


TYPICAL SECTION & DESIGN DATA

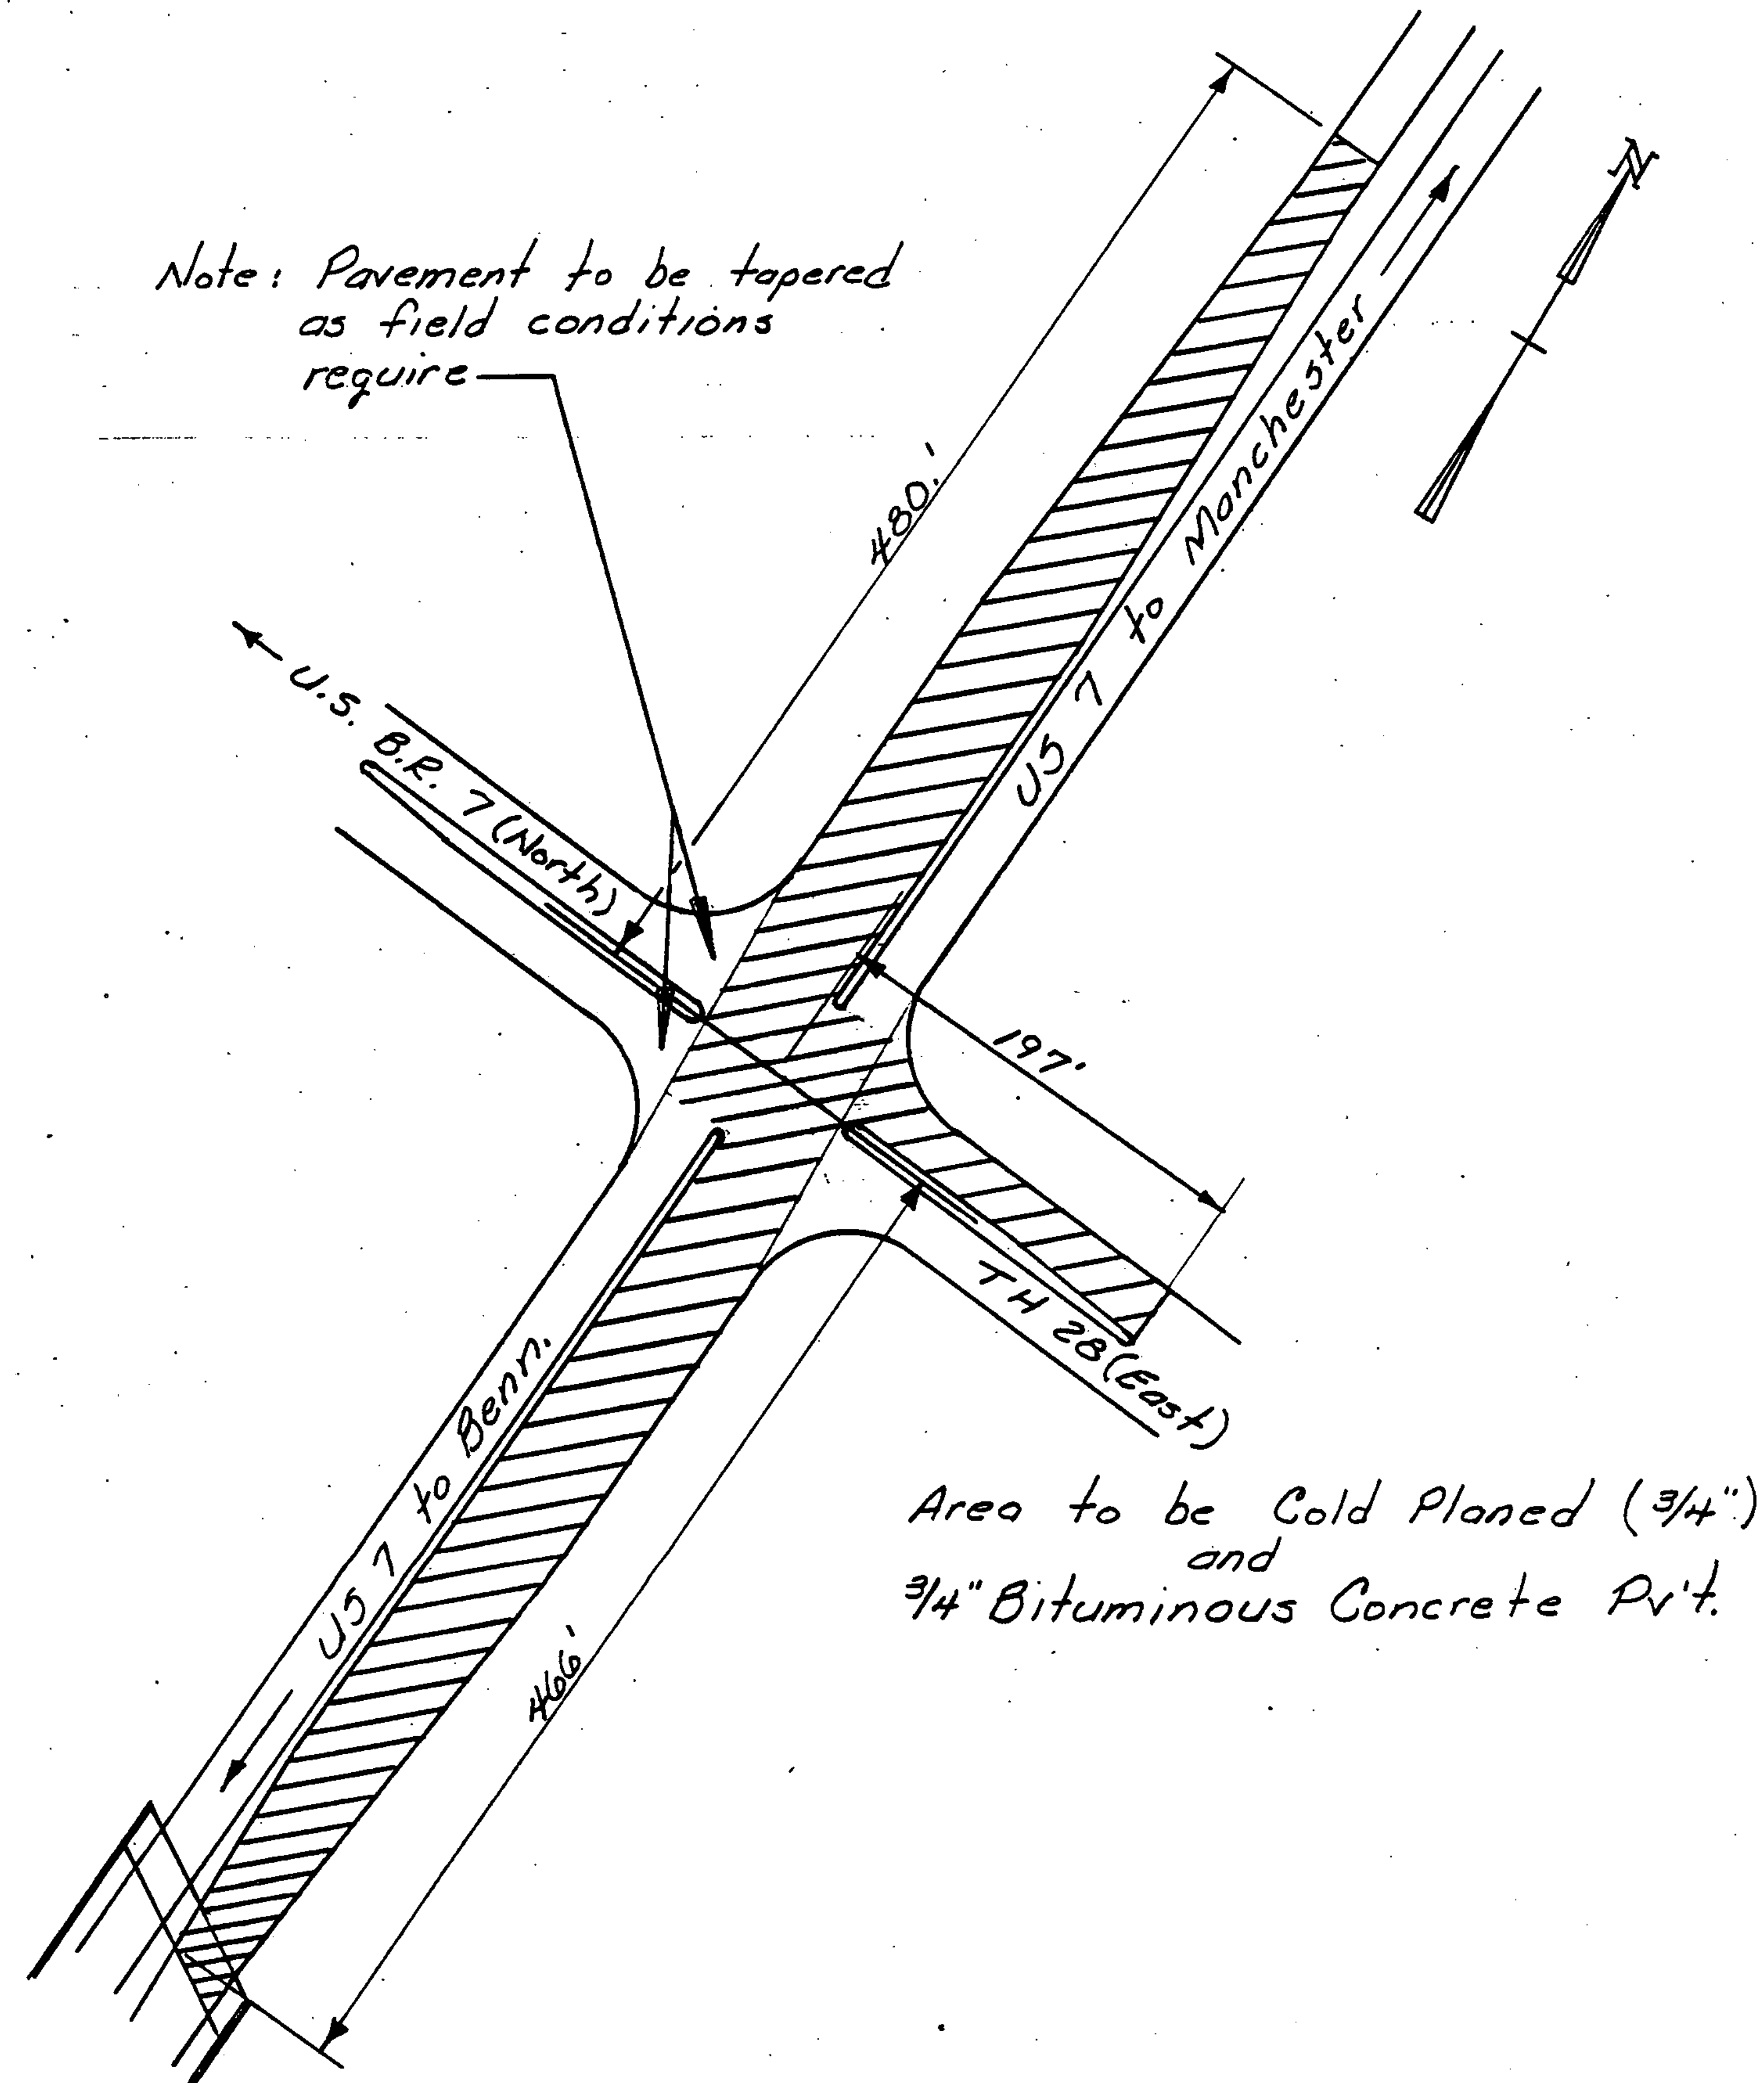

PROJECT BENNINGTON

NO. M 1000 (7) 5
SHEET 4 OF 13