
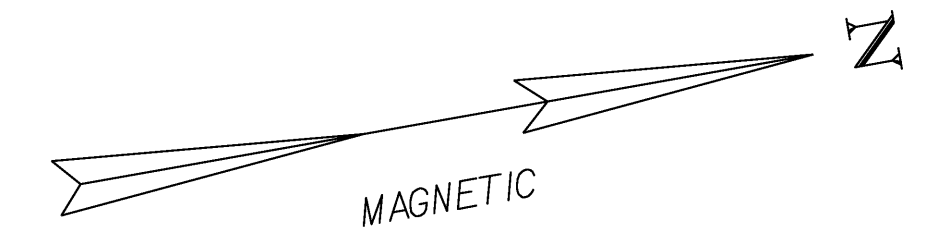


MATCH LINE EROSION PREVENTION & SEDIMENT CONTROL PLAN SHEET 2 STA 222+00

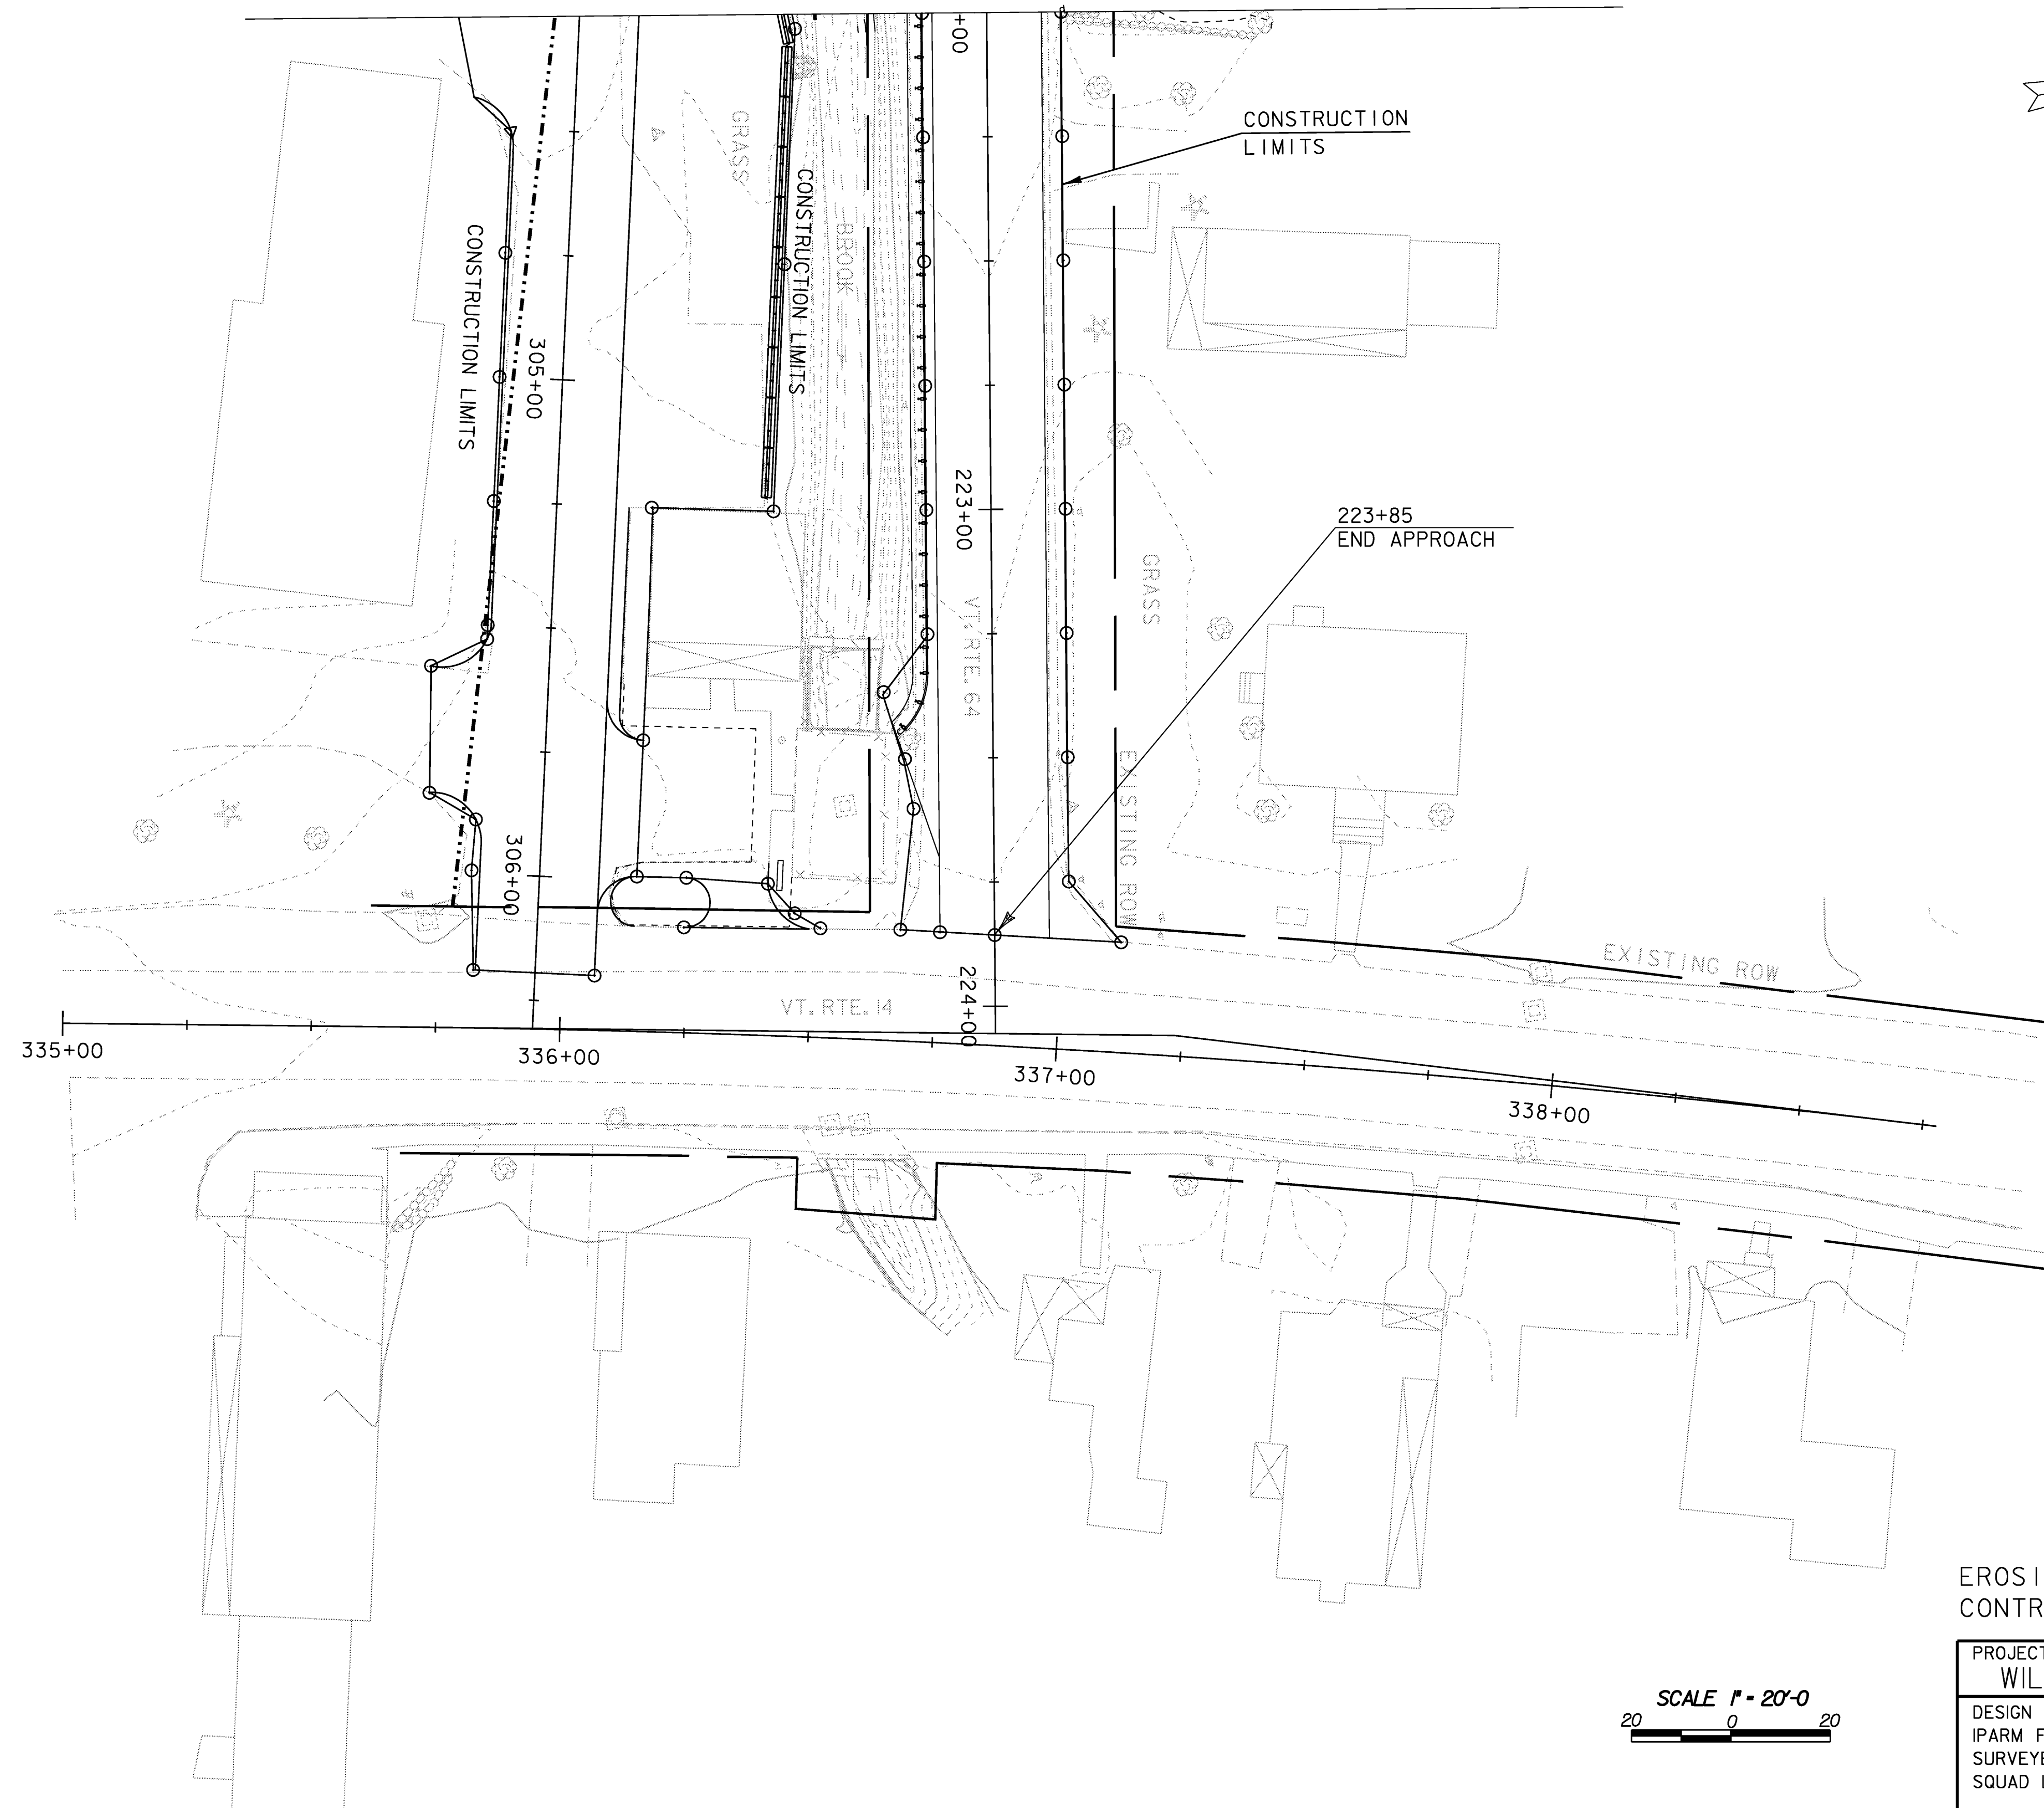

EROSION PREVENTION & SEDIMENT CONTROL PLAN SHEET 3

SCALE 1" = 20'-0"
20 0 20

PROJECT: WILLIAMSTOWN	PROJECT NO.: BRS 0204(4)
DESIGN FILE NAME: str2/83ell/dellero.dgn	PLOT DATE: 07-APR-2008
IPARM FILE NAME: sellero3	SURVEY DATE: 9/89
SURVEYED BY: GILMAN	DRAWN BY: U. STANLEY
SQUAD LEADER: M. EVANS-MONGEON	SHEET: 32 OF 108

DATUM	
VERTICAL	NGVD 1929
HORIZONTAL	ASSUMED