
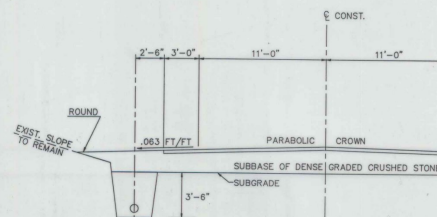


CONSTRUCT DRIVE
1+10 LT ~ 14' GRAVEL
1+75 RT ~ 15' GRAVEL
2+77 LT ~ 12' GRAVEL



RELOCATE MAILBOX
SINGLE SUPPORT
1+28 LT
3+18 LT

END MAINT. AGREE. AREA NO. 1
STA. TH 13 0+95 CL

WALDO LANE
C. CONST.
Δ = 61'-33"-01" RT.
D = 44'-00"-00"
R = 130.22'
T = 77.57'
L = 139.91'
E = 21.35'

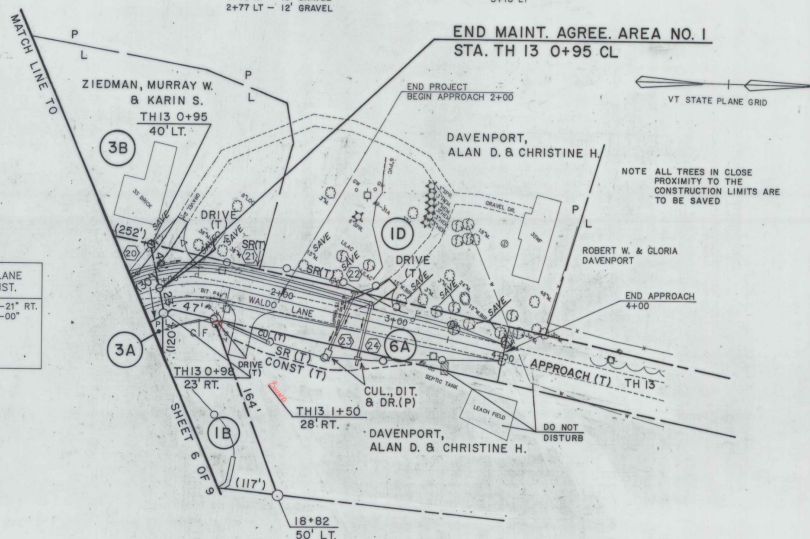

TYPICAL U-DRAIN CONSTRUCTION
WALDO LANE
0+78 ~ 2+77 LT
NOT TO SCALE

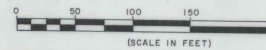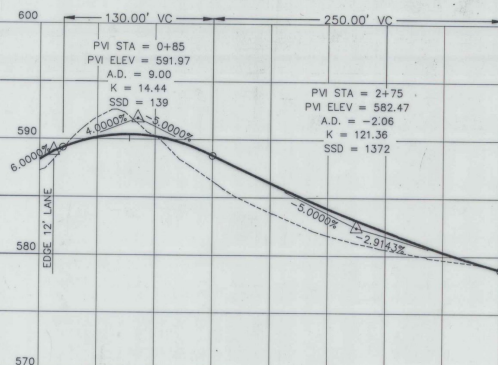

DRAINAGE TABLE	
LOCATION	REMARKS
22 0+75~0+78 LT	NEW 6"x4' UNDERDRAIN W/F.B. @ 0+78 LT
23 0+78~2+77 LT	NEW 6"x198' UNDERDRAIN W/F.B. @ 2+77 LT
24 2+55	REMOVE EXISTING 15" CMP
25 2+62 LT~2+52 RT	NEW 18"x54" PCCSP .064 CAAP .060 RCP OR OPER(SL) W/CRM @ INLET & STONE FILL @ OUTLET
26 2+77 LT~RT	NEW 6"x50' UNDERDRAIN W/OUTLET @ 2+77 LT

THIS
ROY