
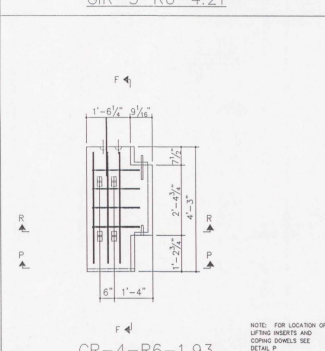
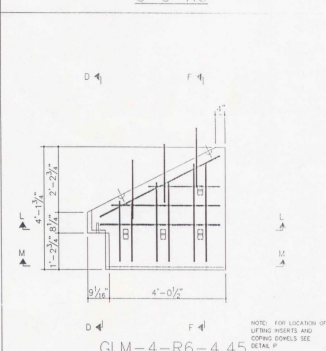
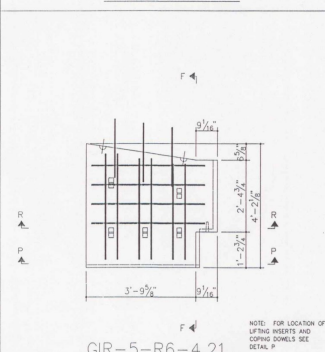
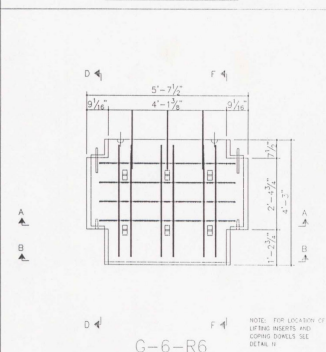
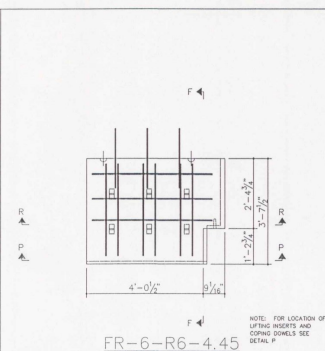


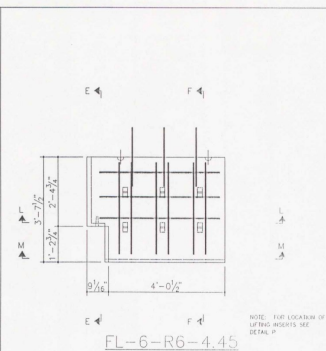

DESIGNED BY: VNG			
PROJECT ENGR: JRS			
CHECKED BY: KT			
ENG. MANAGER			
REV.	DATE	DESCRIPTION	