


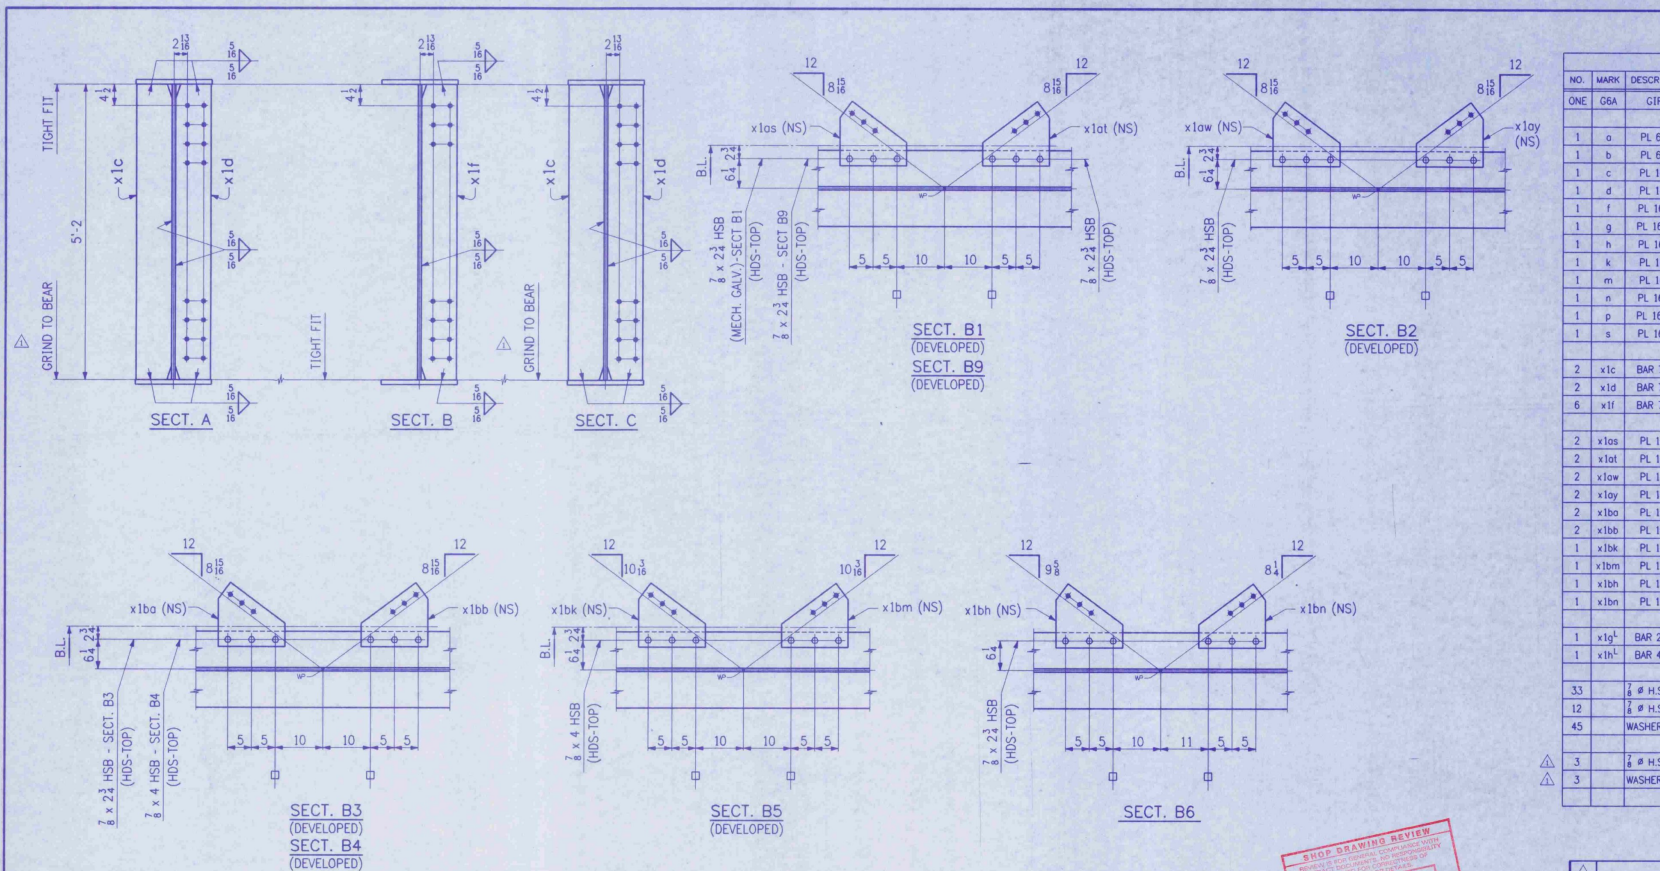

SHOP NOTE
 HOLES: $\frac{1}{8}$ " (UN)
 BOLTS: AS NOTED
 PAINT: AS NOTED, SEE DWG. N1
 FOR GENERAL SHOP NOTES, SEE DWG. N1.
 FOR WEB CAMBER DIAGRAM, SEE DWG. WC1.

WORK THIS DWG. WITH DWG. 13

NO.	MARK	DESCR
ONE	GSA	GIR
1	a	PL 8
1	b	PL 8
1	c	PL 1
1	d	PL 1
1	f	PL 1
1	g	PL 16
1	h	PL 1
1	k	PL 1
1	m	PL 1
1	n	PL 1
1	p	PL 16
1	s	PL 1
2	x1c	BAR
2	x1d	BAR
6	x1f	BAR
2	x1as	PL 1
2	x1at	PL 1
2	x1aw	PL 1
2	x1ay	PL 1
2	x1ba	PL 1
2	x1bb	PL 1
1	x1bk	PL 1
1	x1bm	PL 1
1	x1bh	PL 1
1	x1bn	PL 1
1	x1g ^L	BAR 2
1	x1h ^L	BAR 4
33		$\frac{1}{4}$ " H.S.
12		$\frac{3}{8}$ " H.S.
45		WASHER
3		$\frac{1}{4}$ " H.S.
3		WASHER

△	
△	CHANGED
NO.	
	HIGH STEEL STR
	U.S.
	TOWN OF
	STATE CONTRACT
	CONTRACTOR J. A.
	IN CHARGE abs
	CONTRACT NUMBER VT-9

CODE: 30