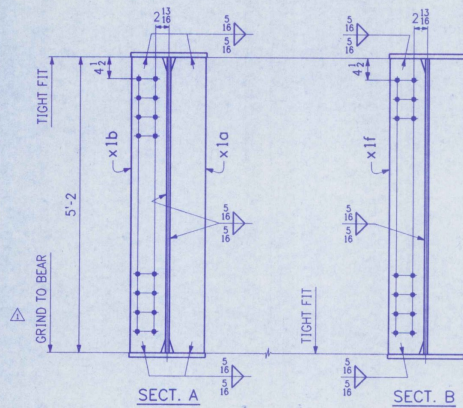


SHOP NOTE
HOLES: $\frac{1}{8}$ (UN)
BOLTS: AS NOTED
PAINT: AS NOTED, SEE DWG. N1
FOR GENERAL SHOP NOTES, SEE DWG. N1.
FOR WEB CAMBER DIAGRAM, SEE DWG. WC1.

WORK THIS DWG. WITH DWG. 15

NO.	MARK	DESCRIPTION
ONE	G1B	GIRDER
1	a	PL 62
1	b	PL 62
1	c	PL 16 x
1	d	PL 16 x
1	e	PL 16 x
1	f	PL 16 x
1	g	PL 16 x
2	x1k	PL 58 x
2	x1m	PL 16 x
4	x1n	BAR 7 x
1	x1a	BAR 7 1/2
1	x1b	BAR 7 1/2
5	x1f	BAR 7 1/2
2	x1op	PL 14 x
3	x1bd	PL 14 x
3	x1bc	PL 14 x
1	x1bg	PL 14 x
1	x1bf	PL 14 x
27	1/2 # H.S. B	
27	WASHERS	
3	1/2 # H.S. B	
3	WASHERS	

CHANGED "MILL"
NO.

HIGH STEEL STRUCTURE

U.S. F.

TOWN OF W.

AGE

STATE CONTRACT PROJ.

CONTRACTOR J. A. M.

IN CHARGE abs

CONTRACT NUMBER VT-953

CODE: 30

400-9