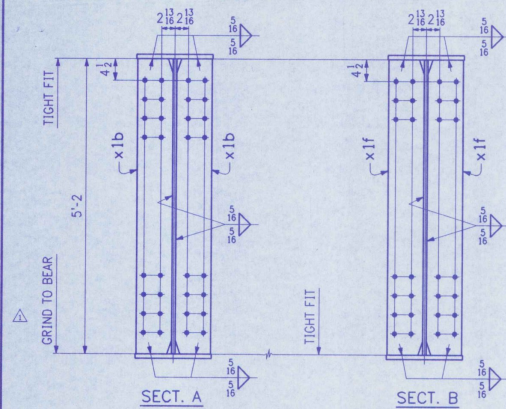


SHOP NOTE
 HOLES: $\frac{1}{8}$ " (UN)
 BOLTS: AS NOTED
 PAINT: AS NOTED, SEE DWG. N1
 FOR GENERAL SHOP NOTES, SEE DWG. N1.
 FOR WEB CAMBER DIAGRAM, SEE DWG. WC1.

WORK THIS DWG. WITH DWG. 17

CODE: 30

NO.	MARK
ONE	G2B
1	a
1	b
1	c
1	d
1	f
1	g
2	x1k
2	x1m
4	x1n
2	x1b
10	x1f
1	x1p
2	x1s
3	x1ad
3	x1af
1	x1ag
1	x1ah
30	
30	
3	
3	

△	
△	CHANG
△	NO.
	HIGH STEEL
	TOW
	STATE CONTRACT
	OR REF. NO.
	CONTRACTOR
	IN CHARGE
	CONTRACT NUMBER