


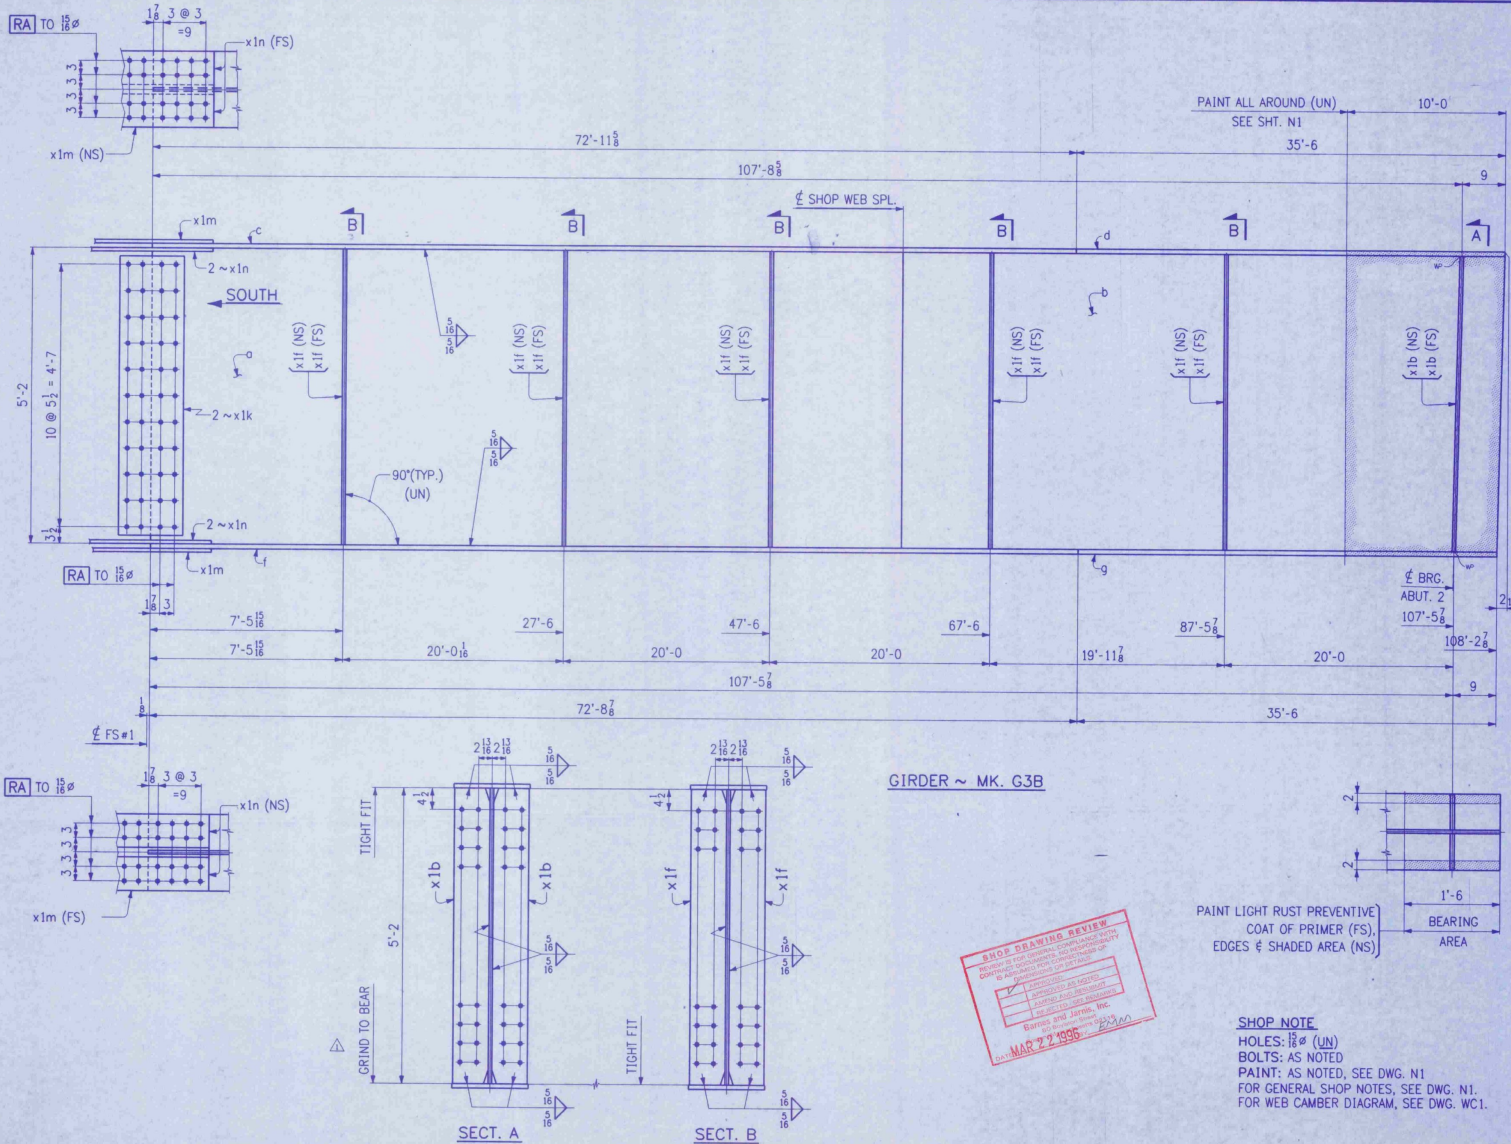

| FED. ROAD<br>DIV. NO. |      | STATE                              |        | FED. AID<br>PROJ. NO. |                  |
|-----------------------|------|------------------------------------|--------|-----------------------|------------------|
|                       |      | VT                                 |        |                       |                  |
| BILL OF MATERIAL      |      |                                    |        |                       |                  |
| NO.                   | MARK | DESCRIPTION                        | LENGTH | REMARKS               | ITEM             |
| ONE                   | G3B  | GIRDER                             |        |                       | 29000            |
| 1                     | a    | PL 62 x $\frac{5}{8}$              | 65     | (T)                   | $\frac{3}{2}$ 4  |
| 1                     | b    | PL 62 x $\frac{5}{8}$              | 42     | $\frac{11}{16}$ (T)   | $\frac{2}{2}$ 5  |
| 1                     | c    | PL 16 x $1\frac{1}{2}$             | 72     | $\frac{11}{16}$ (T)   | $\frac{2}{2}$ 13 |
| 1                     | d    | PL 16 x $1\frac{1}{2}$             | 35     | 6 (T)                 | $\frac{2}{2}$ 14 |
| 1                     | f    | PL 16 x $1\frac{1}{2}$             | 72     | $\frac{8}{16}$ (T)    | $\frac{2}{2}$ 13 |
| 1                     | g    | PL 16 x $1\frac{1}{2}$             | 35     | 6 (T)                 | $\frac{2}{2}$ 14 |
| 2                     | x1k  | PL 58 x $\frac{9}{16}$             | 1      | 1 (T)                 | $\frac{3}{3}$ 6  |
| 2                     | x1m  | PL 16 x $\frac{3}{8}$              | 2      | 1 (T)                 | $\frac{3}{3}$ 4  |
| 4                     | x1n  | BAR 7 x $\frac{1}{2}$              | 2      | 1 (T)                 | $\frac{3}{3}$ 2  |
| 2                     | x1b  | BAR $7\frac{1}{2}$ x $\frac{3}{4}$ | 5      | 2                     | $\frac{3}{3}$ 16 |
| 10                    | x1f  | BAR $7\frac{1}{2}$ x $\frac{1}{2}$ | 5      | 2                     | $\frac{3}{3}$ 14 |
|                       |      |                                    |        |                       |                  |
|                       |      |                                    |        |                       |                  |
|                       |      |                                    |        | </                    |                  |

|                                                                                                                                                 |                           |         |  |
|-------------------------------------------------------------------------------------------------------------------------------------------------|---------------------------|---------|--|
| △                                                                                                                                               |                           |         |  |
| △                                                                                                                                               |                           |         |  |
| △                                                                                                                                               | CHANGED "MILL" TO "GRIND" | 2-21-96 |  |
| NO.                                                                                                                                             | REVISION                  | DATE    |  |
| <b>HIGH STEEL STRUCTURES, INC.</b> 1770 Hempstead Road<br>Lancaster, PA 17602-0008<br>Phone 717/299-5211<br>A Division of High Industries, Inc. |                           |         |  |
| <b>GIRDER G3B</b>                                                                                                                               |                           |         |  |
| S.U. ROUTE 7 OVER OTTER CREEK                                                                                                                   |                           |         |  |
| BRIDGE NO. 79                                                                                                                                   |                           |         |  |
| TOWN OF WALLINGFORD, COUNTY OF RUTLAND                                                                                                          |                           |         |  |
| STATE OF VERMONT                                                                                                                                |                           |         |  |
| AGENCY OF TRANSPORTATION                                                                                                                        |                           |         |  |
| PROJECT NO. BRS-0137(13)                                                                                                                        |                           |         |  |
| CONTRACTOR J. A. McDONALD, INC.                                                                                                                 |                           |         |  |
| IN CHARGE: <b>abs</b> MADE: <b>ppf</b> 1:1 CHK'D: <b>LD</b> DATE: 2-3-96                                                                        |                           |         |  |
| CONTRACT NUMBER: <b>VT-95367</b> DRAWING NUMBER: <b>19 OF 24</b>                                                                                |                           |         |  |

PAINT LIGHT RUST PREVENTIVE  
COAT OF PRIMER (FS),  
EDGES & SHADED AREA (NS)

SHOP NOTE  
HOLES: 1/8" (UN)  
BOLTS: AS NOTED  
PAINT: AS NOTED, SEE DWG. N1  
FOR GENERAL SHOP NOTES, SEE DWG. N1.  
FOR WEB CAMBER DIAGRAM, SEE DWG. WC1.

