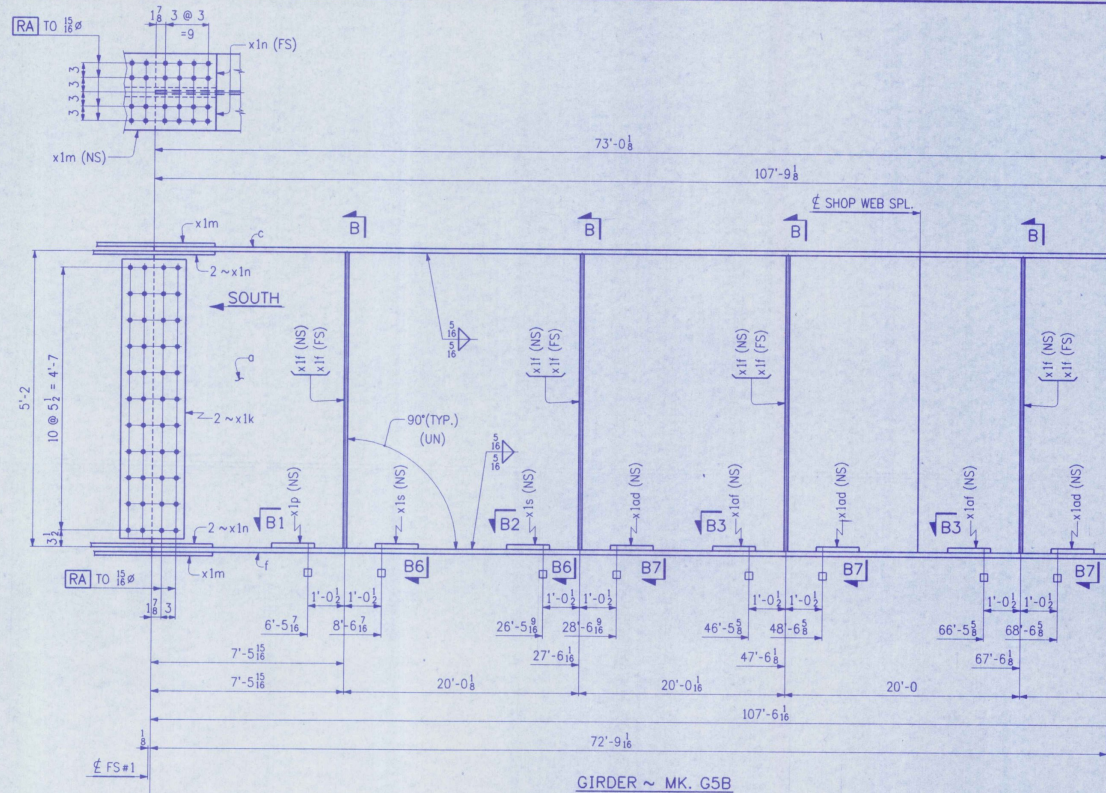


PAINT LIGHT RUST PREVENTIVE
COAT OF PRIMER (FS).
EDGES & SHADED AREA (NS)