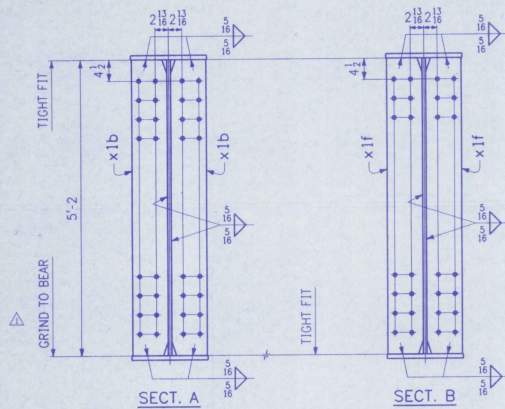


SHOP NOTE
HOLES: 1/8" (UN)
BOLTS: AS NOTED
PAINT: AS NOTED, SEE DWG. N1
FOR GENERAL SHOP NOTES, SEE DWG. N1
FOR WEB CAMBER DIAGRAM, SEE DWG. WC1.

WORK THIS DWG. WITH DWG. 21

CODE: 30

NO.	MARK	DESCRIPTION
ONE	GSB	GIRDER
1	a	PL 62
1	b	PL 62
1	c	PL 16
1	d	PL 16
1	f	PL 16
1	g	PL 16
2	x1k	PL 58
2	x1m	PL 16
4	x1n	BAR 7
2	x1b	BAR 7
10	x1f	BAR 7
1	x1p	PL 14
2	x1s	PL 14
3	x1ad	PL 14
3	x1af	PL 14
1	x1ag	PL 14
1	x1ah	PL 14
30		7 # H.S.
30		WASHER
3		7 # H.S.
3		WASHER

△	
△	CHANGED "M"
NO.	
	HIGH STEEL STR
	U.S.
	TOWN OF
STATE CONTRACT	PH
OF REF. NO.	
CONTRACTOR	J. A.
IN CHARGE	abs
CONTRACT	VT-9
NAMES	