



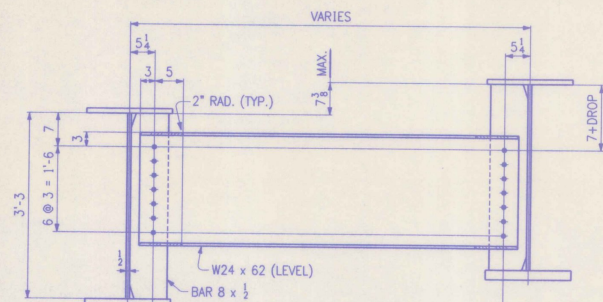

TYP. INT. DIAPHRAGM

- 1/8" HOLES IN DIAPHS
- 1/16" HOLES IN CONN. PL. OF CENTER 3 DPH ROWS
- 1/8" HOLES IN CONN. PL. OF DPHS ADJACENT TO ABUTS

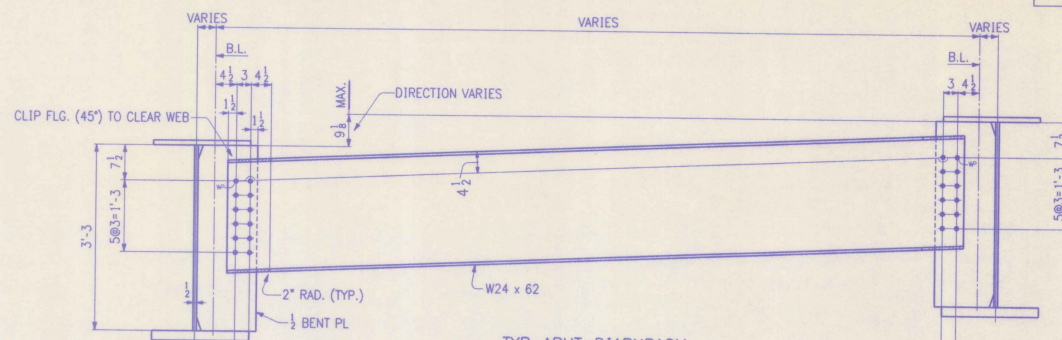

TYP. ABUT. DIAPHRAGM

- 1/8" HOLES IN DIAPHS
- 1/16" HOLES IN CONN. PL.

| SHOP DRAWING REVIEW                                                                               |  |
|---------------------------------------------------------------------------------------------------|--|
| REVIEW FOR CONFORMANCE WITH CONTRACT DOCUMENTS AND SPECIFICATIONS                                 |  |
| REVIEWED BY: <input checked="" type="checkbox"/> APPROVED BY: <input checked="" type="checkbox"/> |  |
| DATE: 5-1-96 BY: JAB                                                                              |  |

THIS IS A WORK (W) DRAWING. ITS FUNCTION IS TO PROVIDE BASIC DIMENSIONS AND CONCEPTS FOR USE IN THE PREPARATION OF THE SHOP DETAILS. IT IS NOT INTENDED TO BE USED FOR ERECTION OR FABRICATION.

|                            |                          |
|----------------------------|--------------------------|
| STATE CONTRACT OR REF. NO. | PROJECT NO. BRS-0137(13) |
| CONTRACTOR                 | J. A. McDONALD, INC.     |
| IN CHARGE                  | abs                      |
| CONTRACT NUMBER            | VT-95368                 |
| DATE                       | 1-23-96                  |
| DRAWING NUMBER             | WS2                      |

HIGH STEEL STRUCTURES, INC. 1770 Hempstead Road  
Lancaster, PA 17605-0008  
Phone 717/298-5211  
A Division of High Industries, Inc.

WORKSHEET - LAYOUTS  
U.S. ROUTE 7 OVER RAILROAD  
BRIDGE NO. 80  
TOWN OF WALLINGFORD, COUNTY OF RUTLAND  
STATE OF VERMONT  
AGENCY OF TRANSPORTATION