



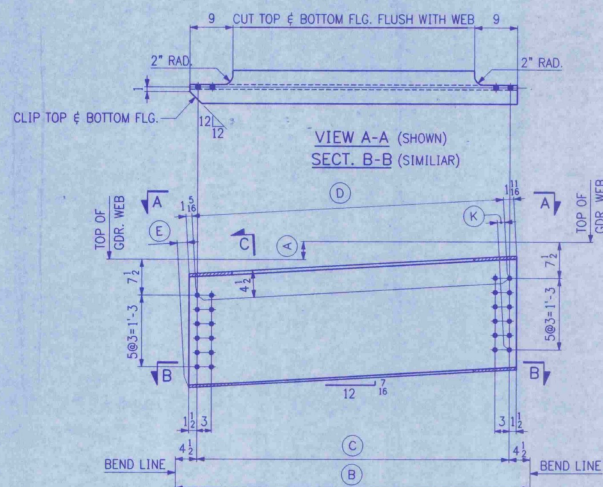

ABUTMENT DIAPHRAGMS

MARK	(A)	(B)	(C)	(D)	(E)	(K)
D26	5 3/4	14'-4 13/16	13'-7 13/16	13'-7 15/16	13 1/16	1/2
D27	5 3/4	14'-5	13'-8	13'-8 1/8	13 1/16	1/2
D28	5 3/4	14'-5 1/16	13'-8 1/8	13'-8 1/8	13 1/16	1/2
D29	5 3/4	14'-5 3/8	13'-8 3/8	13'-8 1/2	13 1/16	1/2
D30	5 5/8	14'-5 1/2	13'-8 1/2	13'-8 5/8	7 7/8	9 1/16

PAINT

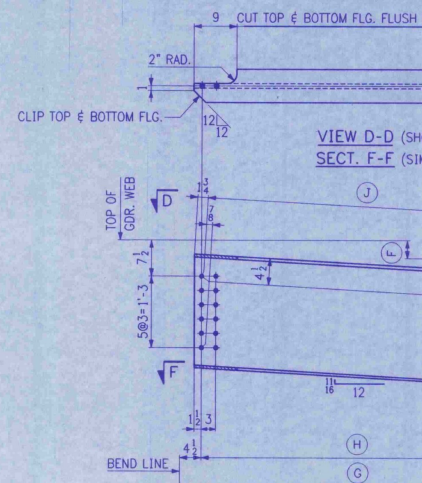

ABUTMENT DIAPHRAGMS

MARK	(F)	(G)	(H)
D31	9	13'-8 1/4	12'-11 1/4
D32	9	13'-8 3/8	12'-11 3/8
D33	9	13'-8 1/2	12'-11 1/2
D34	9 1/8	13'-8 5/8	12'-11 5/8
D35	9 1/8	13'-8 11/16	12'-11 11/16