




SPUCE DETAIL

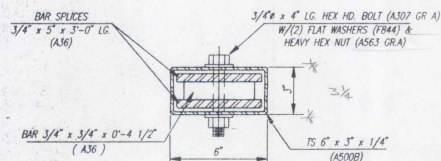


SECTION ~ A-A

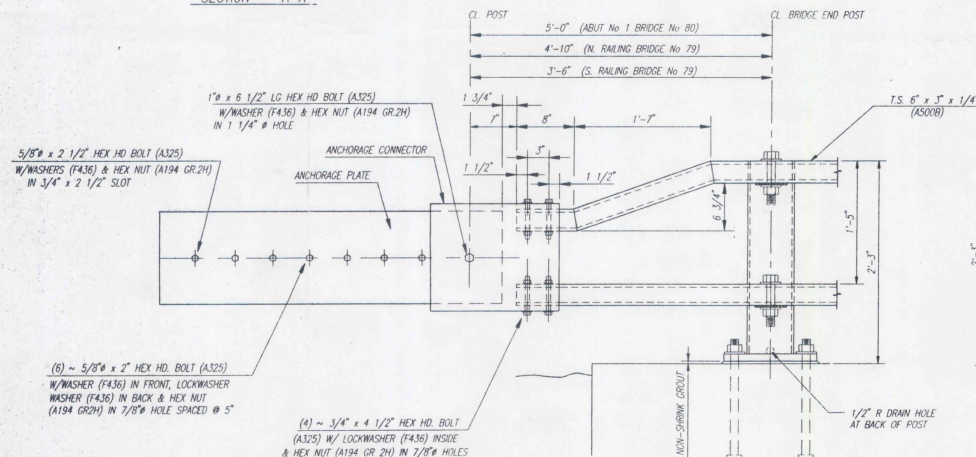

END RAIL ERECTION DETAIL

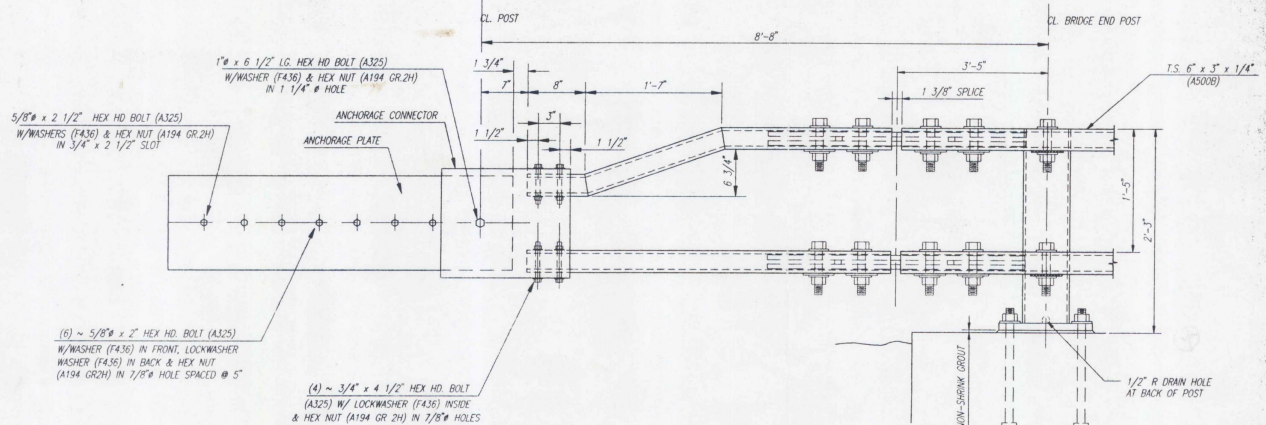

END RAIL ERECTION DETAIL
ABUTMENT No 2 BRIDGE No 80

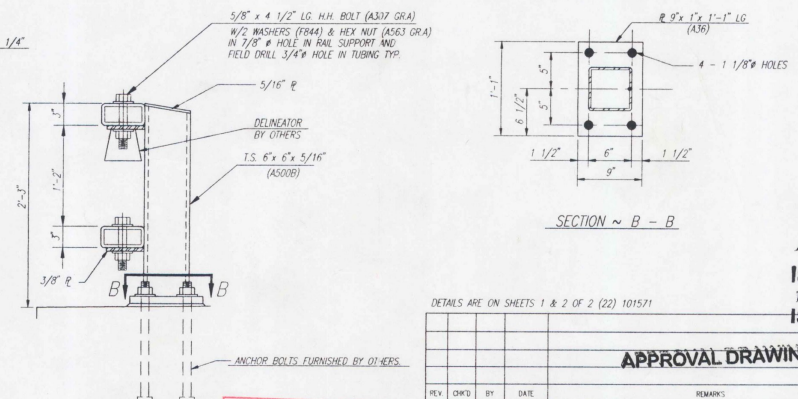

SECTION ~ B-B

SHOP DRAWING REVIEW
REVIEWED BY: [Signature]
DATE: 5-10-96

This drawing and the information shown thereon is the sole property of TRINITY INDUSTRIES, INC. Neither the drawing nor such information is to be used for any purpose other than that for which it was specifically furnished by TRINITY INDUSTRIES, INC., nor is any reproduction authorized without written permission.

DETAILS ARE ON SHEETS 1 & 2 OF 2 (22) 101571

APPROVAL DRAWING			
REV	CHG	BY	DATE
REMARKS:			
STATE OF VERMONT AGENCY OF TRANSPORTATION BOX BEAM BRIDGE RAILING TOWN OF WALLINGFORD, COUNTY OF RUTLAND U.S. ROUTE 7, BRIDGE No 79 & No 80 PROJECT: BRS 0137 (13)			
CUSTOMER	F.R. LAFAYETTE INC.	P.O. No.	
DRAWN	B. TAKACH	CHECKED	
APPROVED		DATE	4-10-96
END FILE #	101571E2	SHEET	22 OF 2
TRINITY INDUSTRIES, INC. 101571			