



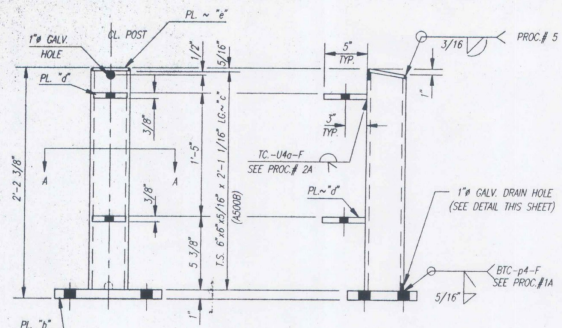


81 ~ 14392A POST

EACH POST 14392A CONSISTING OF:


SUB MK	QUAN.	DESCRIPTION
b	1	PL 9" x 1" x 1'-1" LG. (A36)
c	1	T.S. 6" x 6" x 5/16" x 2'-1 1/16" LG. (A500B)
d	2	PL 5" x 3/8" x 5" LG. (A36)
e	1	PL 5 5/8" x 5/16" x 5 5/8" LG. (A36)

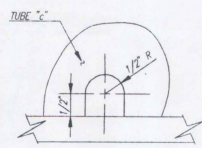


GALV. DRAIN DETAIL

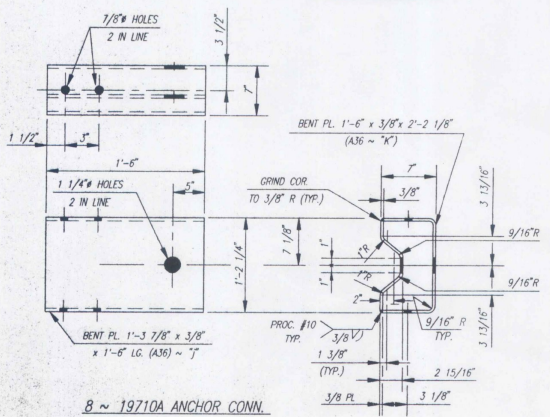


8 ~ 19710A ANCHOR CONN.

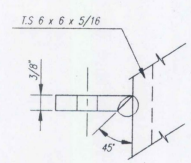


WELD PROC. # 2A
(TC-1440-F)

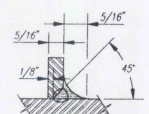

WELD PROC. # 1A
(BTC-p4-F)

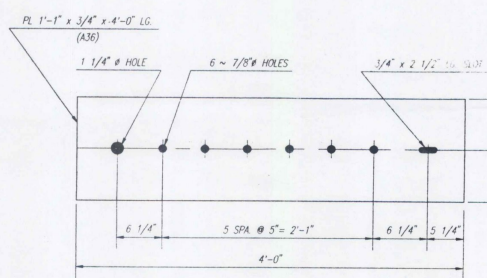

8 ~ 811G ANCHOR PLATE

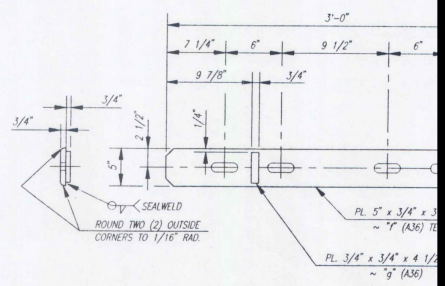

104 ~ 32124A SPLICE