


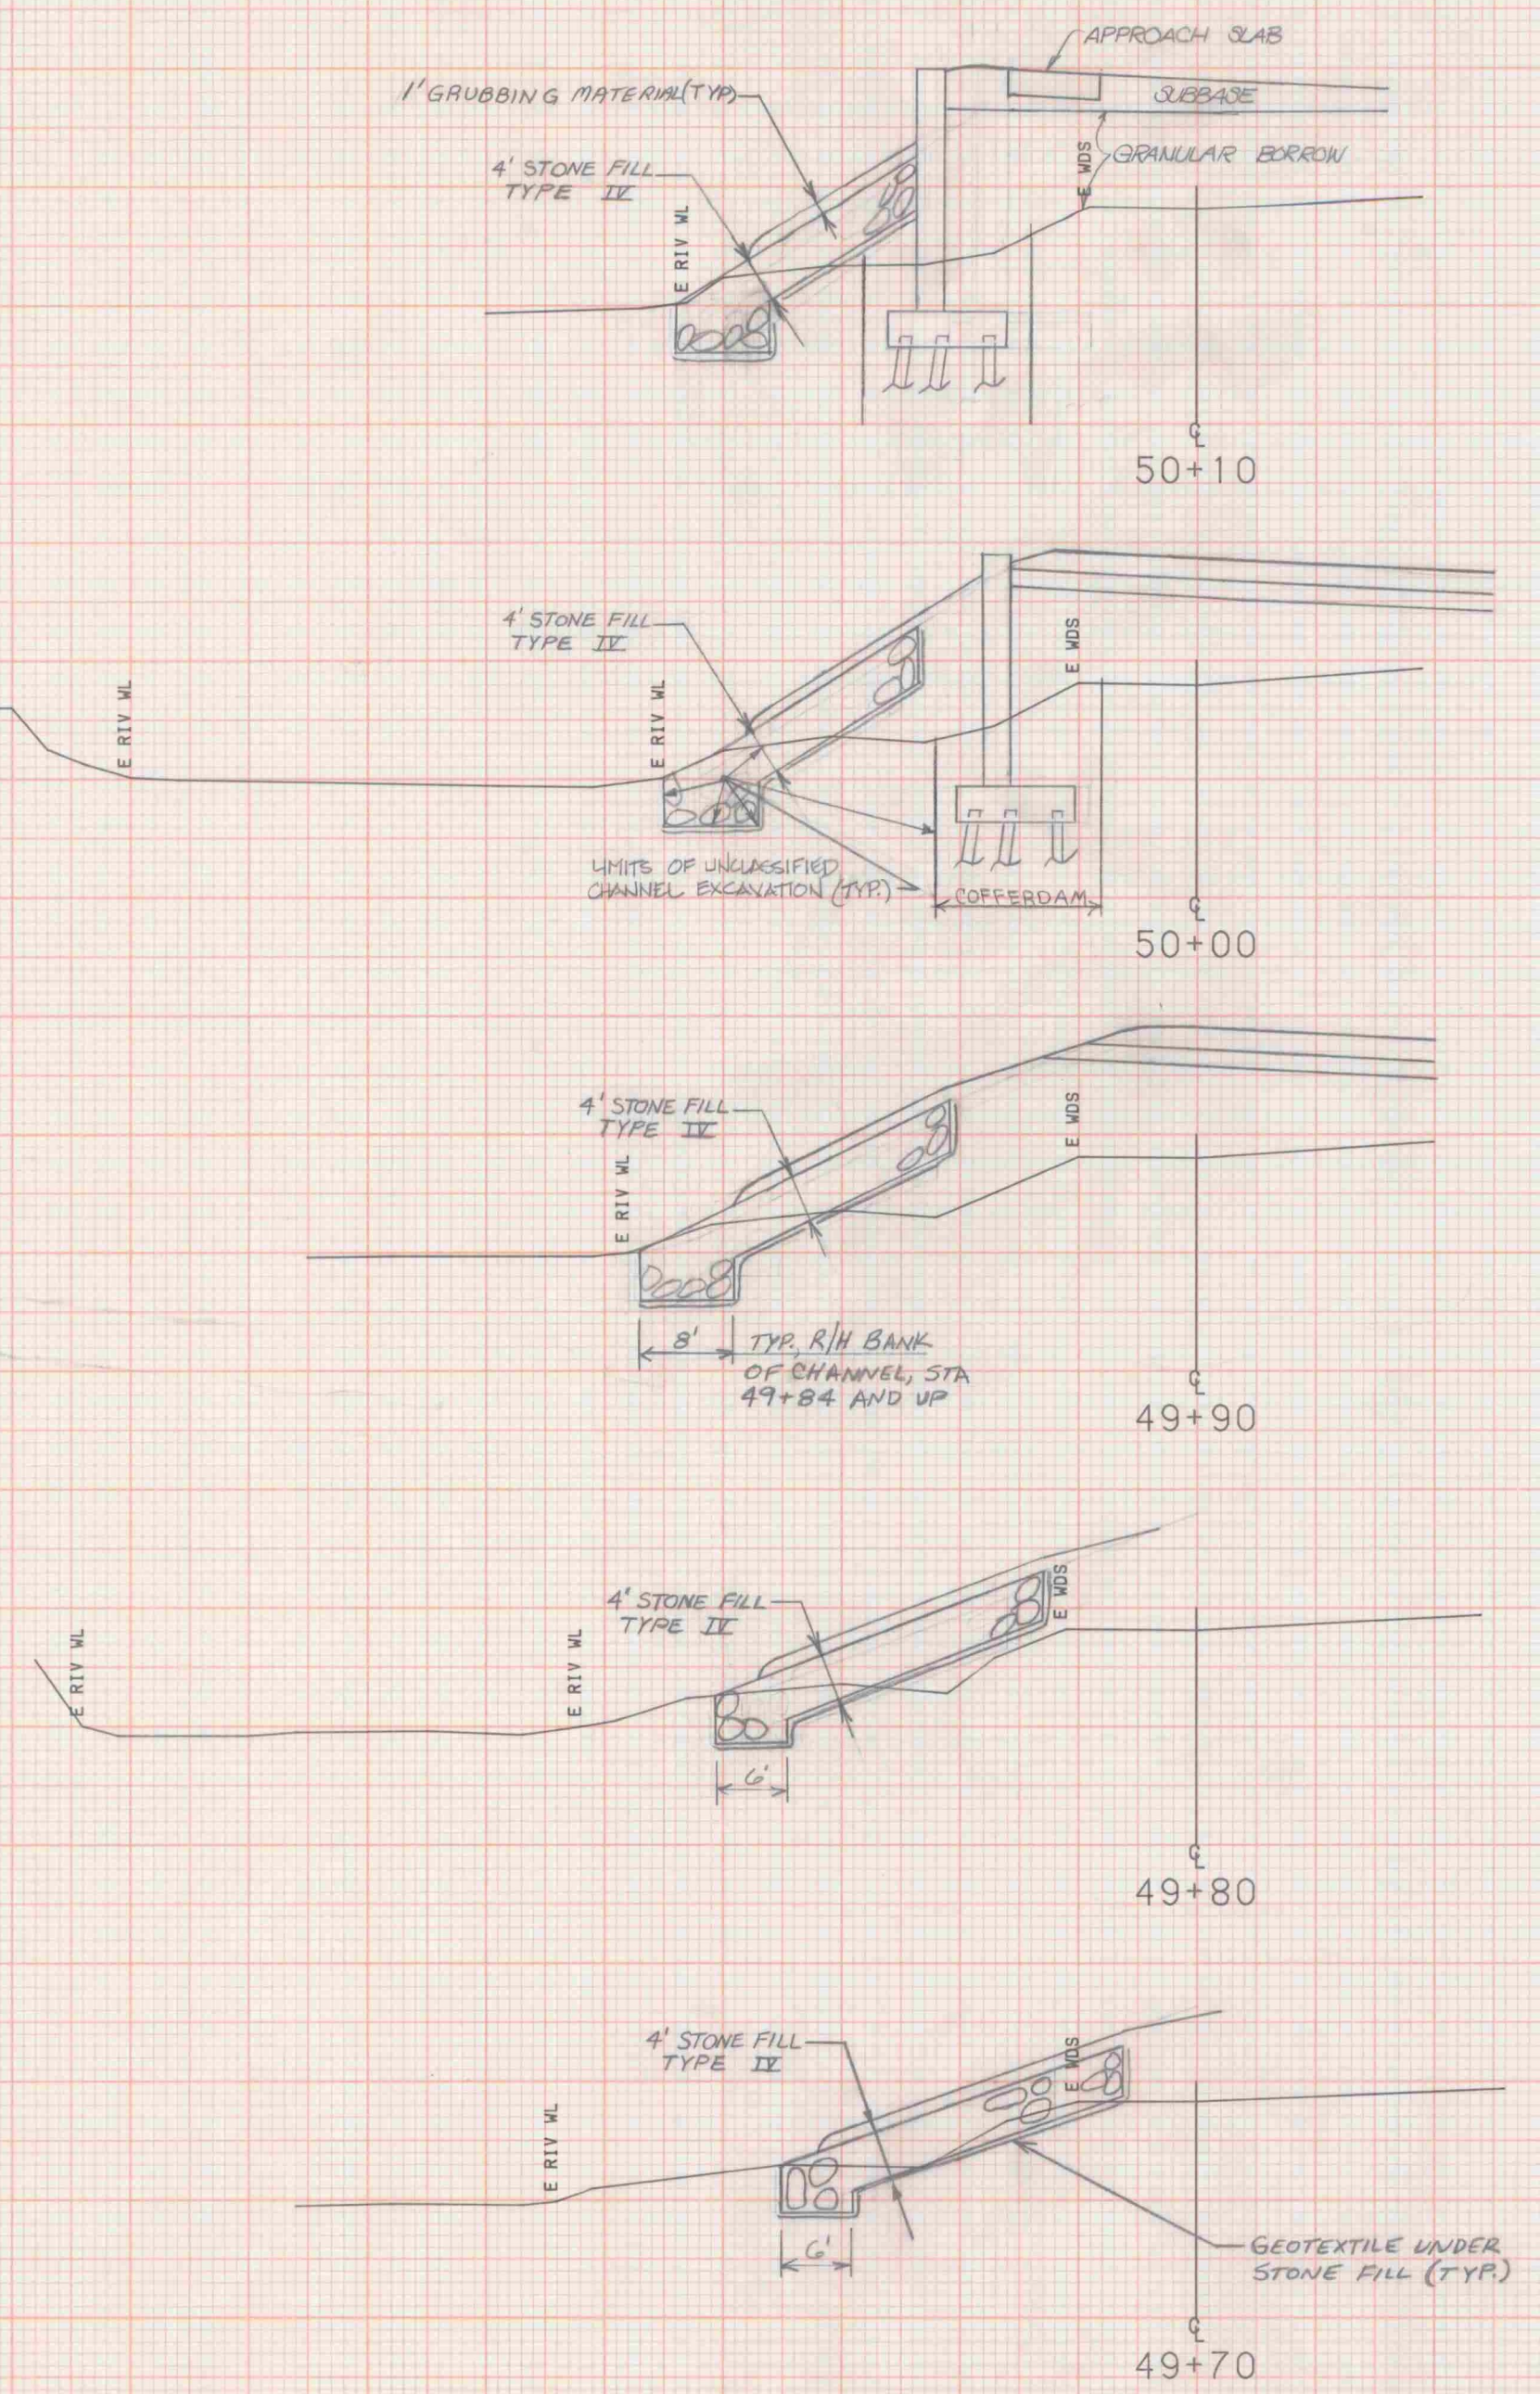

750

750

FROM STA.	49+70	TO STA.	50+10
PROJECT NAME	BRAINTREE CHAN.		
NO.	BR0187 (S)	PLOTTED	07/27/88
SURVEYED BY	J. SHERIDAN	07/88	0141
SHEET	24	OF	SHEETS

SCALE 10 FEET