



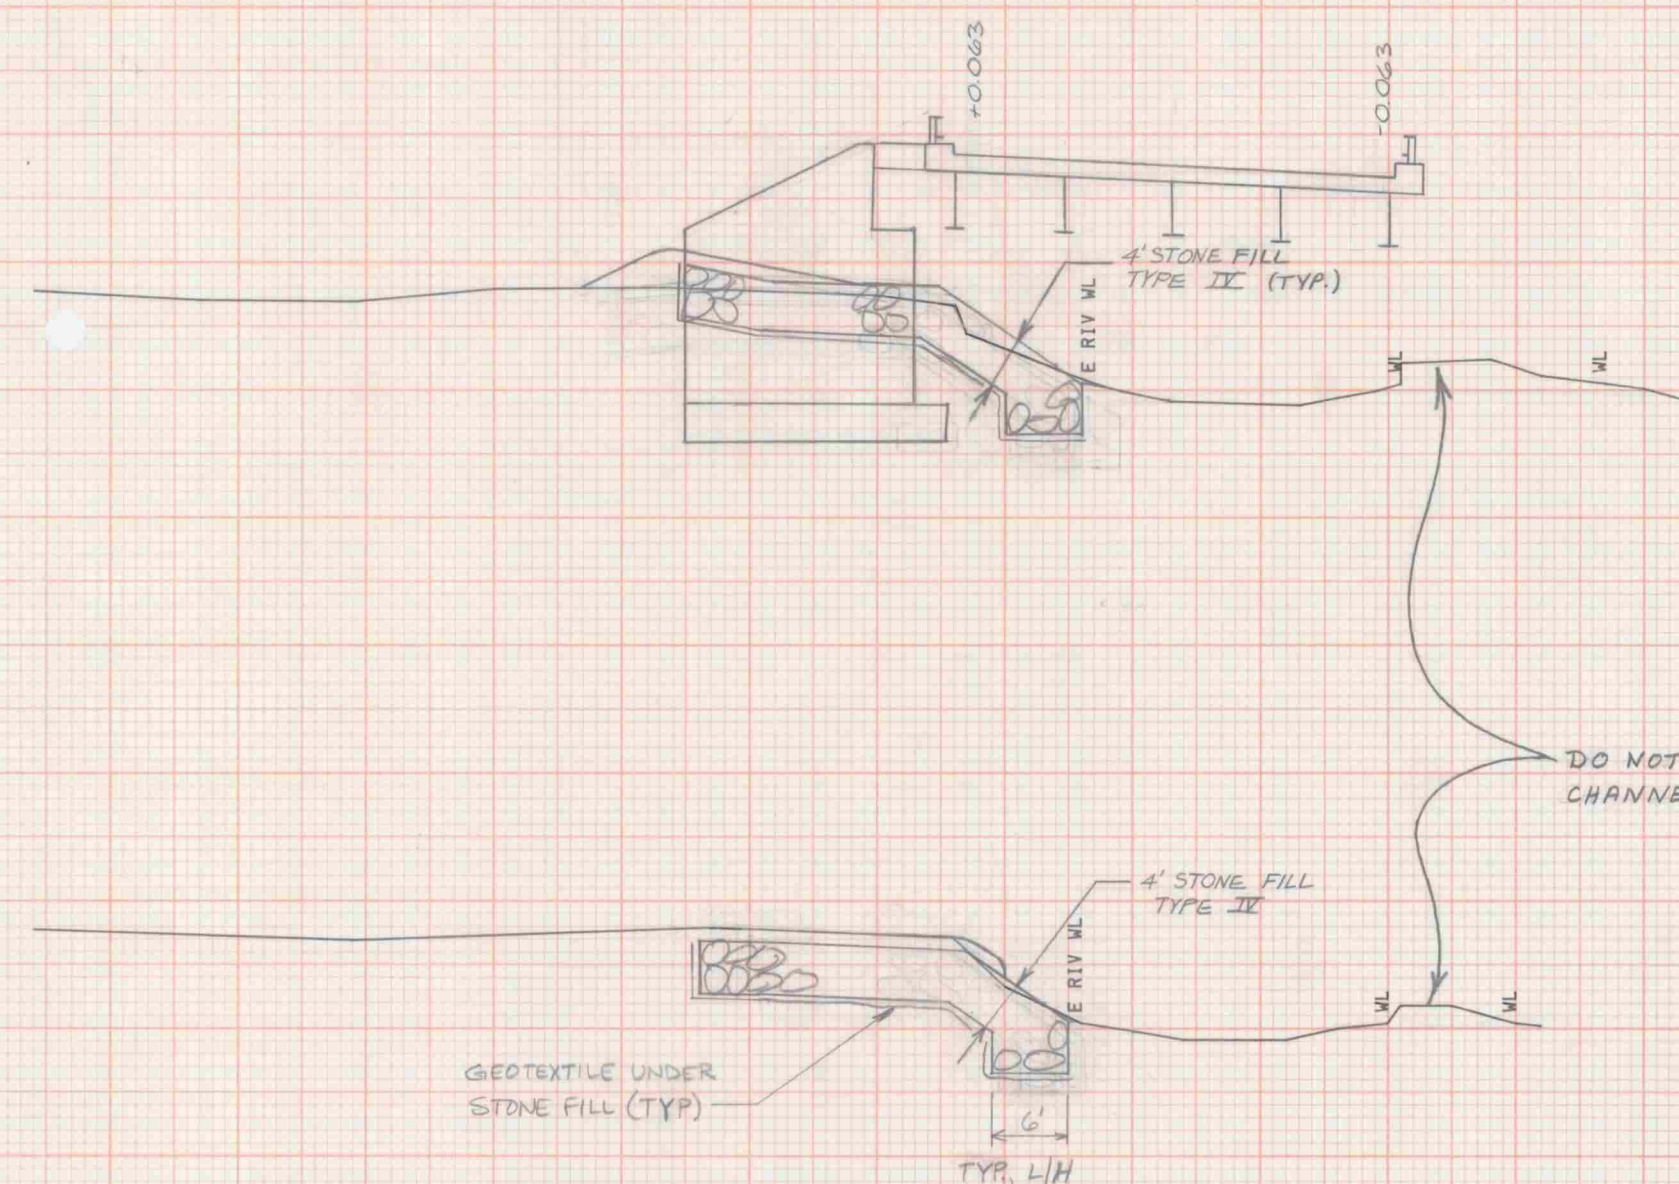

CH STA 51+05, L/H BANK
 BEGIN UNCLASSIFIED CHAN. EXCAV.
 BEGIN GEOTEXTILE UNDER STONE FILL
 BEGIN STONE FILL, TYPE II

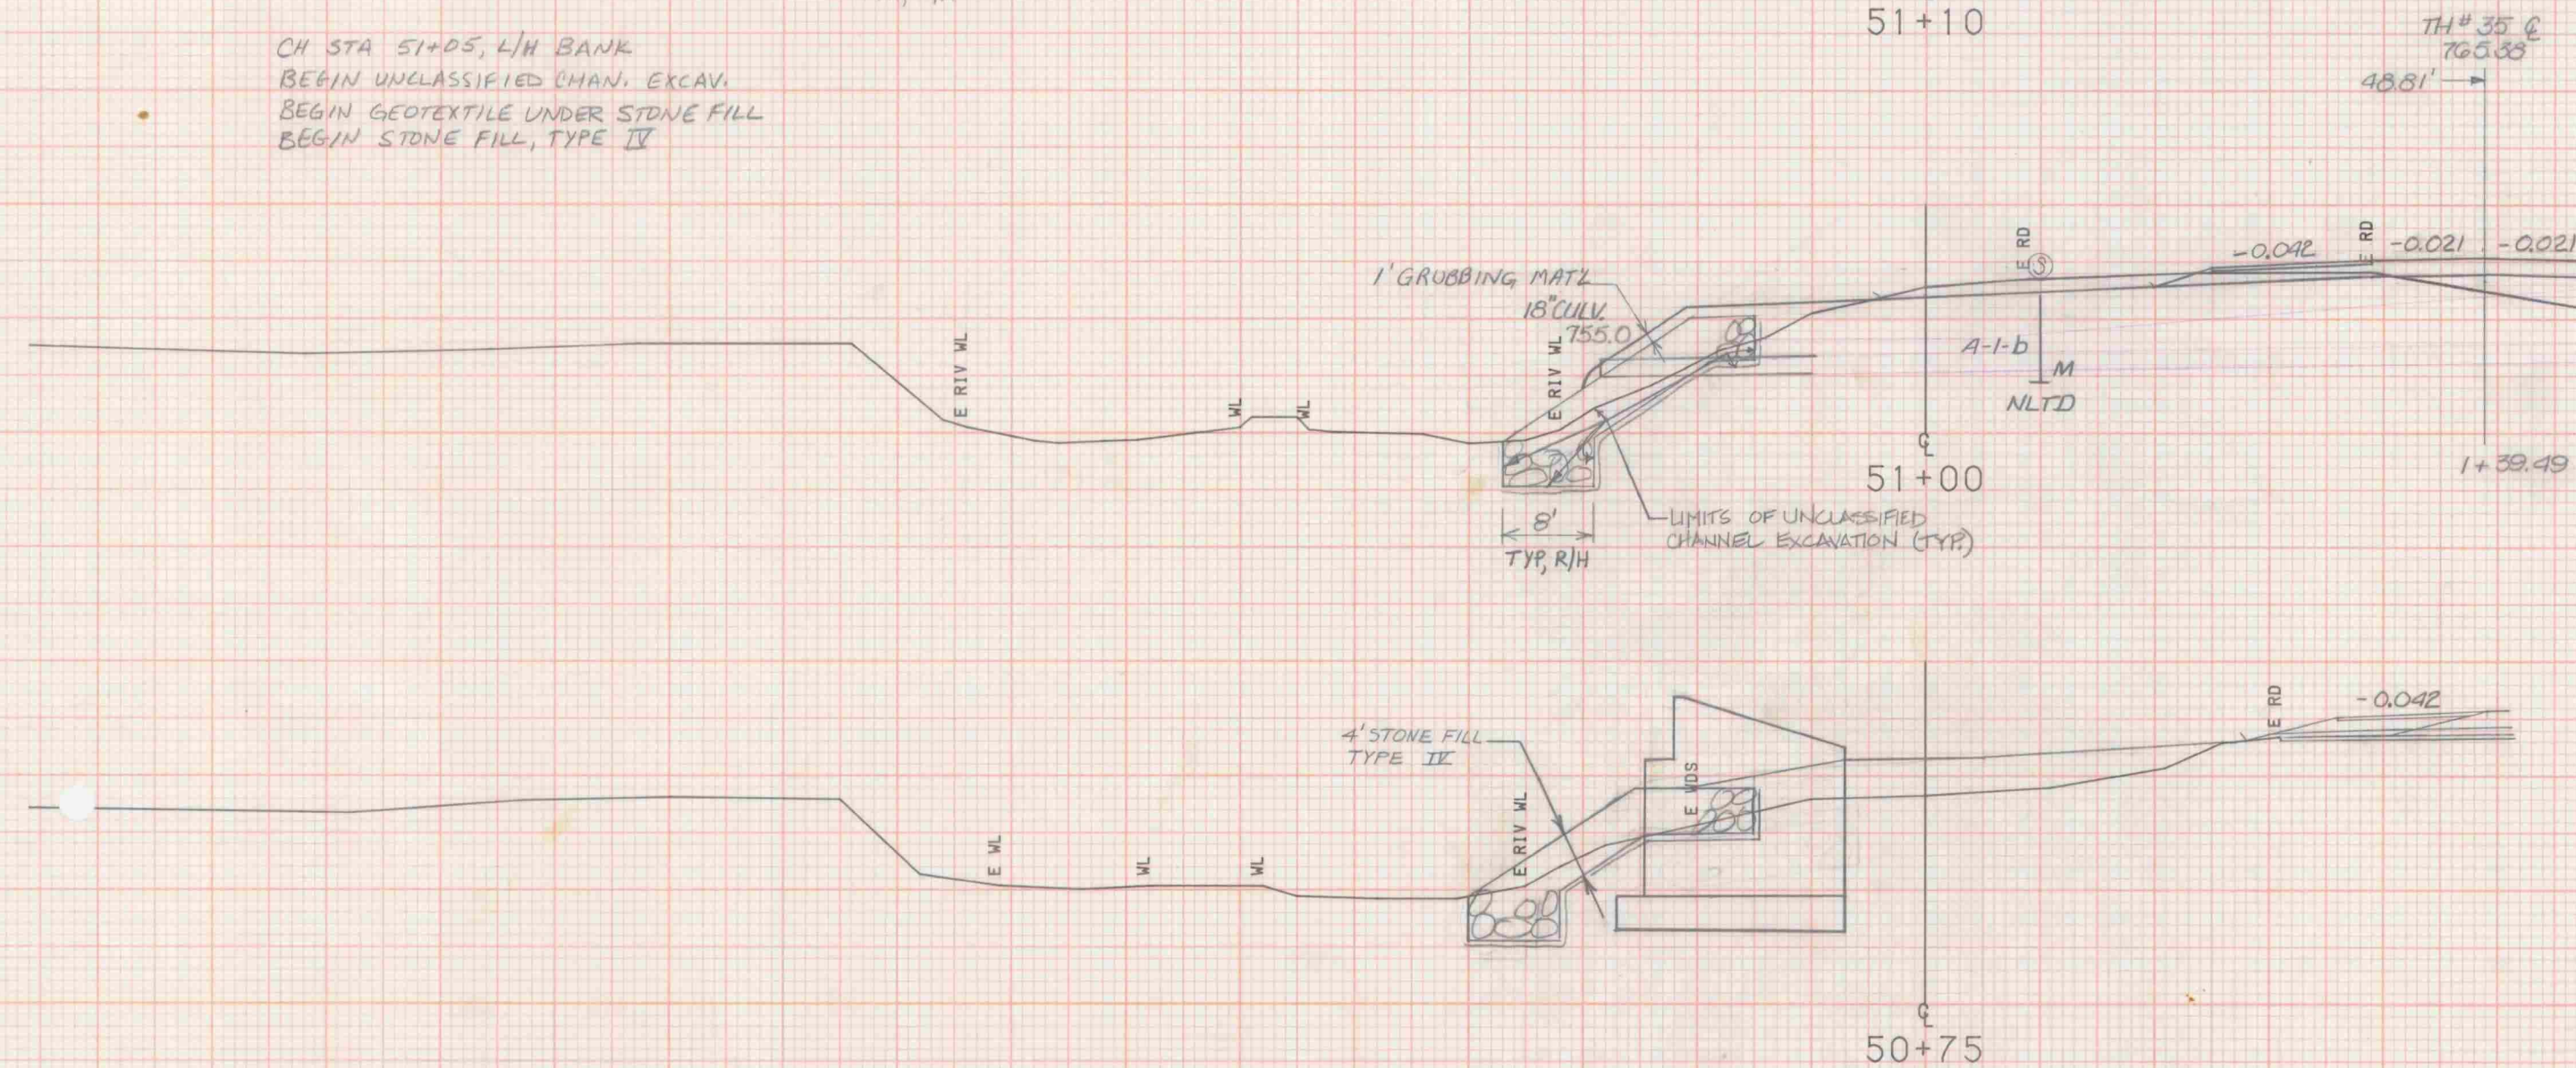


740

750

750

SCALE 10 FEET

FROM STA. 50+75	TO STA. 51+20
PROJECT NAME BRAINTREE CHAN.	
NO. BRS0187 (S)	PLOTTED 07/27/88
SURVEYED BY J. SHERIDAN	07/88 0141
SHEET 2 OF 2	SHEETS

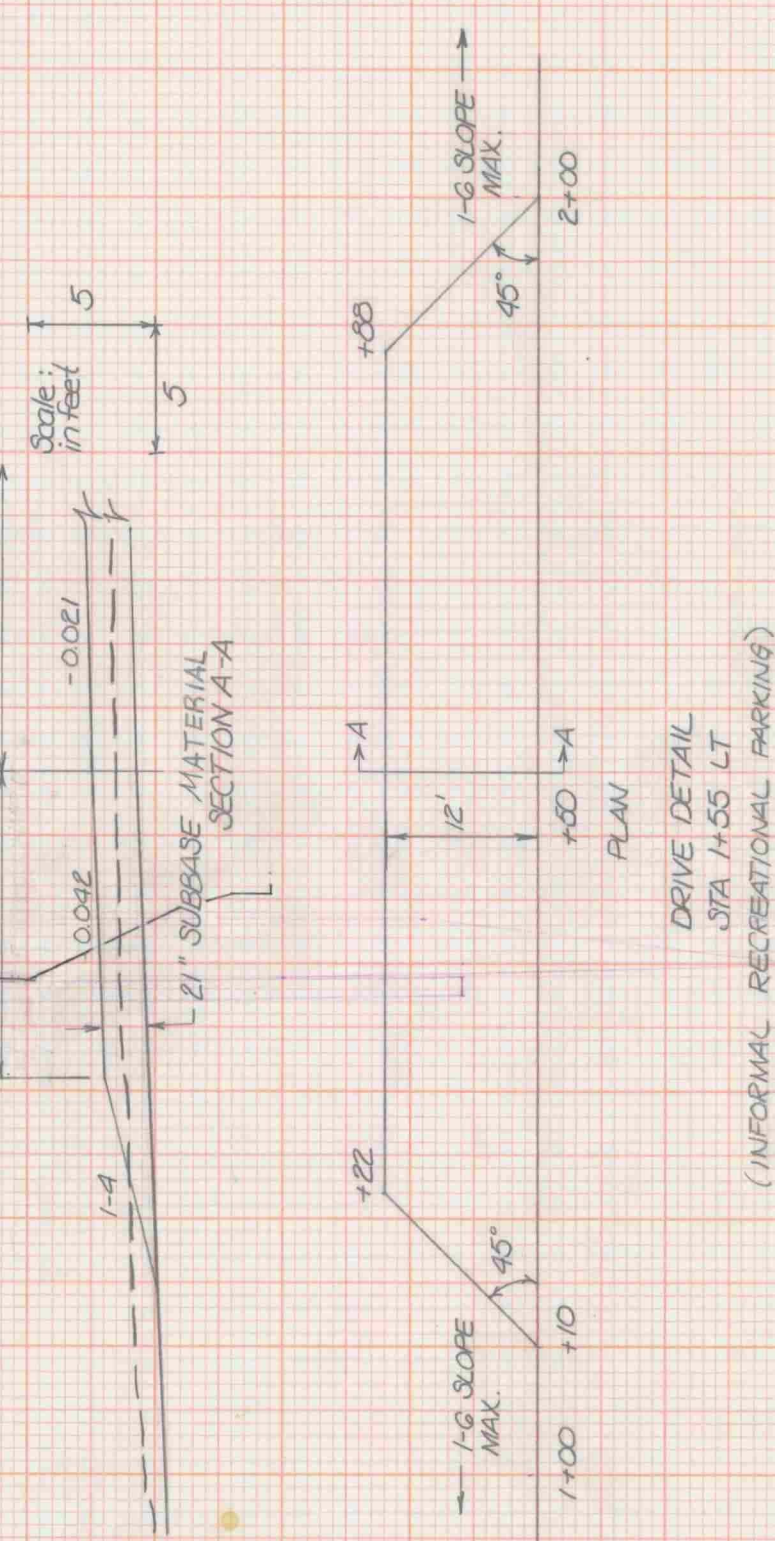

DRIVE DETAIL
 STA 1+55 LT
 (INFORMAL RECREATIONAL PARKING)