




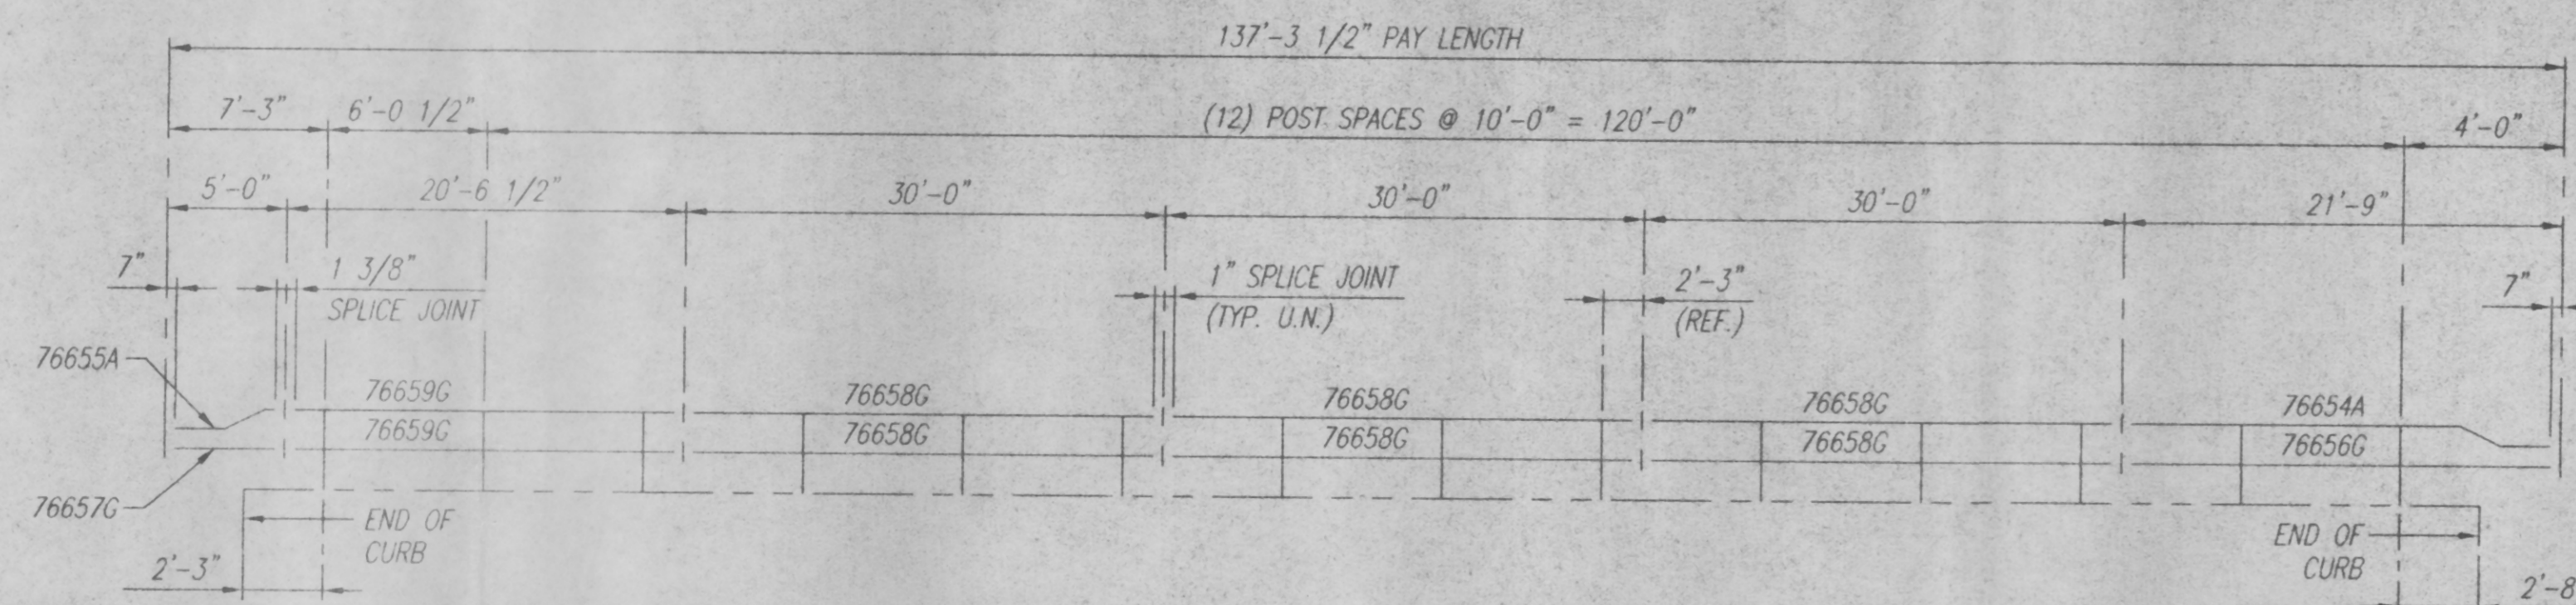

SOUTH RAILING LOOKING SOUTH (VIEWING TRAFFIC FACE)
VT ROUTE 12A OVER THE 3RD BRANCH OF THE WHITE RIVER, BRIDGE No 6

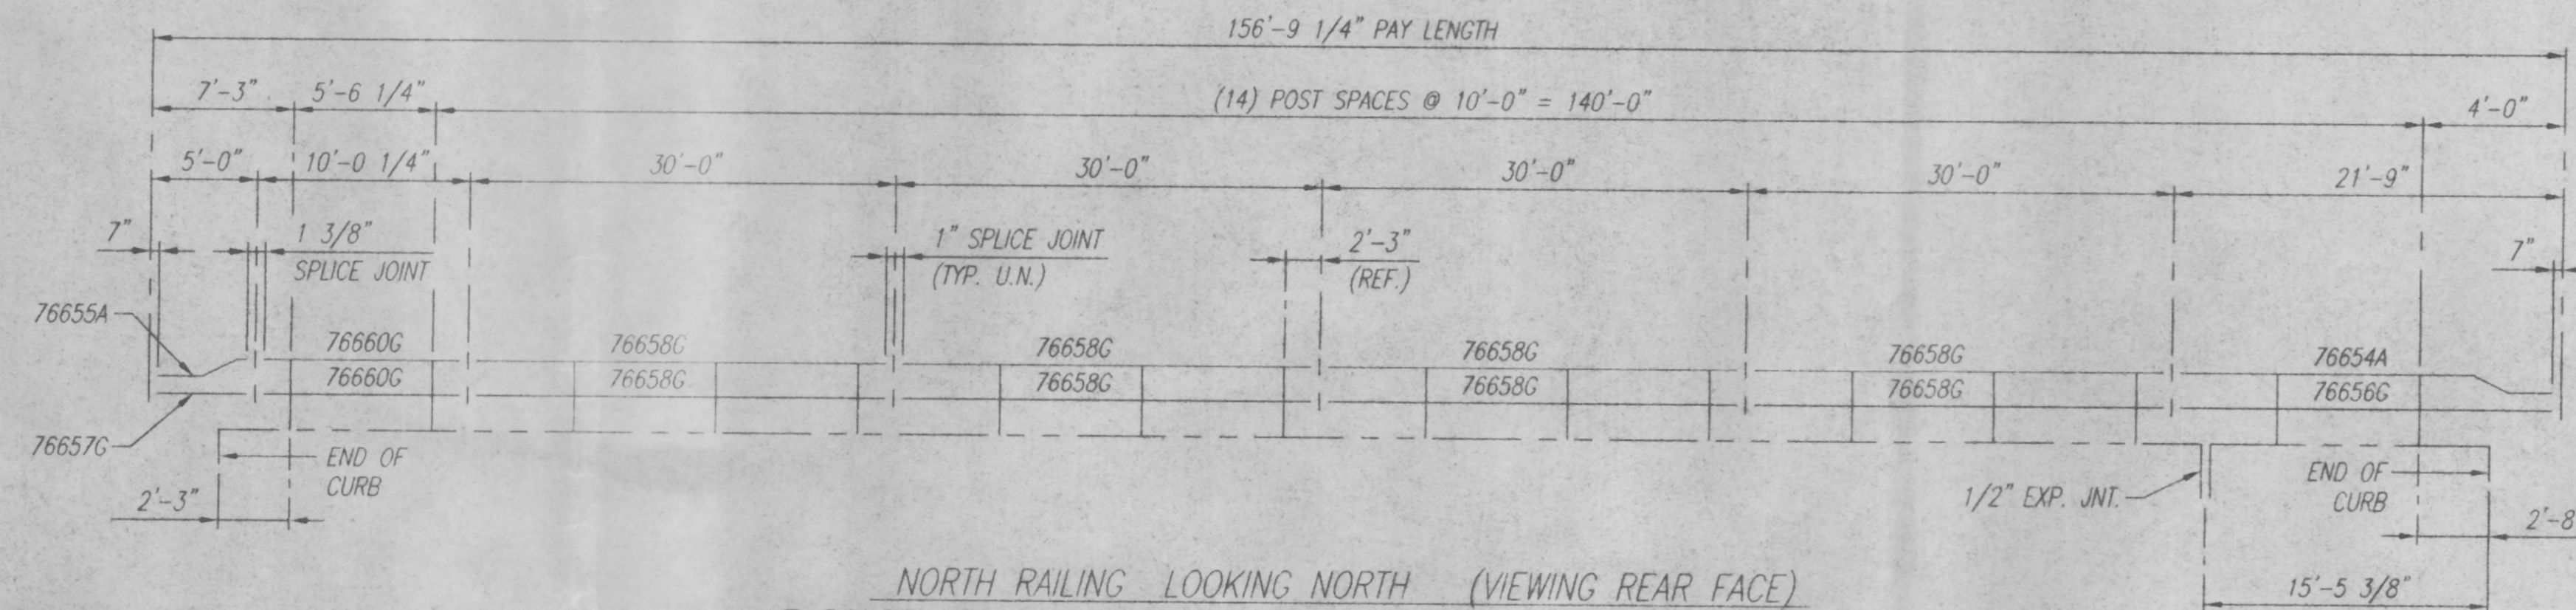

NORTH RAILING LOOKING NORTH (VIEWING REAR FACE)
VT ROUTE 12A OVER THE 3RD BRANCH OF THE WHITE RIVER, BRIDGE No 6

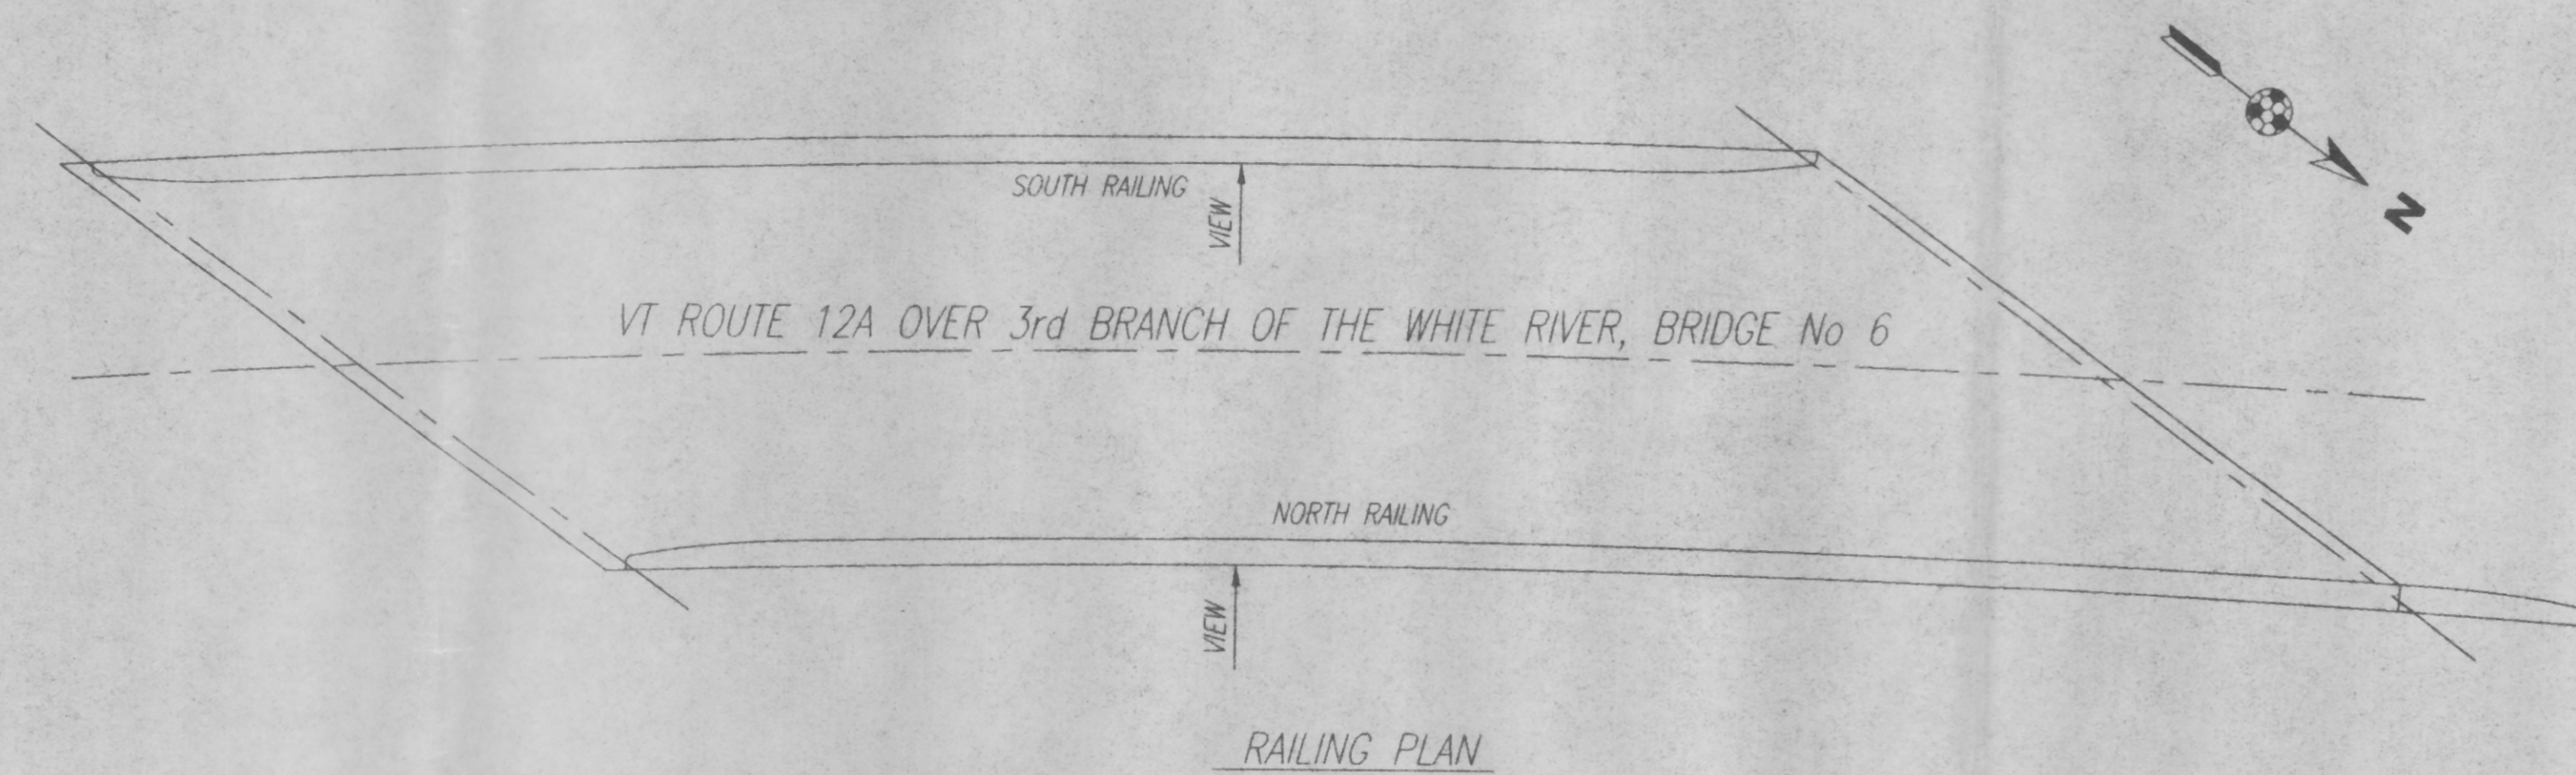

- NOTES:
1. ALL POSTS ARE (14392A)
 2. ALL SPLICES ARE (32124A)
 3. INSPECTED BY CONWELL
 4. FINISH: GALV A123
 5. TOTAL PAY LENGTH 295'-0"

This drawing and the information shown thereon is the sole property of TRINITY INDUSTRIES, INC. Neither the drawing nor such information is to be used for any purpose other than that for which it was specifically furnished by TRINITY INDUSTRIES, INC. nor is any reproduction authorized without written permission.