




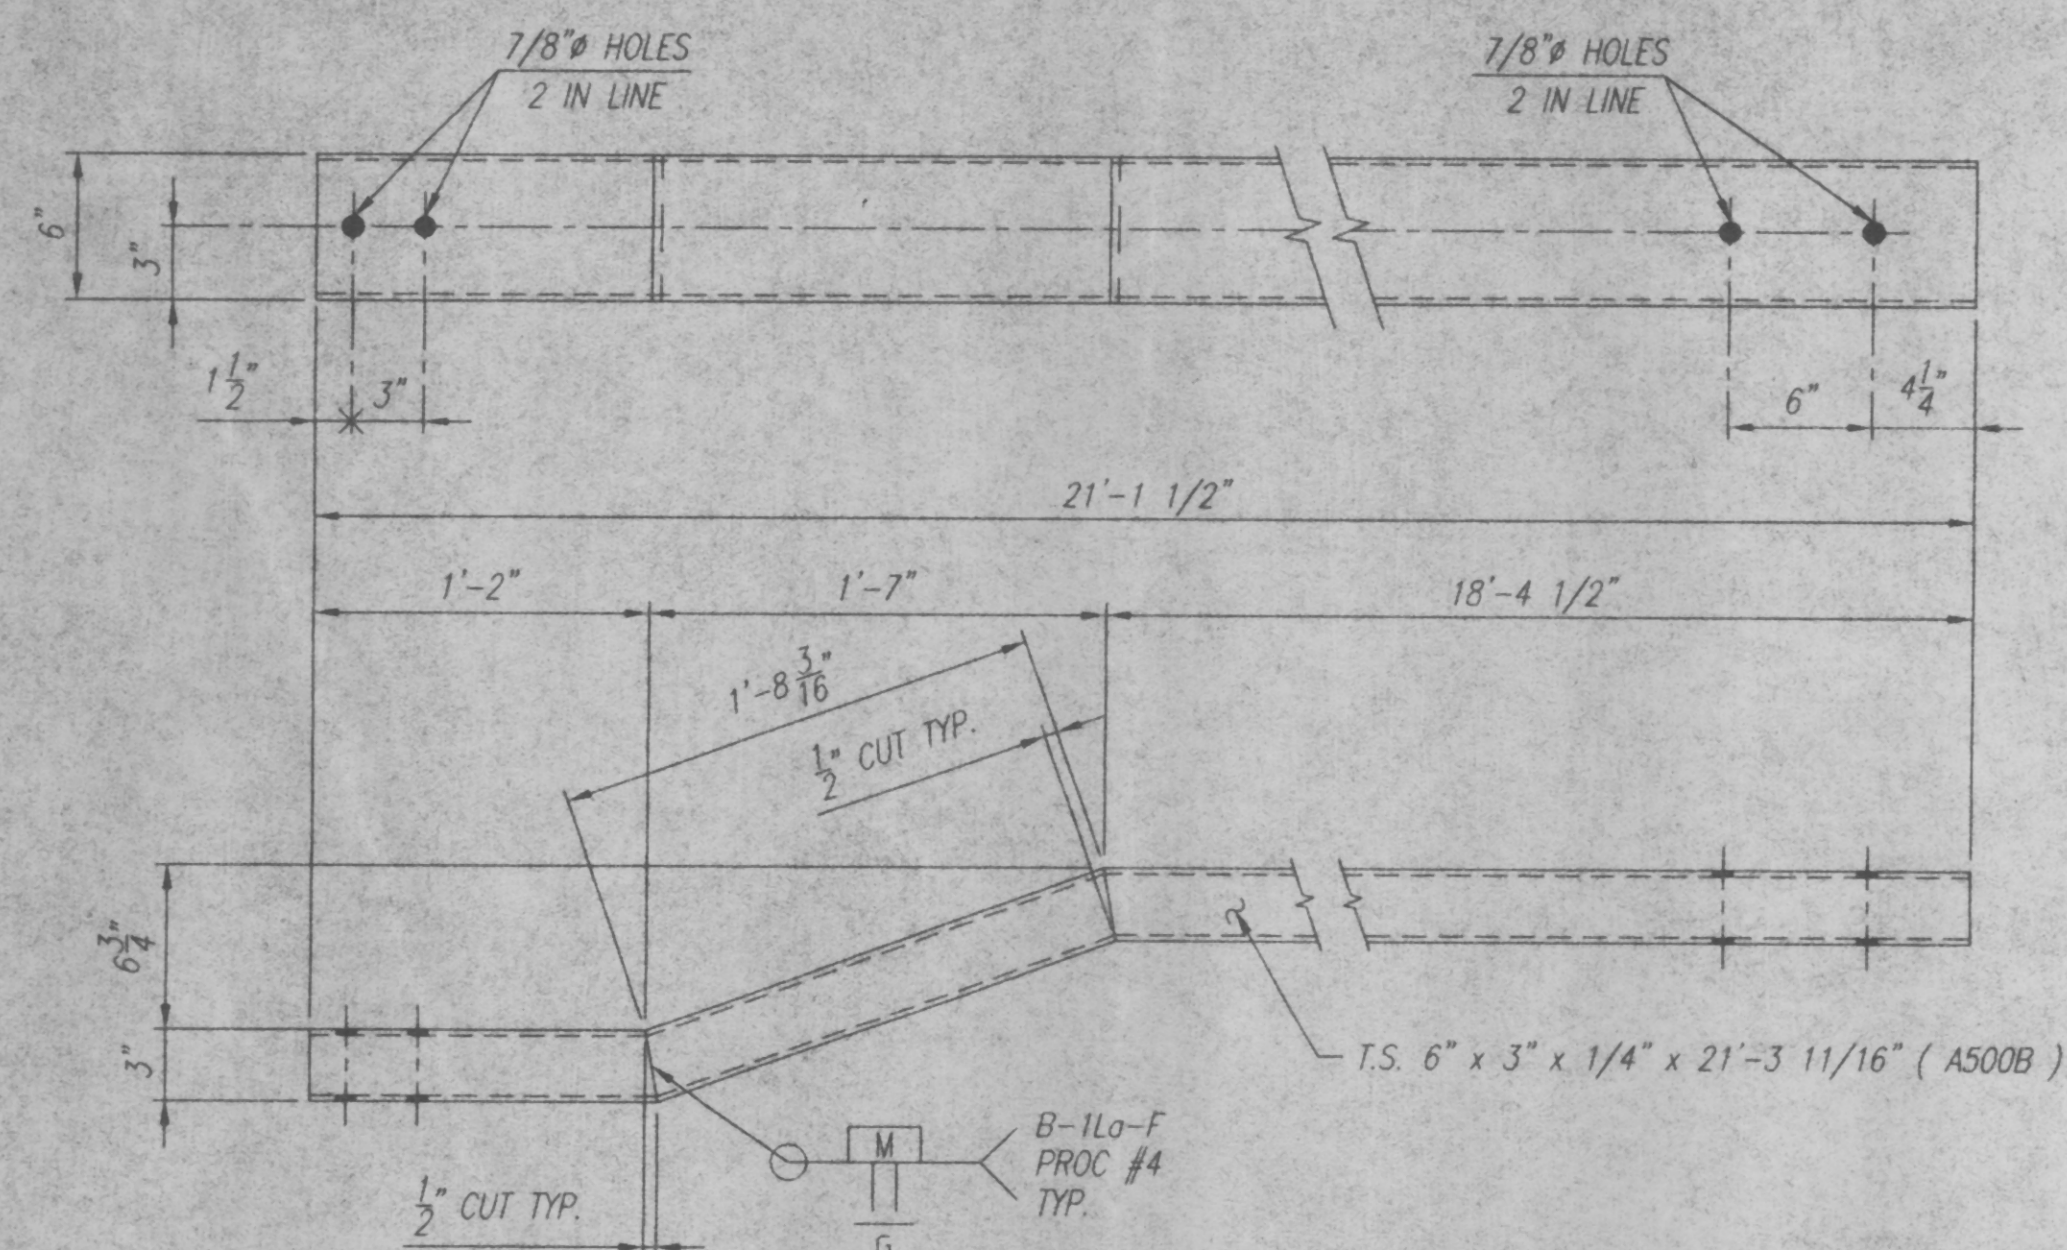


2 ~ END RAILS ~ 76654A

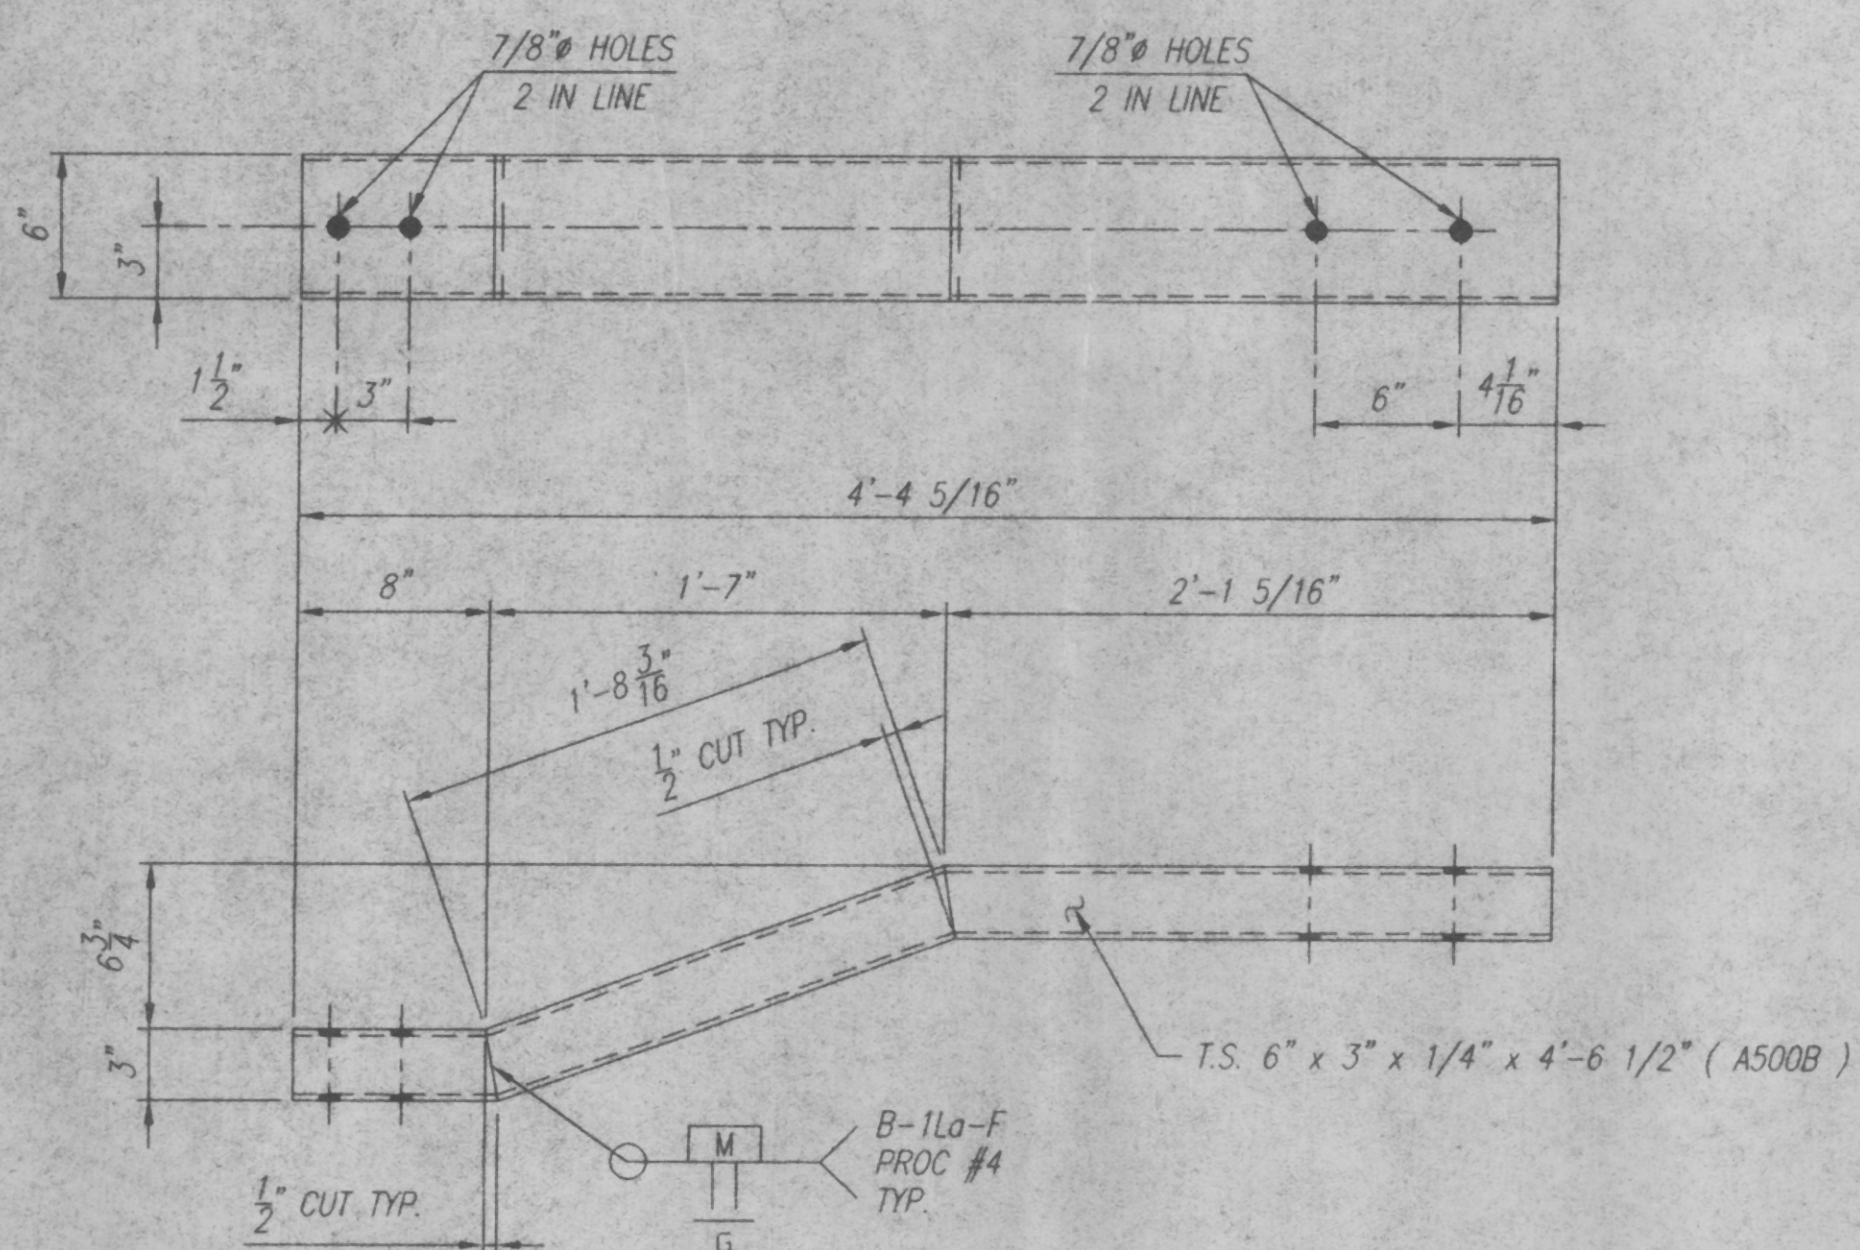


2 ~ END RAILS ~ 76655A

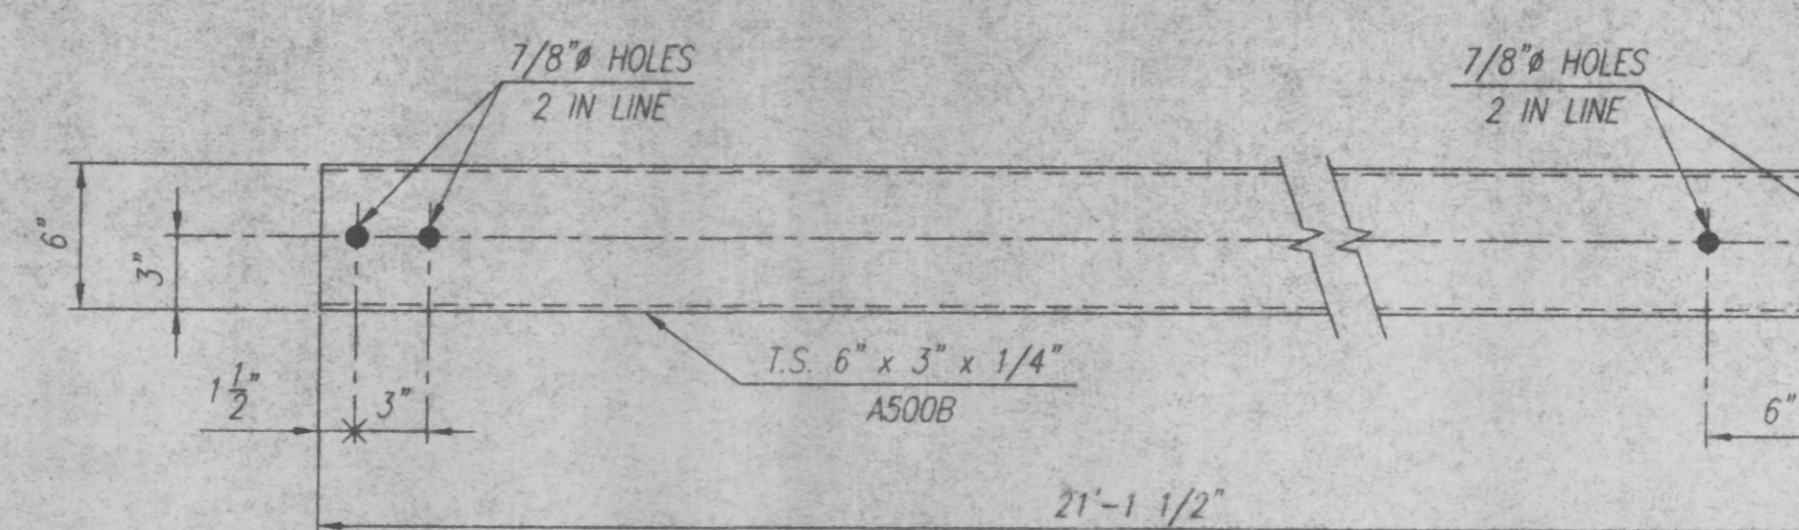


2 ~ END RAILS ~ 76656G

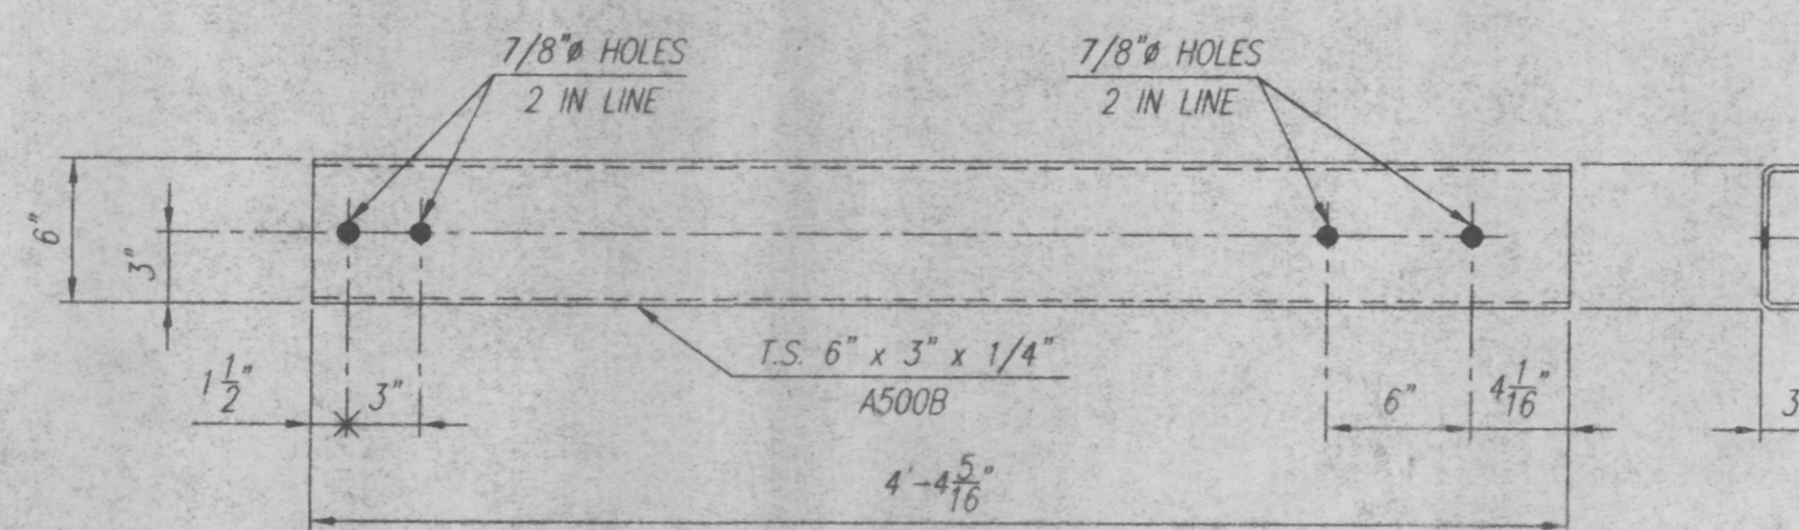

2 ~ END RAILS ~ 76657G

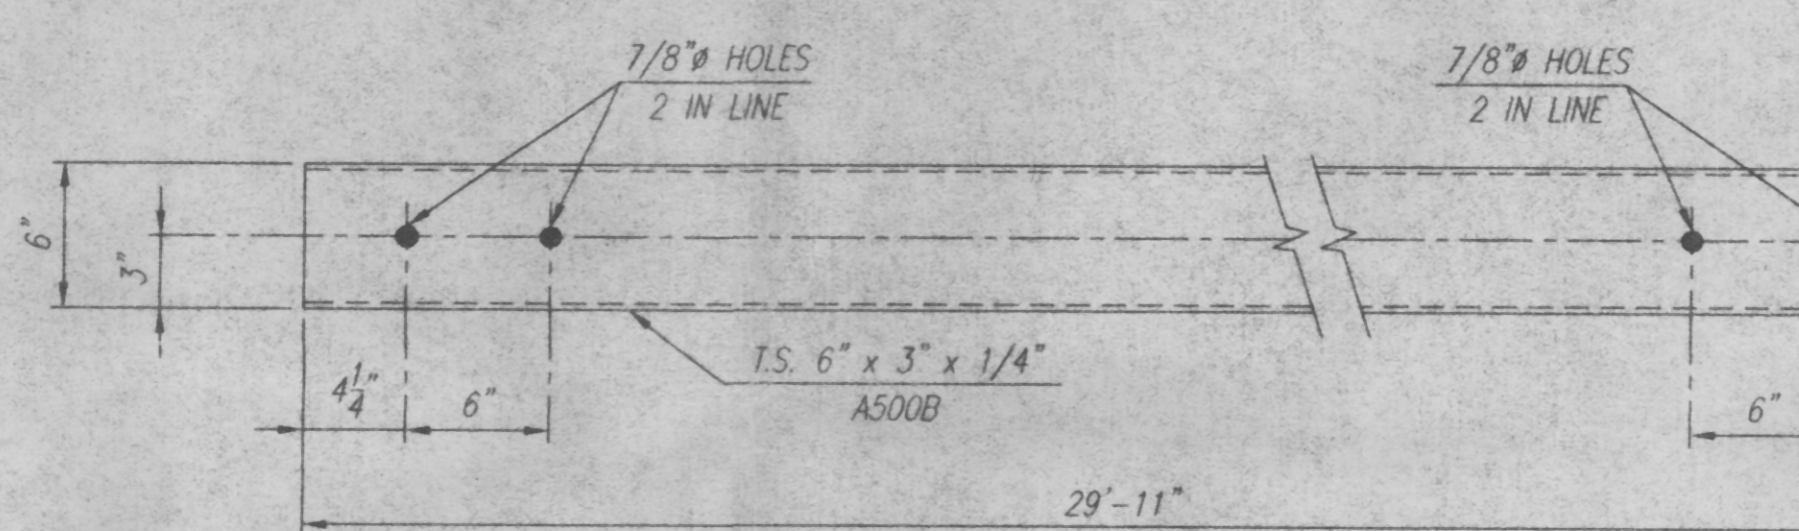

14 ~ RAILS ~ 76658G

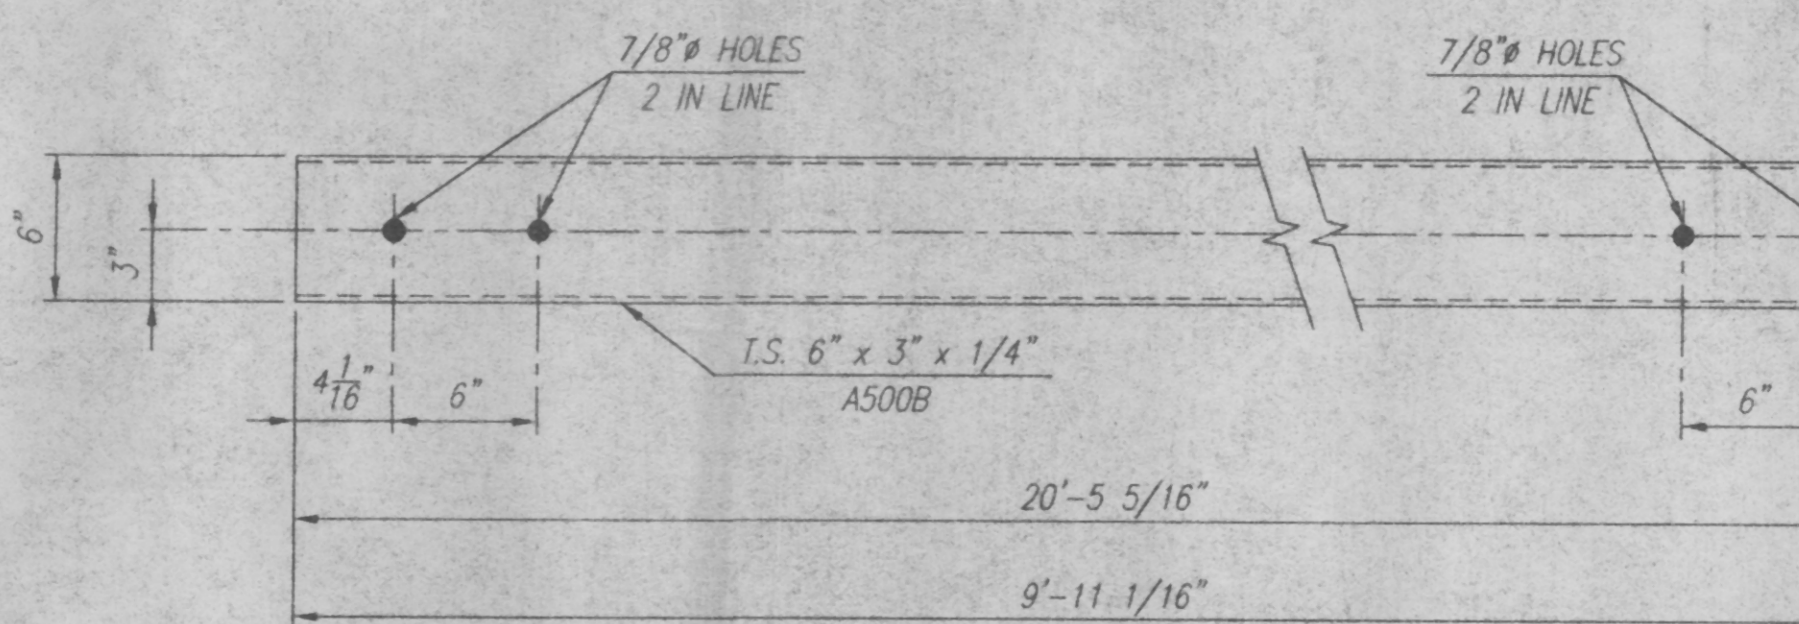

2 ~ RAILS (AS NOTED) ~ 76659G

2 ~ RAILS (AS NOTED) ~ 76660G