
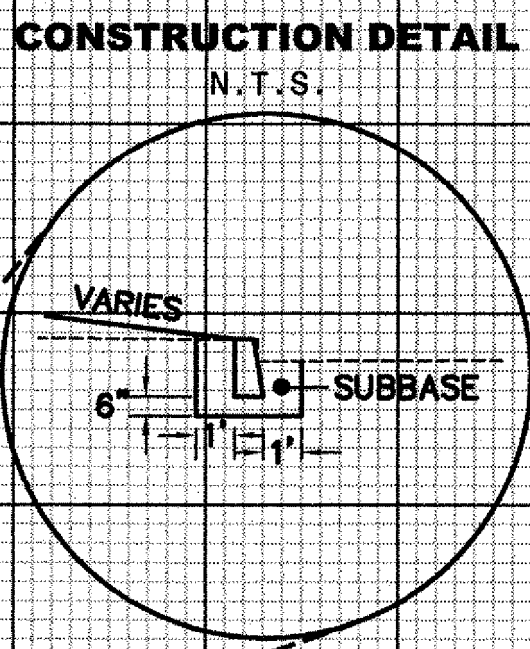


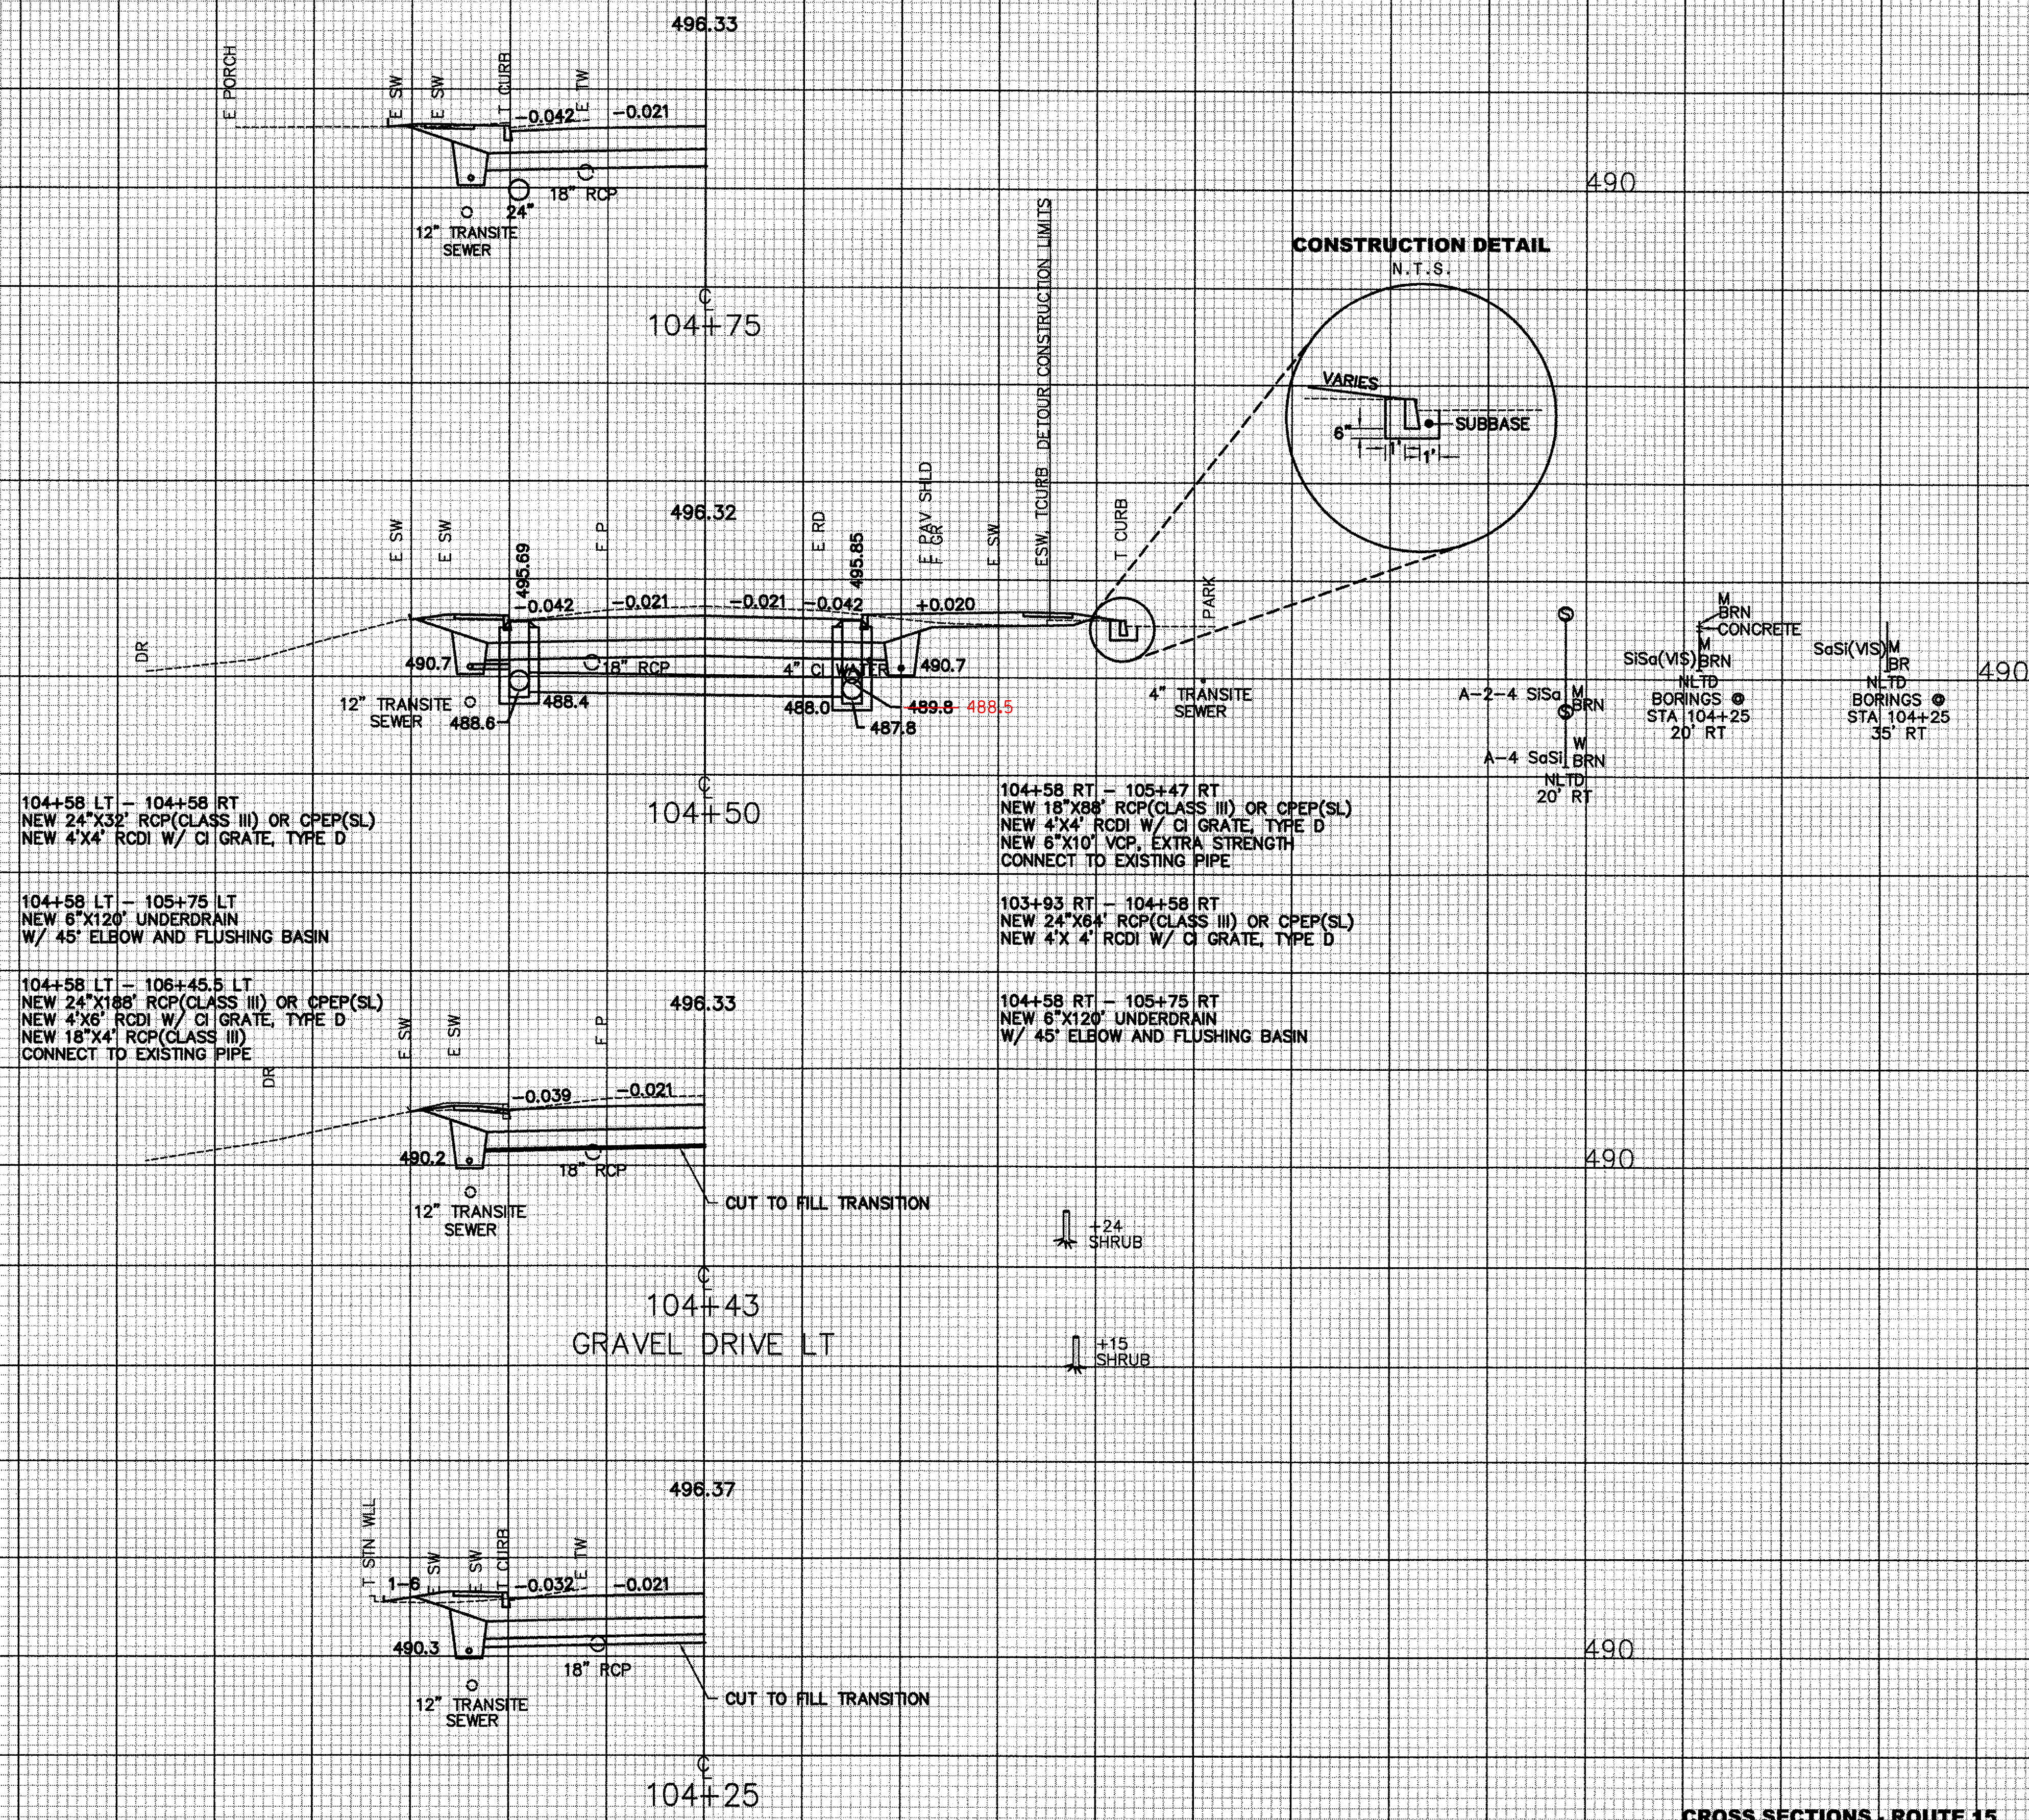

104+58 LT - 104+58 RT
NEW 24"x32" RCP(CLASS III) OR CPEP(SL)
NEW 4'X4' RCDI W/ CI GRATE, TYPE D

104+58 LT - 105+75 LT
NEW 6"x120" UNDERDRAIN
W/ 45' ELBOW AND FLUSHING BASIN

104+58 LT - 106+45.5 LT
NEW 24"x188" RCP(CLASS III) OR CPEP(SL)
NEW 4'X6' RCDI W/ CI GRATE, TYPE D
NEW 18"X4" RCP(CLASS III)
CONNECT TO EXISTING PIPE

104+58 RT - 105+47 RT
NEW 18"X88" RCP(CLASS III) OR CPEP(SL)
NEW 4'X4' RCDI W/ CI GRATE, TYPE D
NEW 6"x10' VCP, EXTRA STRENGTH
CONNECT TO EXISTING PIPE

103+93 RT - 104+58 RT
NEW 24"x64" RCP(CLASS III) OR CPEP(SL)
NEW 4'X4' RCDI W/ CI GRATE, TYPE D

104+58 RT - 105+75 RT
NEW 6"x120" UNDERDRAIN
W/ 45' ELBOW AND FLUSHING BASIN

A-2-4 SiSa M
NLTD
20' RT

A-4 SaSi BRN
NLTD
20' RT

SiSa(VIS) BRN
NLTD
BORINGS @
STA 104+25
20' RT

SaSi(VIS) BRN
NLTD
BORINGS @
STA 104+25
35' RT

CROSS SECTIONS - ROUTE 15

FROM STA.	104+25	TO STA.	104+75
PROJECT NAME	JOHNSON	VT ROUTE 15	
NO.	030-2(17)S	PLOTTED	12/30/87
SURVEYED BY	SARGENT	DEC.	1987
SHEET	73	OF	85 SHEETS

SCALE 10 FEET