


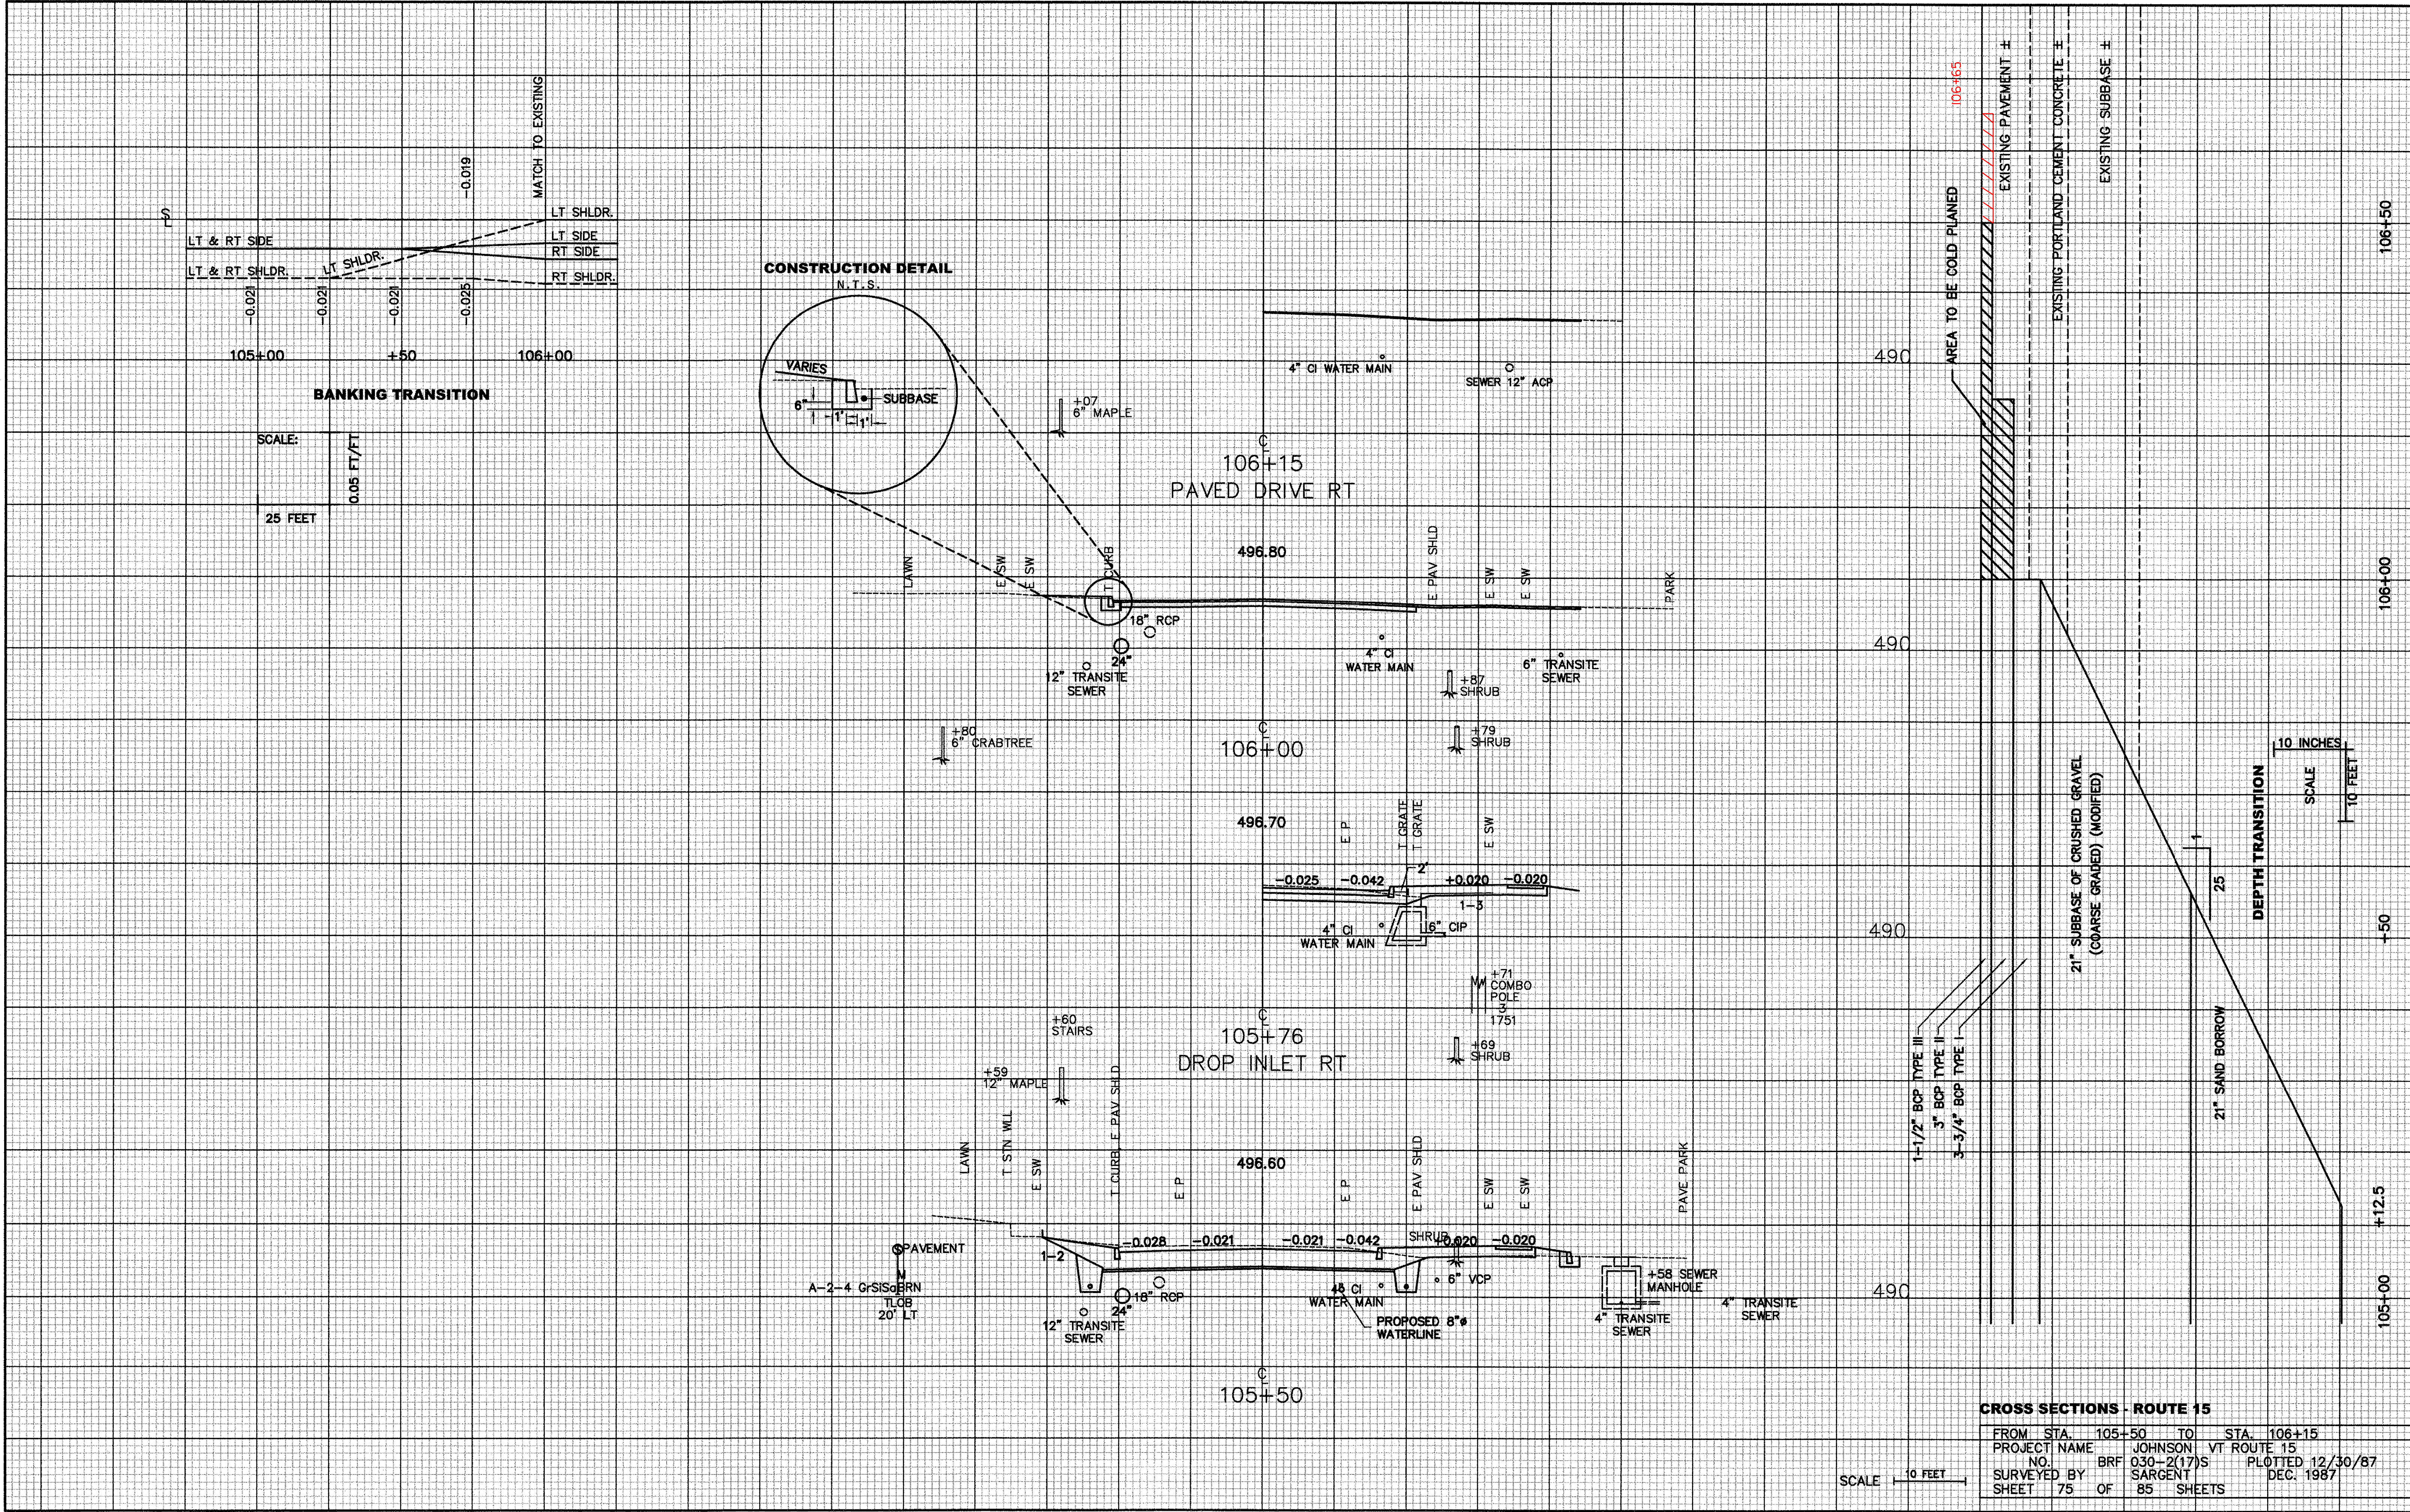

CROSS SECTIONS - ROUTE 15			
FROM STA.	105+50	TO STA.	106+15
PROJECT NAME	JOHNSON VT ROUTE 15		
NO.	030-2(17)S	PLOTTED	12/30/87
SURVEYED BY	SARGENT	DEC.	1987
SHEET	75	OF	85 SHEETS