


FINAL SURVEY NO.	SURVEYED PLOTTED DATE AREAS CHECKED	BY	DATE

ORIGINAL SURVEY NO.	SURVEYED PLOTTED DATE AREAS CHECKED	BY	DATE

1/2" = 10' (1" = 10')

NOTE: DO NOT PLACE GRUBBING MATERIAL
UNDER OR WITHIN 10' OF PROPOSED
SUPERSTRUCTURE.

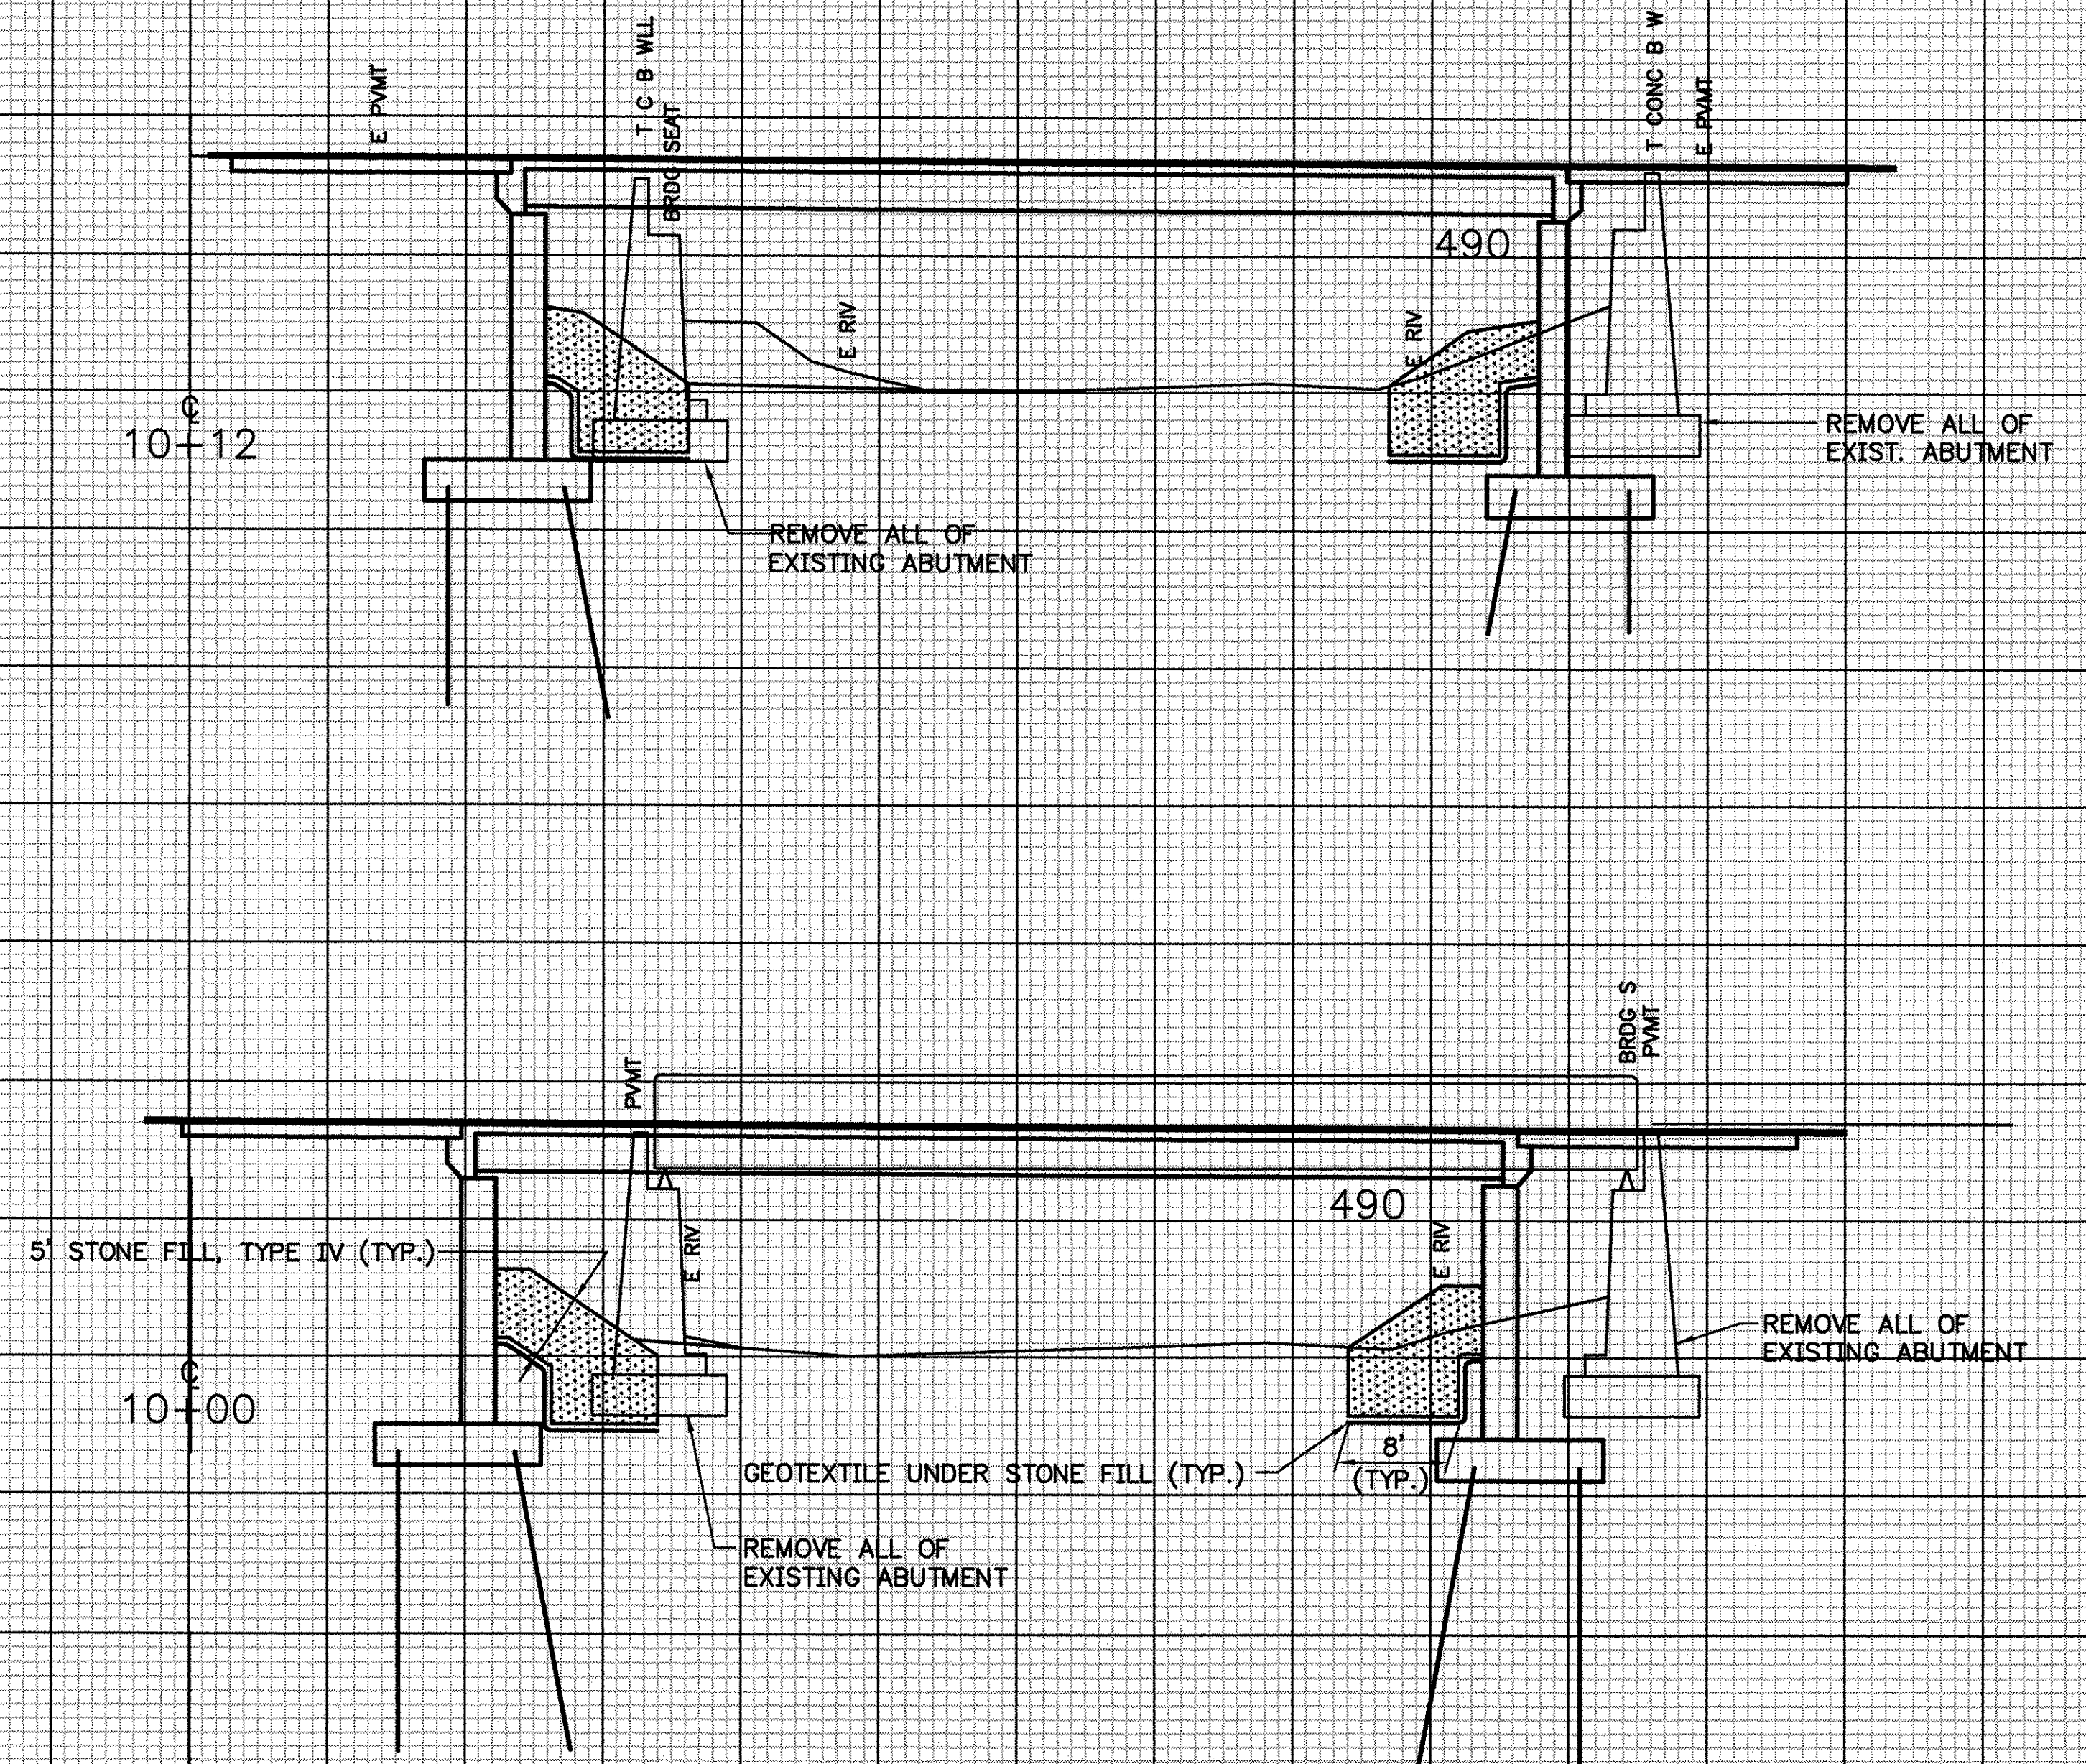

CROSS SECTIONS - CHANNEL

FROM STA.	10+00	TO STA.	10+12
PROJECT NAME	JOHNSON	CHANNEL LINE	
NO.	BRF030-2 (17)S	PLOTTED	12/30/87
SURVEYED BY	SARGENT	DEC.	1987
SHEET	82 OF 85 SHEETS		

SCALE 1" = 10 FEET