


FINAL SURVEY NOTEBOOK	NO.	SURVEYED PLOTTED DATE AREAS CHECKED	BY	DATE

ORIGINAL SURVEY NOTEBOOK	NO.	SURVEYED PLOTTED DATE AREAS CHECKED	BY	DATE

1/24/88 DWG C-10

F:\Proj\00-94-91255 Johnson\BRIDGE\91256-1022-26-97 104417.dwg EOT

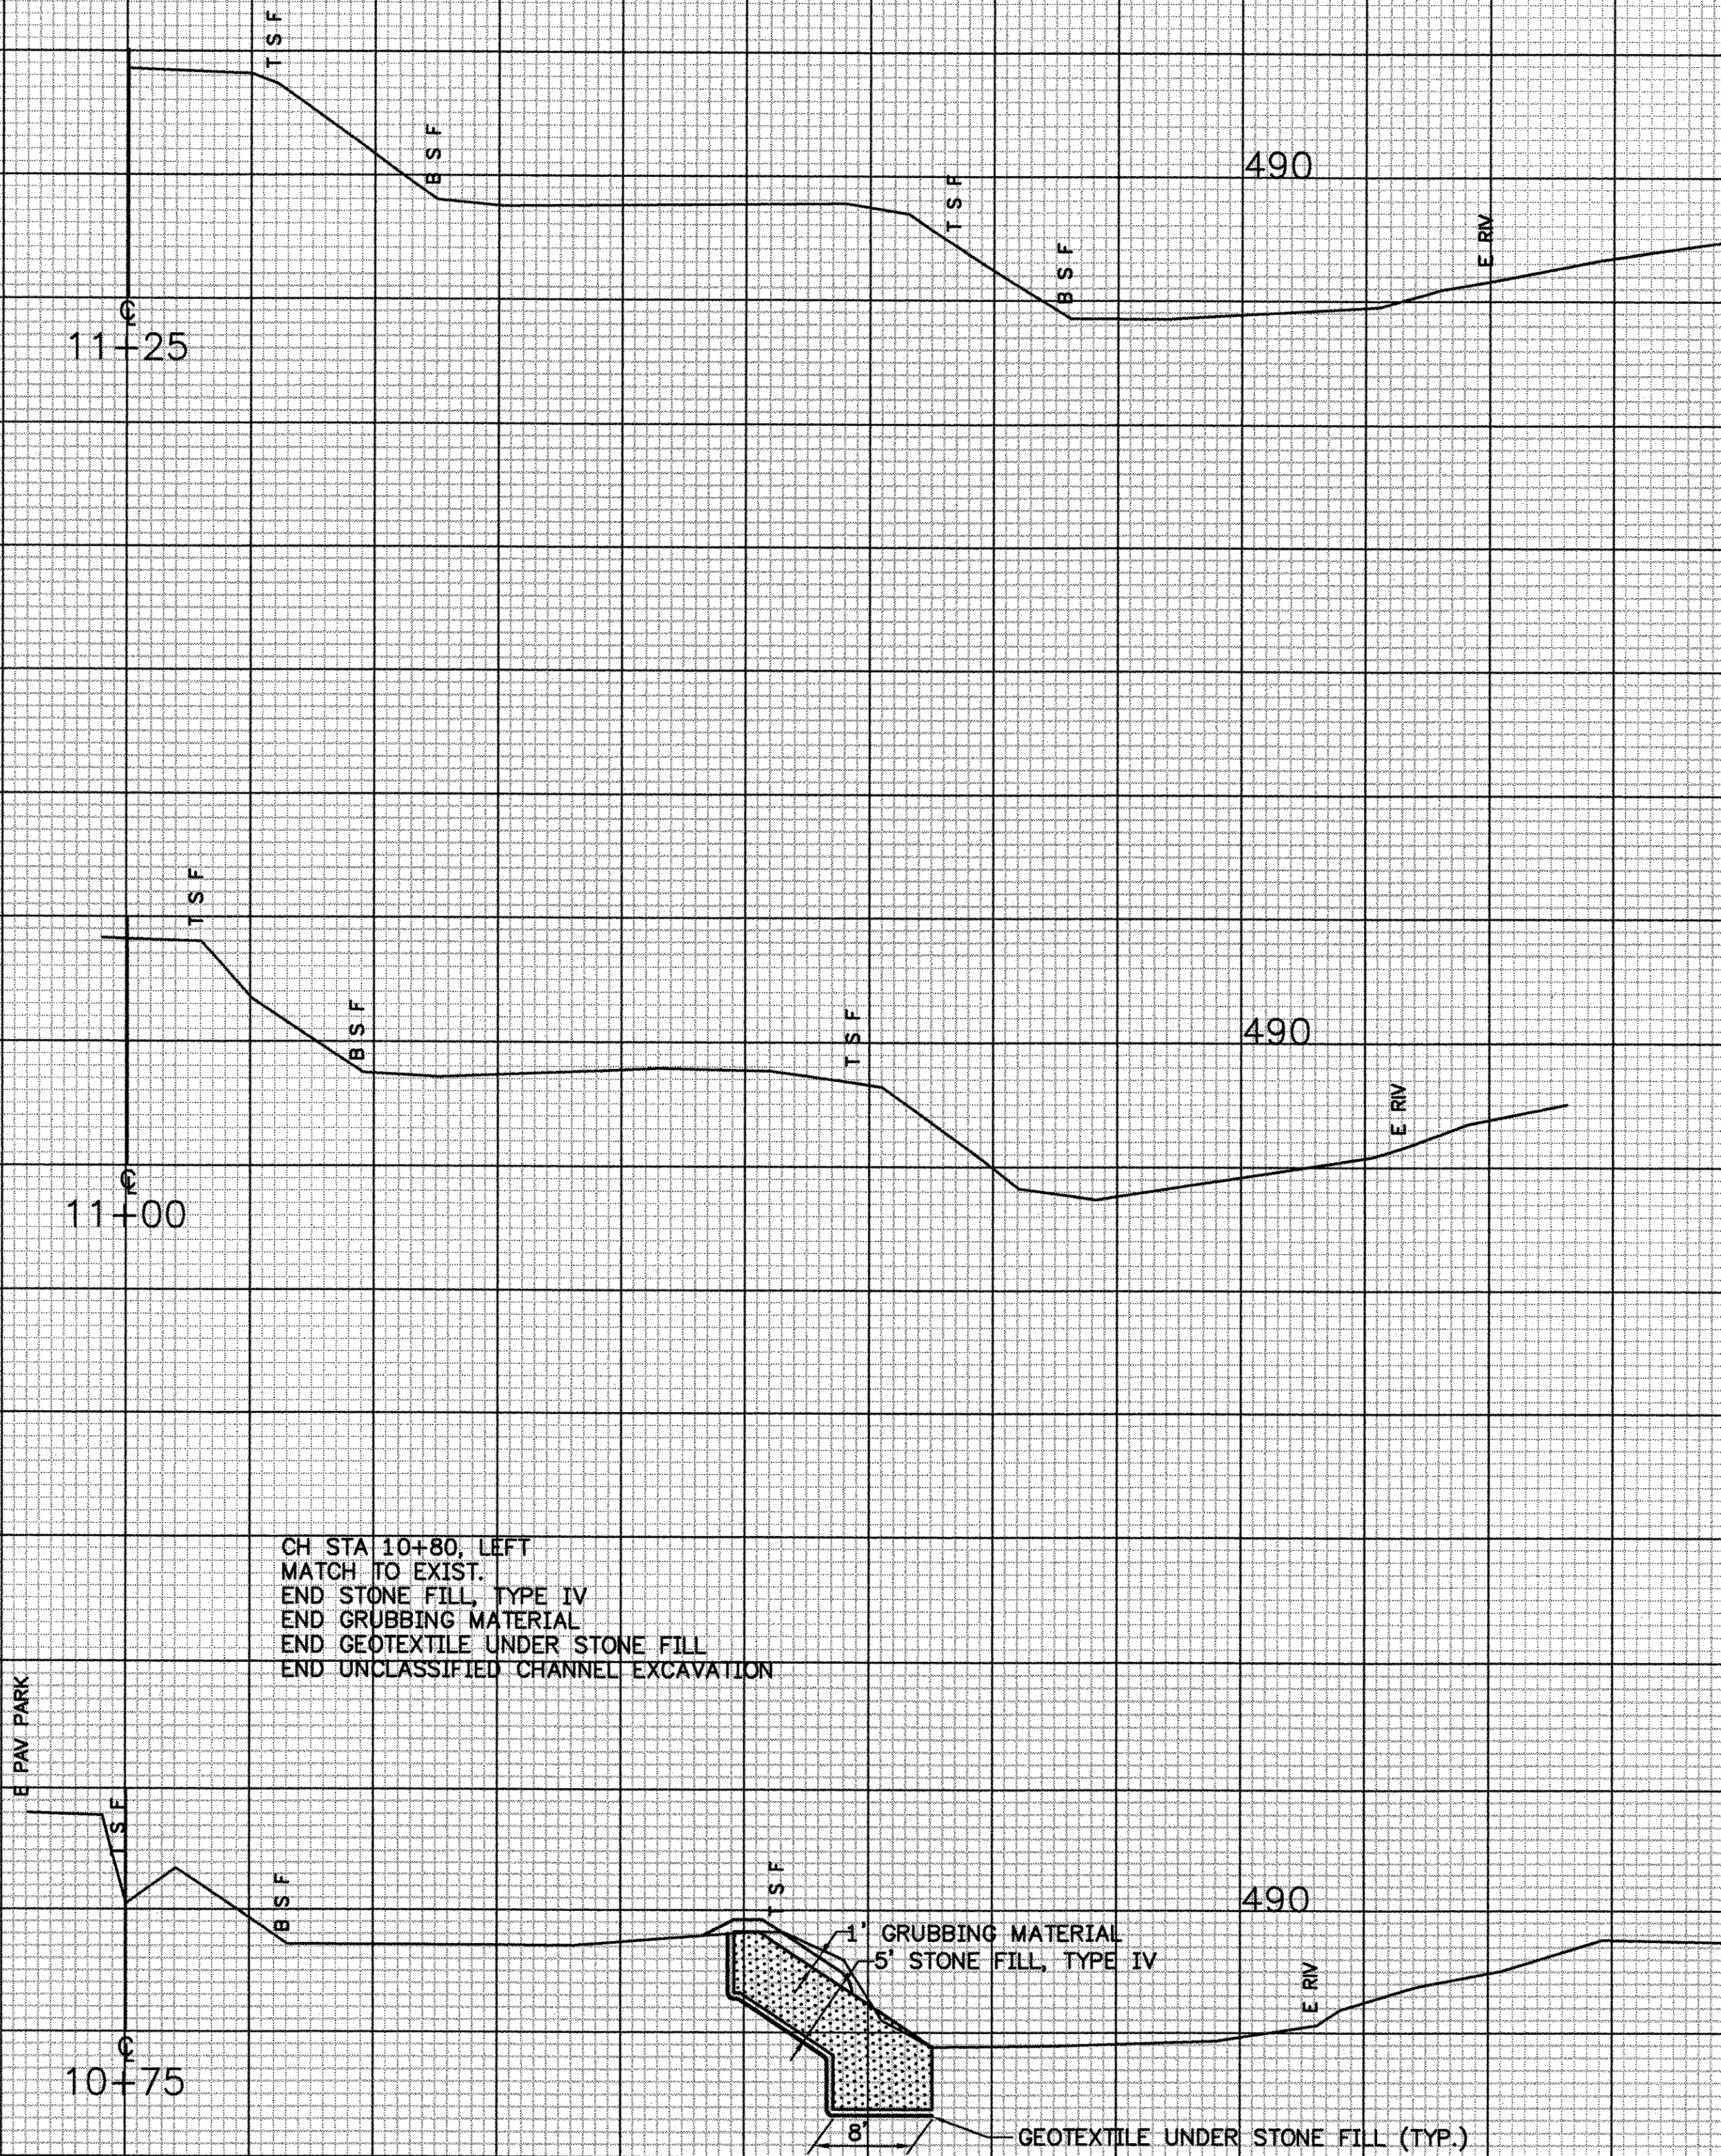

CROSS SECTIONS - CHANNEL

FROM STA.	10+75	TO STA.	11+25
PROJECT NAME	JOHNSON	CHANNEL LINE	
NO.	BRF030-2 (17)	S	PLOTTED 12/30/87
SURVEYED BY	SARGENT		DEC. 1987
SHEET	85 OF 85	SHEETS	

SCALE 10 FEET