
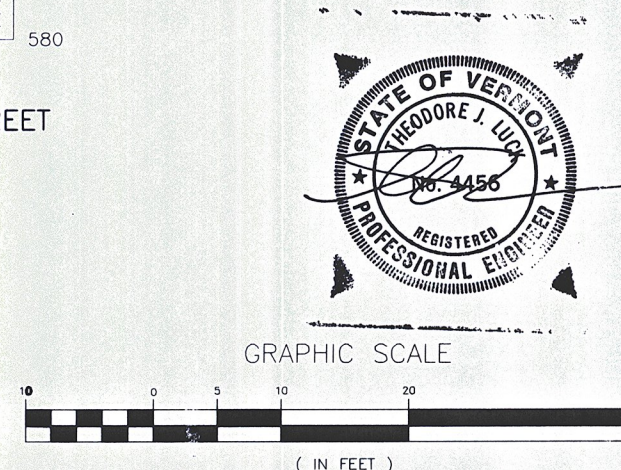
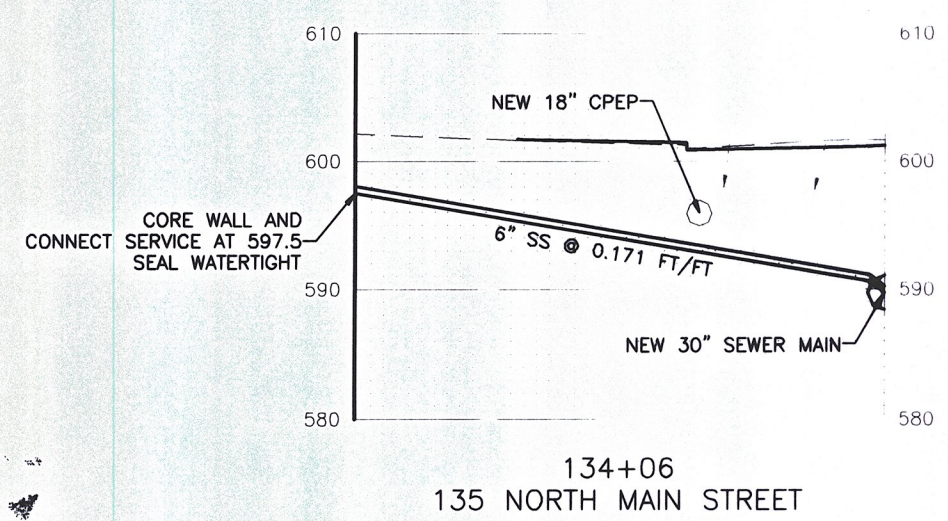
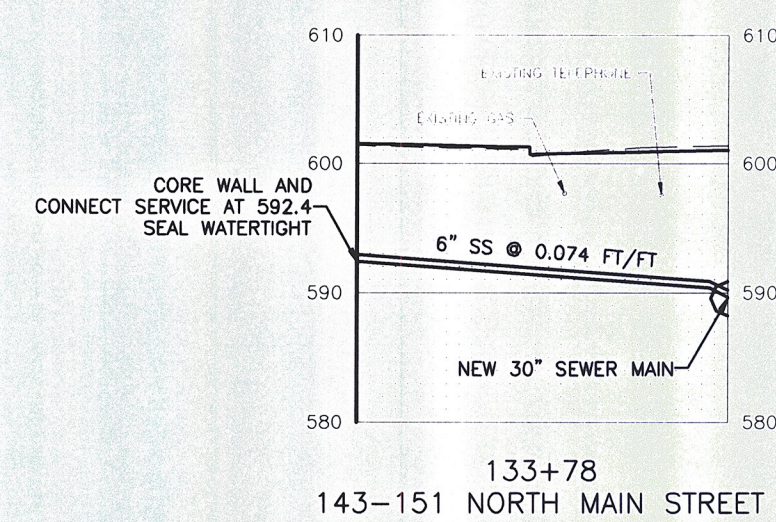
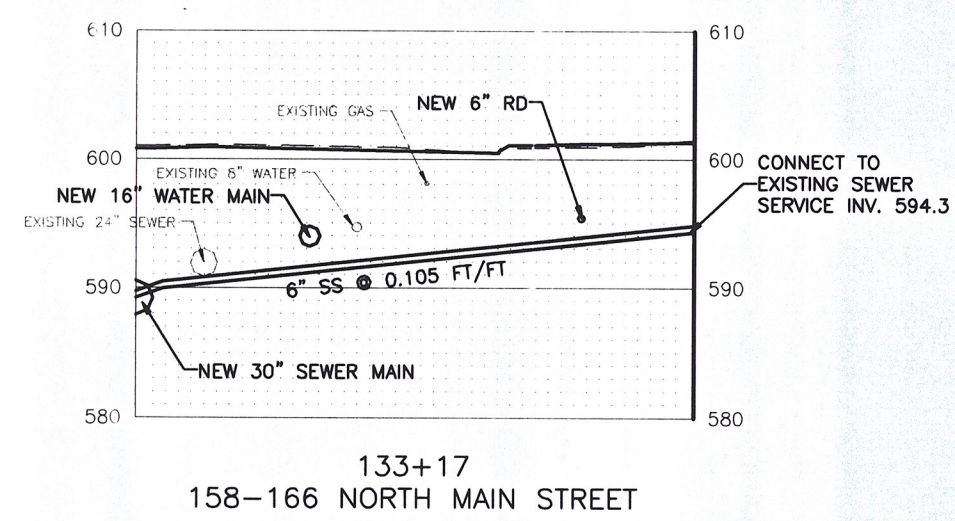
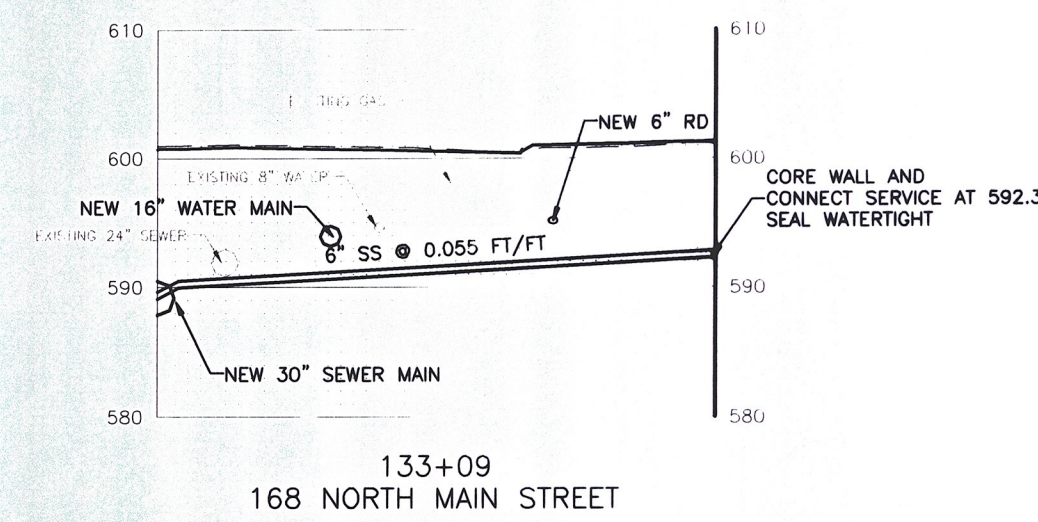
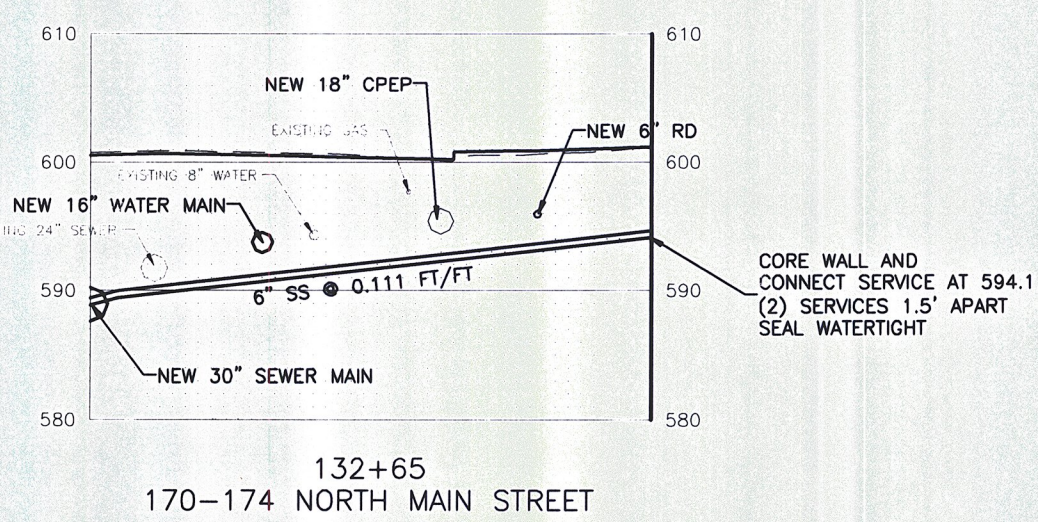
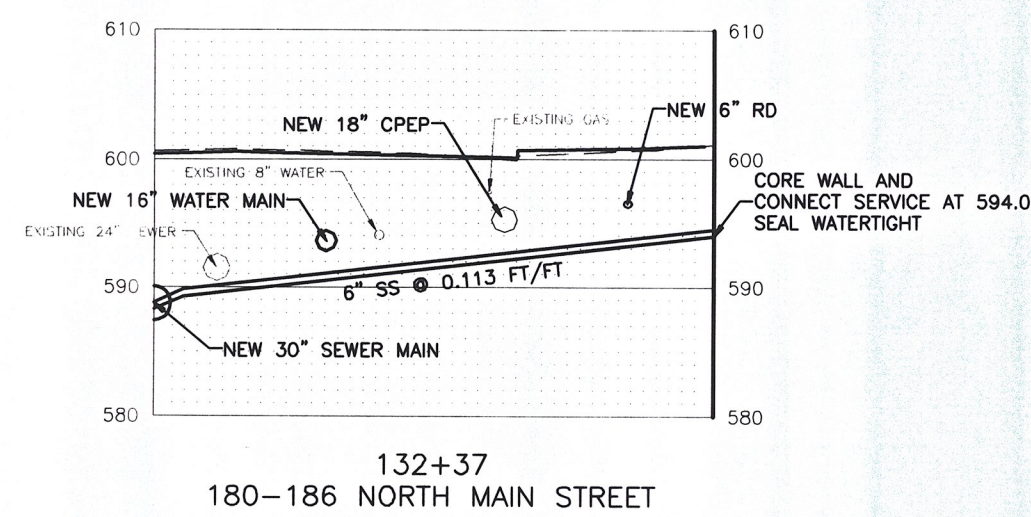
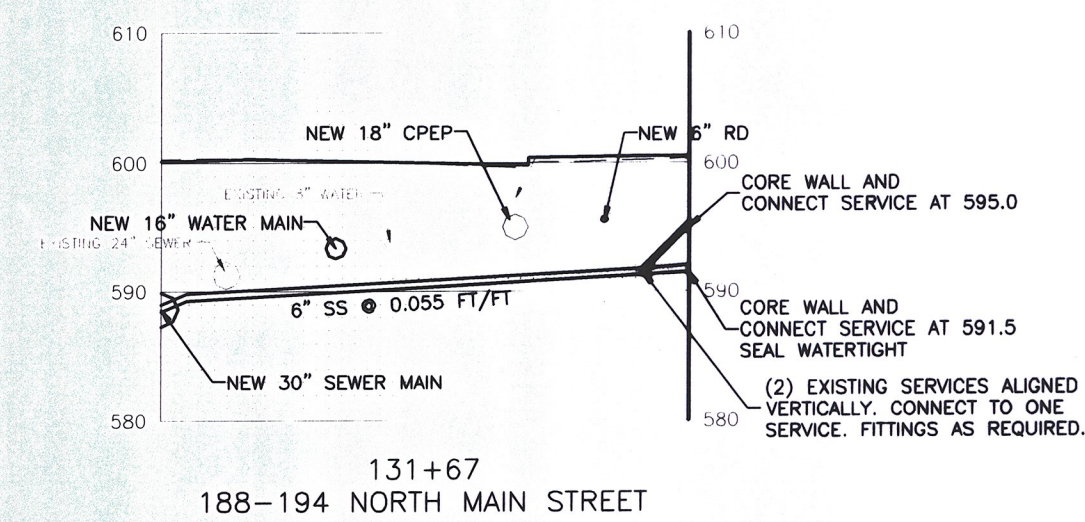
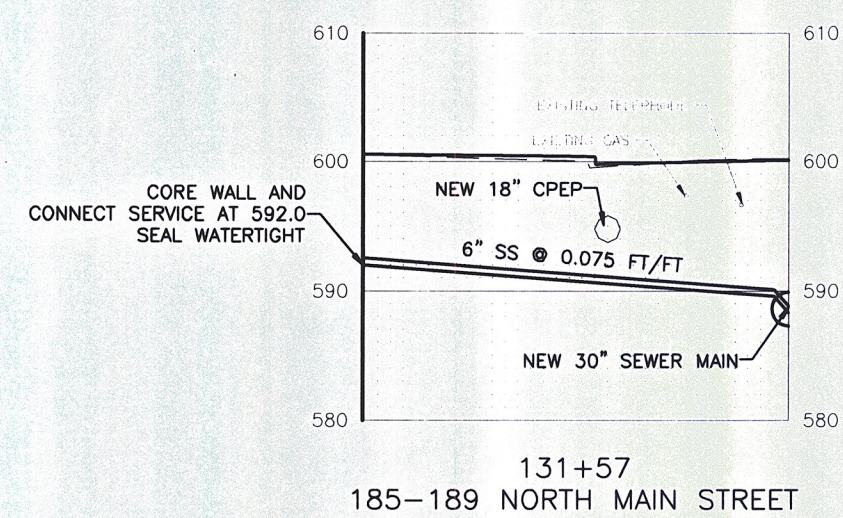
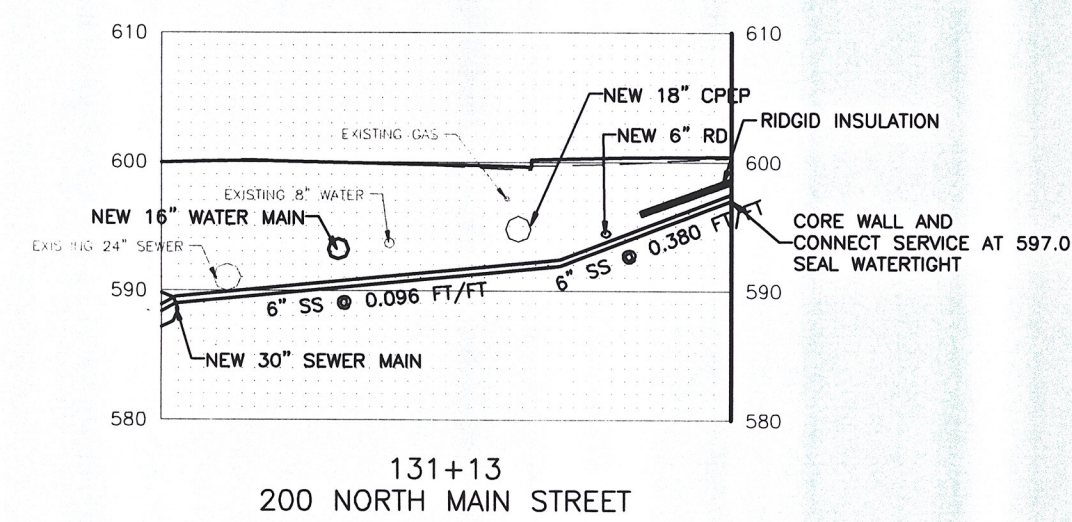


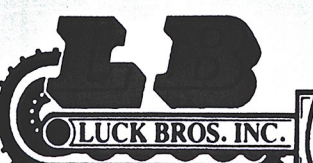

	PROJECT NAME:	BARRE CITY	NOTES / REVISIONS ISSUED: 2/7/2012
	PROJECT NUMBER:	FEGC F 026-134) C/2	
	FILE NAME:	SAN PROFILES	
	MANAGER:	J. LUCK	
	DRAWN BY:	C. KEMPNEY	
PROPOSED REDESIGN SANITARY SEWER PROFILES			
Sheet "147" REVISED			