



18" INV IN (36) = 590.58
 18" INV IN (81) = 590.83
 18" INV IN (82) = 590.73
 10" INV IN = 591.5 (EXIST)
 24" INV OUT (35) = 590.48

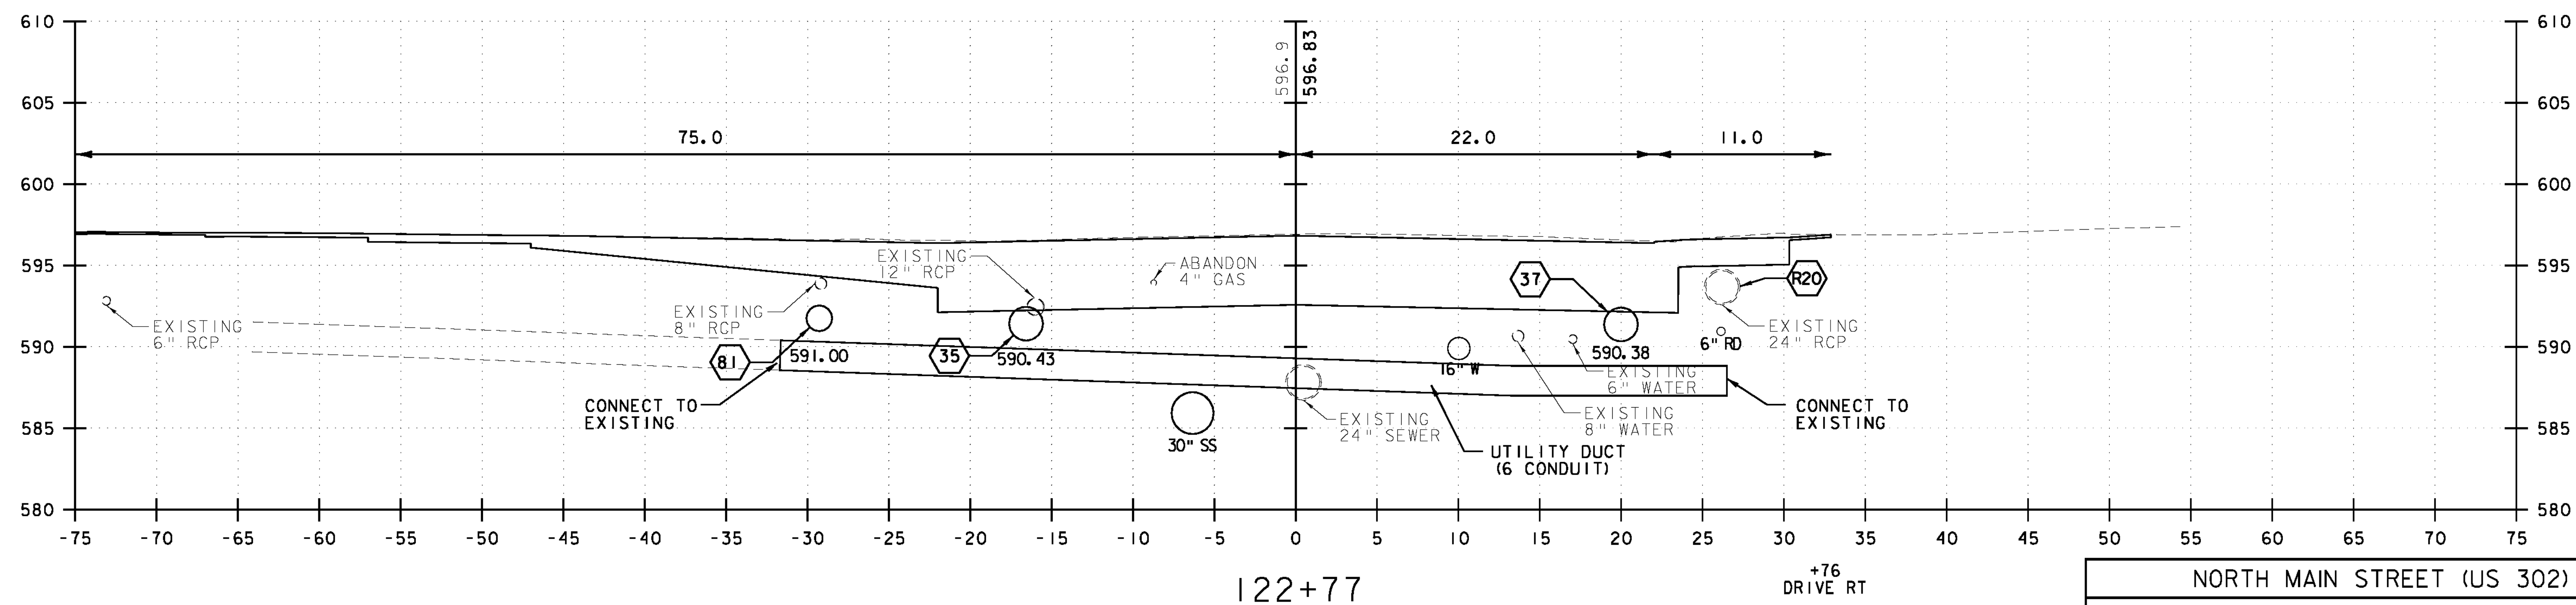

+76
DRIVE RT

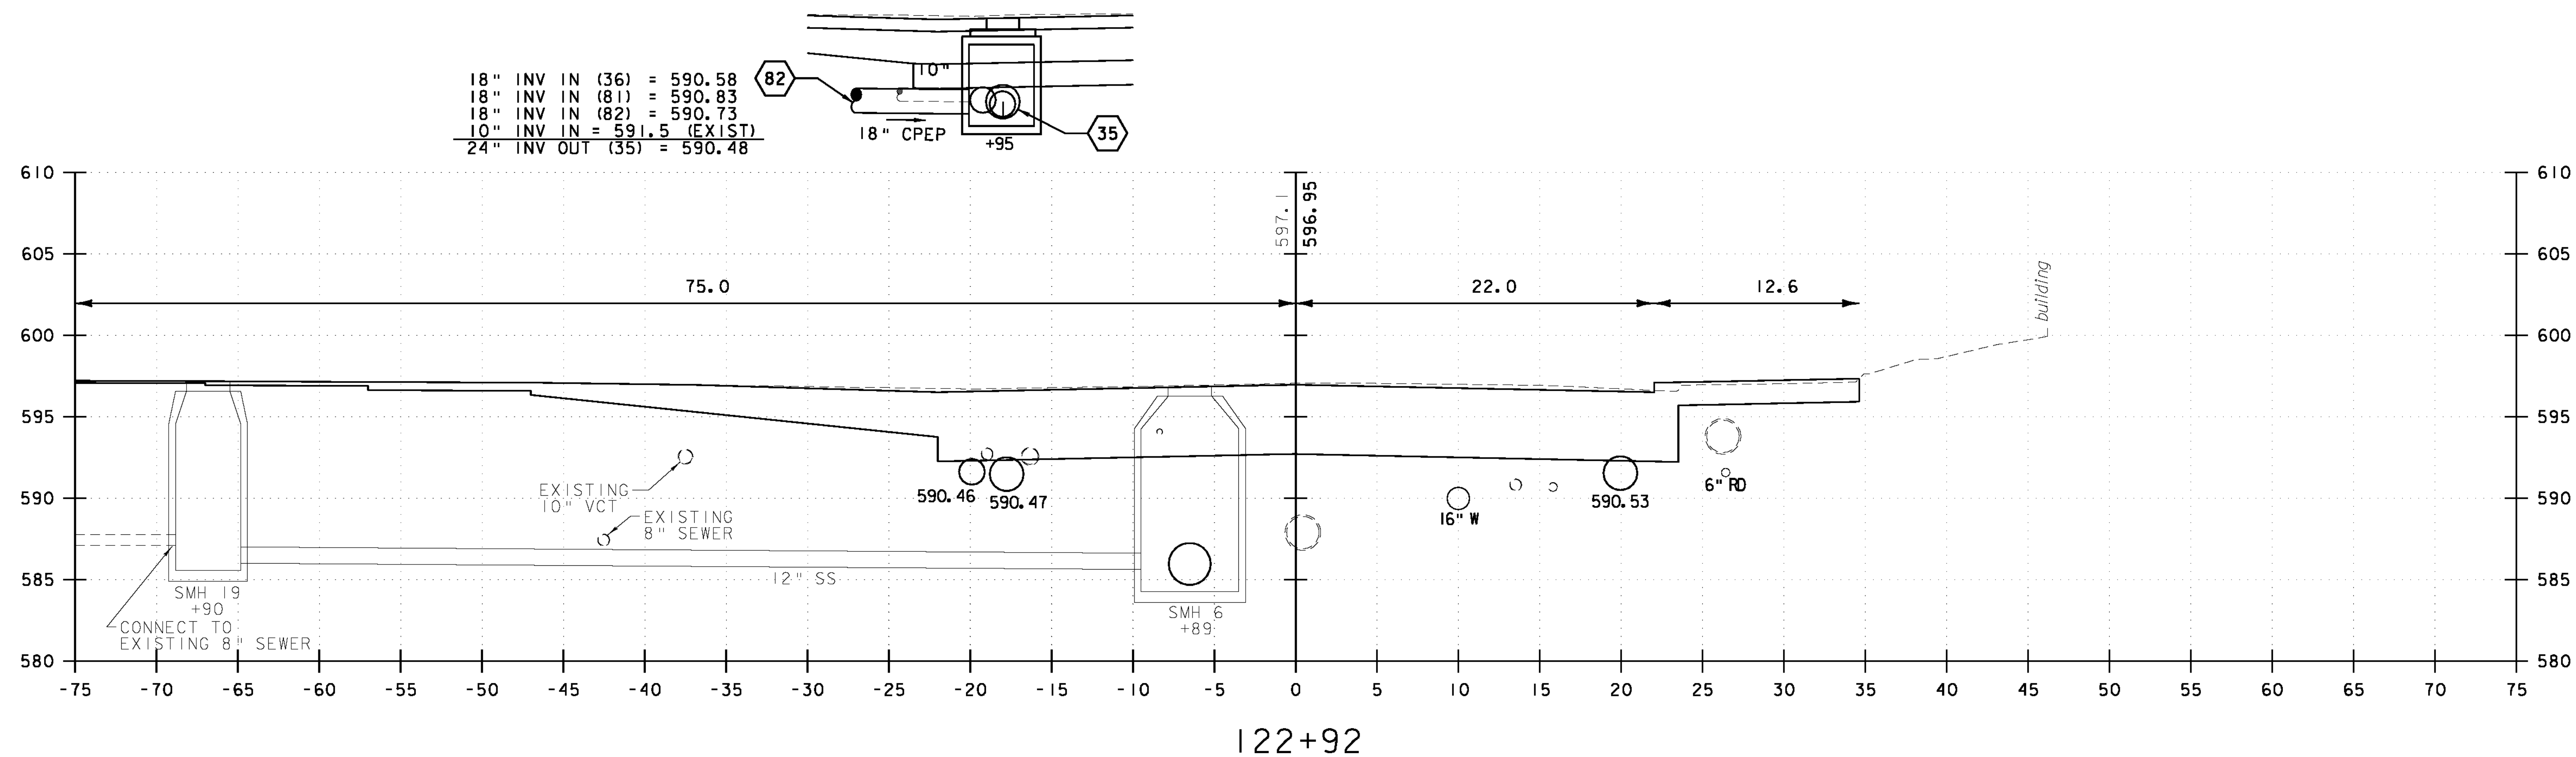

VHB Vanasse Hangen Brustlin, Inc.

NORTH MAIN STREET (US 302)

PROJECT NAME: BARRE CITY
 PROJECT NUMBER: FECC F 026-1(34) C/2

FILE NAME: 85b010_xsl_Cut_C2
 PROJECT LEADER: G. BAKOS
 DESIGNED BY: DMP / MDS
 CROSS SECTIONS

PLOT DATE: 3/9/2011
 DRAWN BY: DMP / JAR
 CHECKED BY:
 SHEET 250 OF 339