




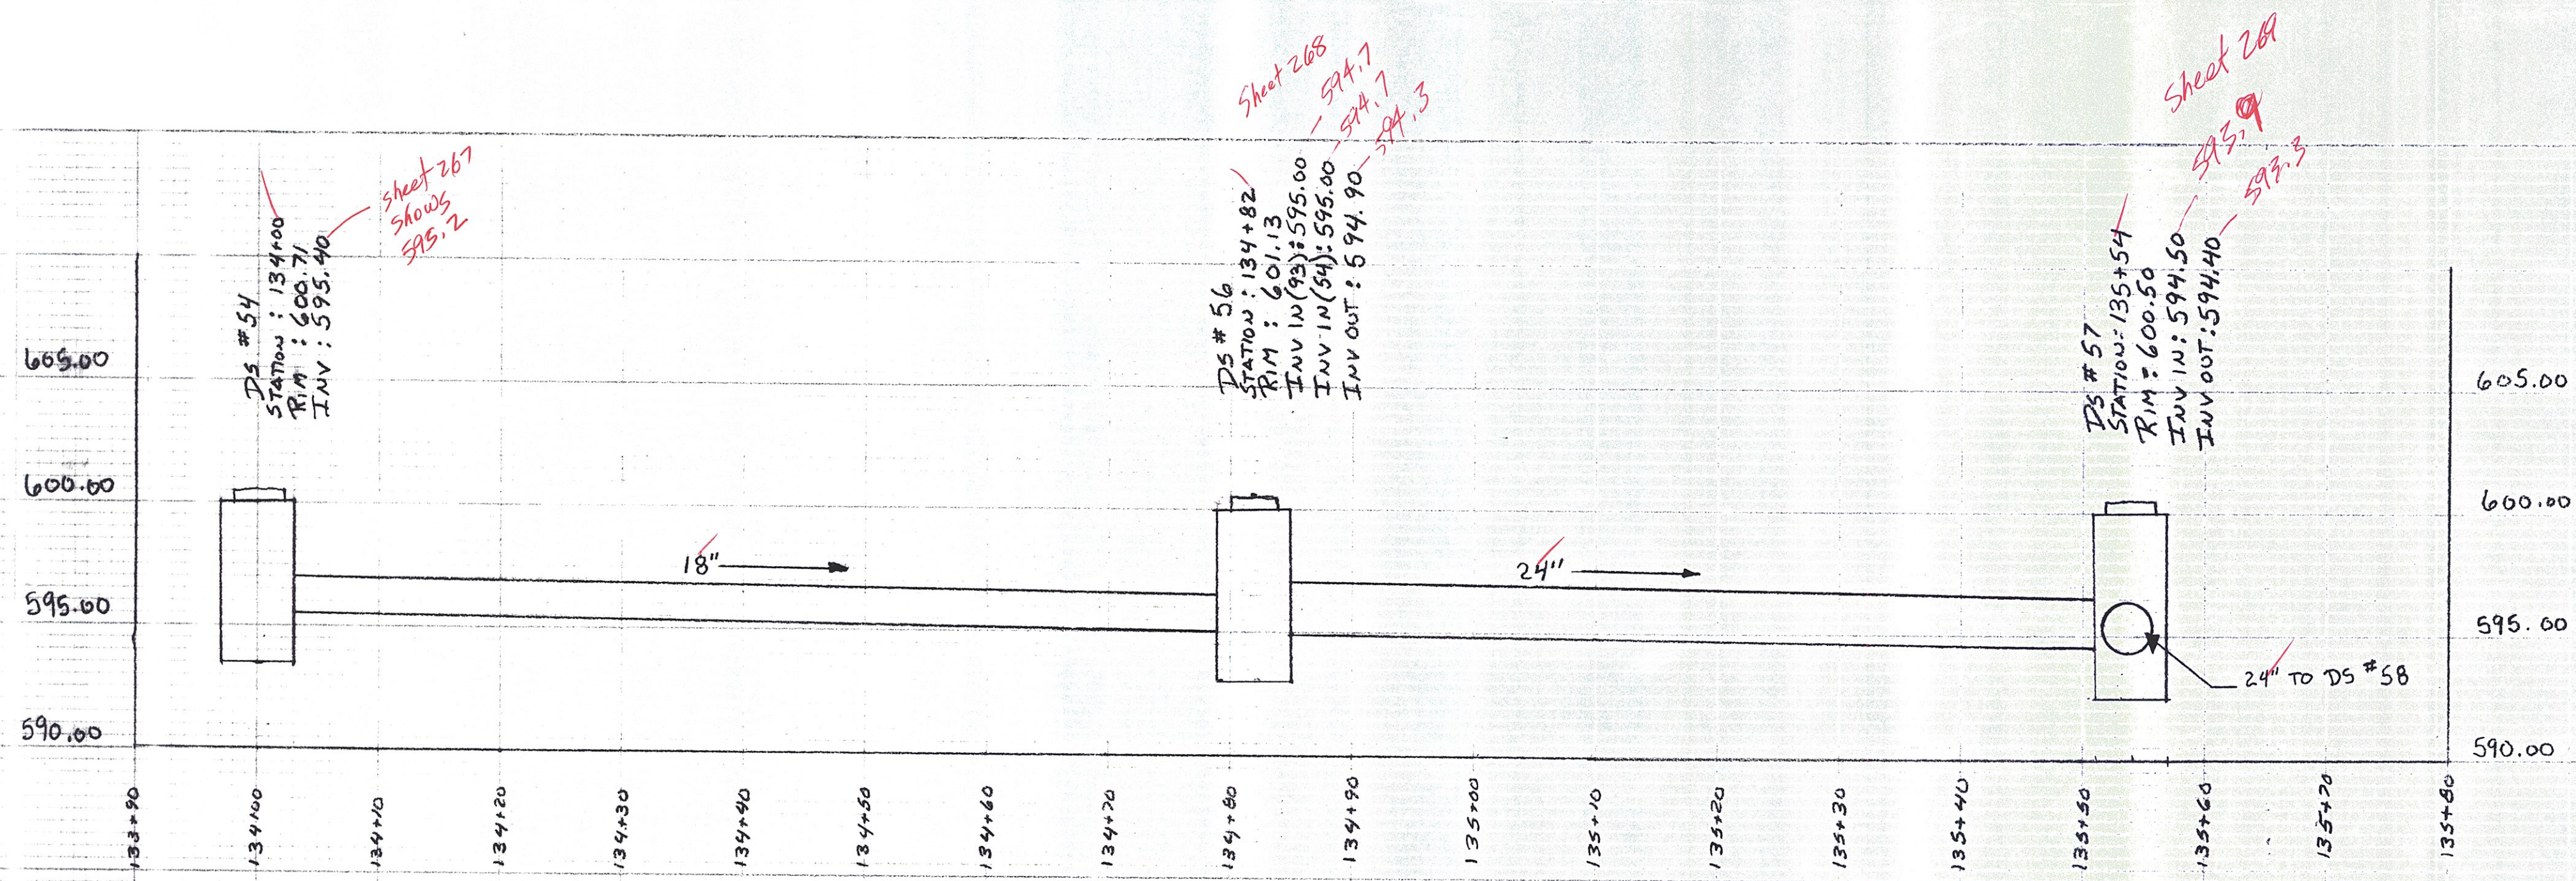


DRAINAGE RUN (54) TO (57)

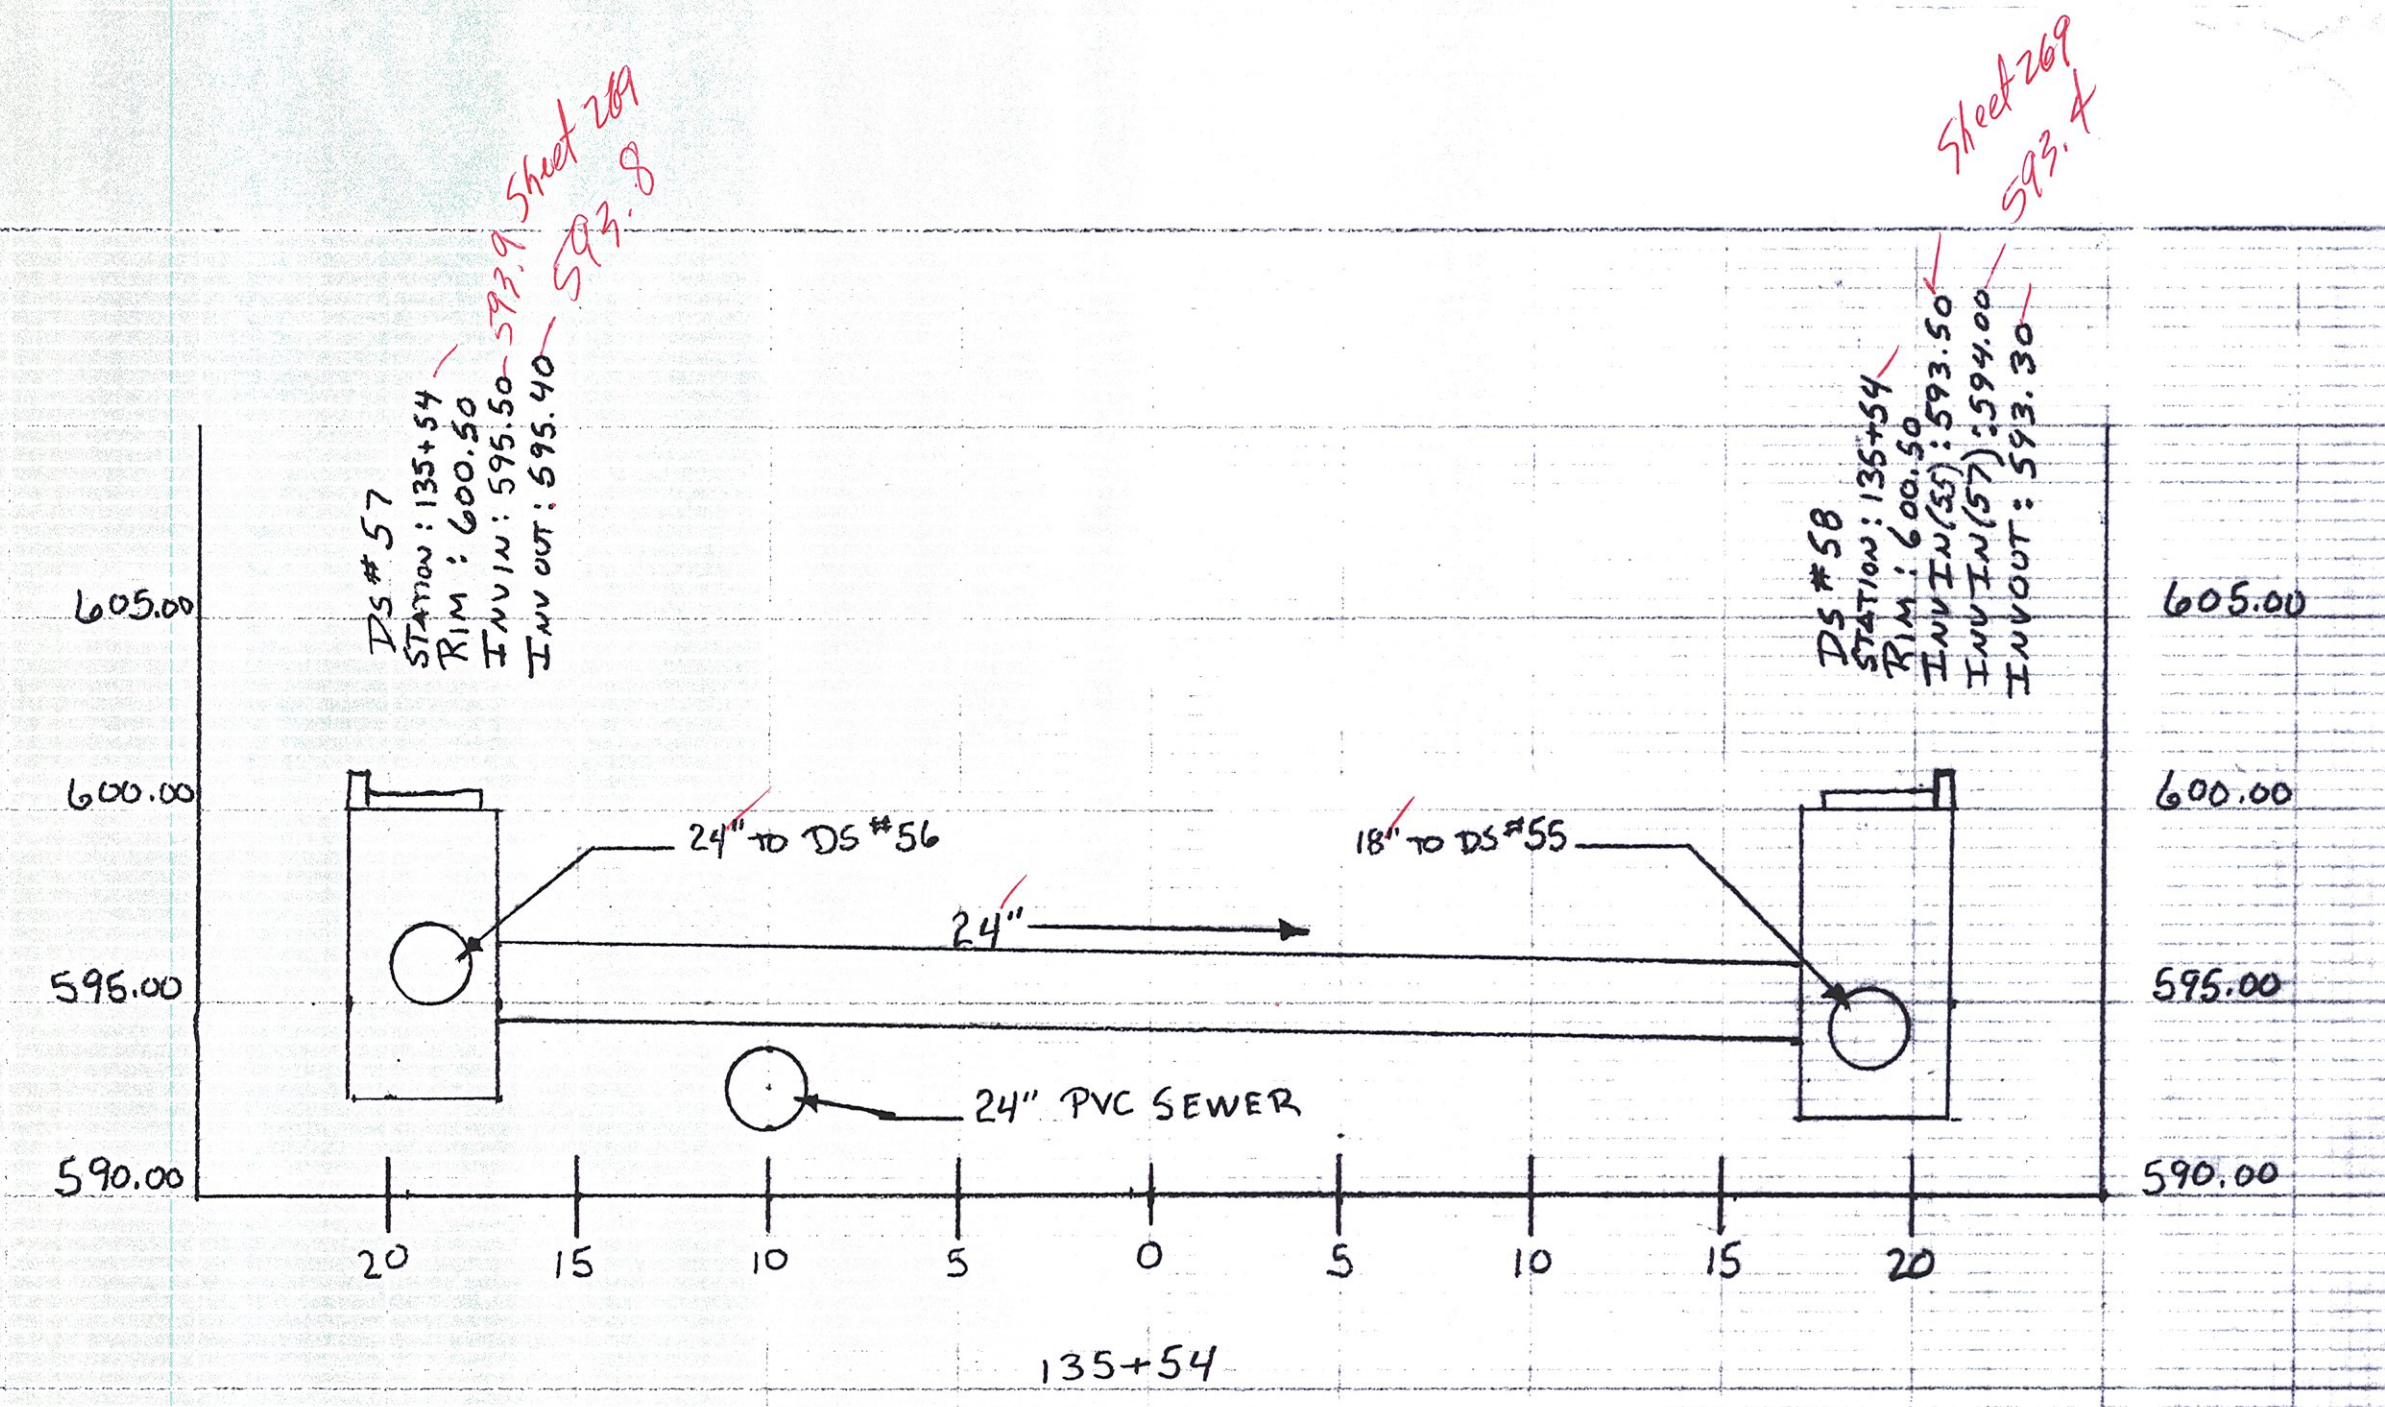

DRAINAGE X-ING (57) TO (58)

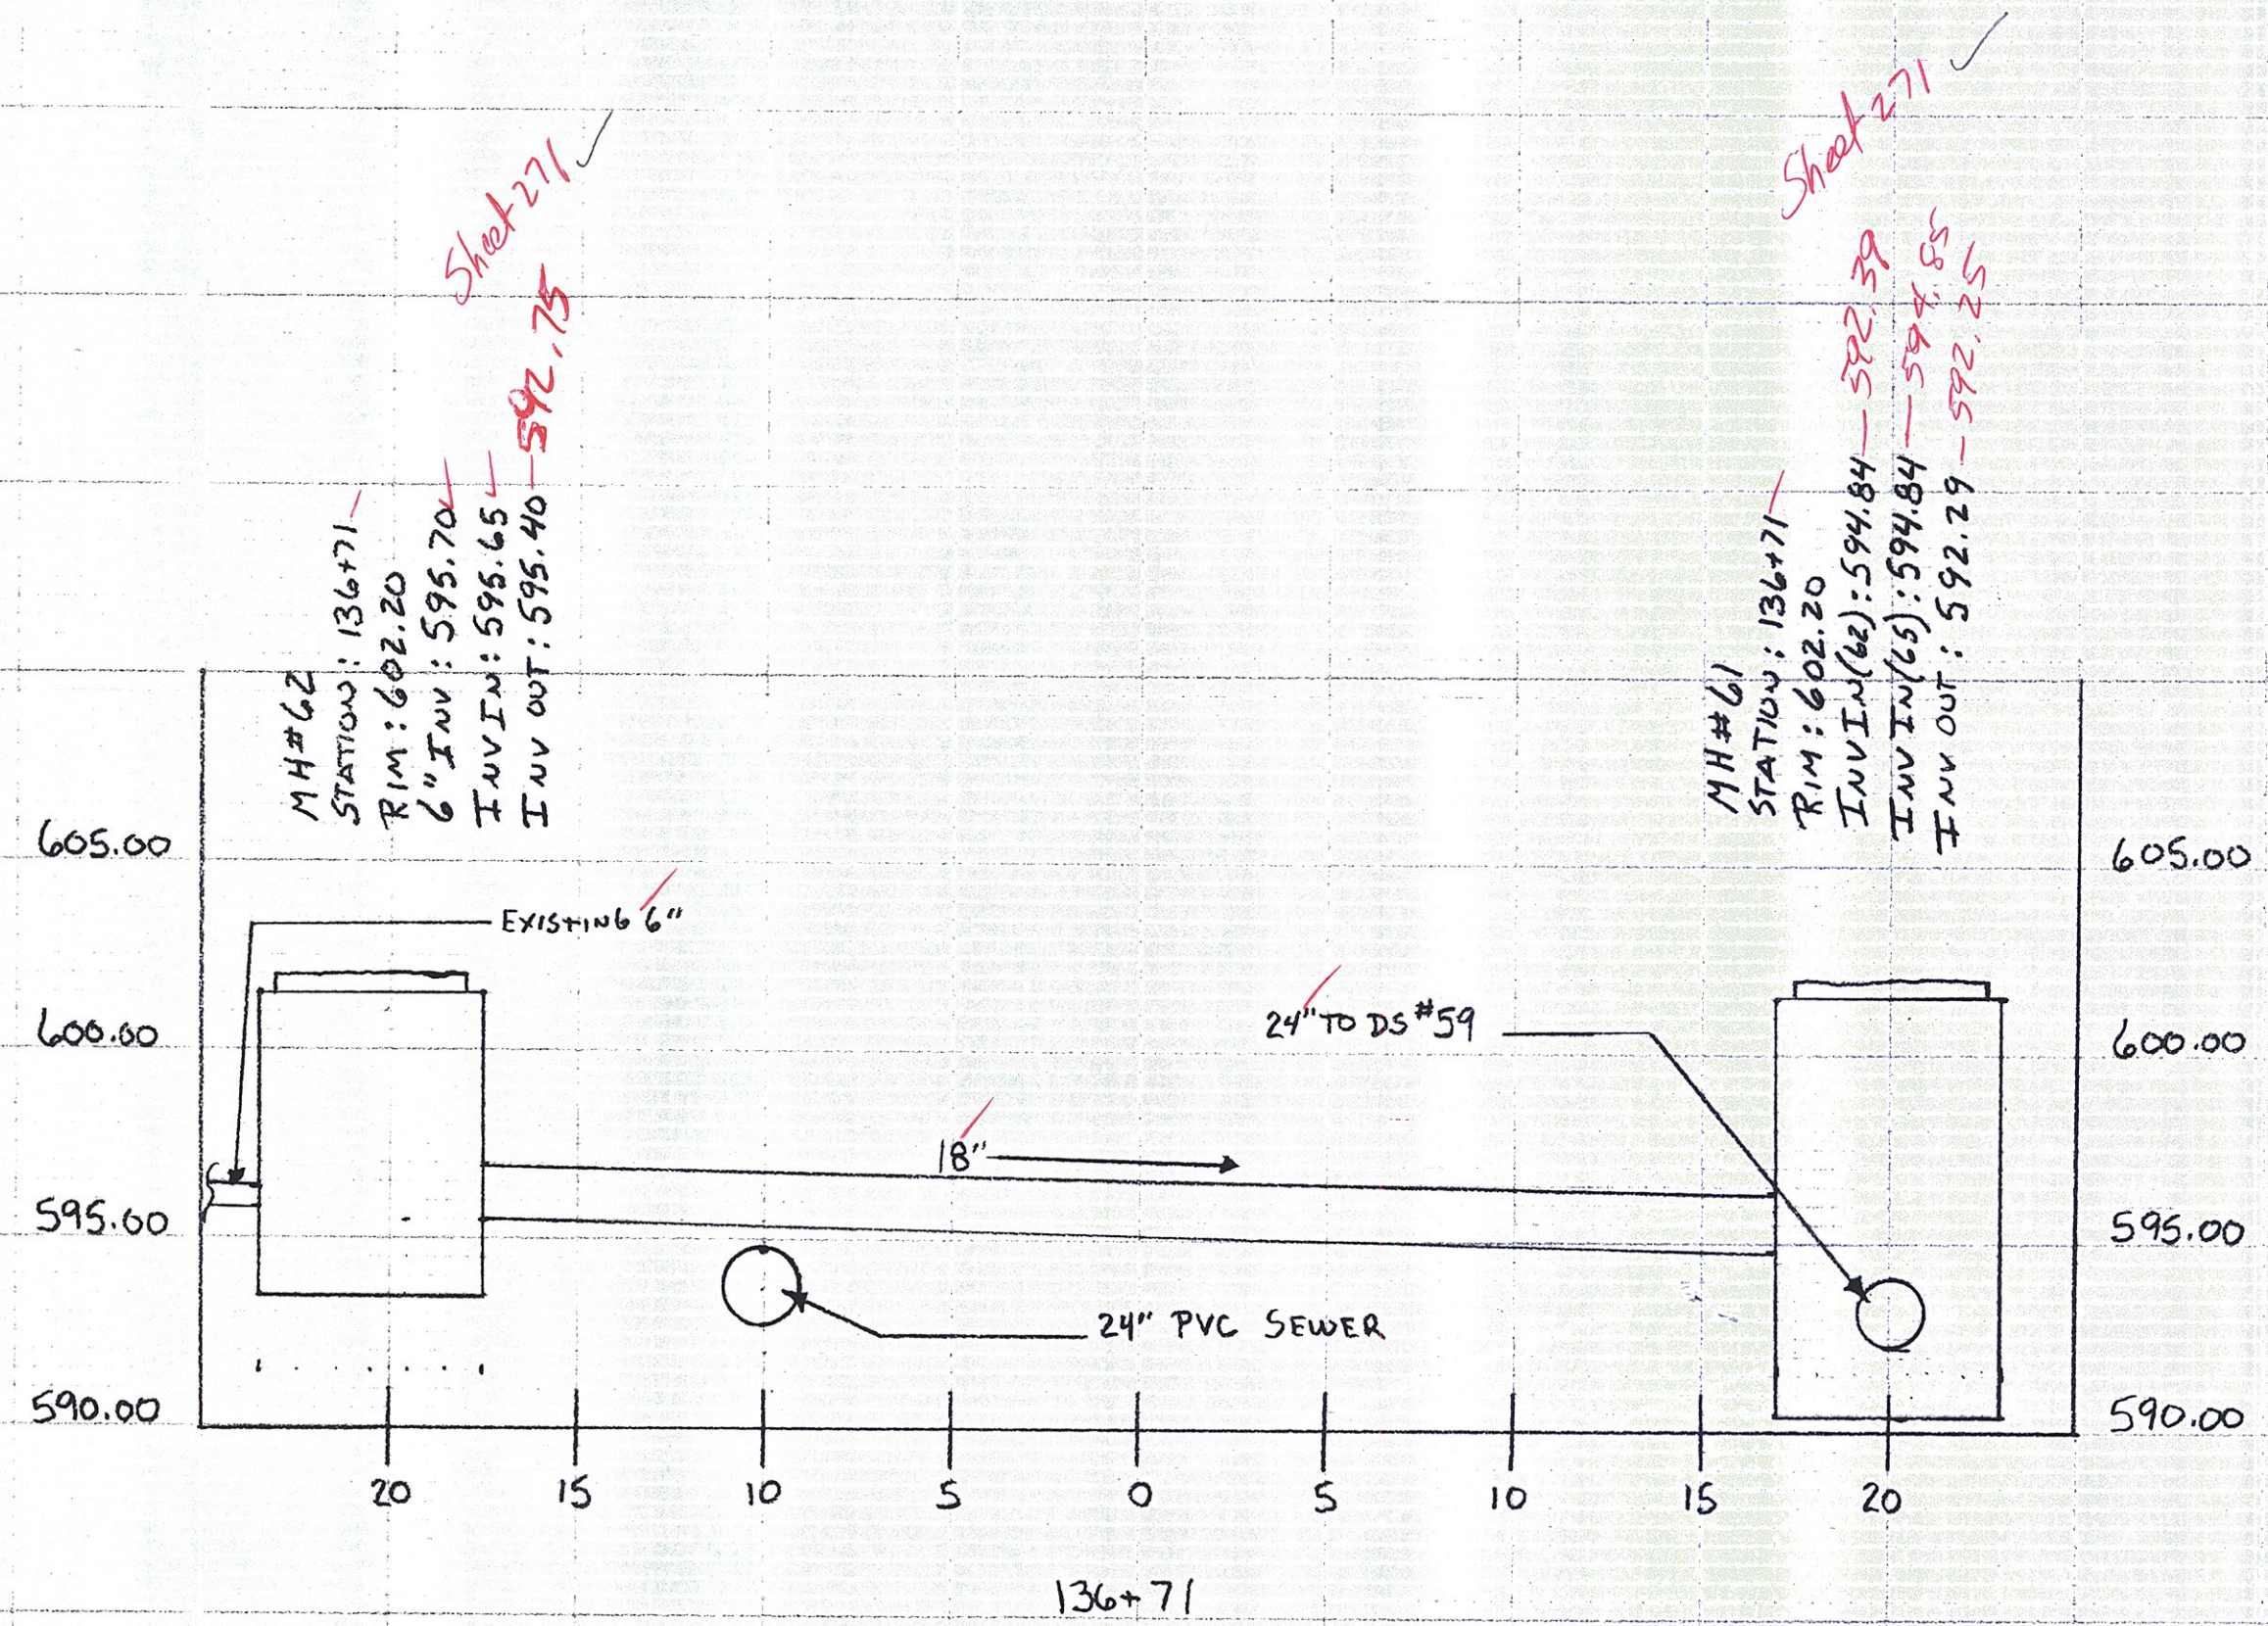

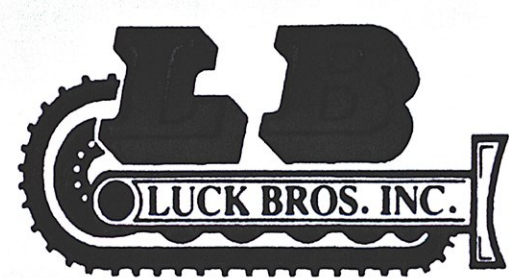

PROJECT NAME:	BARRE CITY	NOTES / REVISIONS
PROJECT NUMBER:	FEGC F 026-1(34) C/2	ISSUED: 2/7/2012
FILE NAME:	SAN PROFILES	
MANAGER:	J. LUCK	
DRAWN BY:	C. KEMPNEY	
PROPOSED REDESIGN STORM SEWER PROFILES		