


CONSTRUCT SIDEWALK RAMP TYPE 5
STA 136+89 - 137+03 RT
STA 136+89 - 137+03 LT
STA 500+43 - 500+60 RT
STA 602+44 - 602+61 RT
STA 700+37 - 700+52 LT
CONSTRUCT SIDEWALK RAMP TYPE 6
STA 139+60 - 139+78 RT

CONSTRUCT DRIVE TYPE 1
STA 136+71 LT
WIDTH
14'

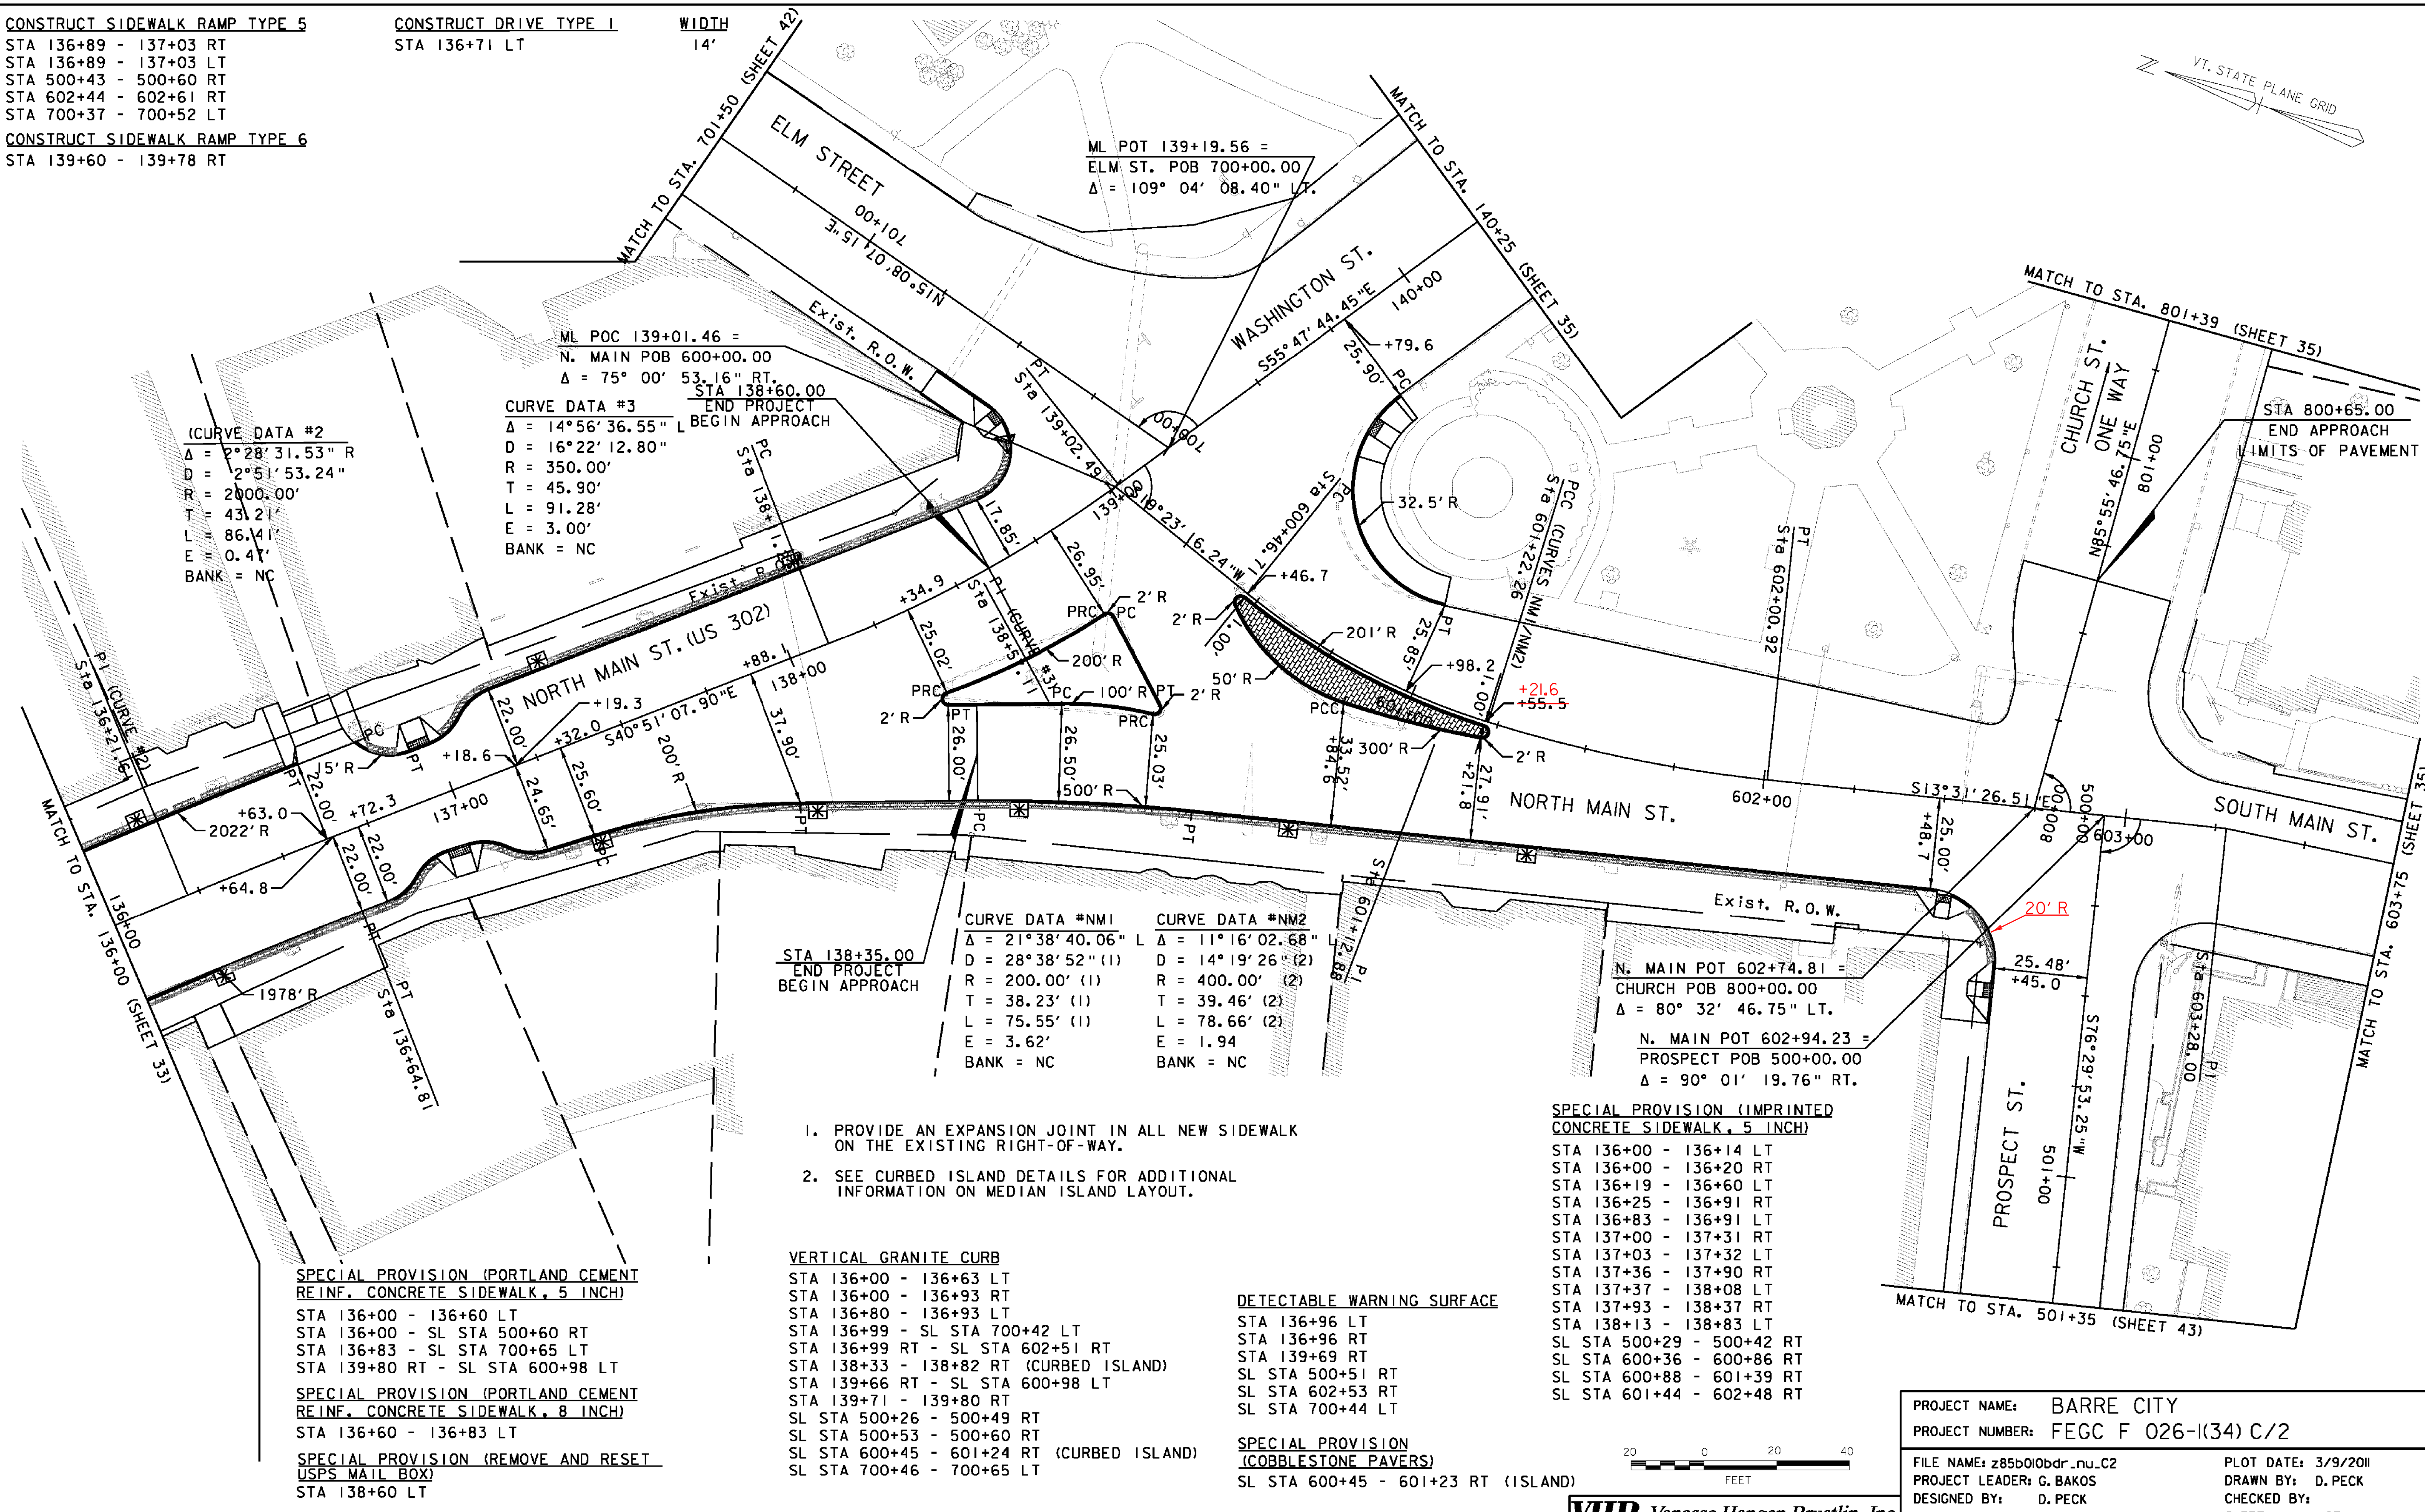

VHB Vanasse Hangen Brustlin, Inc.

PROJECT NAME:	BARRE CITY	PLOT DATE:	3/9/2011
PROJECT NUMBER:	FEGC F 026-(K34) C/2	DRAWN BY:	D. PECK
FILE NAME:	z85b010bdr_nu_c2	CHECKED BY:	
PROJECT LEADER:	G. BAKOS	ALIGNMENT AND CURB LAYOUT PLAN #5	SHEET 34 OF 339
DESIGNED BY:	D. PECK		