

SPECIAL PROVISION (CU STRUCTURAL SOIL)

STA 115+47 - 115+87 RT
STA 116+85 - 116+90 LT

LANDSCAPE BACKFILL, TRUCK MEASUREMENT

SL STA 10+70 - 11+00 LT-RT
SL STA 11+52 - 11+68 LT-RT
SL STA 20+48 - 20+94 LT-RT
STA 116+77 - 116+90 LT

DECIDUOUS TREES

STA 115+67 RT
SL STA 11+02 LT
SL STA 11+20 LT
SL STA 11+45 LT
SL STA 11+64 LT

REMOVING MEDIUM TREES

STA 116+29 LT
SL STA 11+25 RT
SL STA 30+62 RT

SPECIAL PROVISION (GRANITE POST AND CHAIN FENCE)

SL STA 20+50 - 20+78 RT
STA 114+51 - 114+89 LT
STA 116+77 - 116+90 LT

SPECIAL PROVISION (STEEL BENCH WITH BACK)

STA 116+86 LT

EVERGREEN SHRUBS


STA 116+79 - 116+88 LT

SPECIAL PROVISION (BICYCLE RACK)

STA 116+85 LT

TREE PROTECTION ZONE/TPZ

STA 112+60 - 112+77 RT
STA 115+35 - 115+45 LT
STA 115+74 - 115+93 LT
STA 115+91 - 116+04 RT
STA 116+48 - 116+90 RT
SL STA 10+90 - 11+15 RT

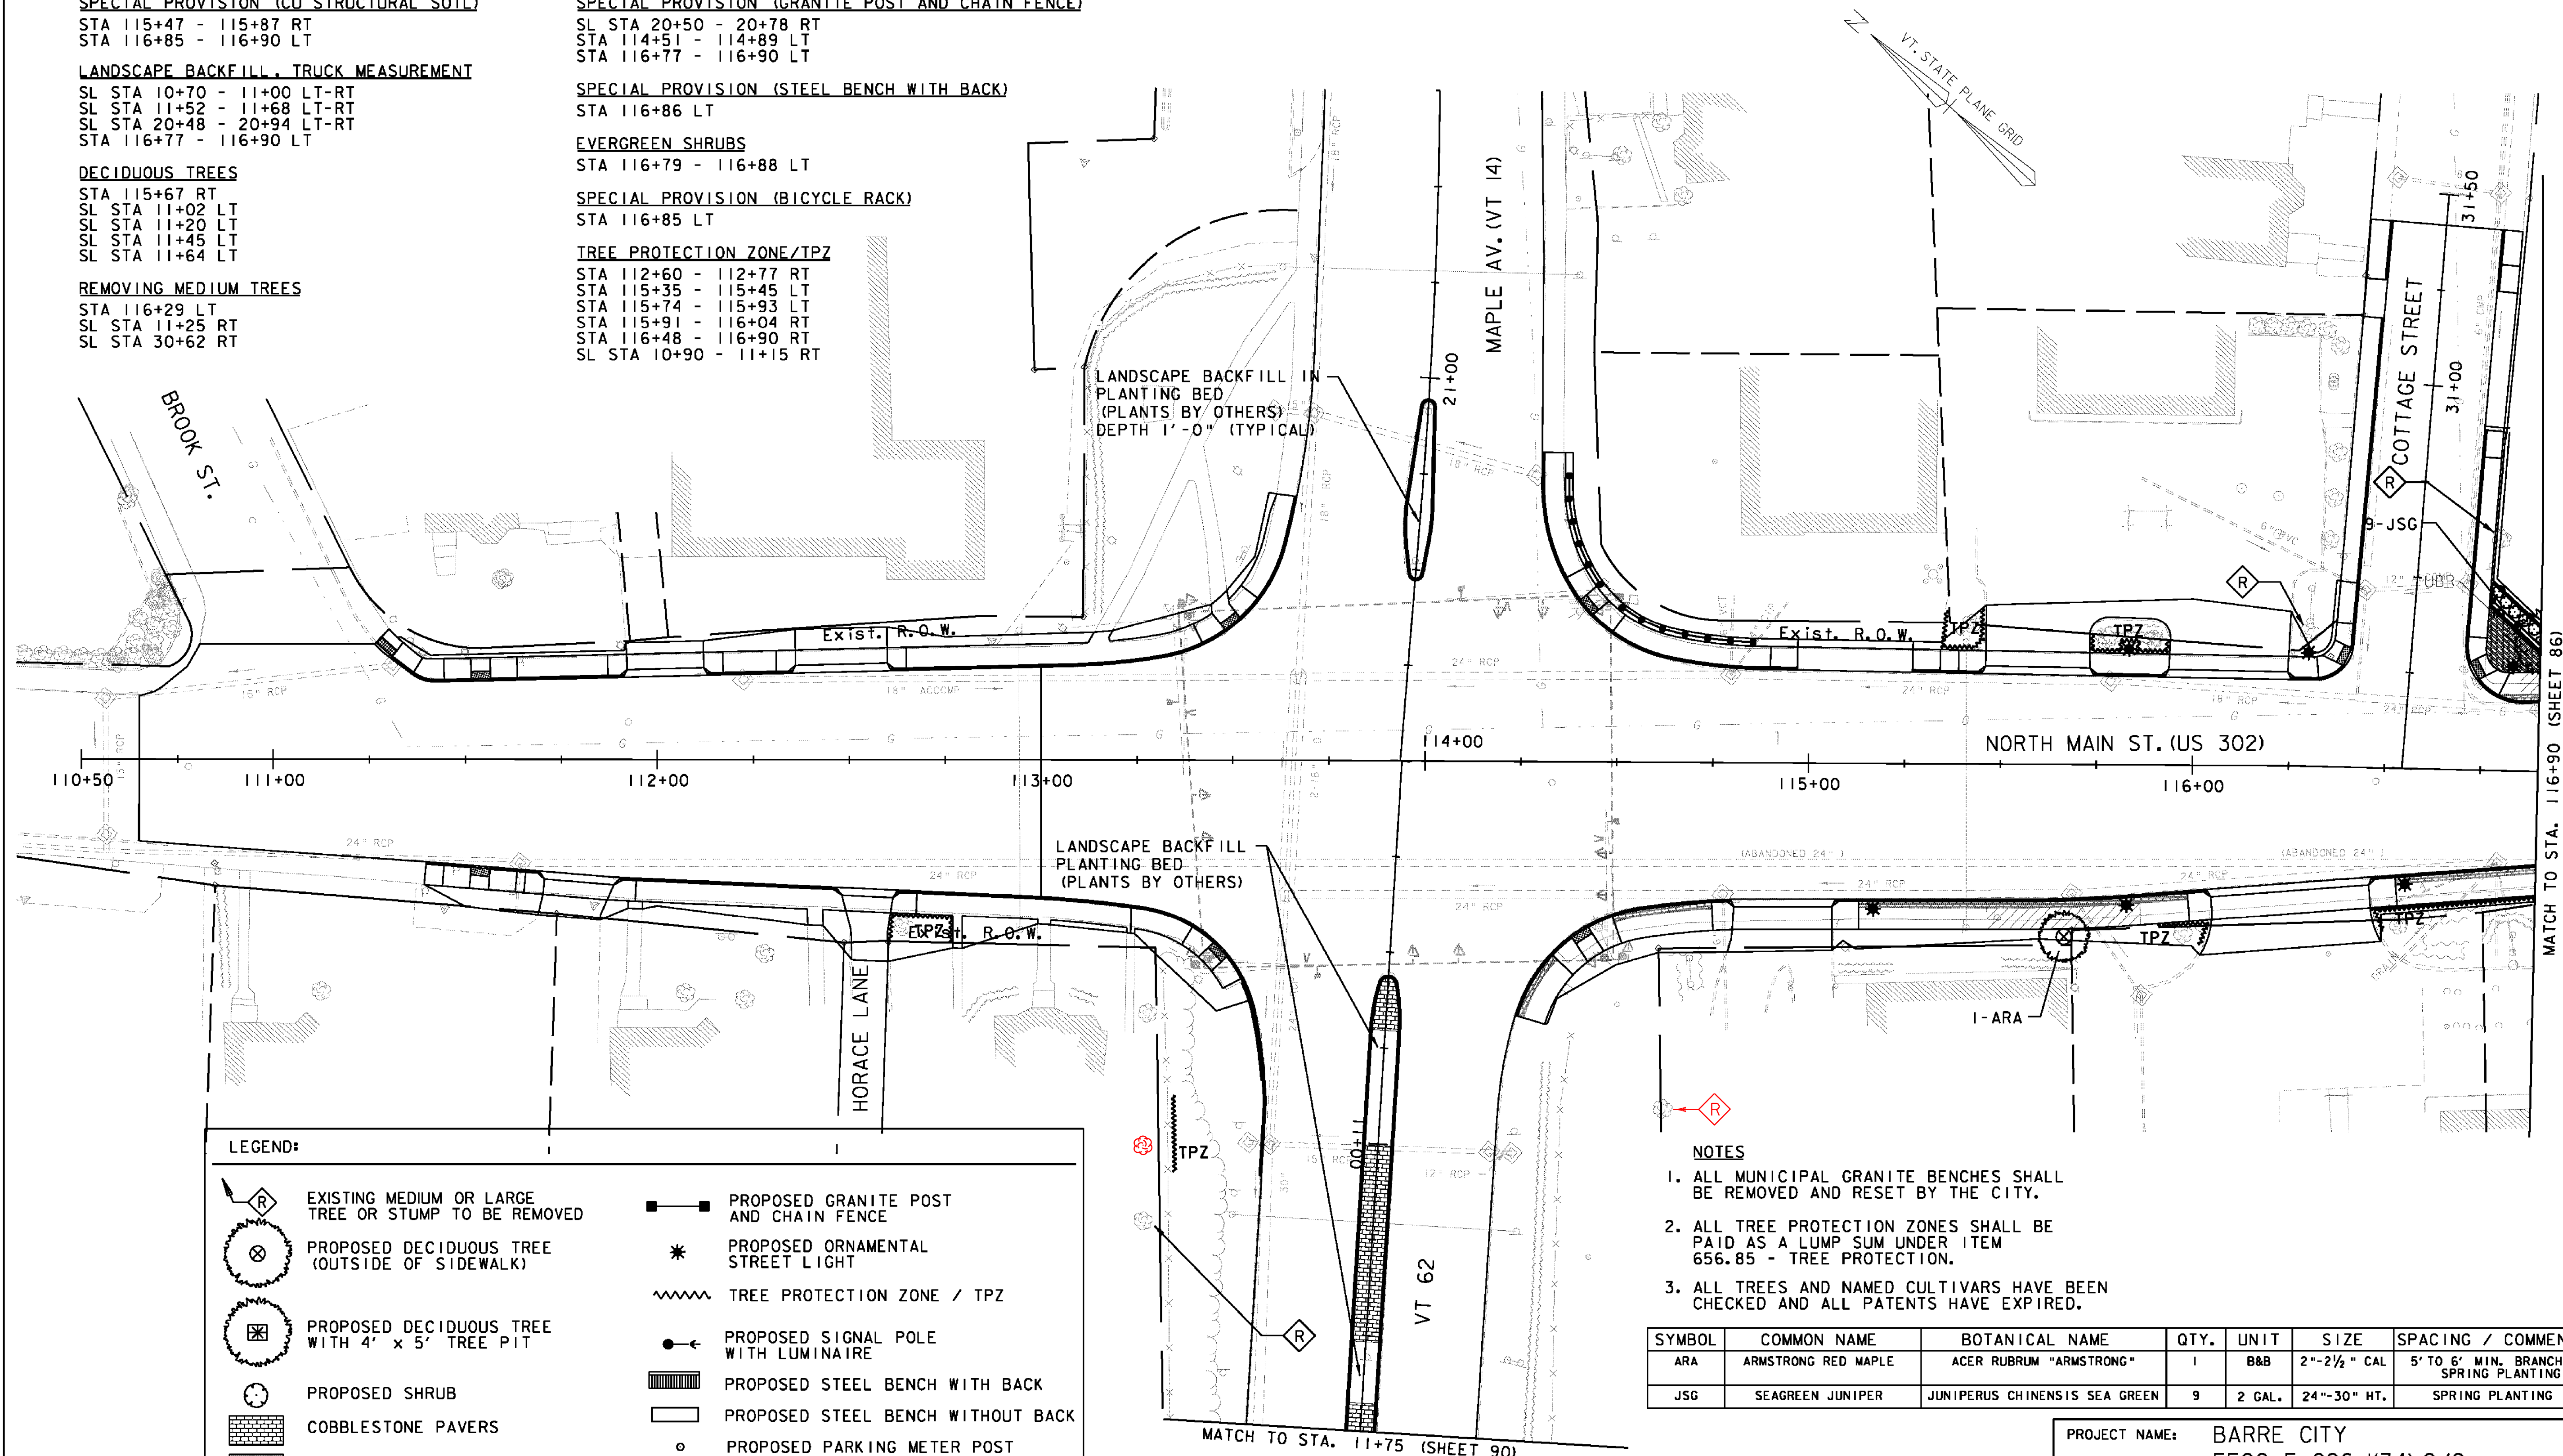

LEGEND:

- | | | | |
|--|--|--|---------------------------------------|
| | EXISTING MEDIUM OR LARGE TREE OR STUMP TO BE REMOVED | | PROPOSED GRANITE POST AND CHAIN FENCE |
| | PROPOSED DECIDUOUS TREE (OUTSIDE OF SIDEWALK) | | PROPOSED ORNAMENTAL STREET LIGHT |
| | PROPOSED DECIDUOUS TREE WITH 4' x 5' TREE PIT | | TREE PROTECTION ZONE / TPZ |
| | PROPOSED SHRUB | | PROPOSED SIGNAL POLE WITH LUMINAIRE |
| | COBBLESTONE PAVERS | | PROPOSED STEEL BENCH WITH BACK |
| | IMPRINTED 5" CONCRETE SIDEWALK | | PROPOSED STEEL BENCH WITHOUT BACK |
| | CU STRUCTURAL SOIL | | PROPOSED PARKING METER POST |
| | | | PROPOSED TRASH RECEPTACLE |
| | | | PROPOSED BICYCLE RACK |

NOTES

1. ALL MUNICIPAL GRANITE BENCHES SHALL BE REMOVED AND RESET BY THE CITY.
2. ALL TREE PROTECTION ZONES SHALL BE PAID AS A LUMP SUM UNDER ITEM 656.85 - TREE PROTECTION.
3. ALL TREES AND NAMED CULTIVARS HAVE BEEN CHECKED AND ALL PATENTS HAVE EXPIRED.

SYMBOL	COMMON NAME	BOTANICAL NAME	QTY.	UNIT	SIZE	SPACING / COMMENTS
ARA	ARMSTRONG RED MAPLE	ACER RUBRUM "ARMSTRONG"	1	B&B	2"-2 1/2" CAL	5' TO 6' MIN. BRANCH HT. SPRING PLANTING
JSG	SEAGREEN JUNIPER	JUNIPERUS CHINENSIS SEA GREEN	9	2 GAL.	24"-30" HT.	SPRING PLANTING



VHB Vanasse Hangen Brustlin, Inc.

PROJECT NAME: BARRE CITY
PROJECT NUMBER: FECC F 026-1(34) C/2
FILE NAME: z85b010bdr_id.C2
PROJECT LEADER: G. BAKOS
DESIGNED BY: D. PECK
LANDSCAPING PLAN #1
PLOT DATE: 3/9/2011
DRAWN BY: D. PECK
CHECKED BY:
SHEET 85 OF 339