
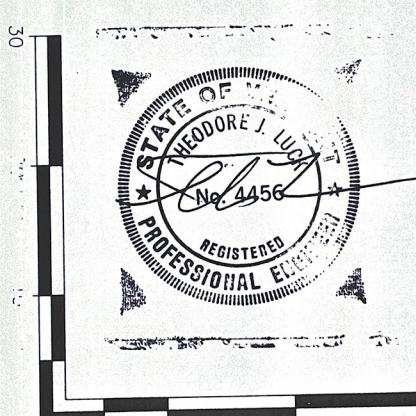


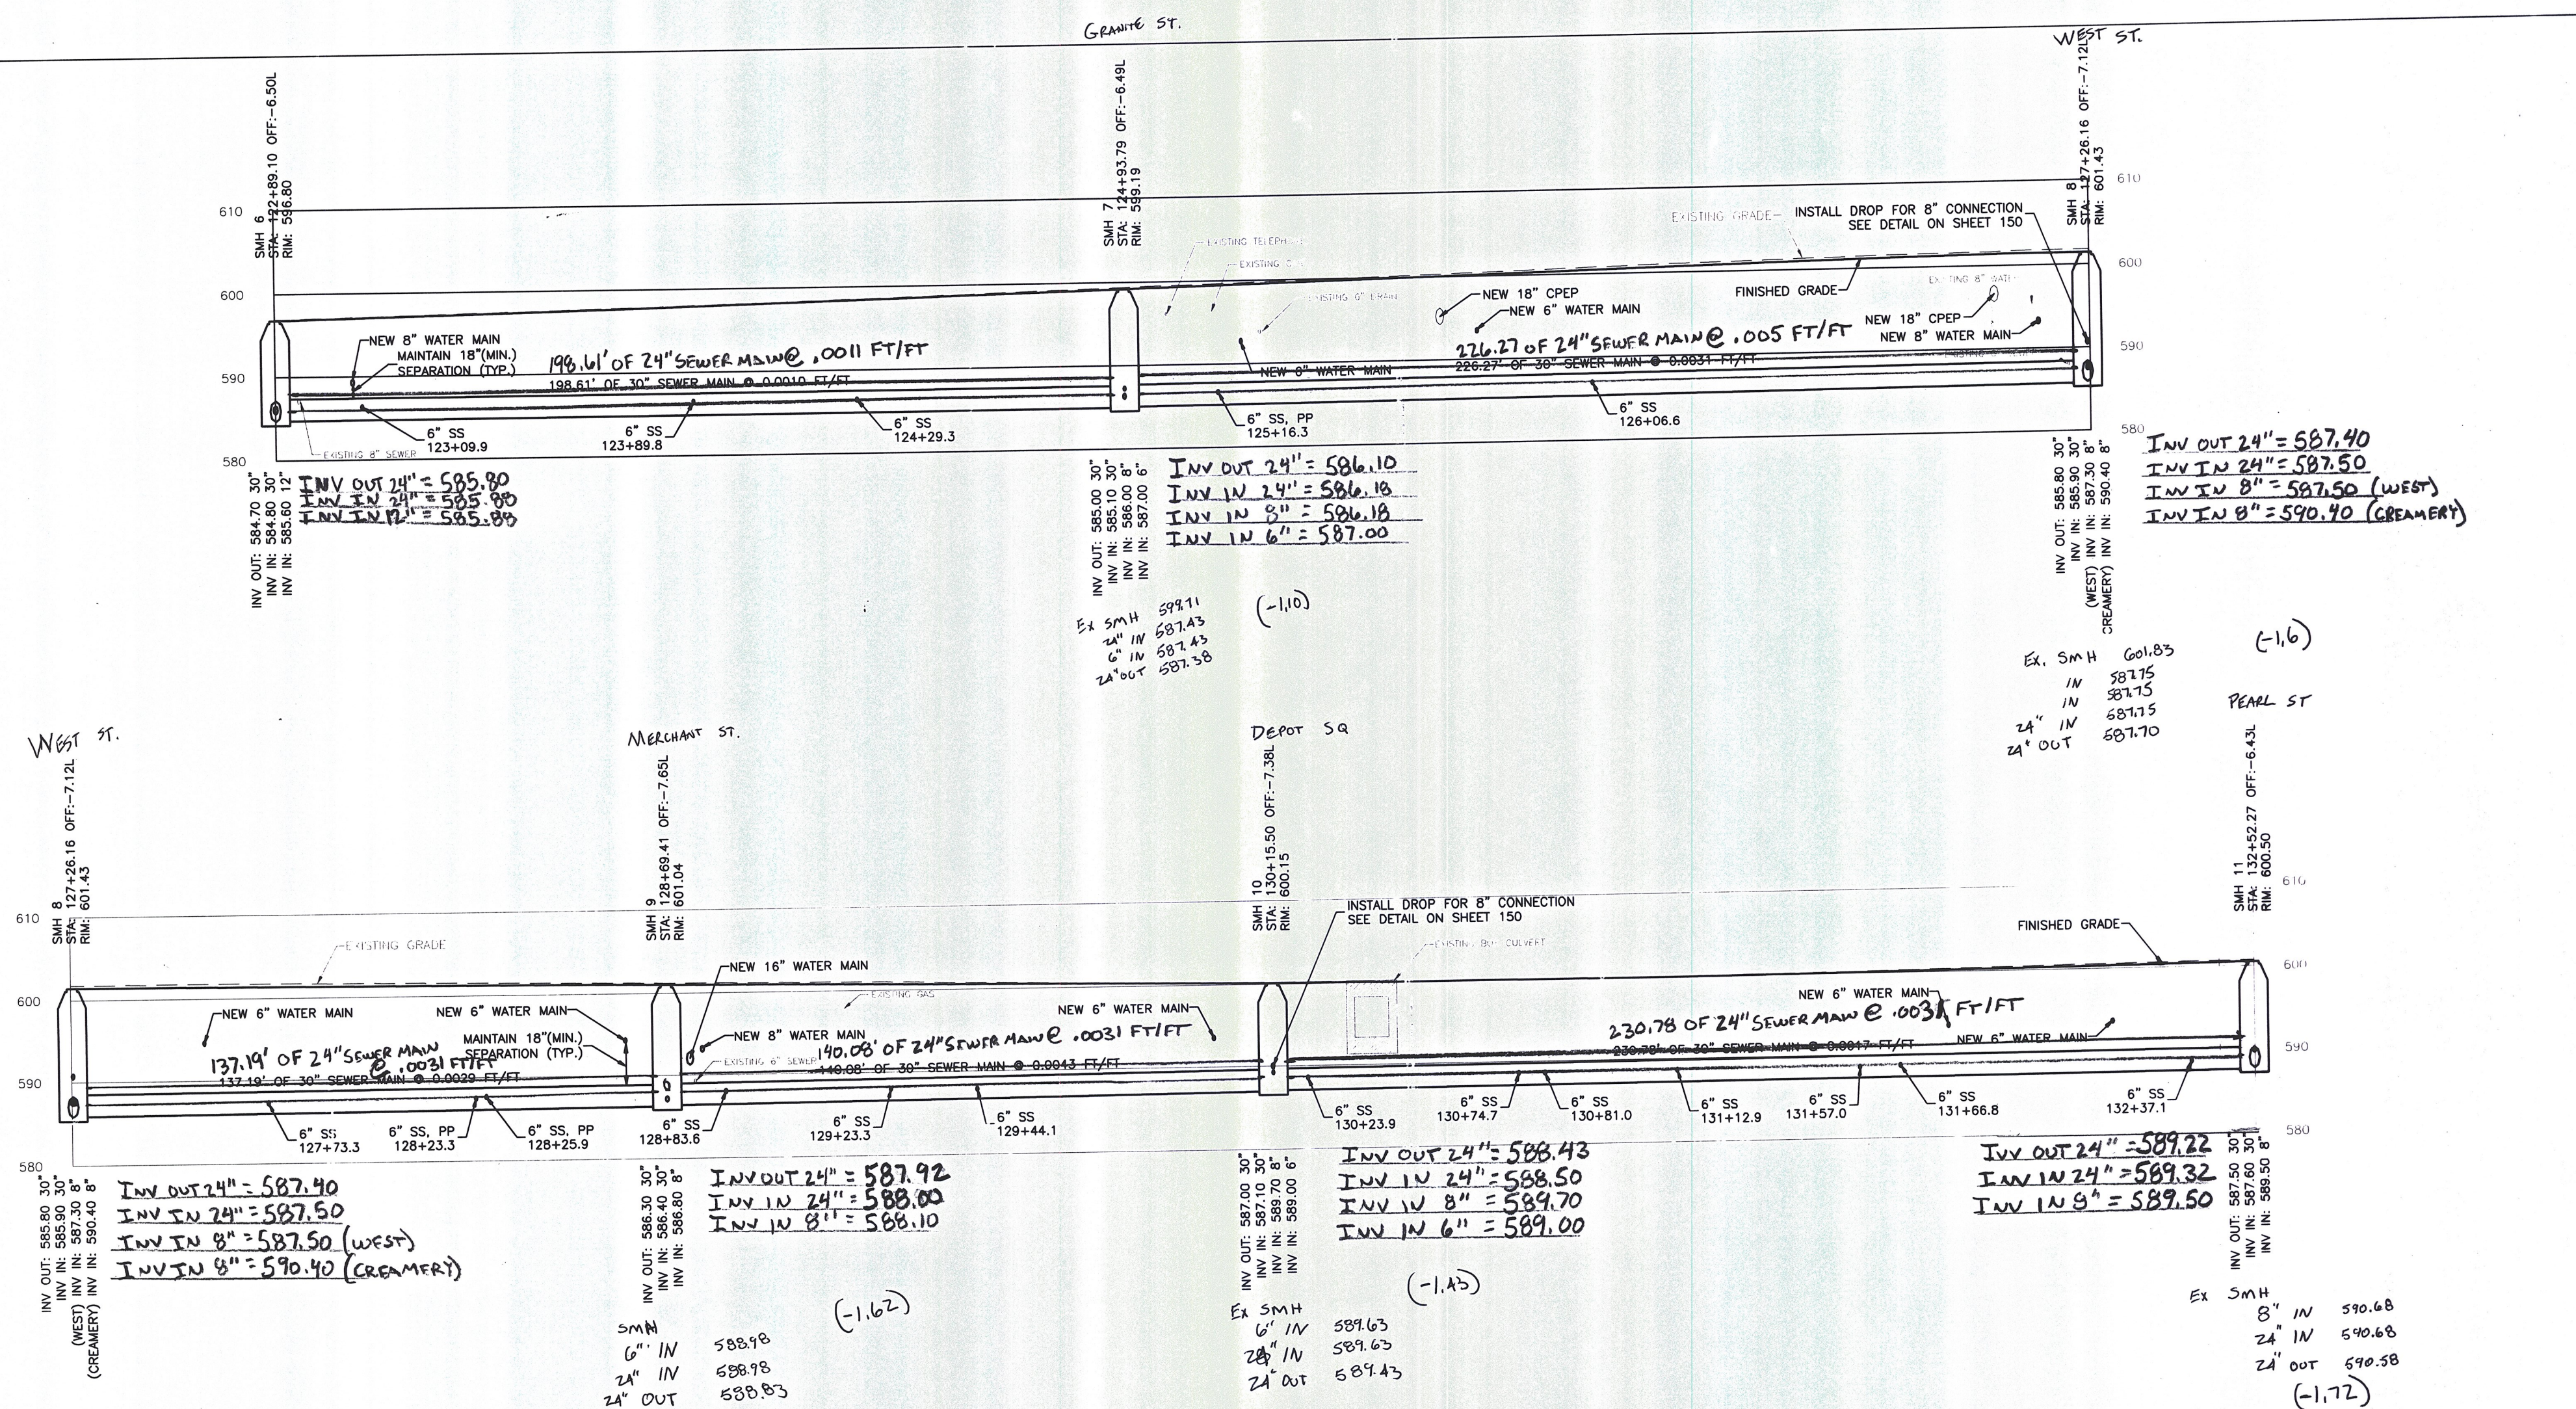

NOTES:
 1. SEE SHEET 133 FOR GENERAL NOTES, LEGEND, AND ABBREVIATIONS.
 2. STATIONING SHOWN HEREON IS BASED ON ROAD CENTERLINE AS PER VTTRANS REQUIREMENTS AND MAY NOT REFLECT PROPER PIPE LENGTHS.
 3. SEE SHEETS 134-138 FOR PLAN INFORMATION.
 4. SEE SHEETS 144-149 FOR SEWER SERVICE PROFILES.
 5. SEE SHEETS 150 AND 154 FOR DETAILS.

PROJECT NAME:	BARRE CITY	NOTES / REVISIONS	
		ISSUED:	2/7/2012
PROJECT NUMBER:	FECC F 026-134 C/2		
FILE NAME:	SAN PROFILES		
MANAGER:	J. LUCK		
DRAWN BY:	C. KEMPNEY		
PROPOSED REDESIGN SANITARY SEWER PROFILES			
Sheet 1 of 2			