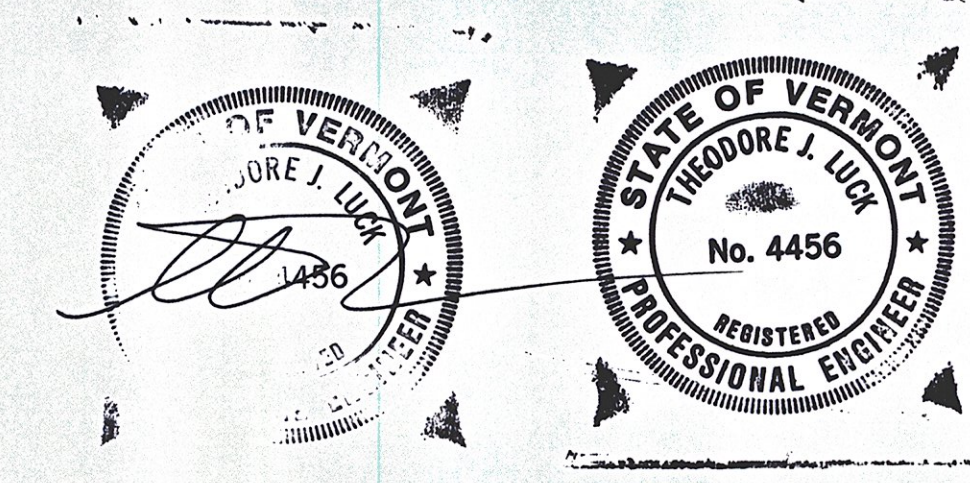
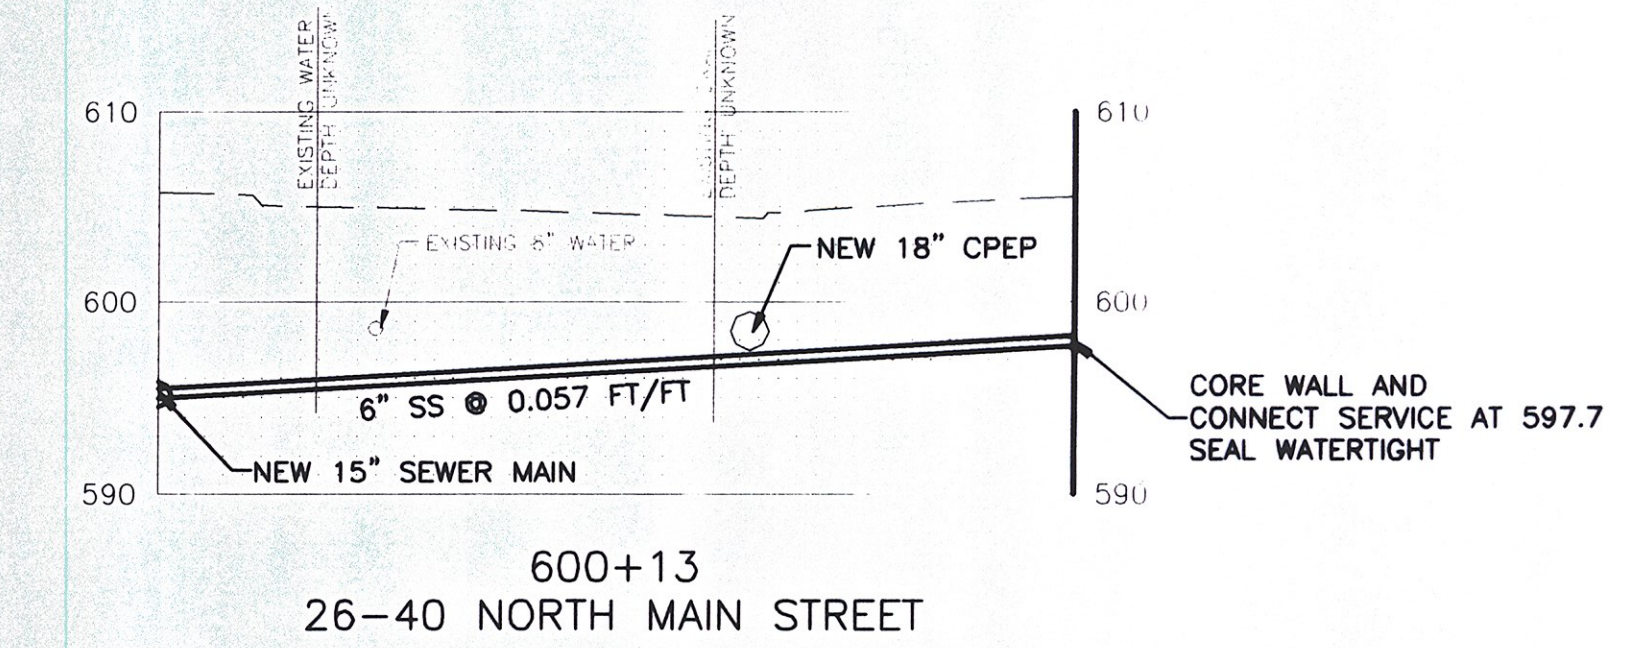
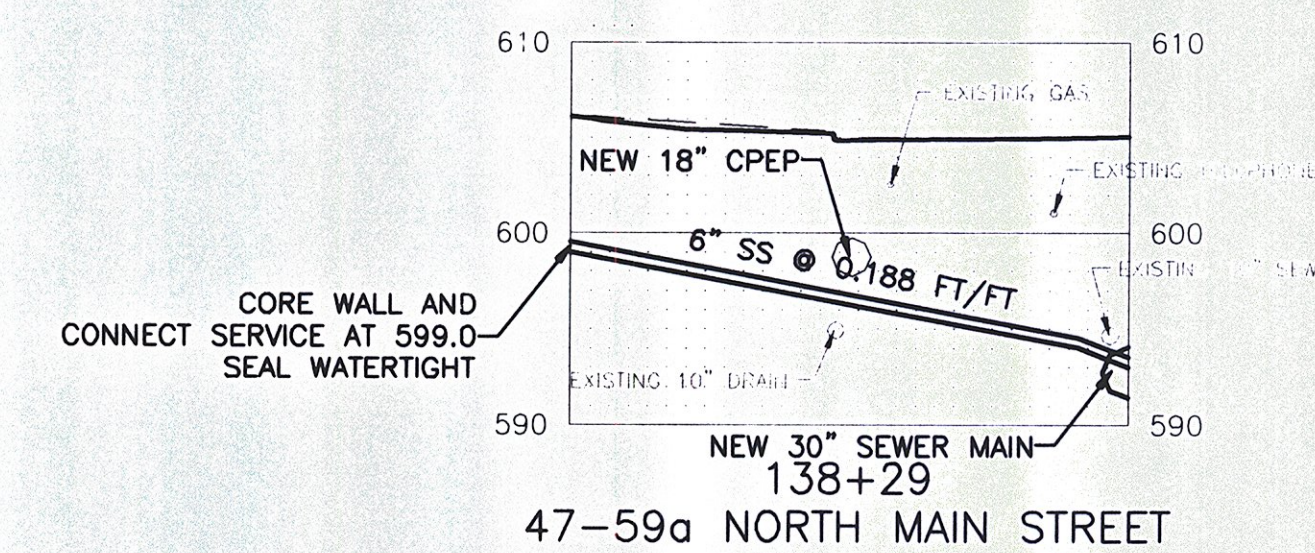
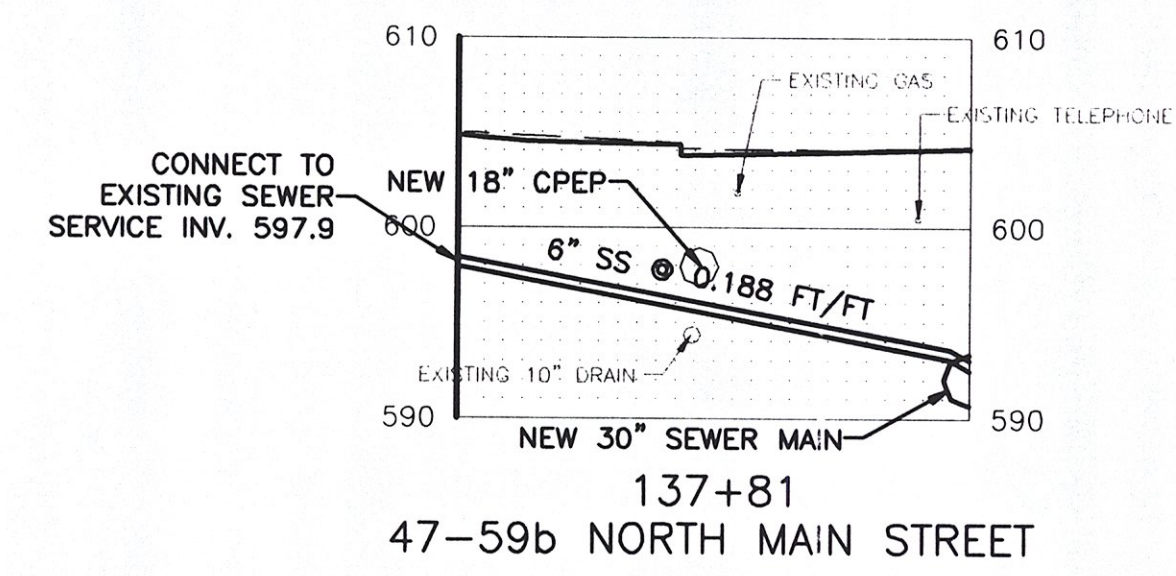
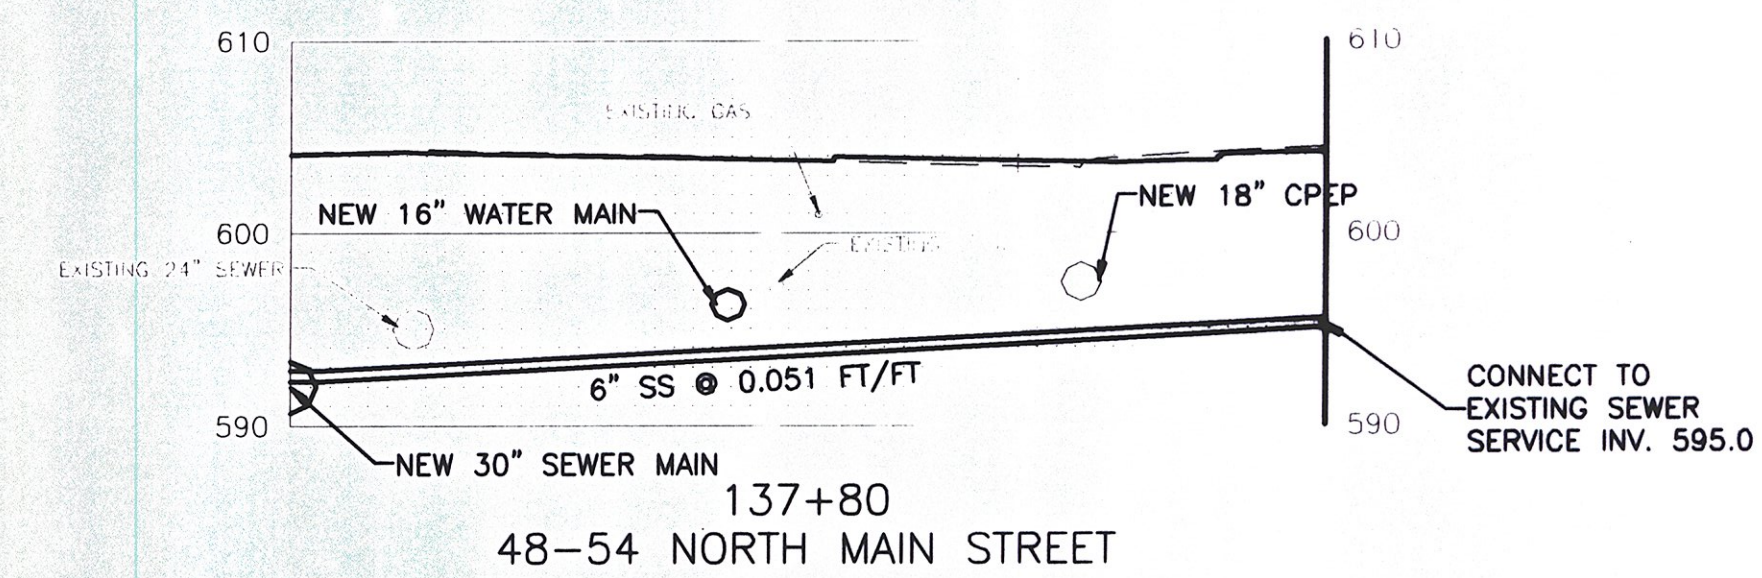
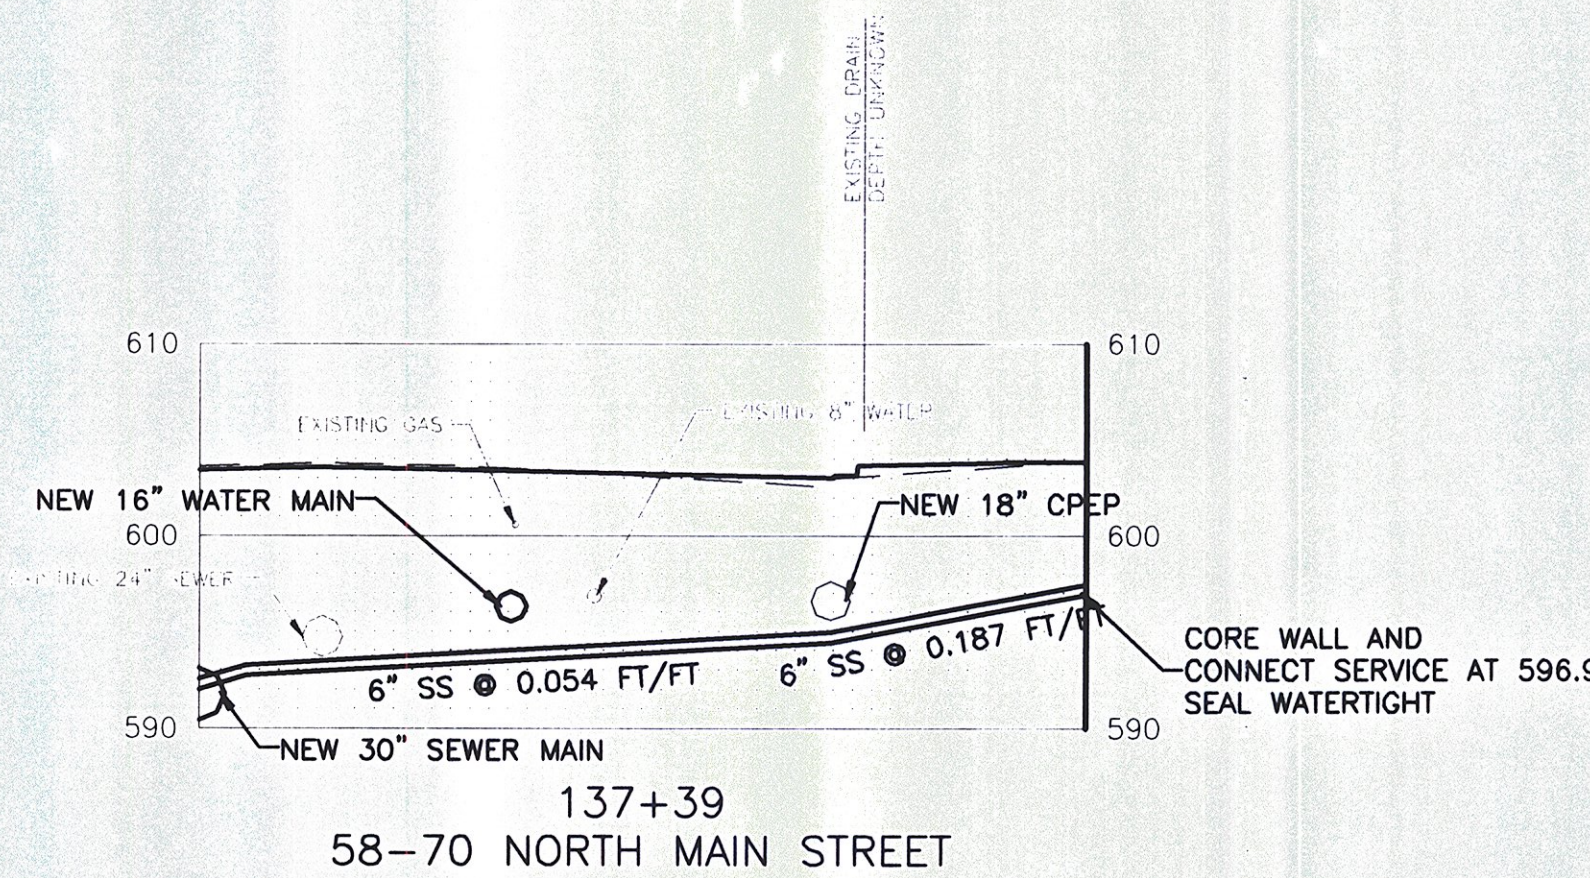
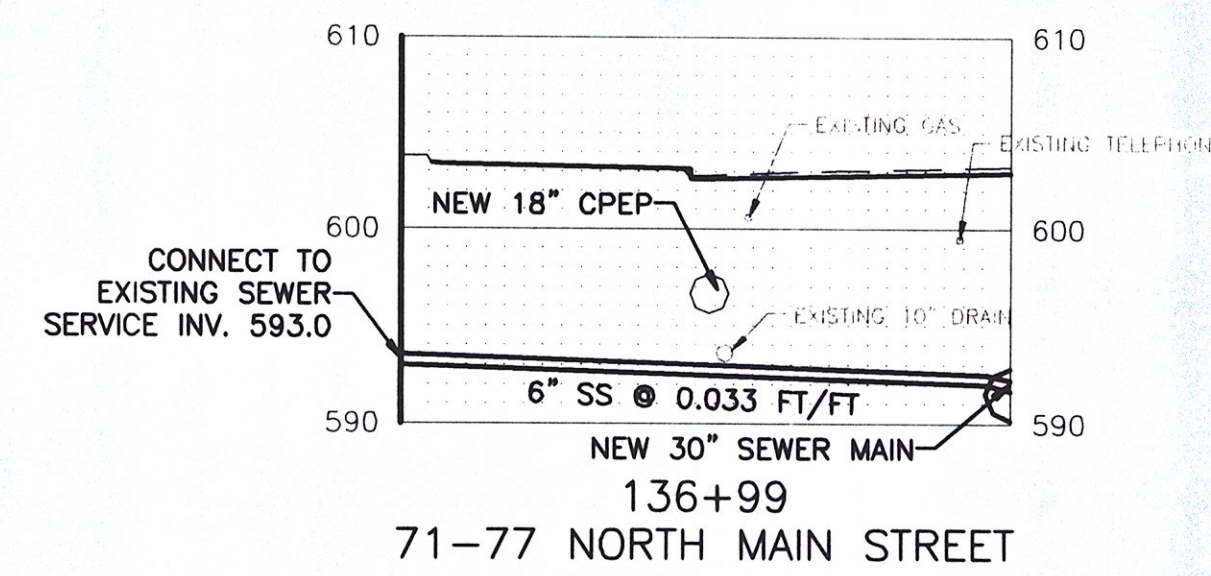


NOTES / REVISIONS	
PROJECT NAME:	BARRE CITY
PROJECT NUMBER:	FEGC F 026-1(34) C/2
FILE NAME:	SAN PROFILES
MANAGER:	J. LUCK
DRAWN BY:	C. KEMPNEY
PROPOSED REDESIGN SANITARY SEWER PROFILES	
Sheet "A9" revised	