



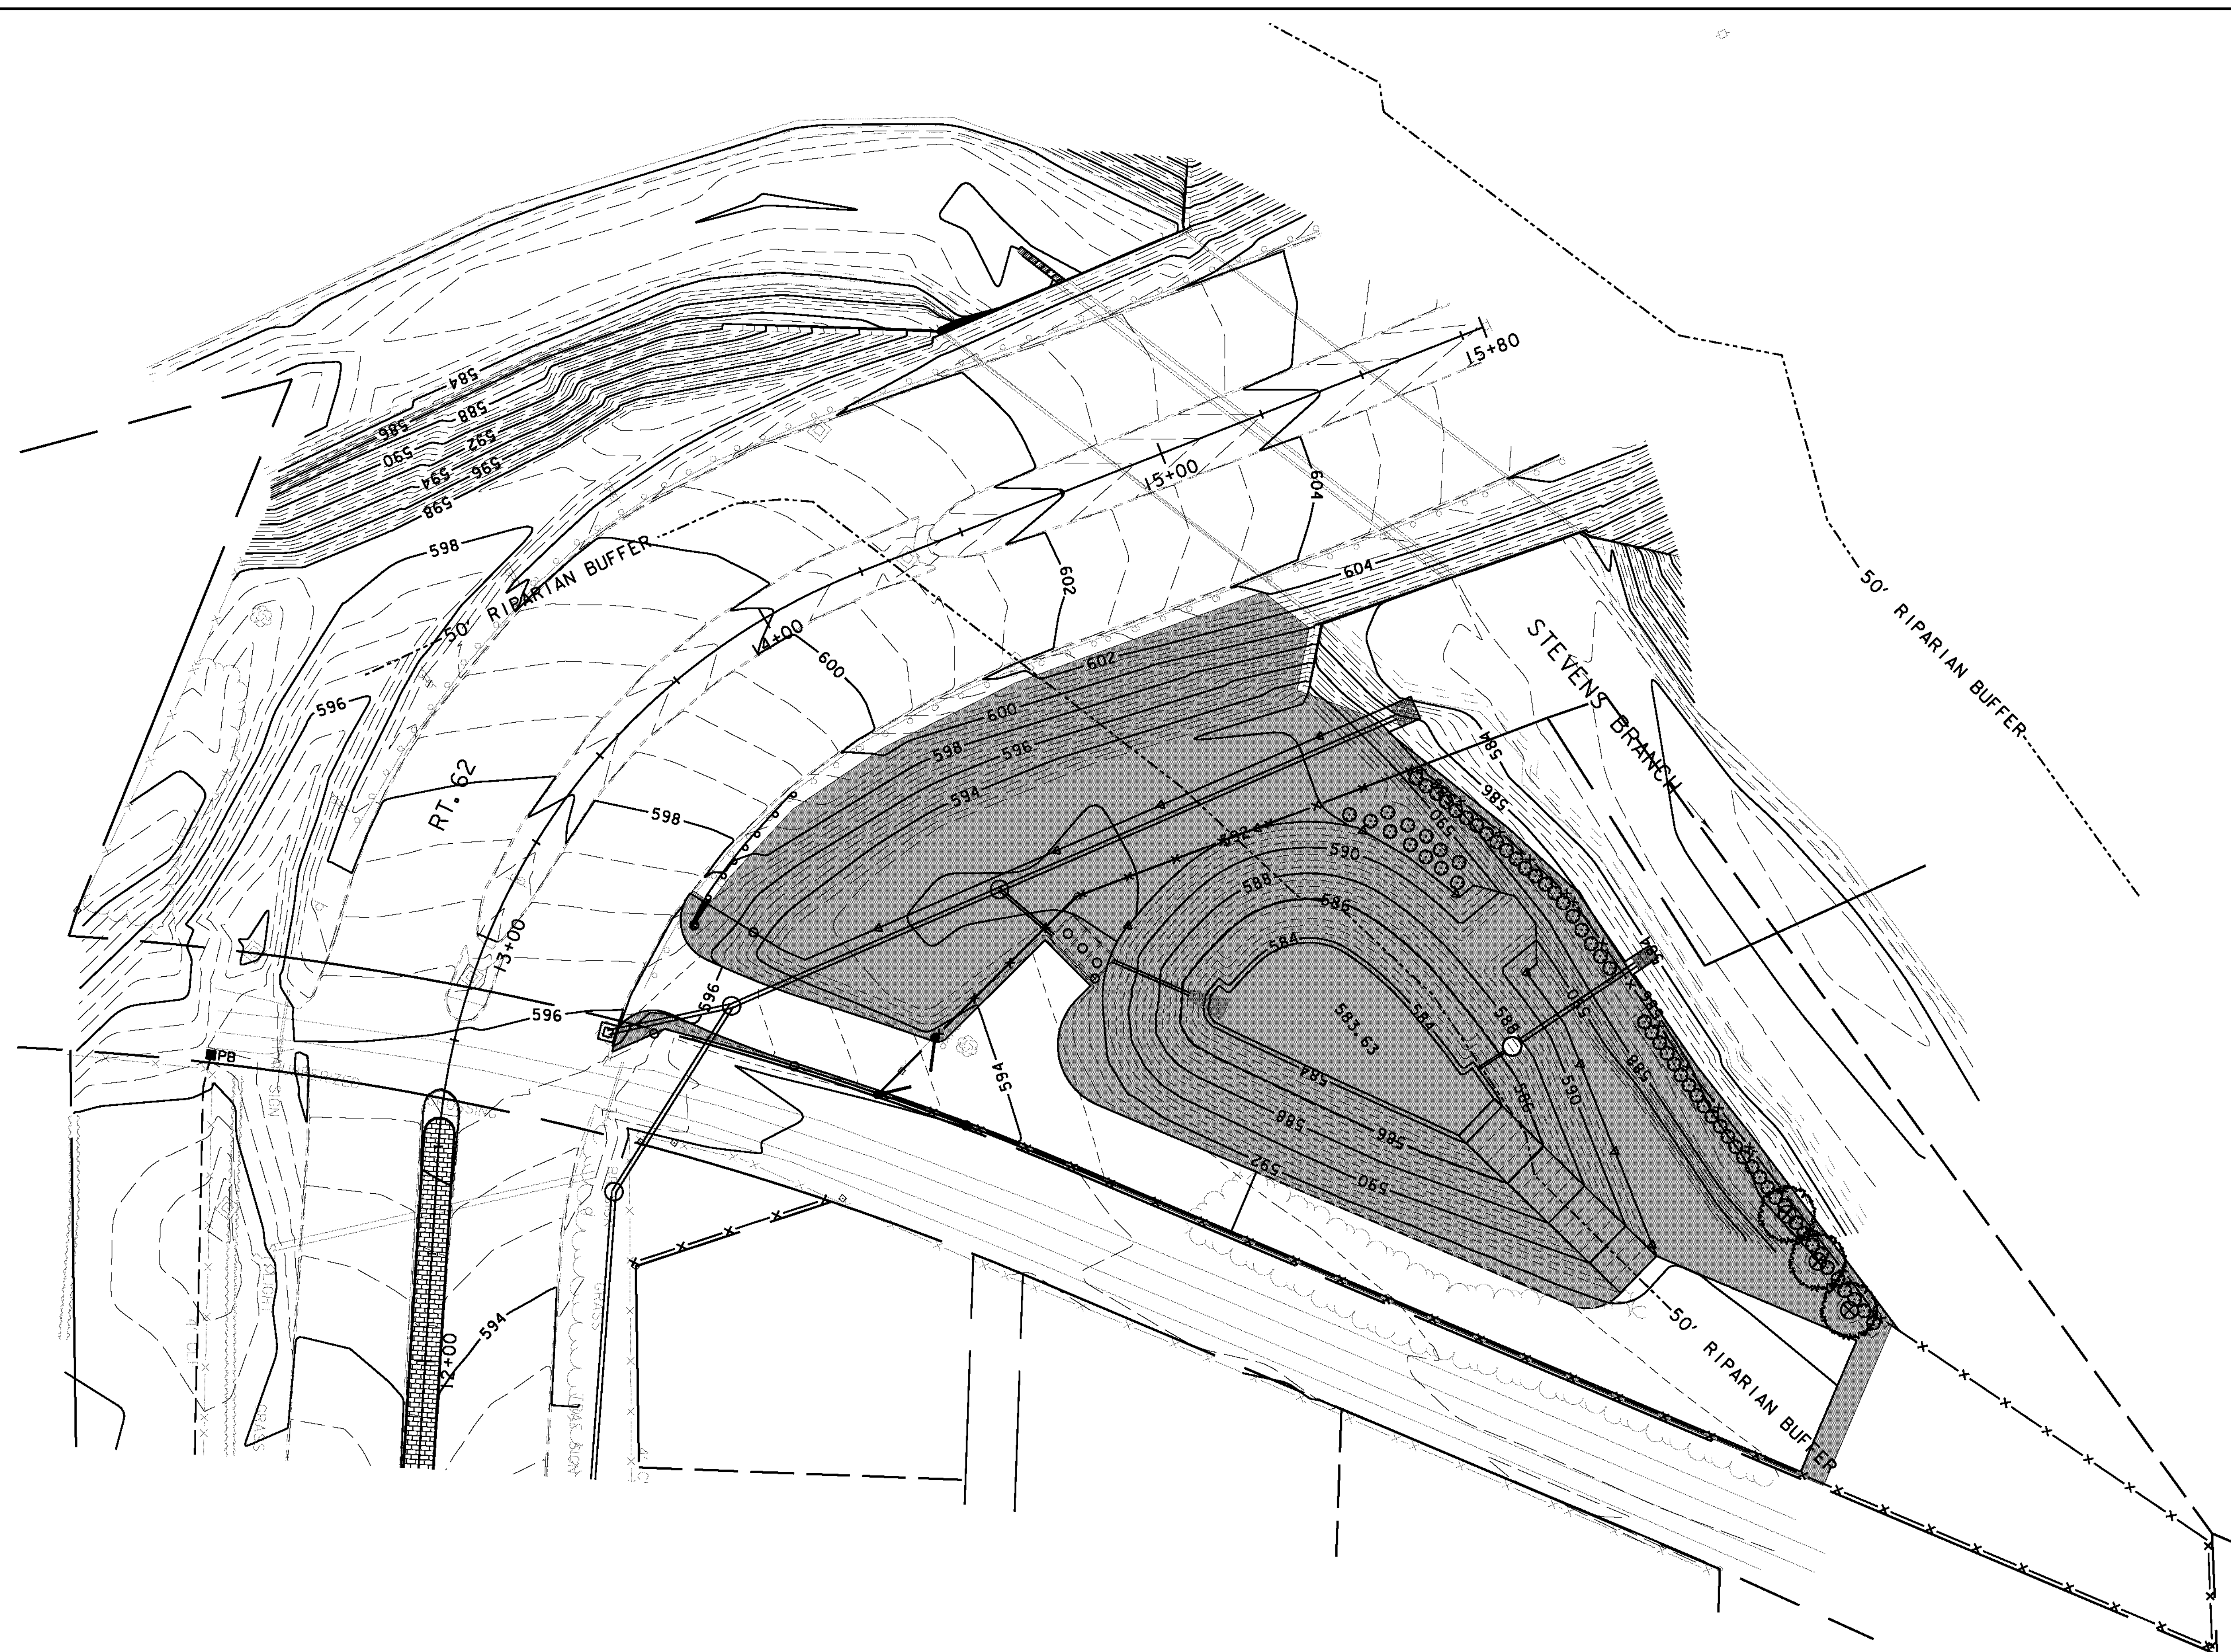

- NOTES:
1. ADD LANDSCAPE BACKFILL TO REVEGETATE
 2. INSTALL 18" DEPTH OF BACKFILL FOR PROPOSED SHRUBS.
 3. APPLY WET AREA SEED MIX ON AQUATIC BENCH AND BENCH SIDE SLOPES. SEE LANDSCAPING PLAN #6 (SHEET 90) FOR ADDITIONAL INFORMATION

LEGEND

— AER E&T —	AERIAL ELECTRIC & TELEPHONE
	DISTURBED AREAS REQUIRING RE-VEGETATION
- - - - -	RIPARIAN BUFFER ZONE
x-x-x-x-x	NEW FENCE
- - - - -	PROPOSED FIELD DRIVE

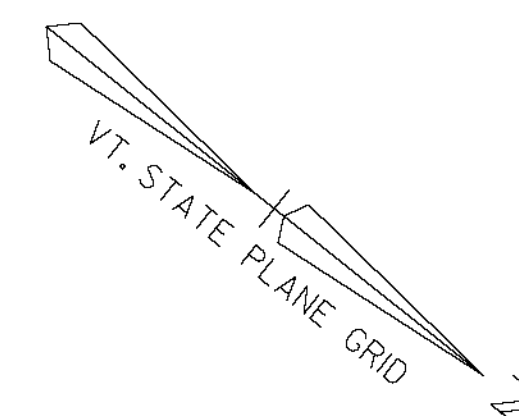

VHB Vanasse Hangen Brustlin, Inc.

EPSC FINAL CONDITION SITE PLAN

PROJECT NAME: BARRE CITY	
PROJECT NUMBER: FECC F 026-1(34) C/2	
FILE NAME: z85b010_ER0_FC_C2.dgn	PLOT DATE: 3/9/2011
PROJECT LEADER: G. BAKOS	DRAWN BY: DMP / DEJ
DESIGNED BY: DMP / DEJ	CHECKED BY:
EPSC FINAL CONDITION SITE PLAN	SHEET 162 OF 339