



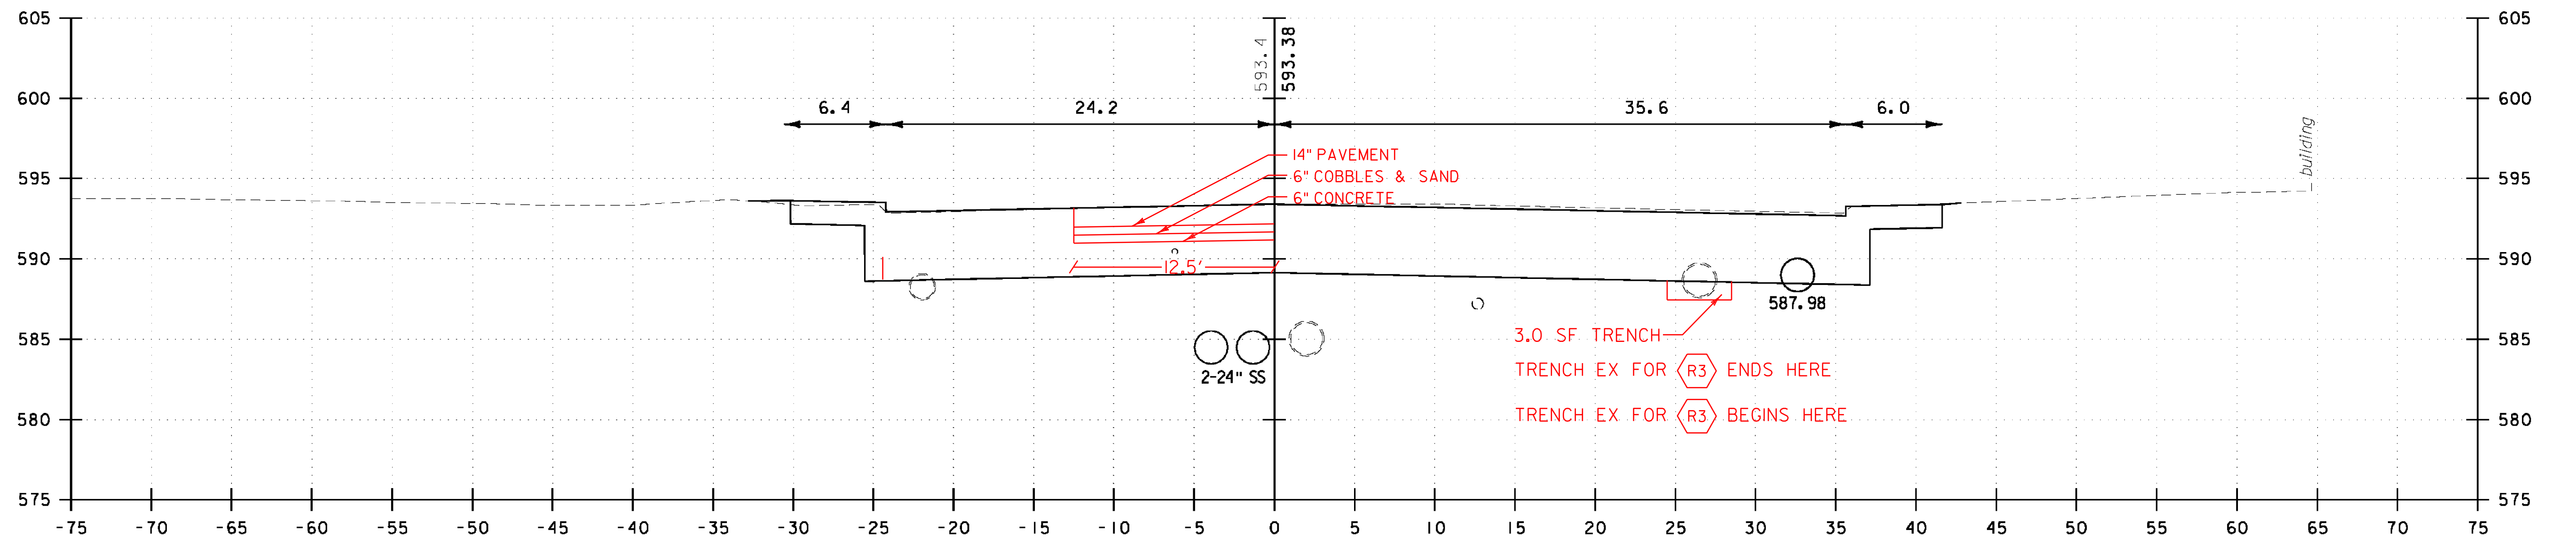

113+00
END APPROACH/BEGIN PROJECT STA. 113+00

EXCAVATION ~ (4.25' X 63') + (2.5' X 1.42') = 282 SF
DENSE GRADED ~ 2.00' X 63' = 126 SF
SAND BORROW ~ 1.50' X 63' = 94.5 SF

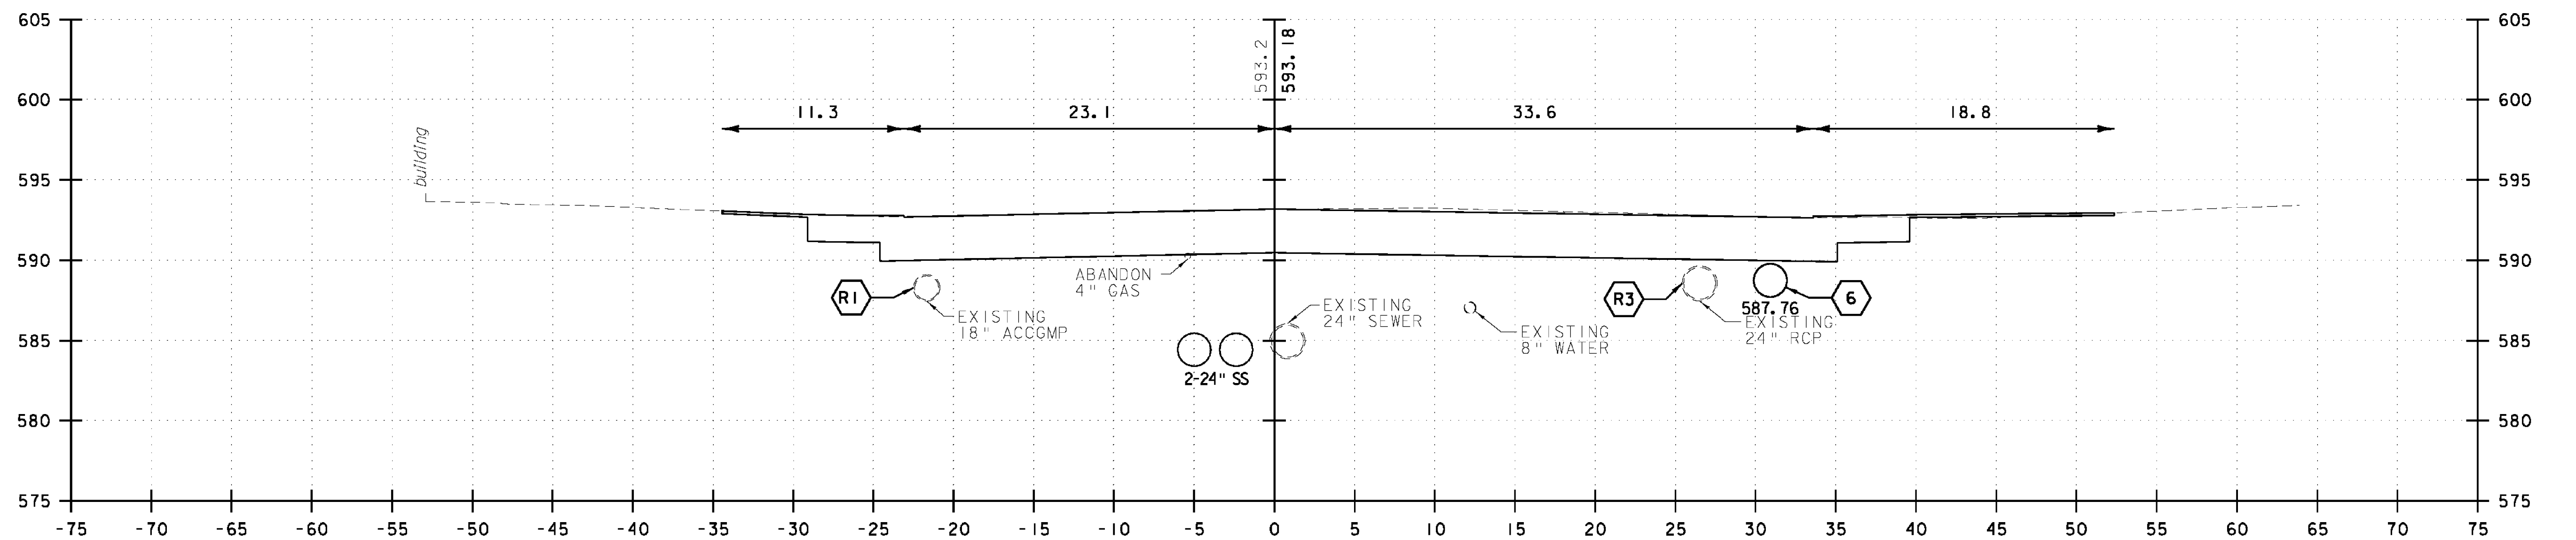

112+55

+55
DRIVE R

5 0 5 10
FEET

VHB Vanasse Hangen Brustlin, Inc.

NORTH MAIN STREET (US 302)	
PROJECT NAME:	BARRE CITY
PROJECT NUMBER:	FEGC F 026-(134) C/2
FILE NAME:	85b010_xsl.Cut_C2
PROJECT LEADER:	G. BAKOS
DESIGNED BY:	DMP / MDS
CROSS SECTIONS	
PLOT DATE:	3/9/2011
DRAWN BY:	DMP / JAR
CHECKED BY:	
SHEET	233 OF 339