




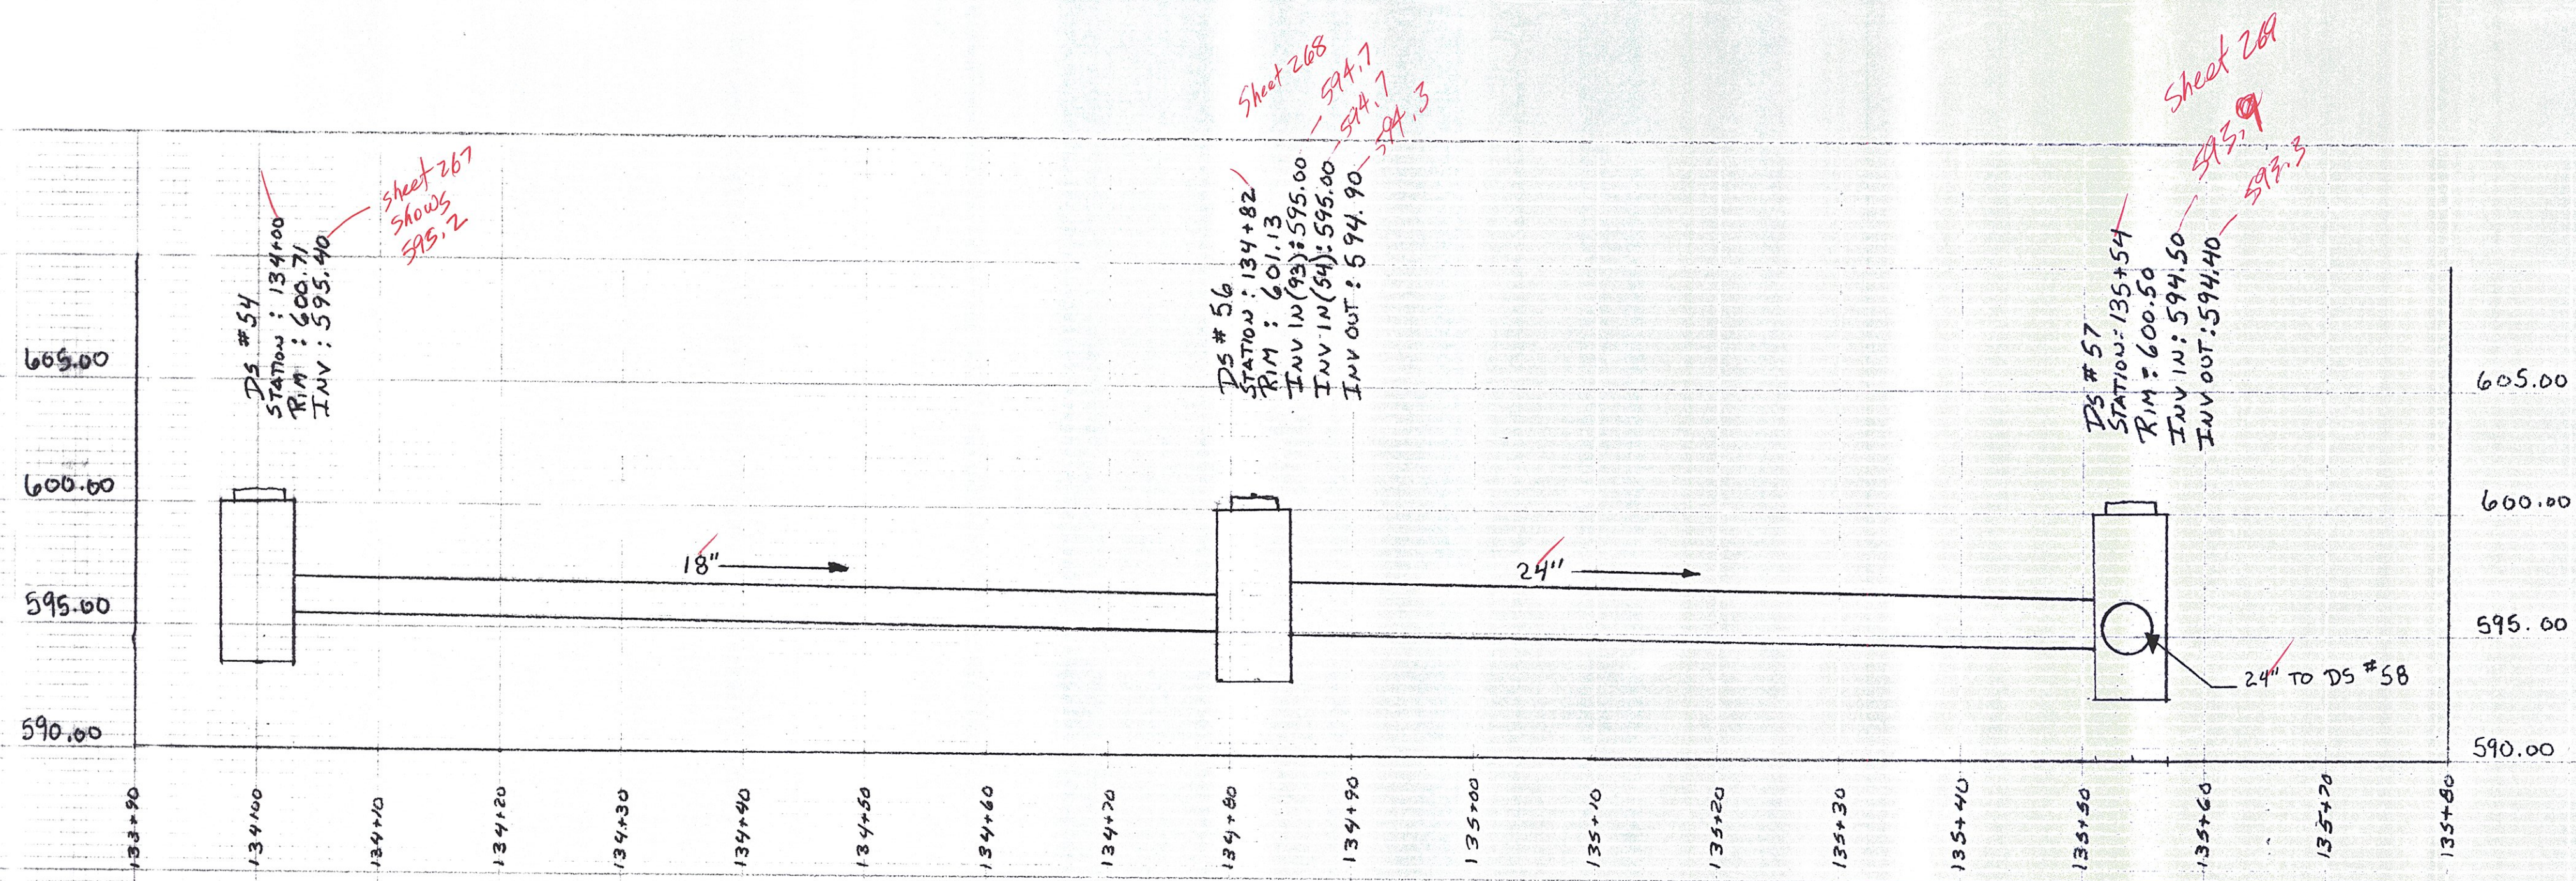

DRAINAGE RUN (54) TO (56)

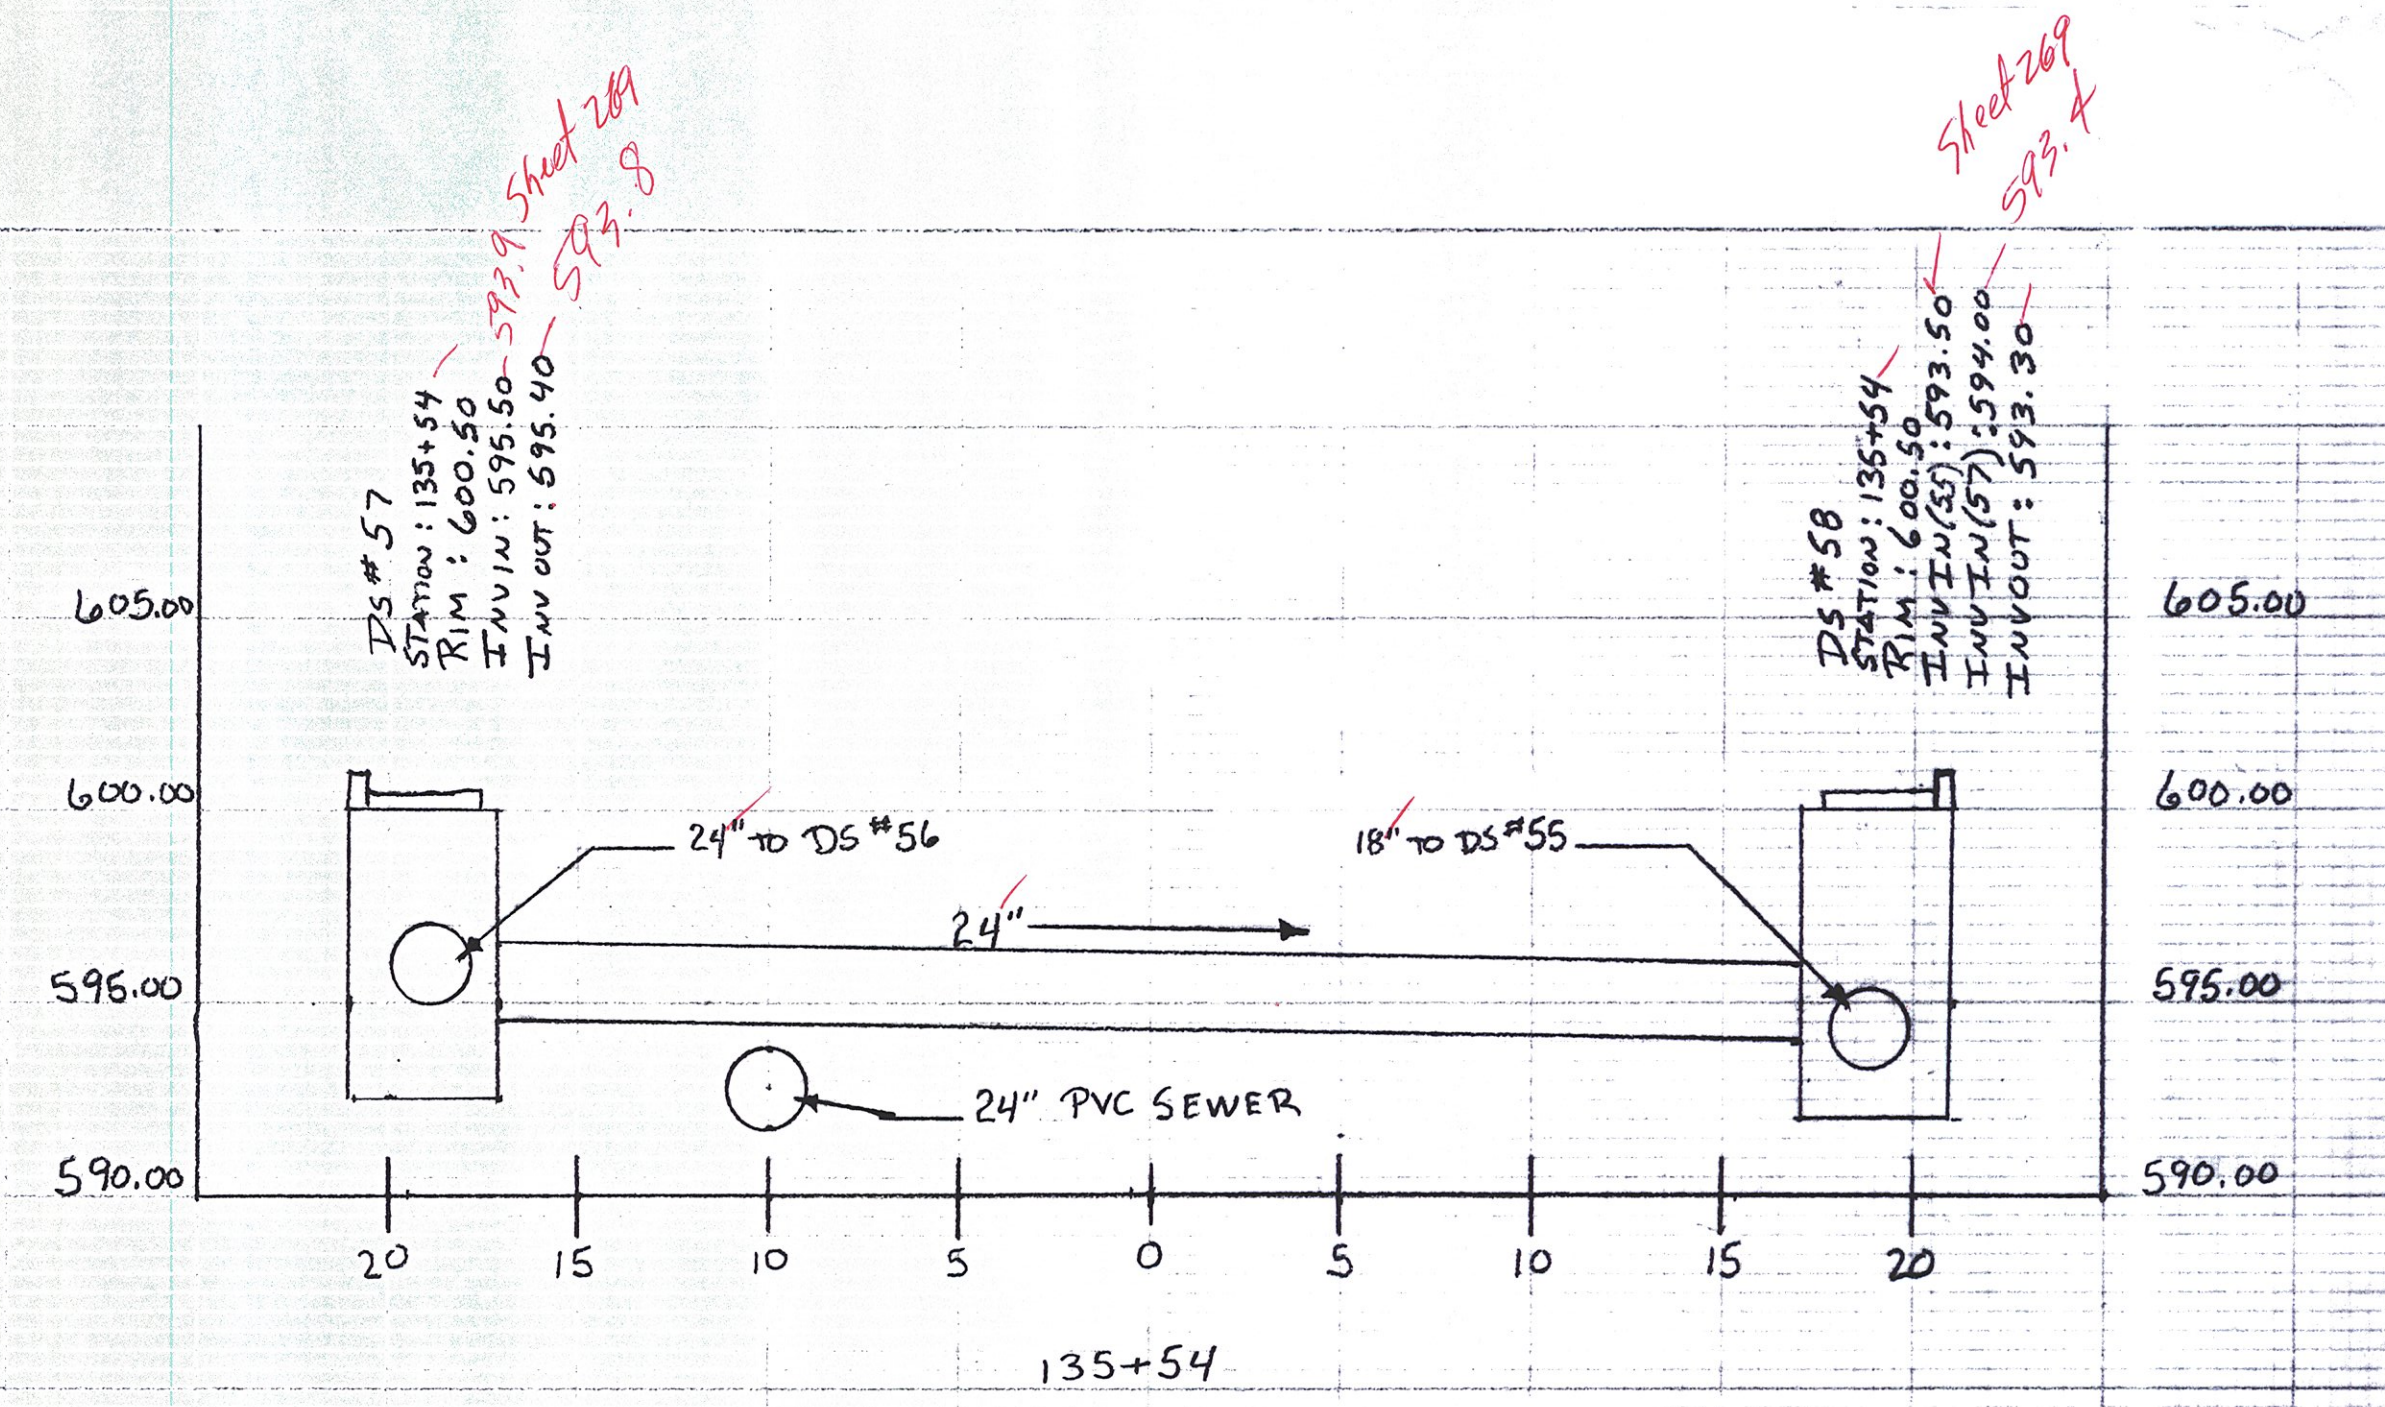

DRAINAGE X-ING (57) TO (58)

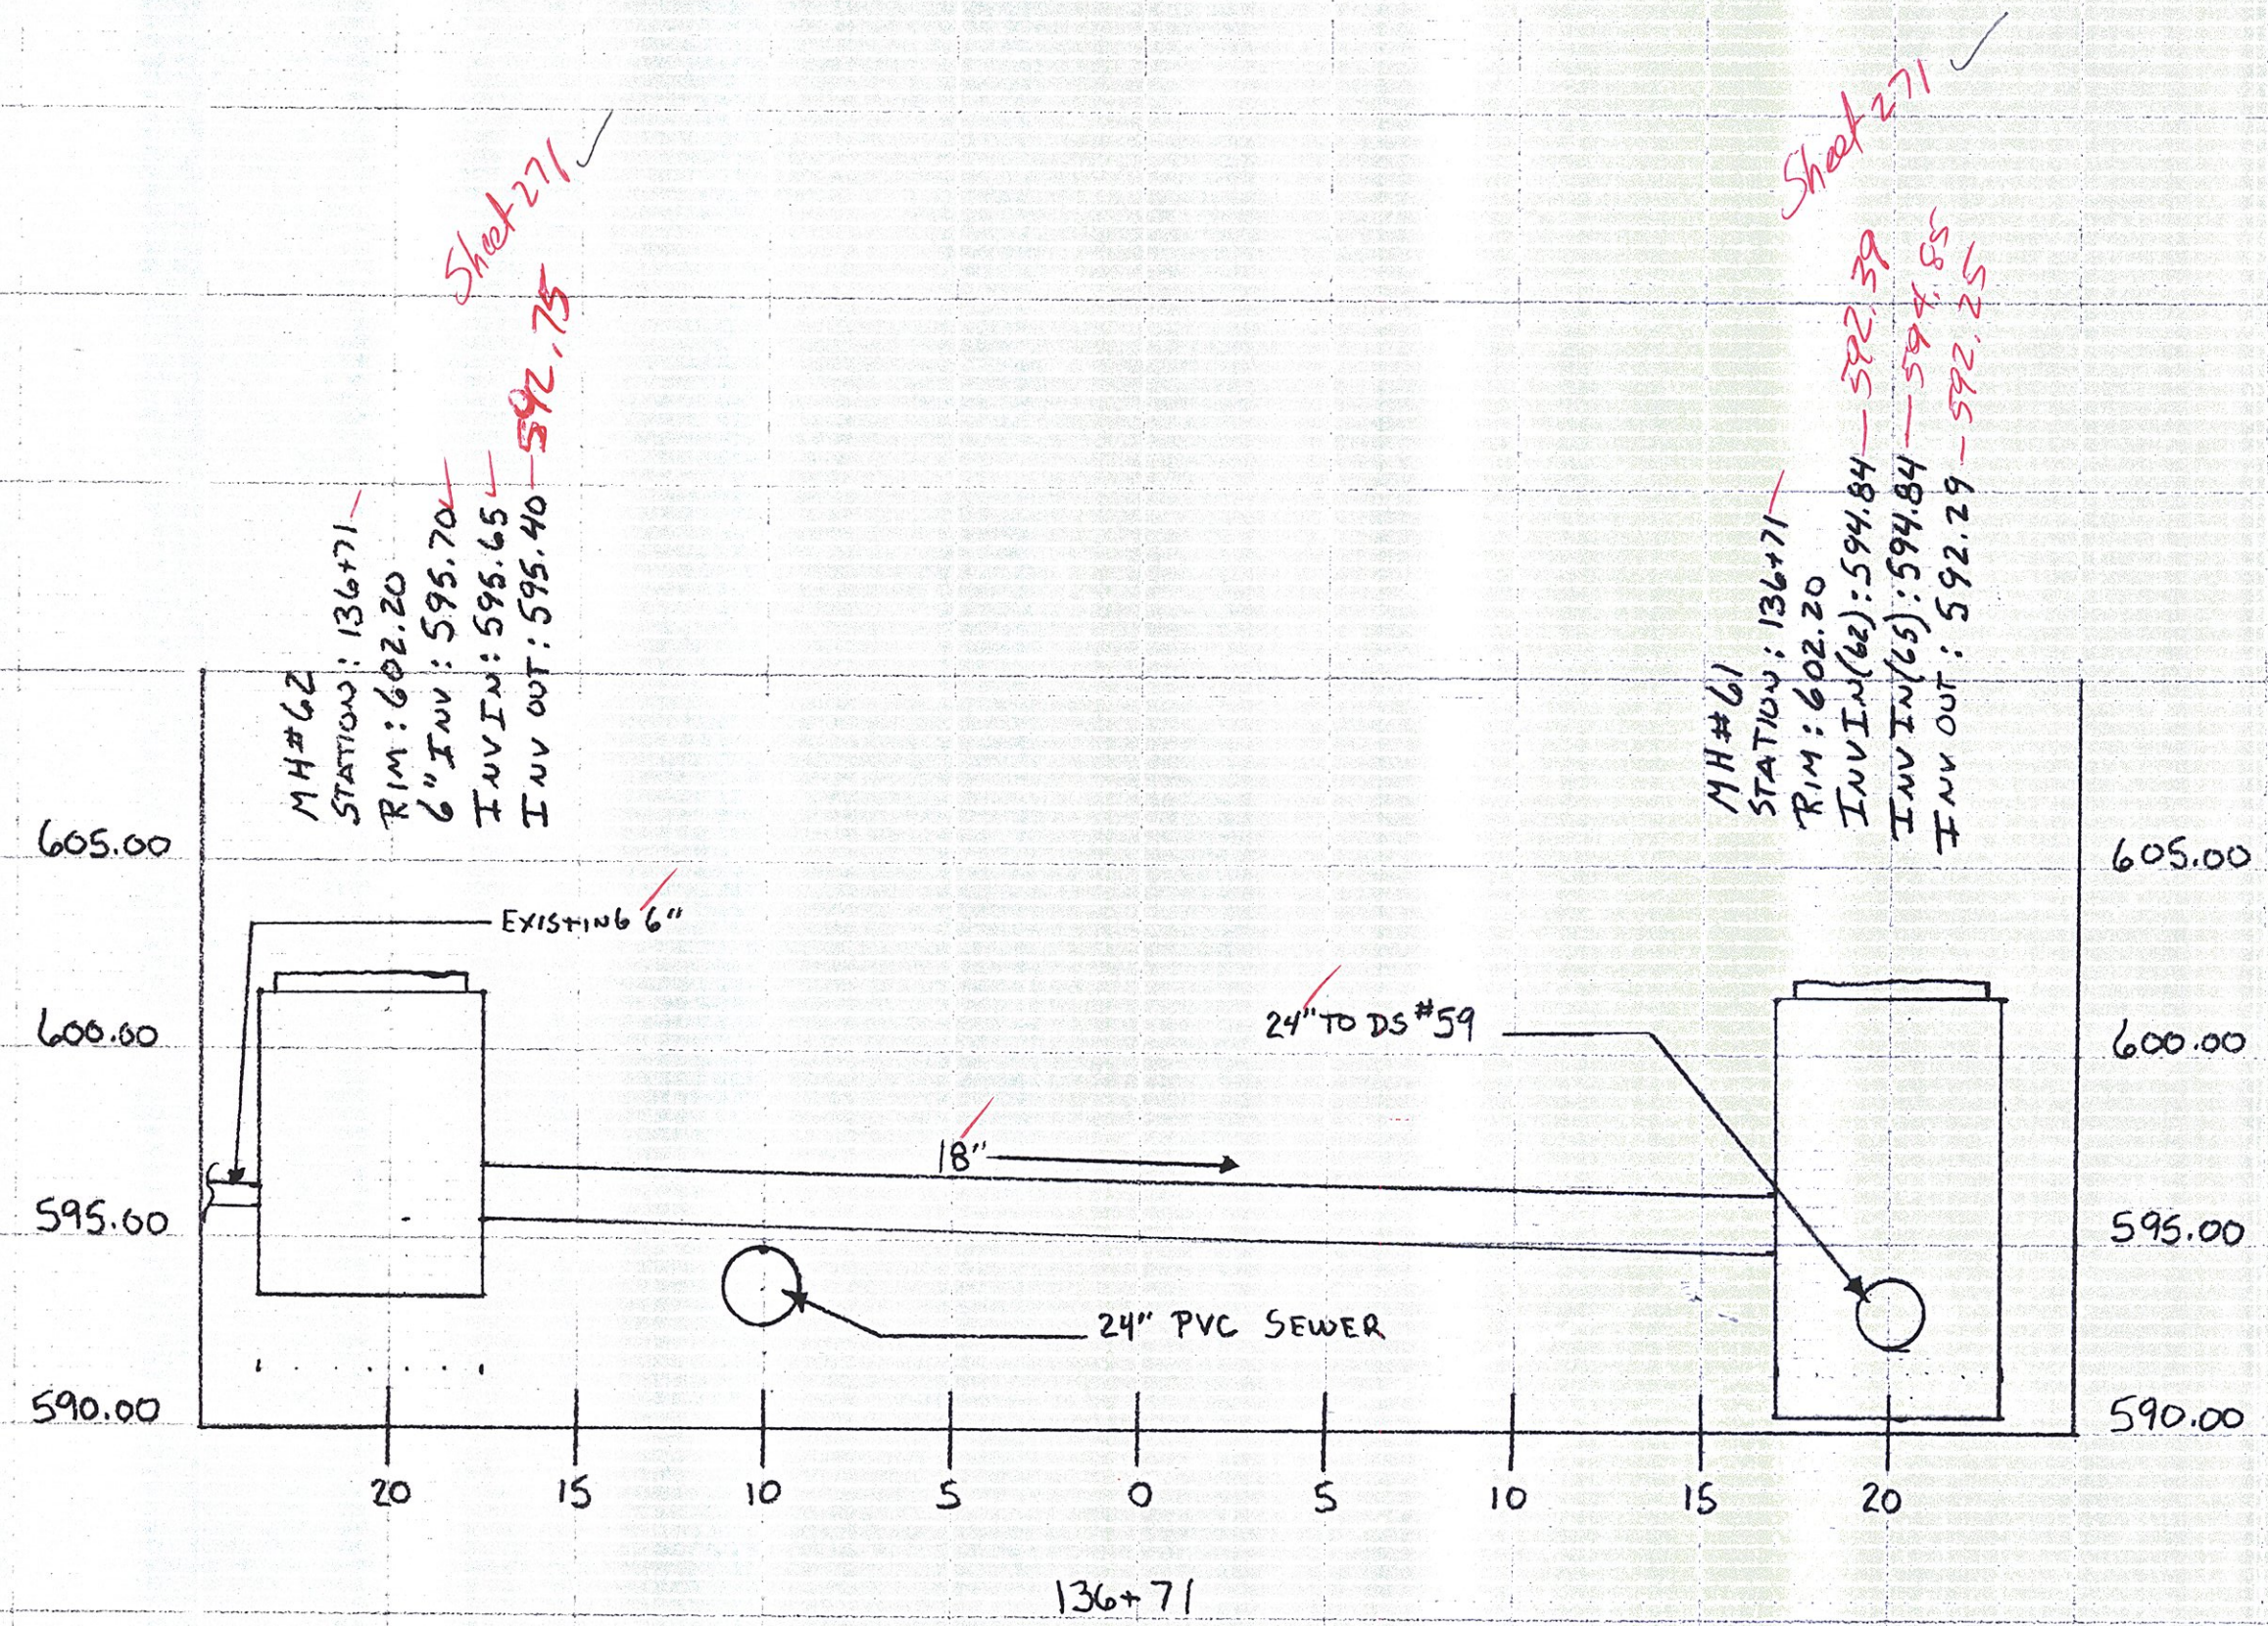

PROJECT NAME: BARRE CITY

PROJECT NUMBER: FECC F 026-1(34) C/2

FILE NAME: SAN PROFILES

MANAGER: J. LUCK

DRAWN BY: C. KEMPNEY

NOTES / REVISIONS	
ISSUED:	2/7/2012

PROPOSED REDESIGN STORM SEWER PROFILES