


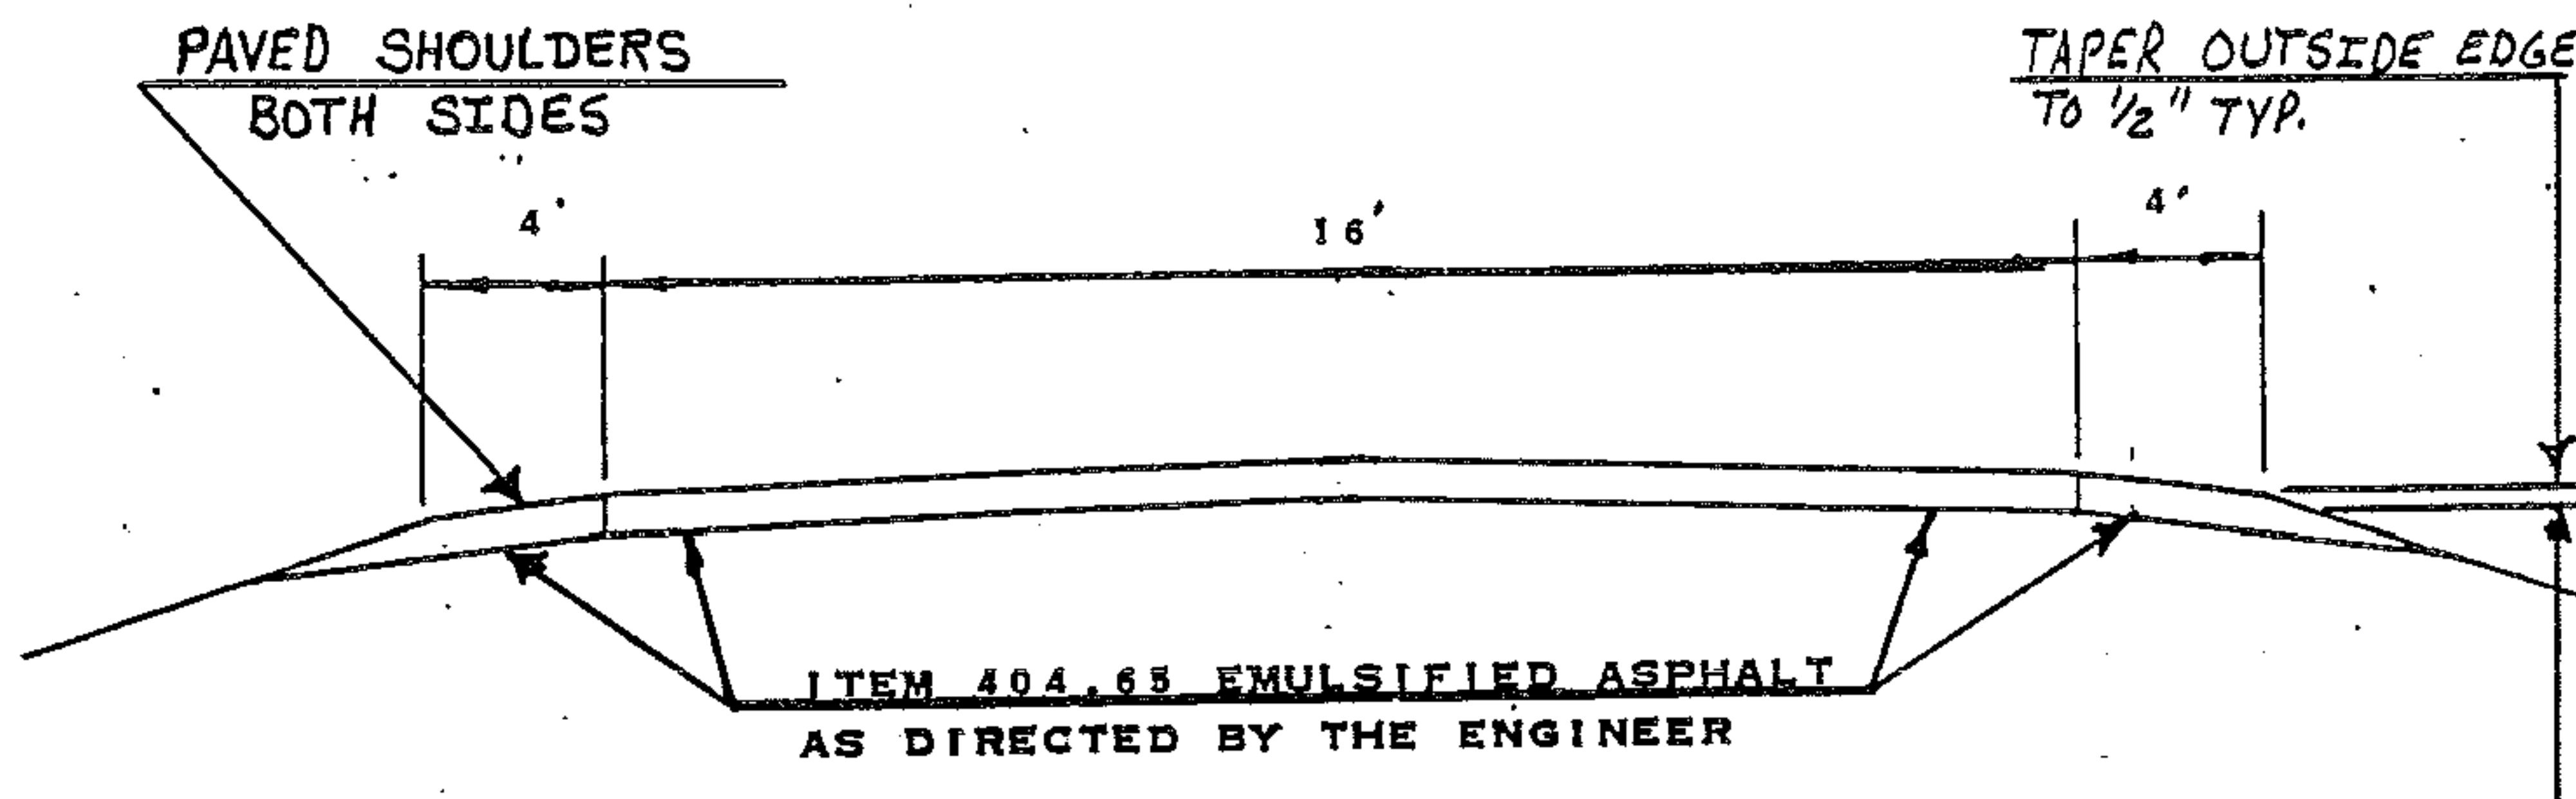

FAIRHAVEN
MM 0.000 MM 0.088
JUGHANDLE

1982 ADT 50
V 50