



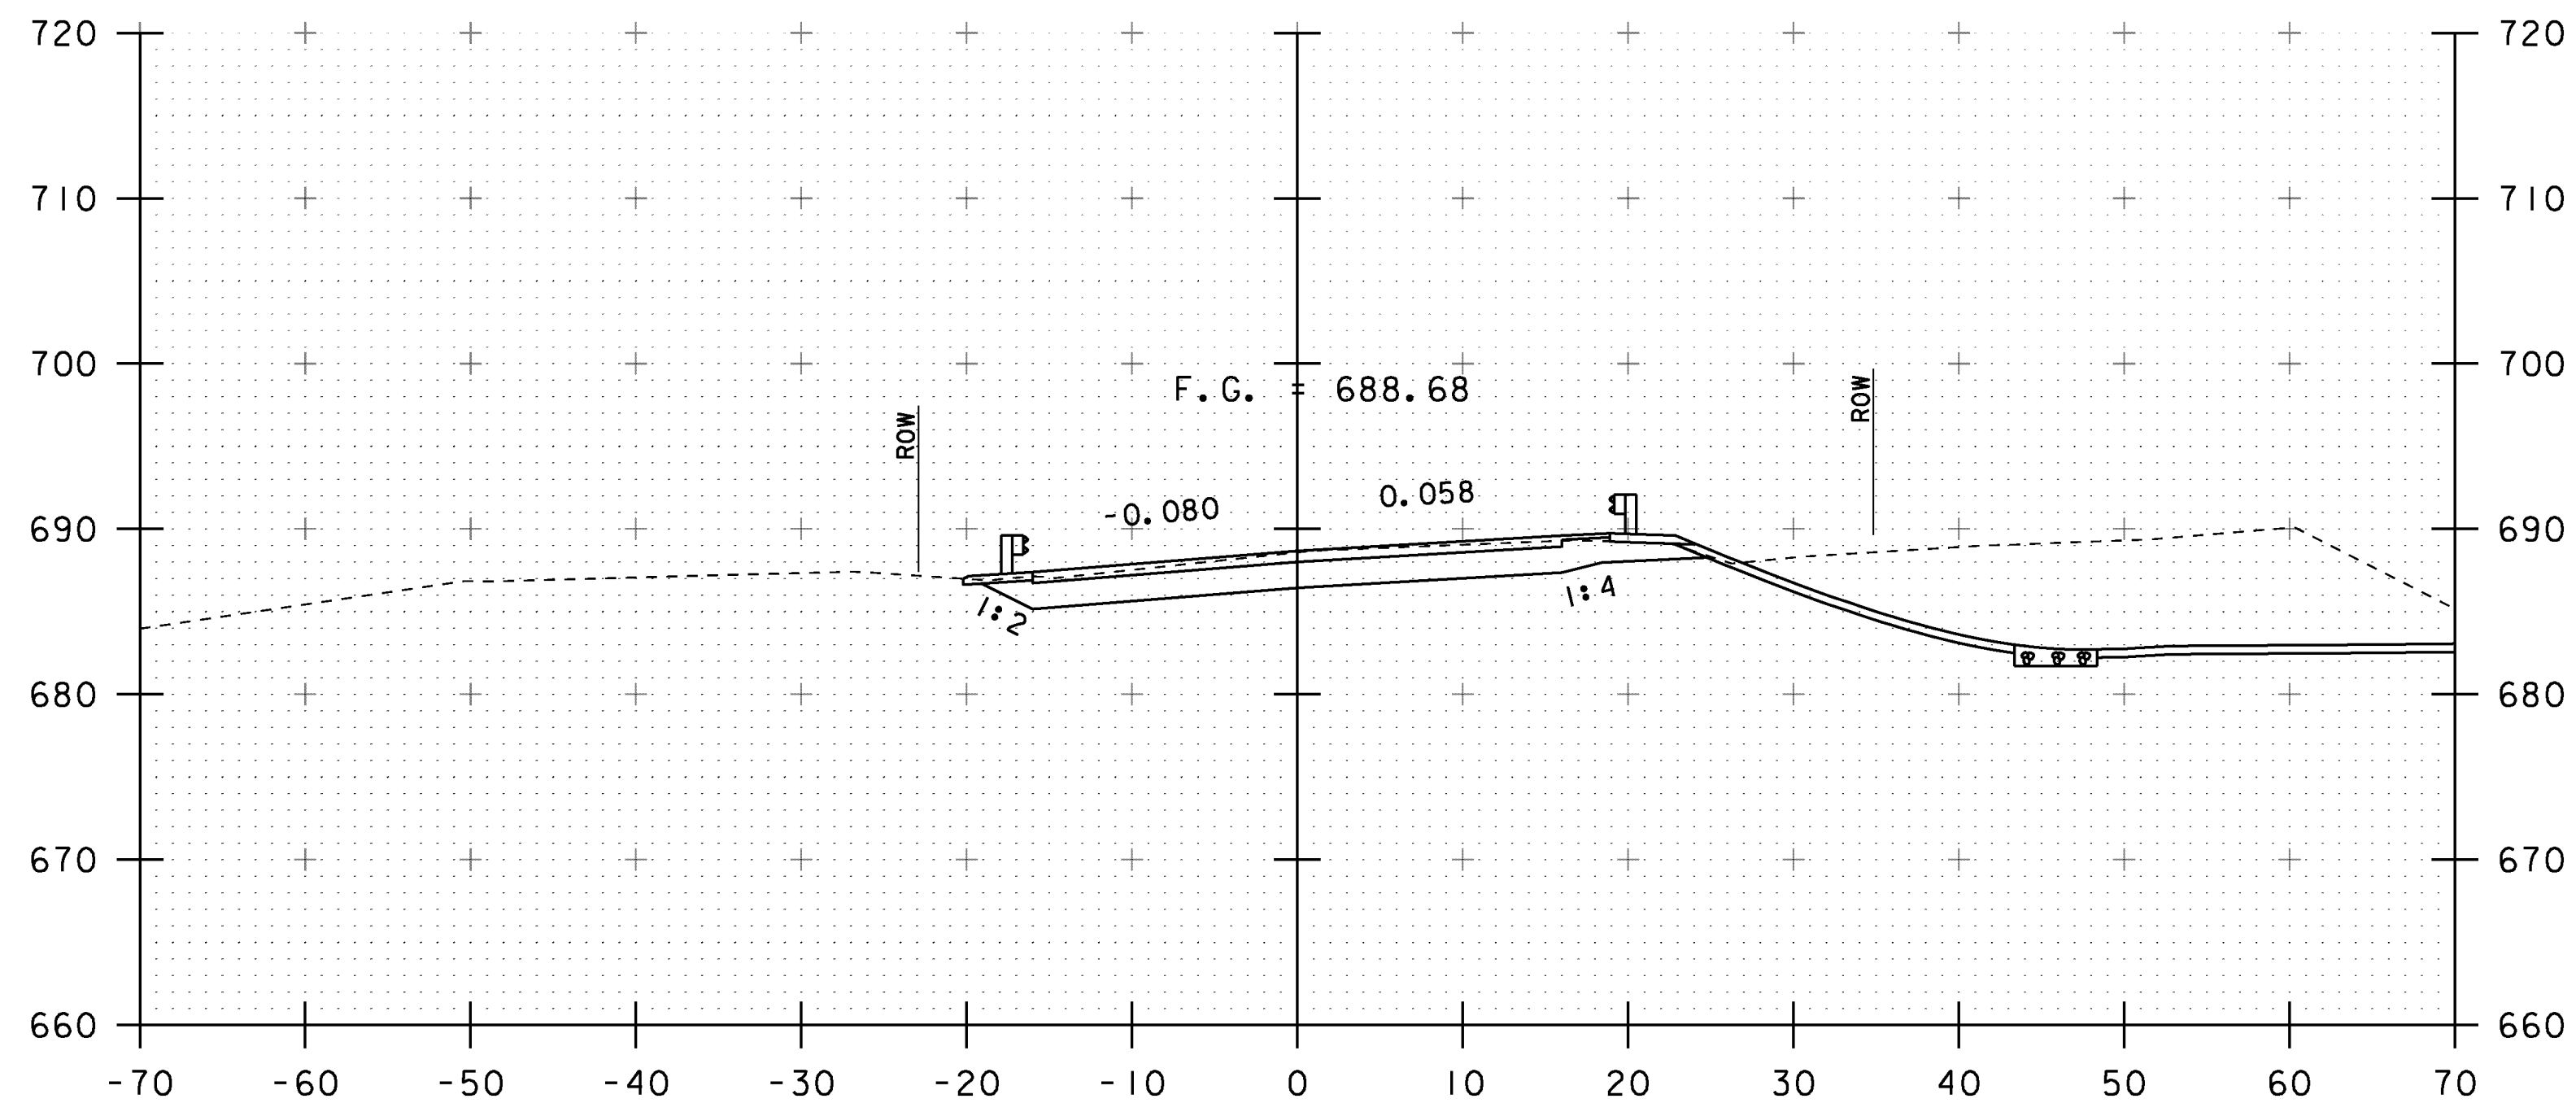


STA 16+00.00
END PROJECT
BEGIN APPROACH


16+00

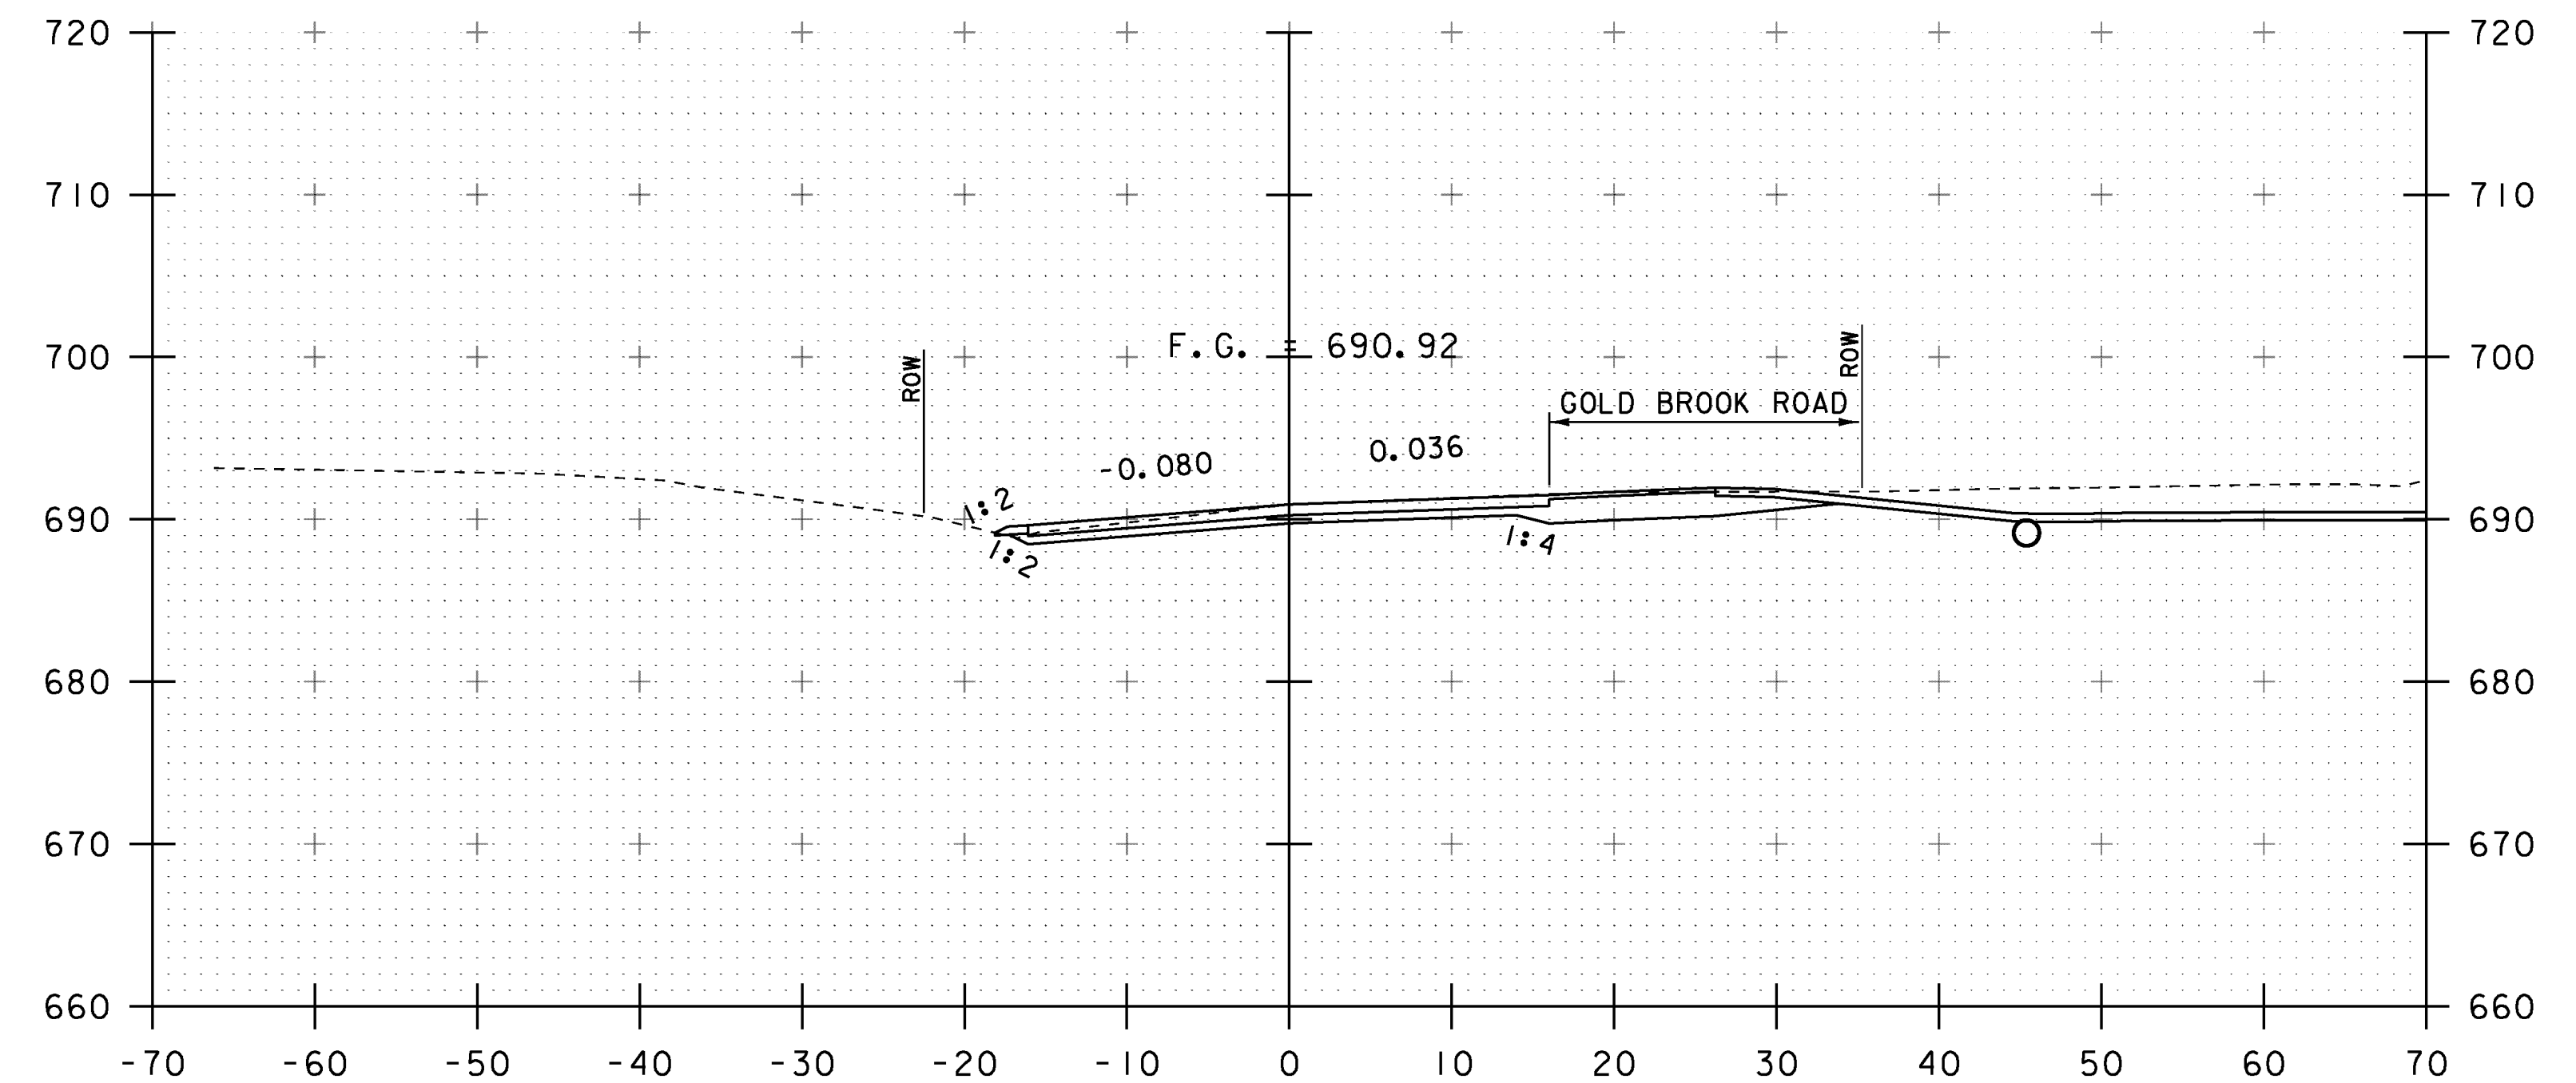


16+50

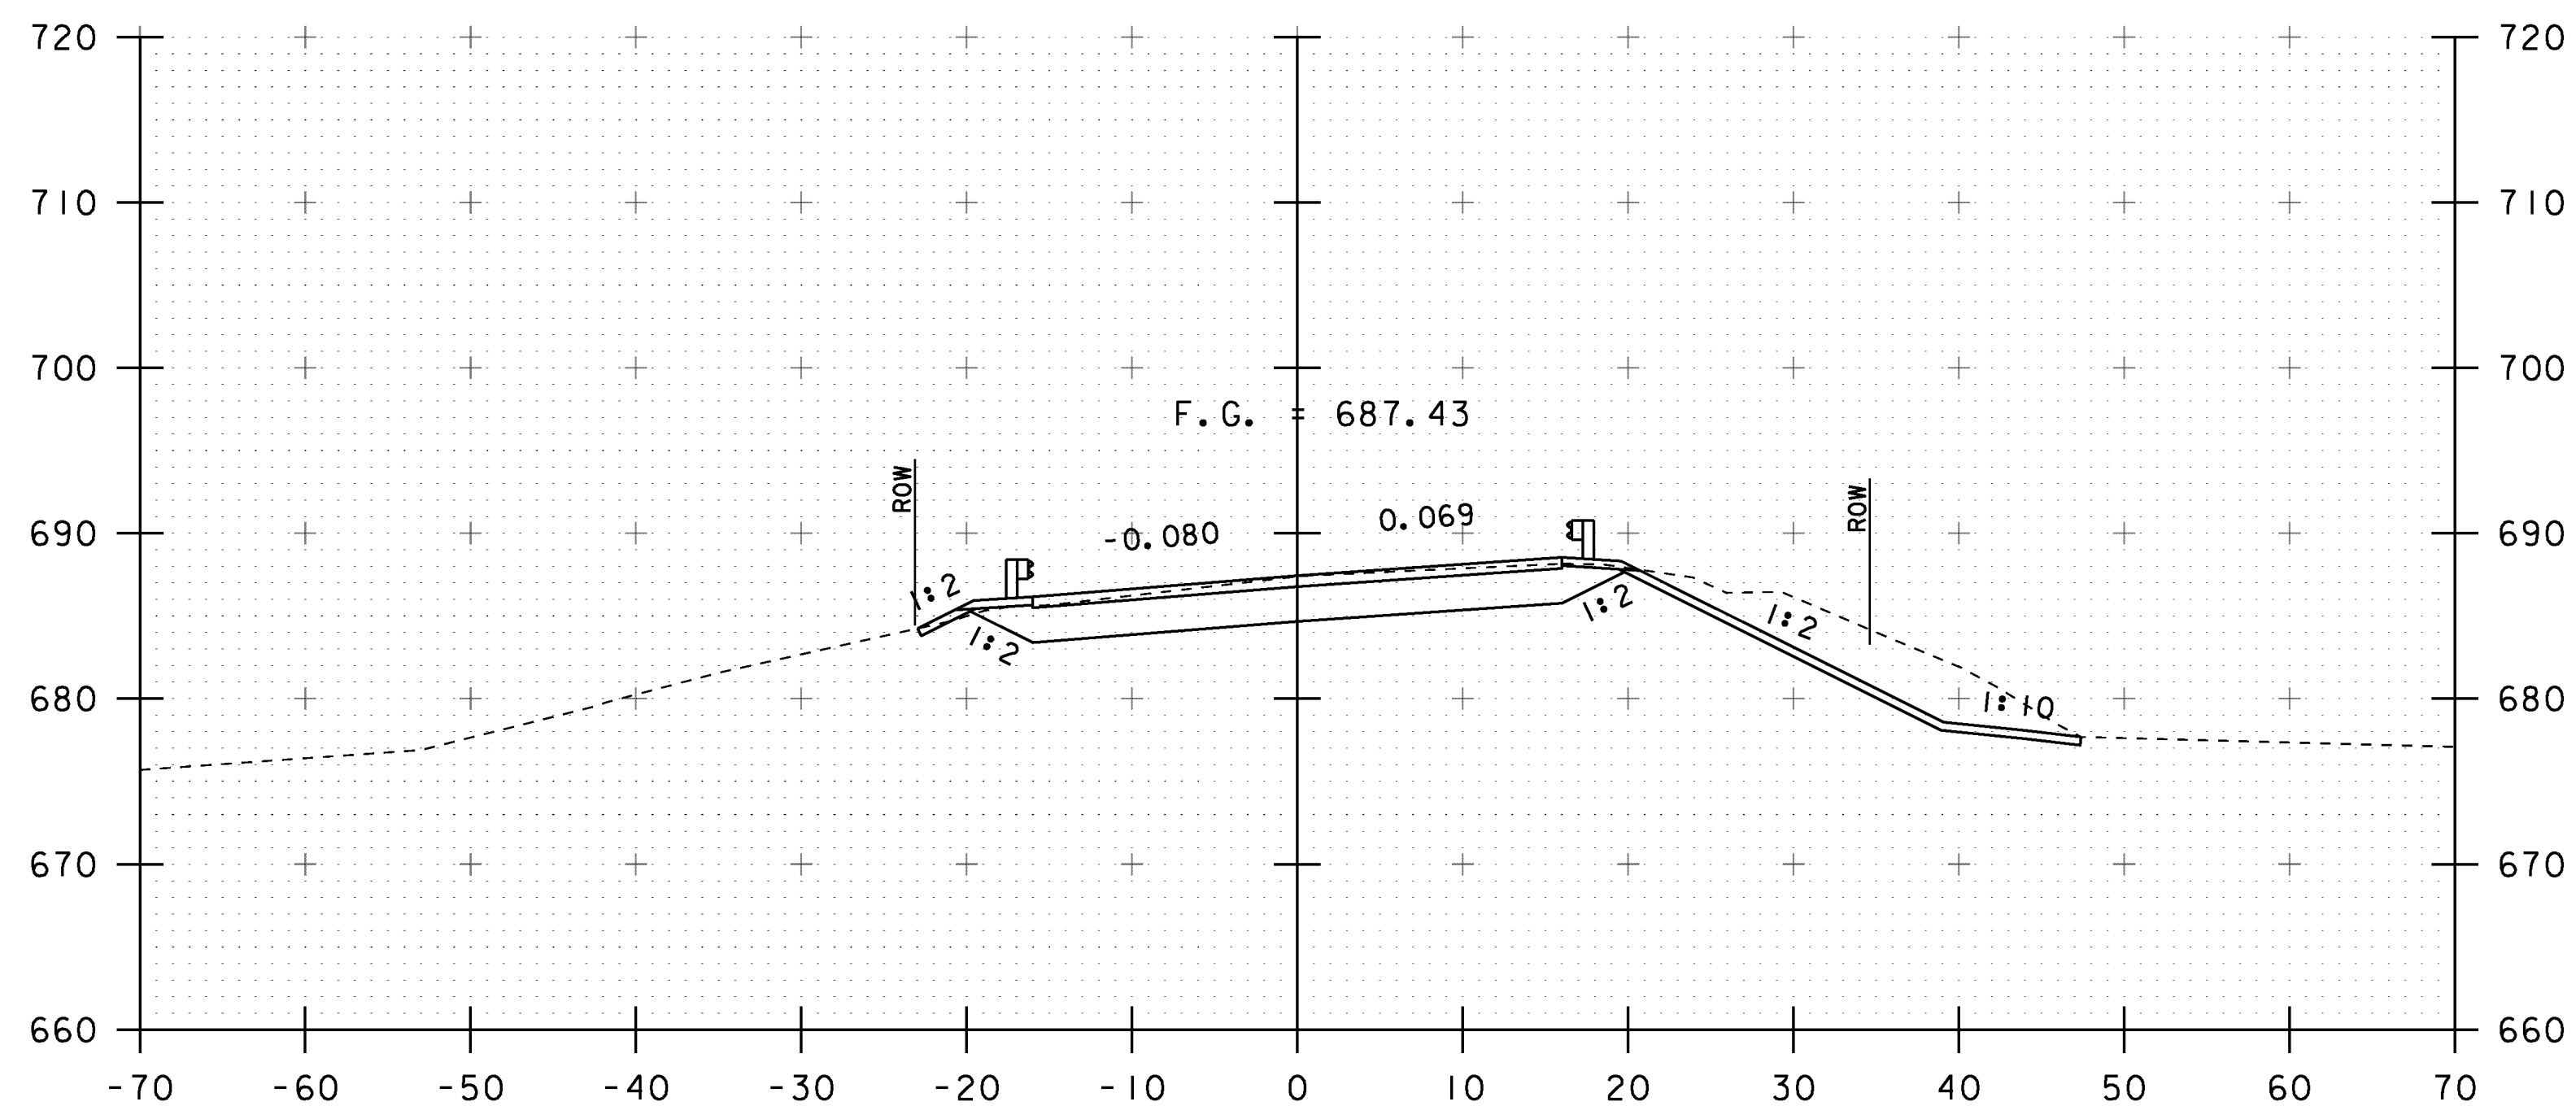

15+75

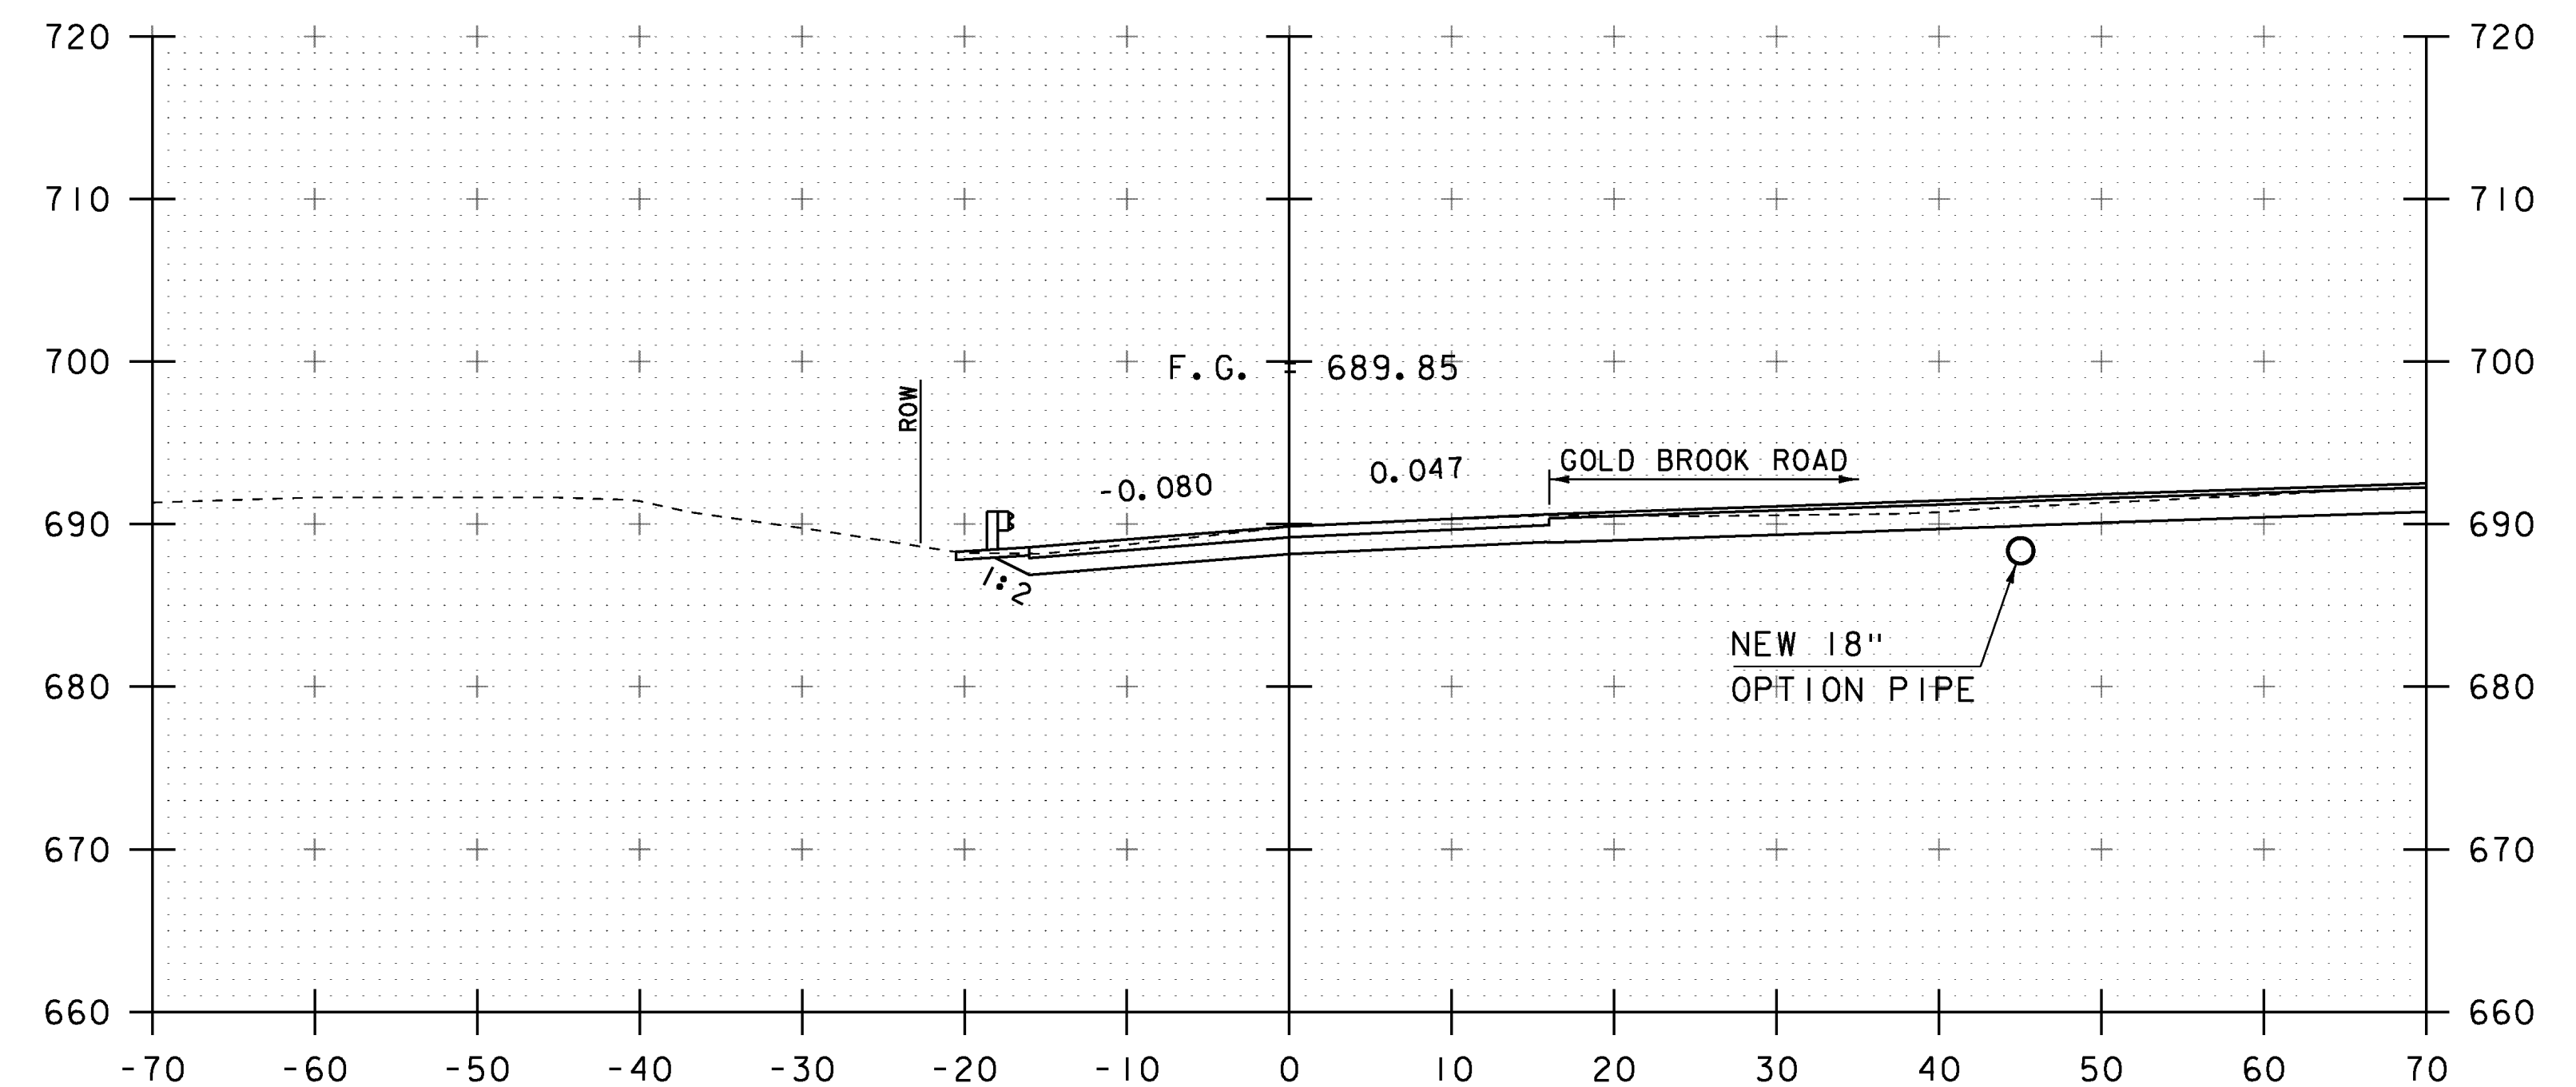

16+25

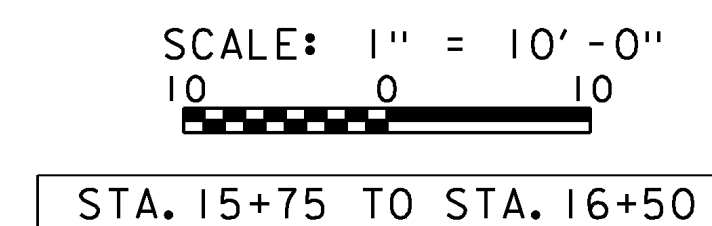

PROJECT NAME:	STOWE	PLOT DATE:	17-JUN-2013
PROJECT NUMBER:	BRF 029-1 (17)	DRAWN BY:	R. PELLETT
FILE NAME:	s85e037xsl.dgn	CHECKED BY:	G. ROY
PROJECT LEADER:	C. CARLSON	SHEET	46 OF 70
DESIGNED BY:	H. SALLS		
MAINLINE CROSS SECTIONS	4		