




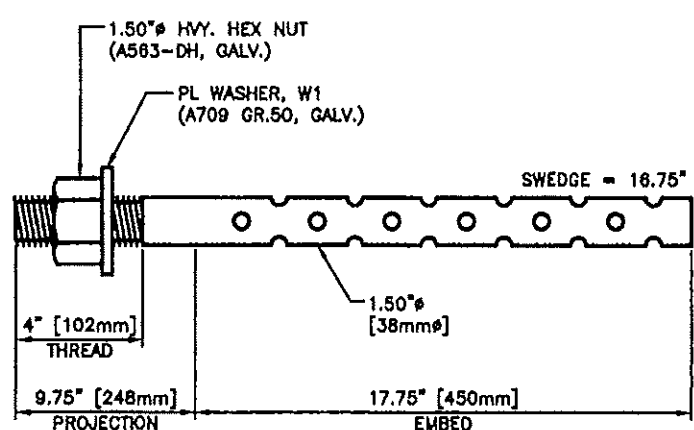


ANCHOR BOLTS FOR FB-1 BRG. ASS'YS
MK. AB1
 RD 1.50" x 27.50"
 4 REQ'D
 ASTM A449 (GALV.)

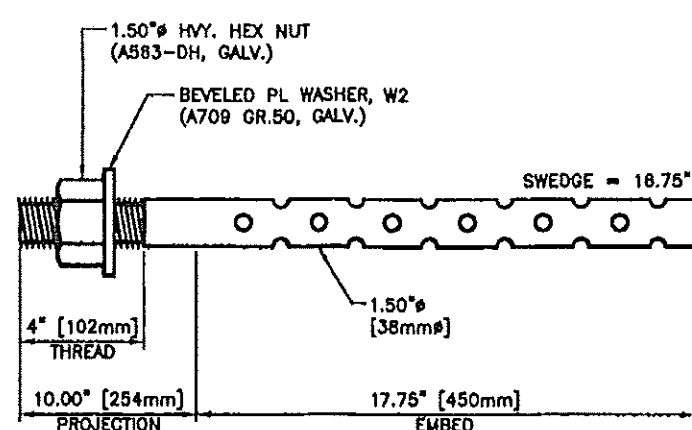


ANCHOR BOLTS FOR NG-1 BRG. ASS'YS
MK. AB2
 RD 1.50" x 27.75"
 6 REQ'D
 ASTM A449 (GALV.)

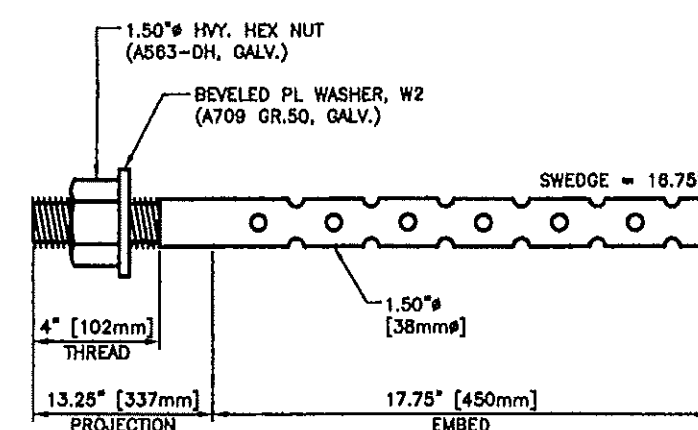

ANCHOR BOLTS FOR GE-1 BRG. ASS'YS
MK. AB3
 RD 1.50" x 31.00"
 4 REQ'D
 ASTM A449 (GALV.)

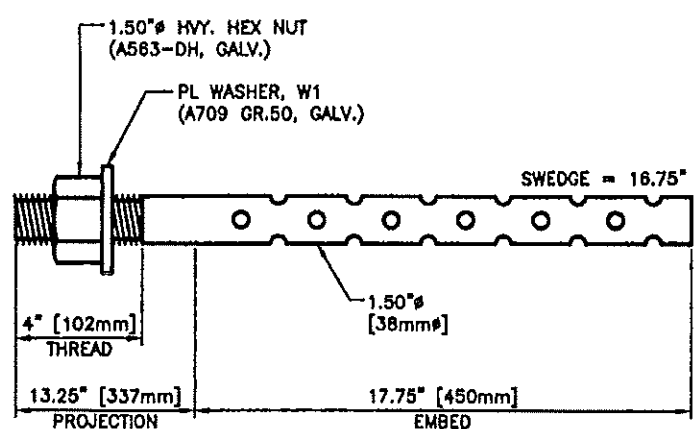

ANCHOR BOLTS FOR IG-1 BRG. ASS'YS
MK. AB4
 RD 1.50" x 31.00"
 6 REQ'D
 ASTM A449 (GALV.)

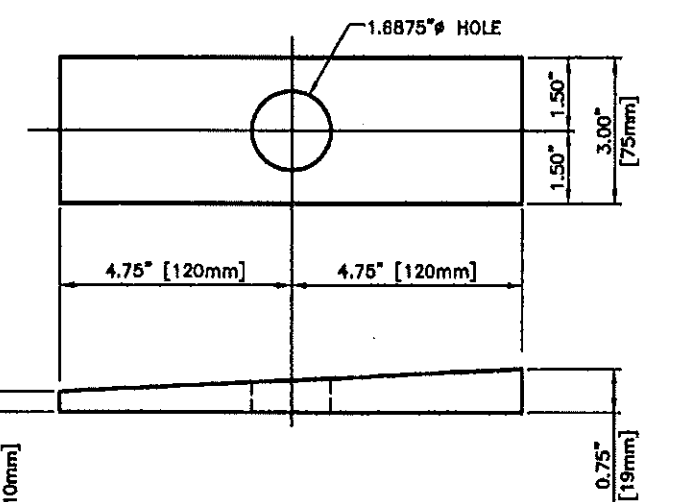

BEVELED PLATE WASHER, MK. W2
10 REQ'D
 PL 0.75" x 3.00" x 0.50"
 [PL 19mm x 76mm x 240mm]
 (ASTM A709 GR.50, GALV.)

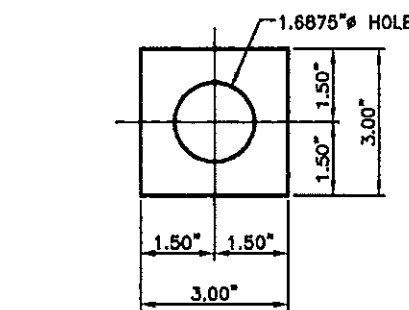


PLATE WASHER, MK. W1
10 REQ'D
 PL 0.375" x 3.00" x 3.00"
 [PL 10mm x 76mm x 76mm]
 (ASTM A709 GR.50, GALV.)

RECEIVED
 CMTD BY: *SS* DTD BY: *RY*
 DEC 23 2010
 RESUBMIT APPROVED
 BY: *CPW* DATE: 12/30/10

SEE NOTES ON SHEET 0N1

		STATE OF VERMONT AGENCY OF TRANSPORTATION BRIDGE ON ROUTE 107 TOWN OF STOCKBRIDGE, VT	
STATE	COUNTY	B.L.N.	
VT	WINDSOR	N/A	
PROJ. NO.: BR-022-(20)		COSMEC, INC.	
POT BEARING ASSEMBLIES		Cosmea	
SCALE: NONE	DATE: 11/2/10	DATE: 11/11/10	
SHEET 6 OF 6		JOB NO.: 10716	
REV. DESCRIPTION		DRAWING NUMBER: 10716-001-0	