



ABM INFO		SHIP	BILL OF MATERIAL				JOB NO.	DRAWING NO.	REV.
PAGE	LINE	MARK	QTY	MARK	MATERIAL	LENGTH	457	5	
						m	REMARKS	WT	PROCUREMENT NOTES
		5G5	1		GIRDER			17979 kg 39536 lbs	
1	L		1	wa	PL 16x1536	22 482	M270M-345WT2		
1	J		1	wb	PL 16x1536	23 023	M270M-345WT2		
1	E		1	ta	PL 24x400	24 230	M270M-345WT2		
1	G		1	tb	PL 24x400	21 263	M270M-345WT2		
1	C		1	ba	PL 24x450	10 217	M270M-345WT2		
1	A		1	bb	PL 42x450	25 000	M270M-345WT2		
1	C		1	bc	PL 24x450	10 216	M270M-345WT2		
2	B		2	xla	PL 18x175	1 536	M1E		
2	B		1	xlc	PL 18x175	1 536	M1E		
2	B		1	xld	PL 18x175	1 536	M1E		
2	C		1	xlg	PL 14x175	1 536			
2	C		1	xlk	PL 14x175	1 536			
2	C		1	xlm	PL 14x175	1 536			
2	C		1	xln	PL 14x175	1 536			
2	C		1	xlp	PL 14x175	1 536			
2	C		1	xlt	PL 14x175	1 536			
2	D		1	xlv	PL 6x75	0 304			

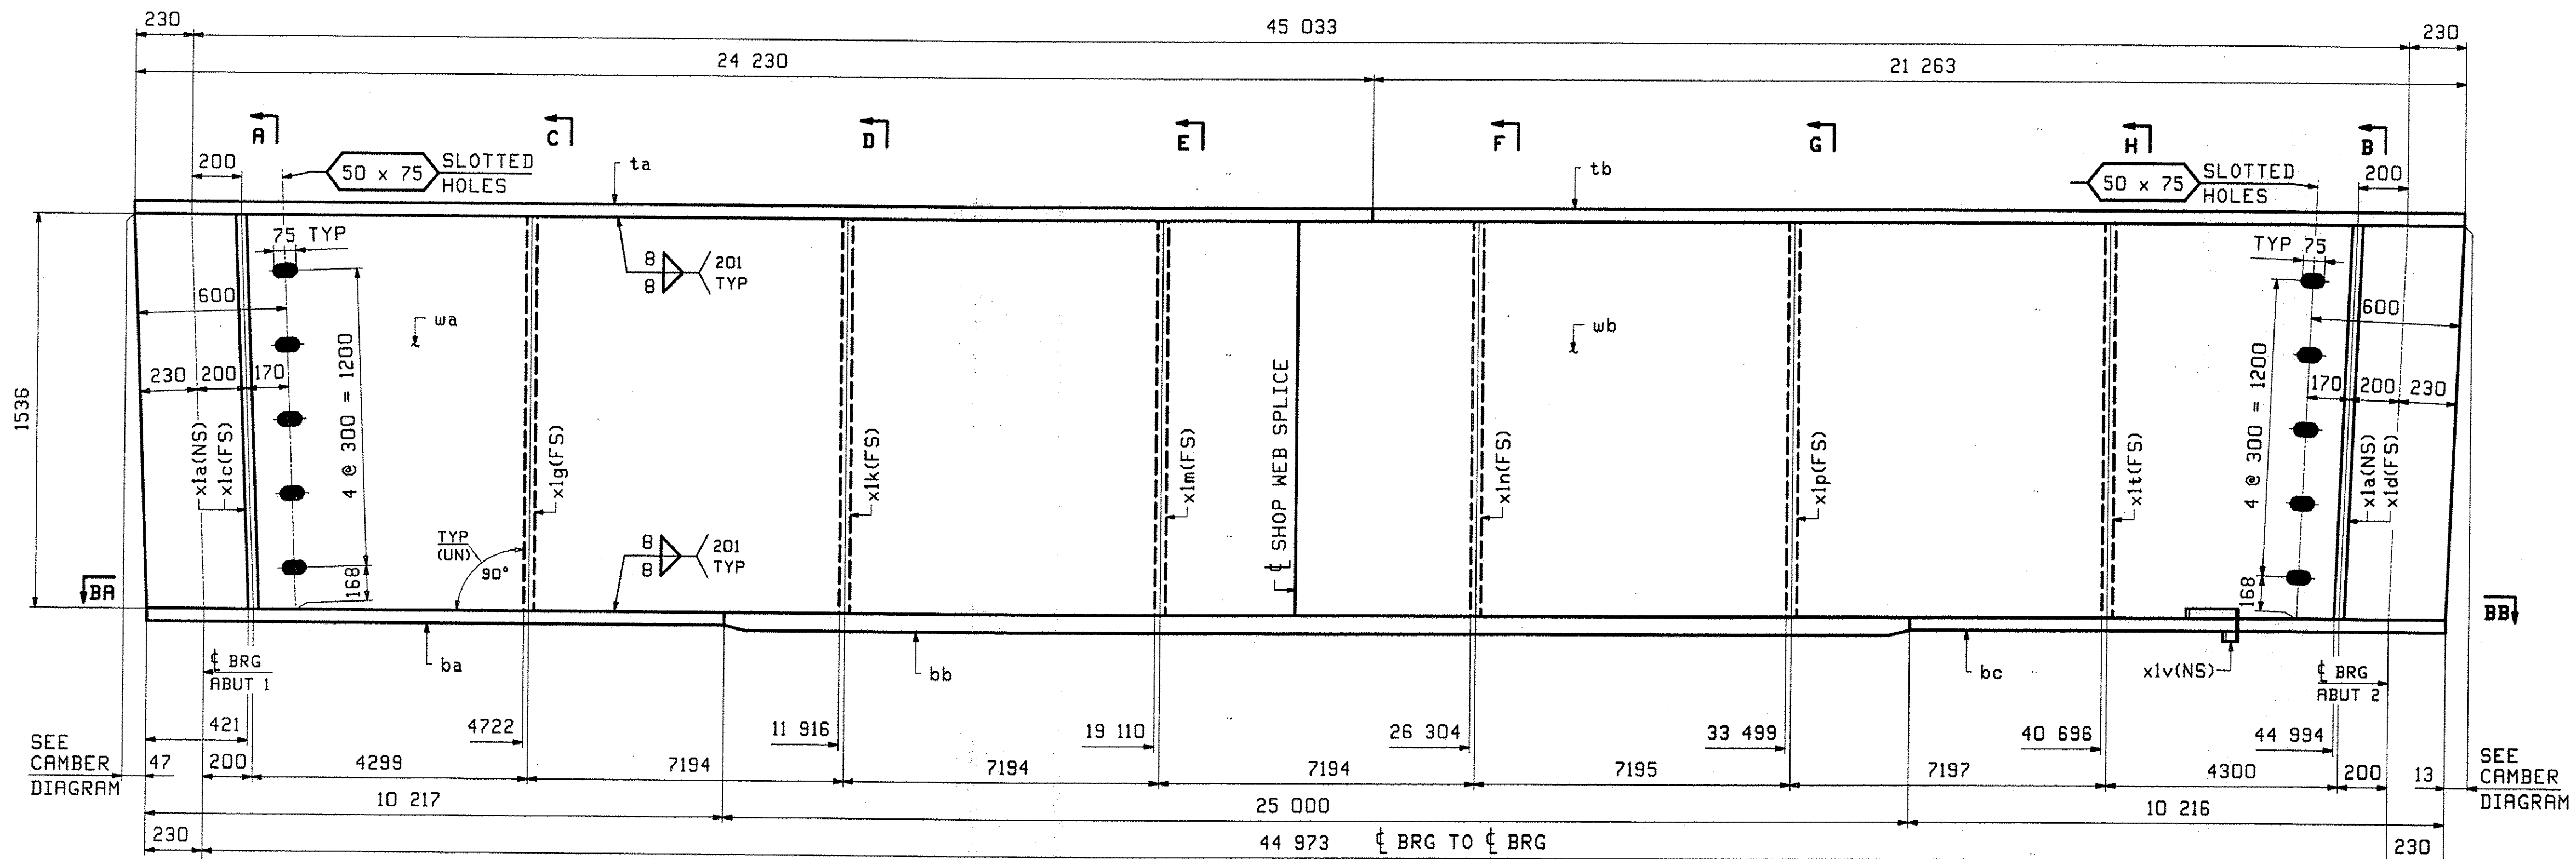


ONE - GIRDER - 5G5


FOR GIRDER STANDARDS SEE DRAWING X1.
FOR CAMBER & FLANGE DIAGRAMS SEE DRAWING C1.
FOR GENERAL NOTES SEE DRAWING GNI.
"T2" DENOTES MATERIAL SUBJECT TO CHARPY V-NOTCH TESTING.

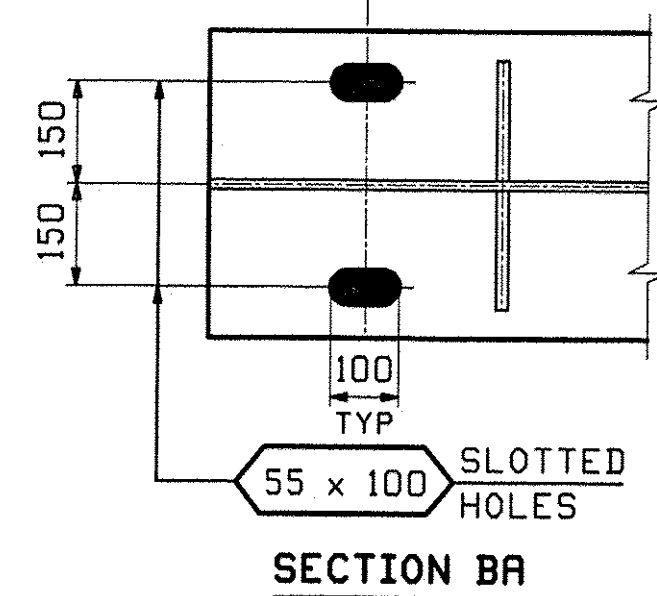


SECTION BA

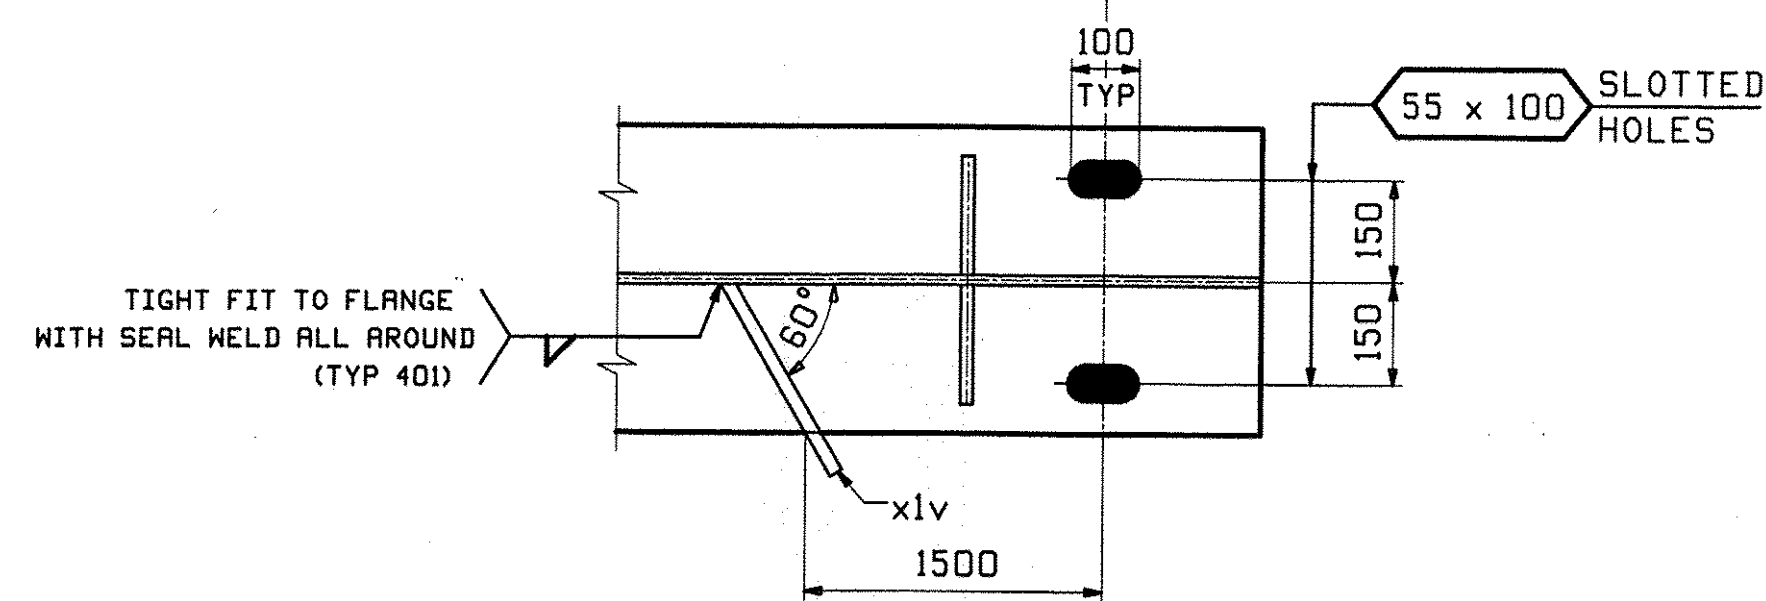


SECTION BB

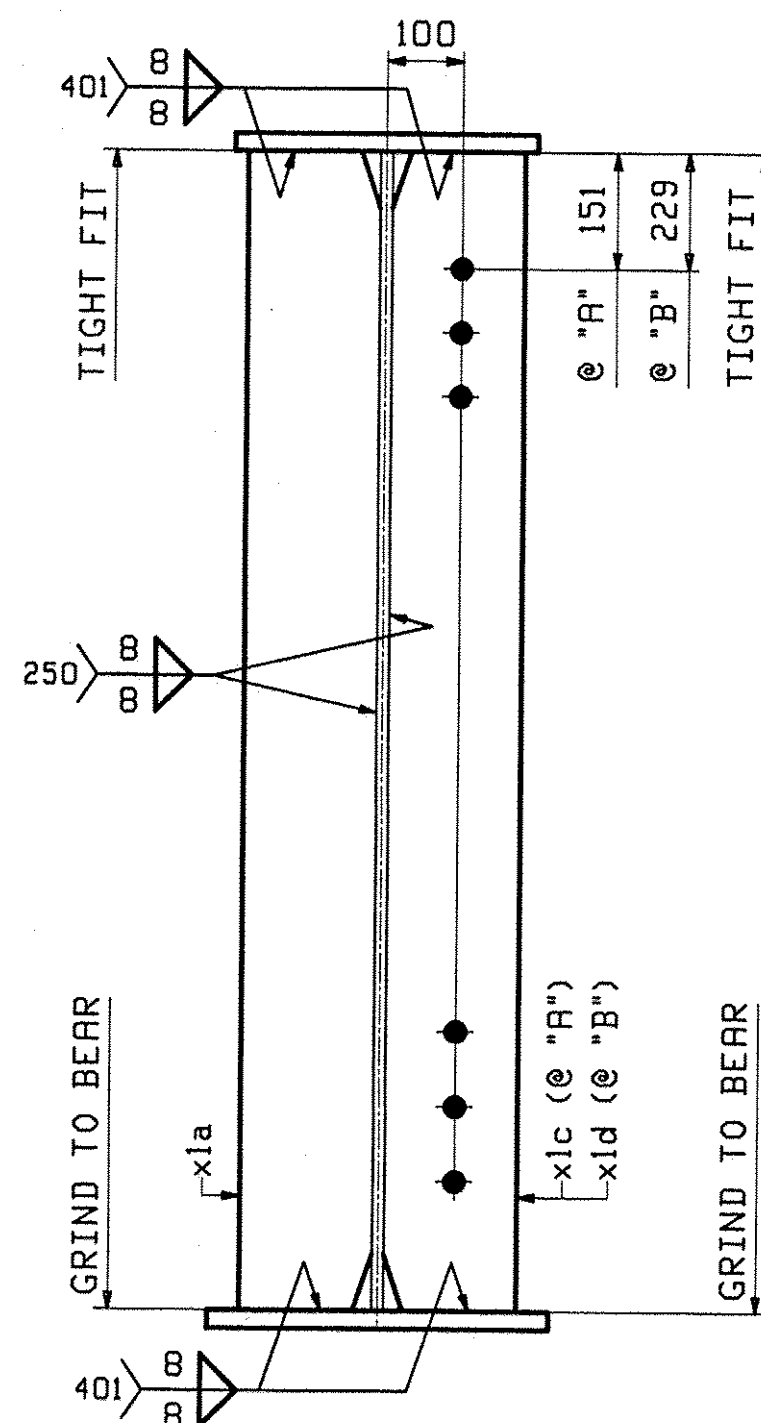

SECTIONS A & B

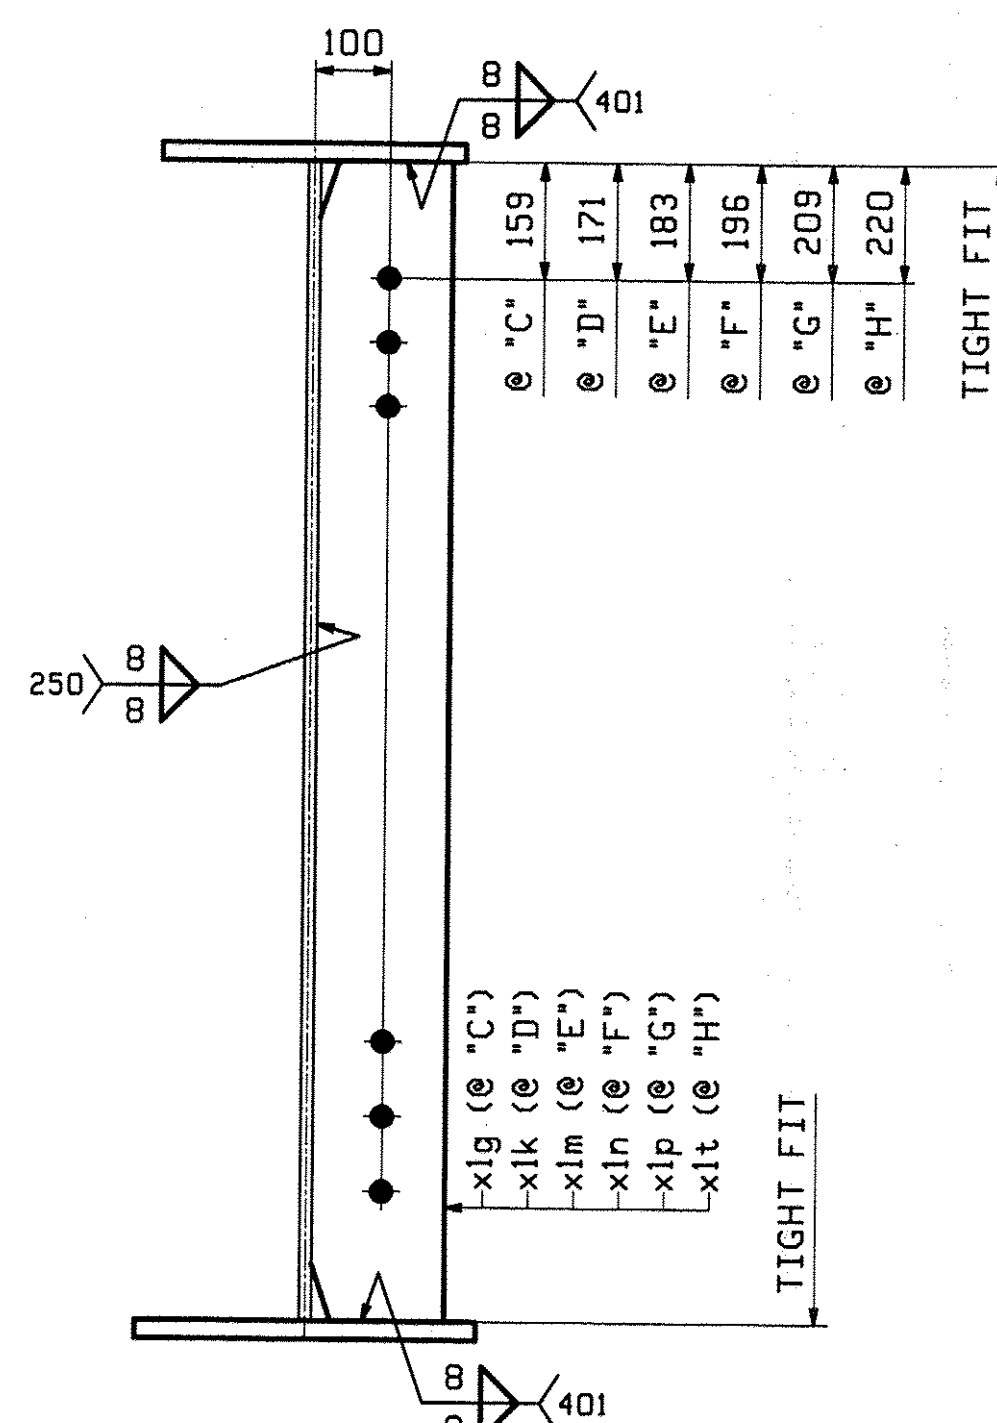

SECTIONS C THRU H

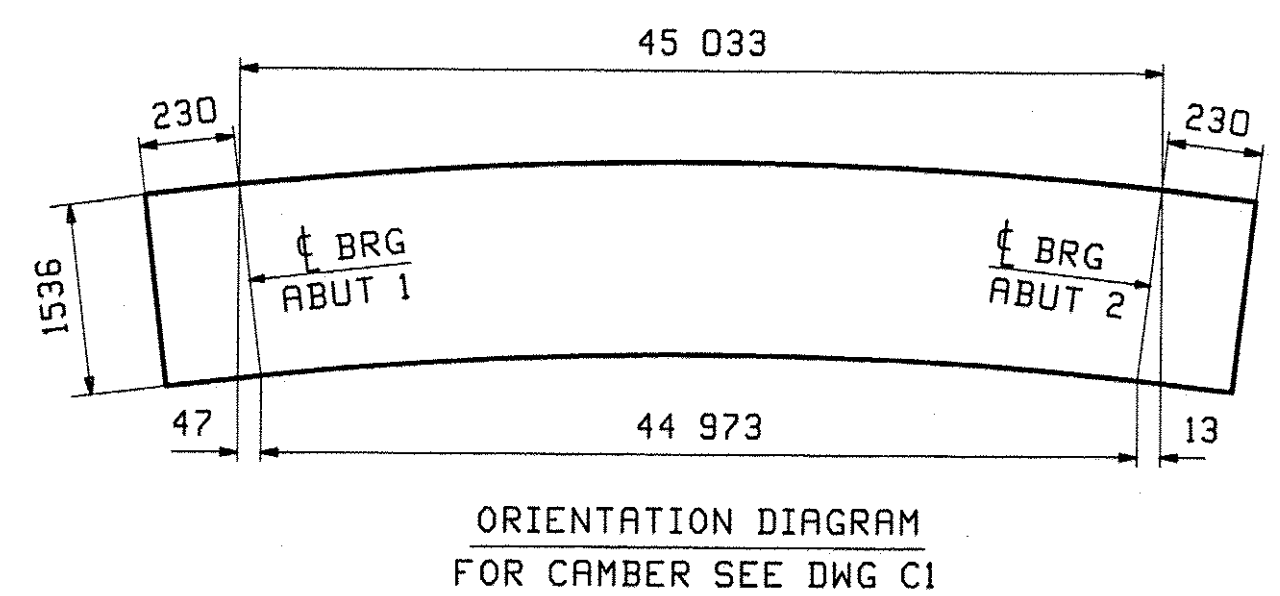

ORIENTATION DIAGRAM
FOR CAMBER SEE DWG C1

0								6/18/10	
REV.	DATE	REMARKS			DWN	CHK	APVL	SHOP	
MATERIAL:		SURFACE PREP. & PAINT:			HOLES:		SHOP BOLTS:		
M270M-345W(UN)		SEE DWG GNI			15 16" Ø		NONE		
DESCRIPTION: GIRDER - 5G5									
CASCO BAY STEEL STRUCTURES, INC.									
75 SPRING HILL ROAD					SACO, MAINE 04072				
PHONE (207) 282-7360					FAX. (207) 282-1179				
									
STRUCTURE: VT Route 125 over Lemon Fair River						DRAWN:		DATE:	
Bridge No. 9						JTB		06/01	
Cornwall						CHKD:		DATE:	
County of Addison						PCP		06/16	
LOCATION: CORNWALL, VERMONT						JOB NO.		DWG NO.	
PROJ NO. BRS 0172(G)						457		5	
CUSTOMER: VT AOT								REV. 	

RECEIVED
JUN 23 2010
RESUBMIT APPROVED
BY DATE 7/20/10