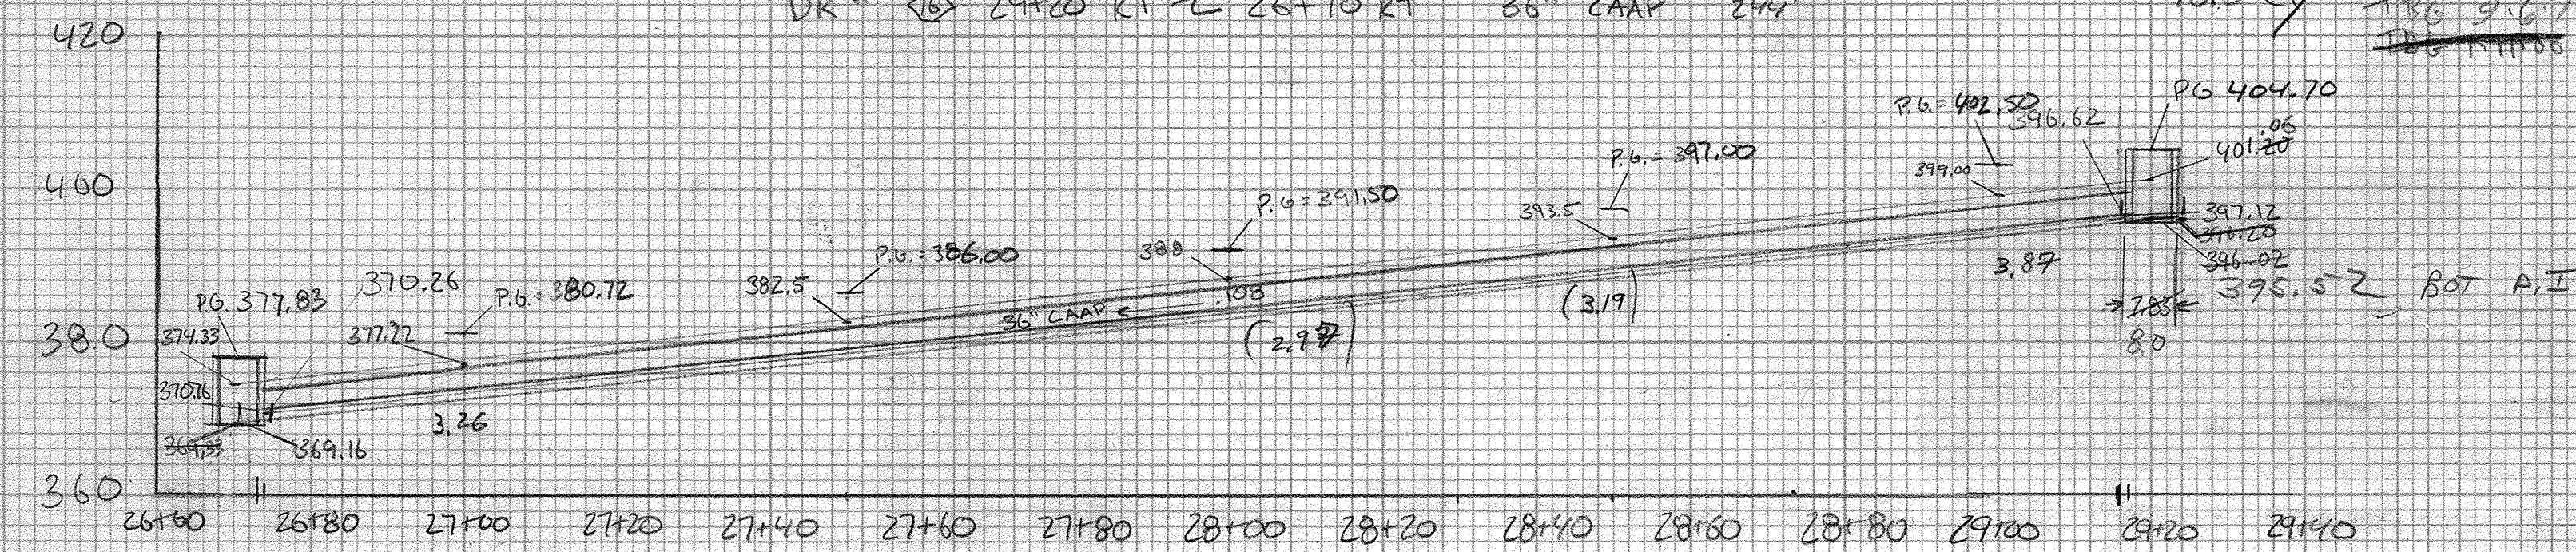
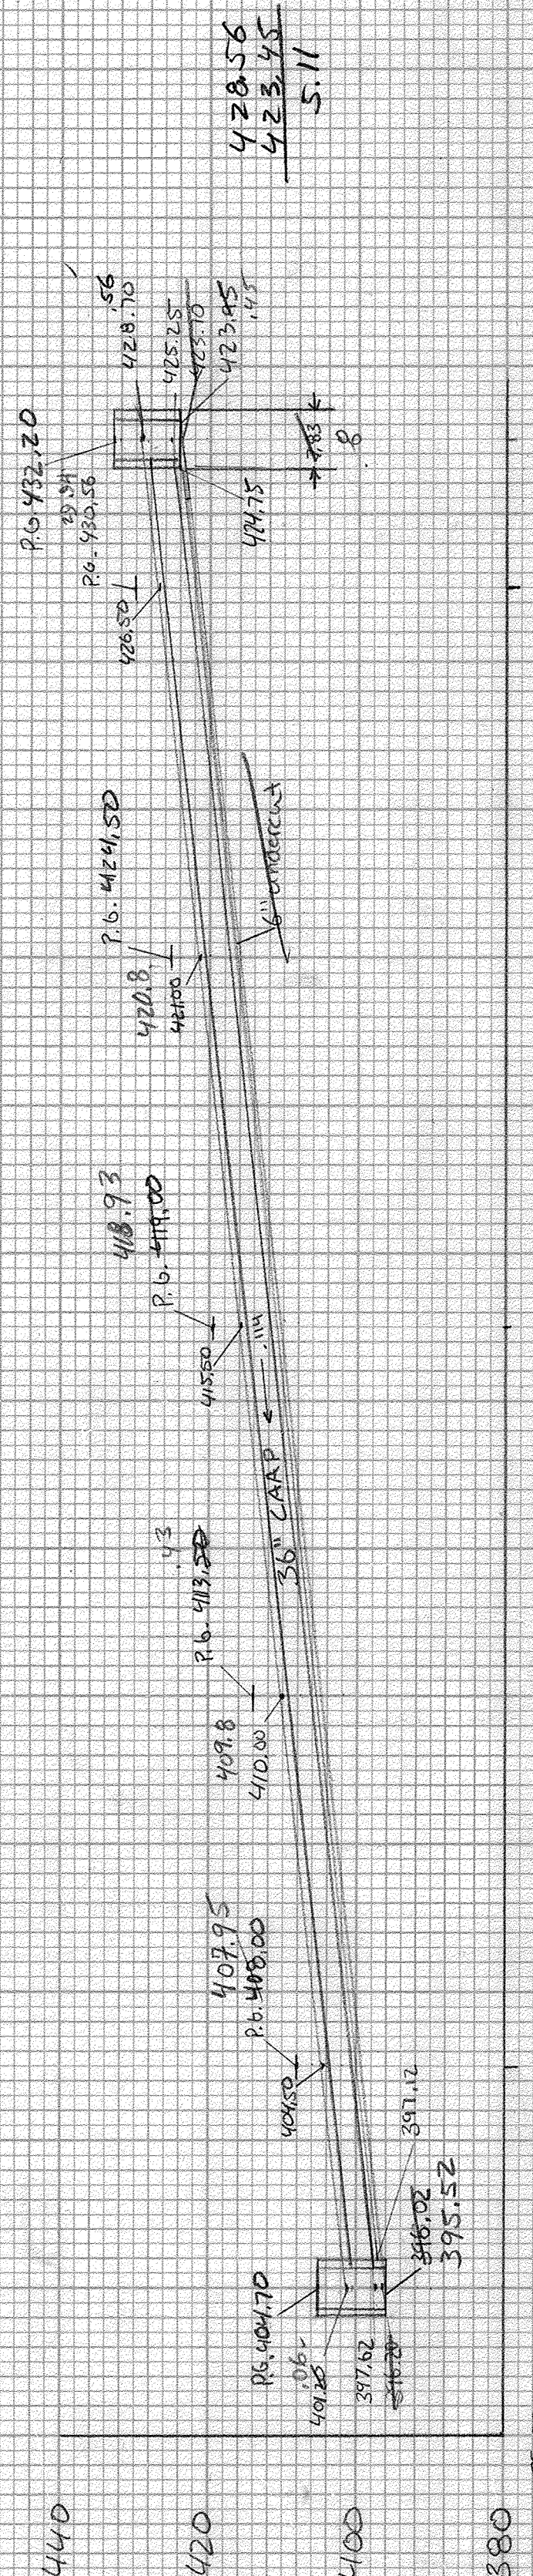


$$DR \# \begin{array}{|c|} \hline 20 \\ \hline \end{array} \quad 31+70 RT \sim 29+70 RT$$


T.E 2010/04 10/10

[illegible]