

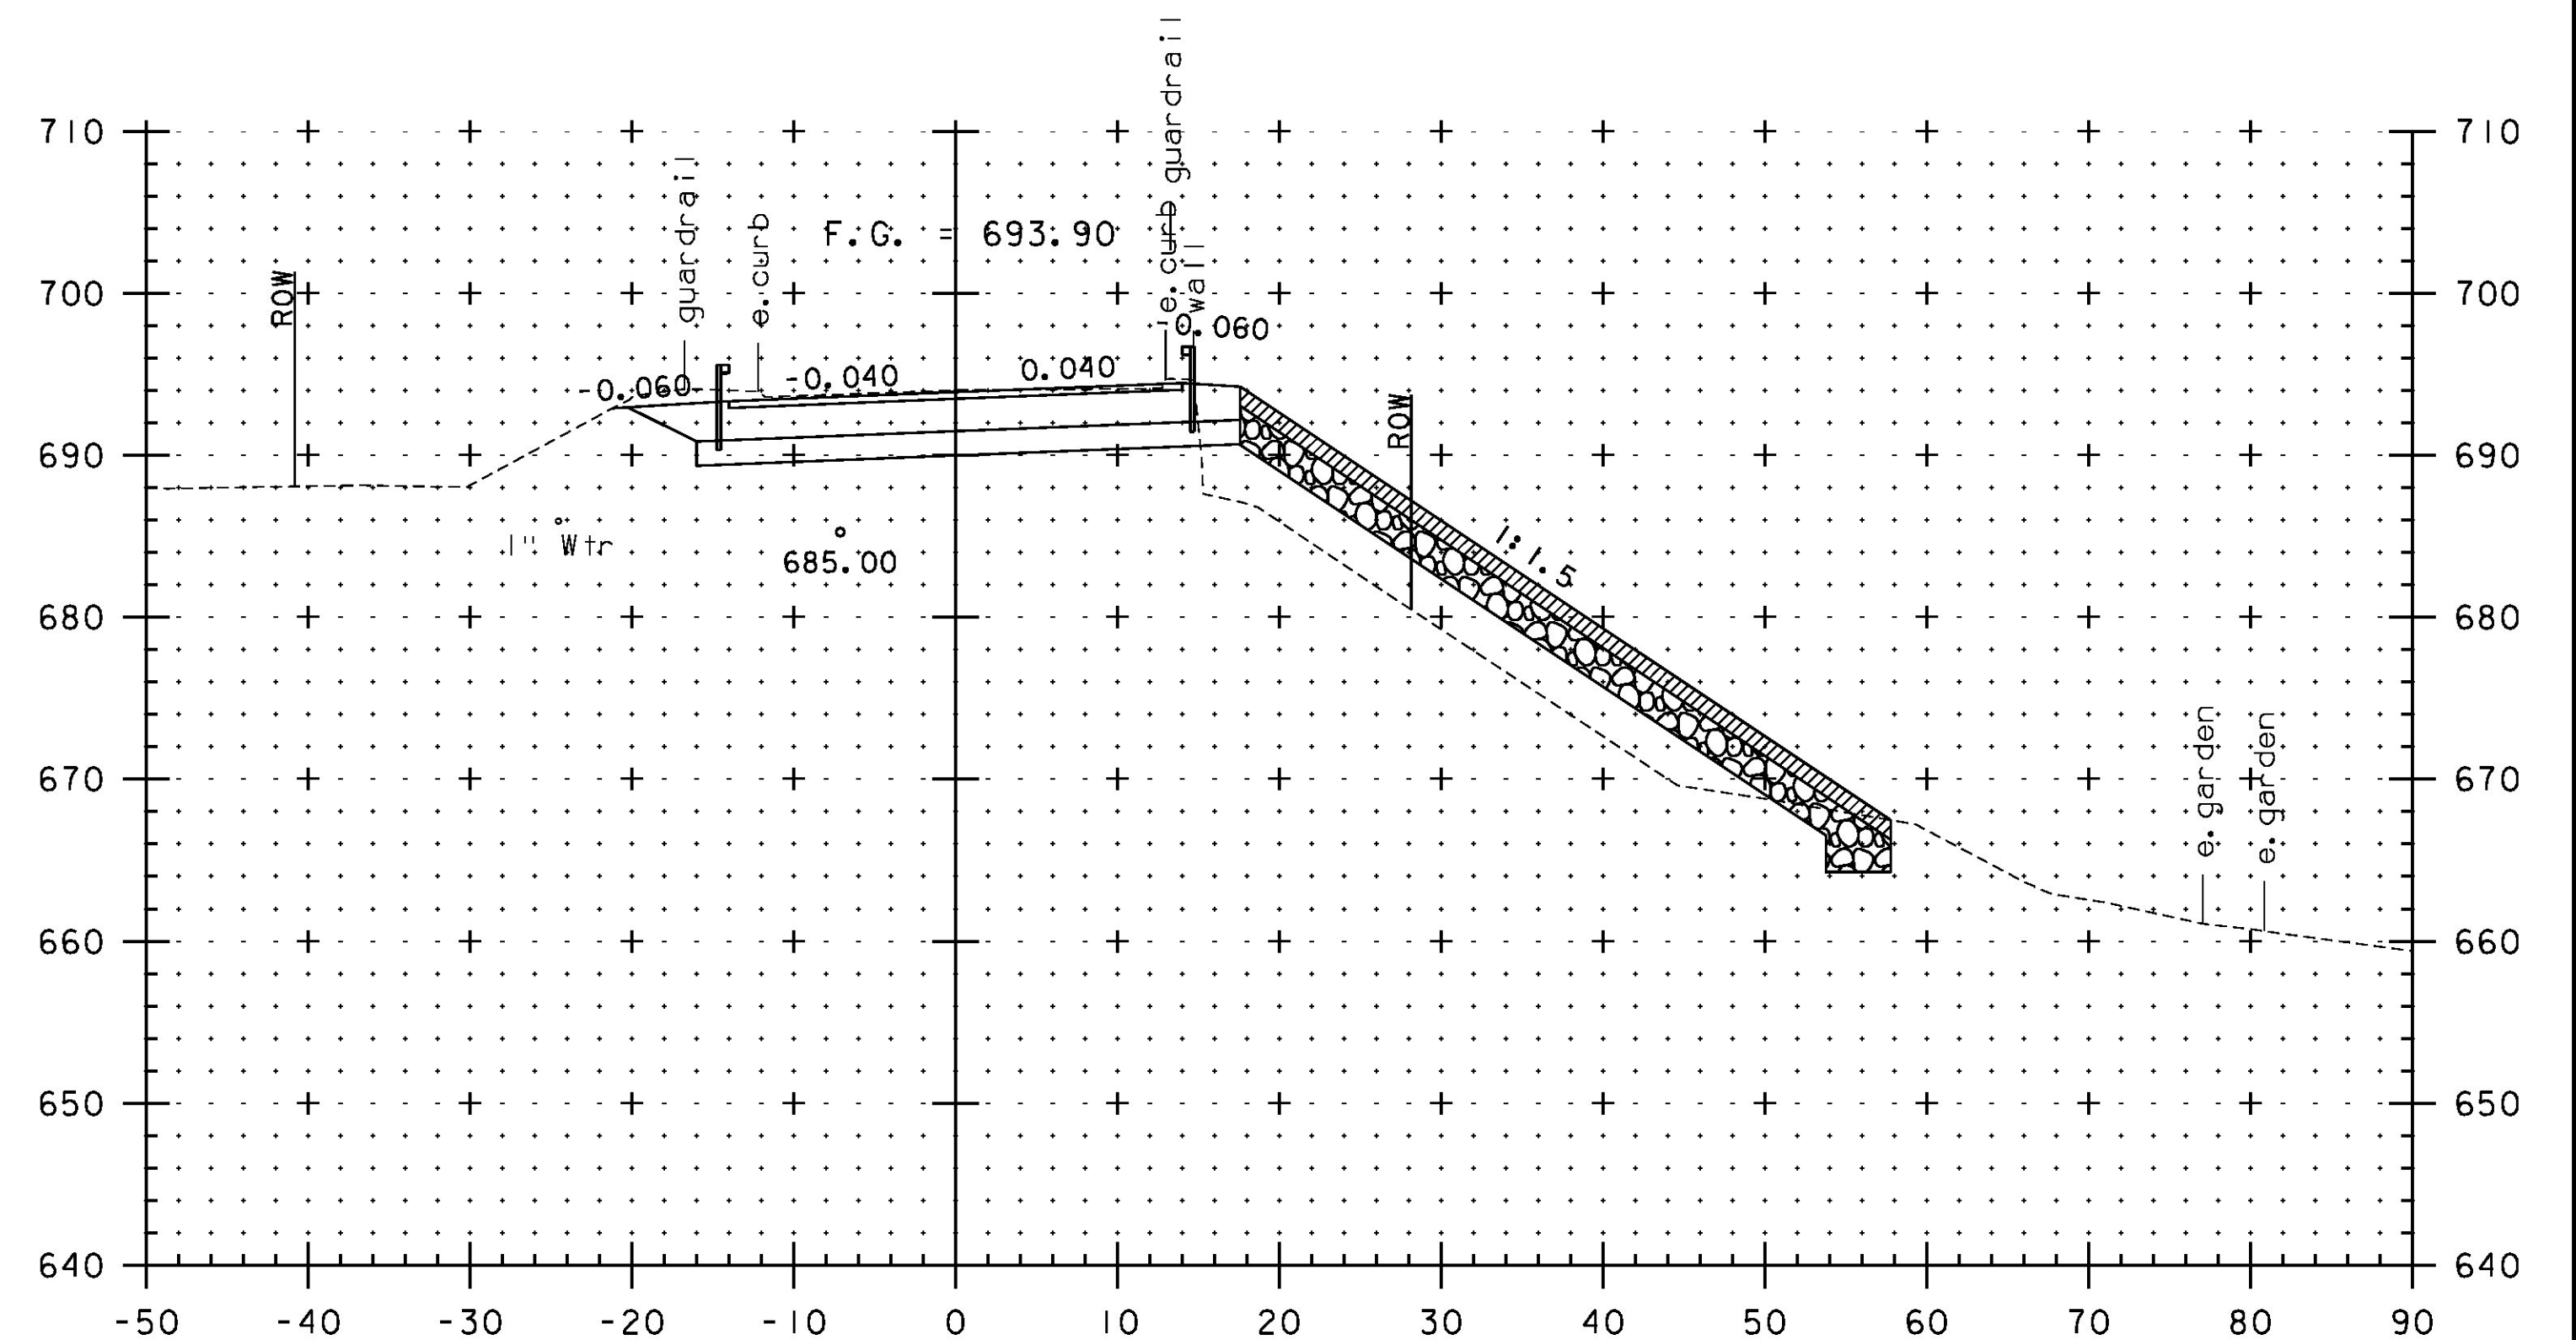
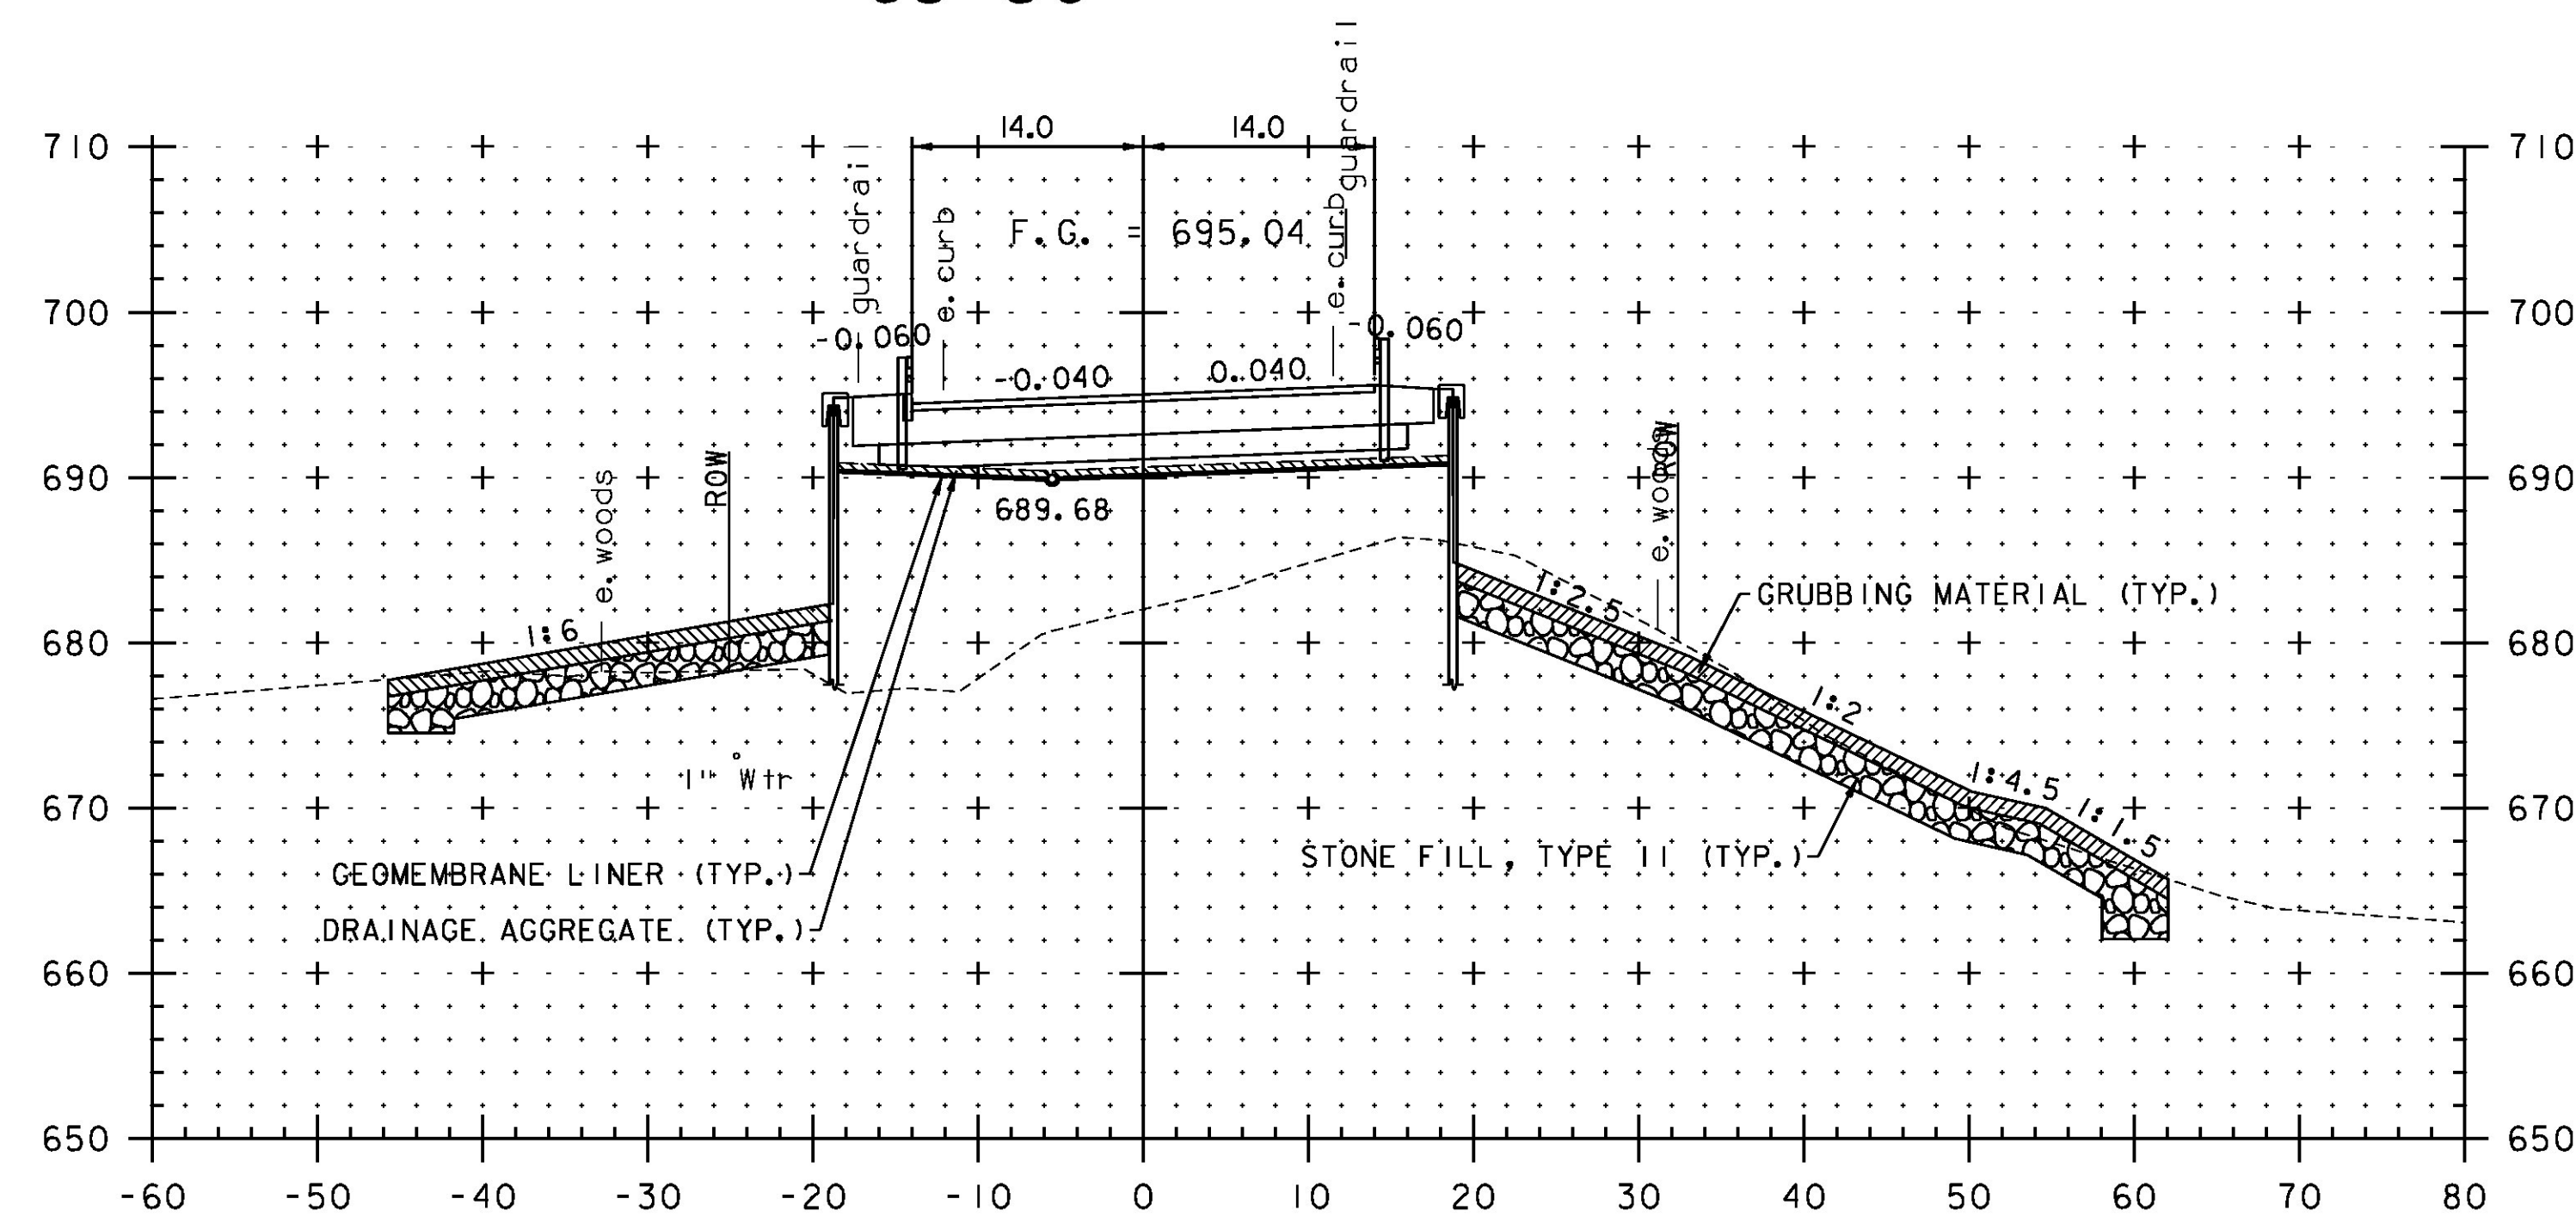



CLD 14-016 MODEL: MAINLINE.XS04

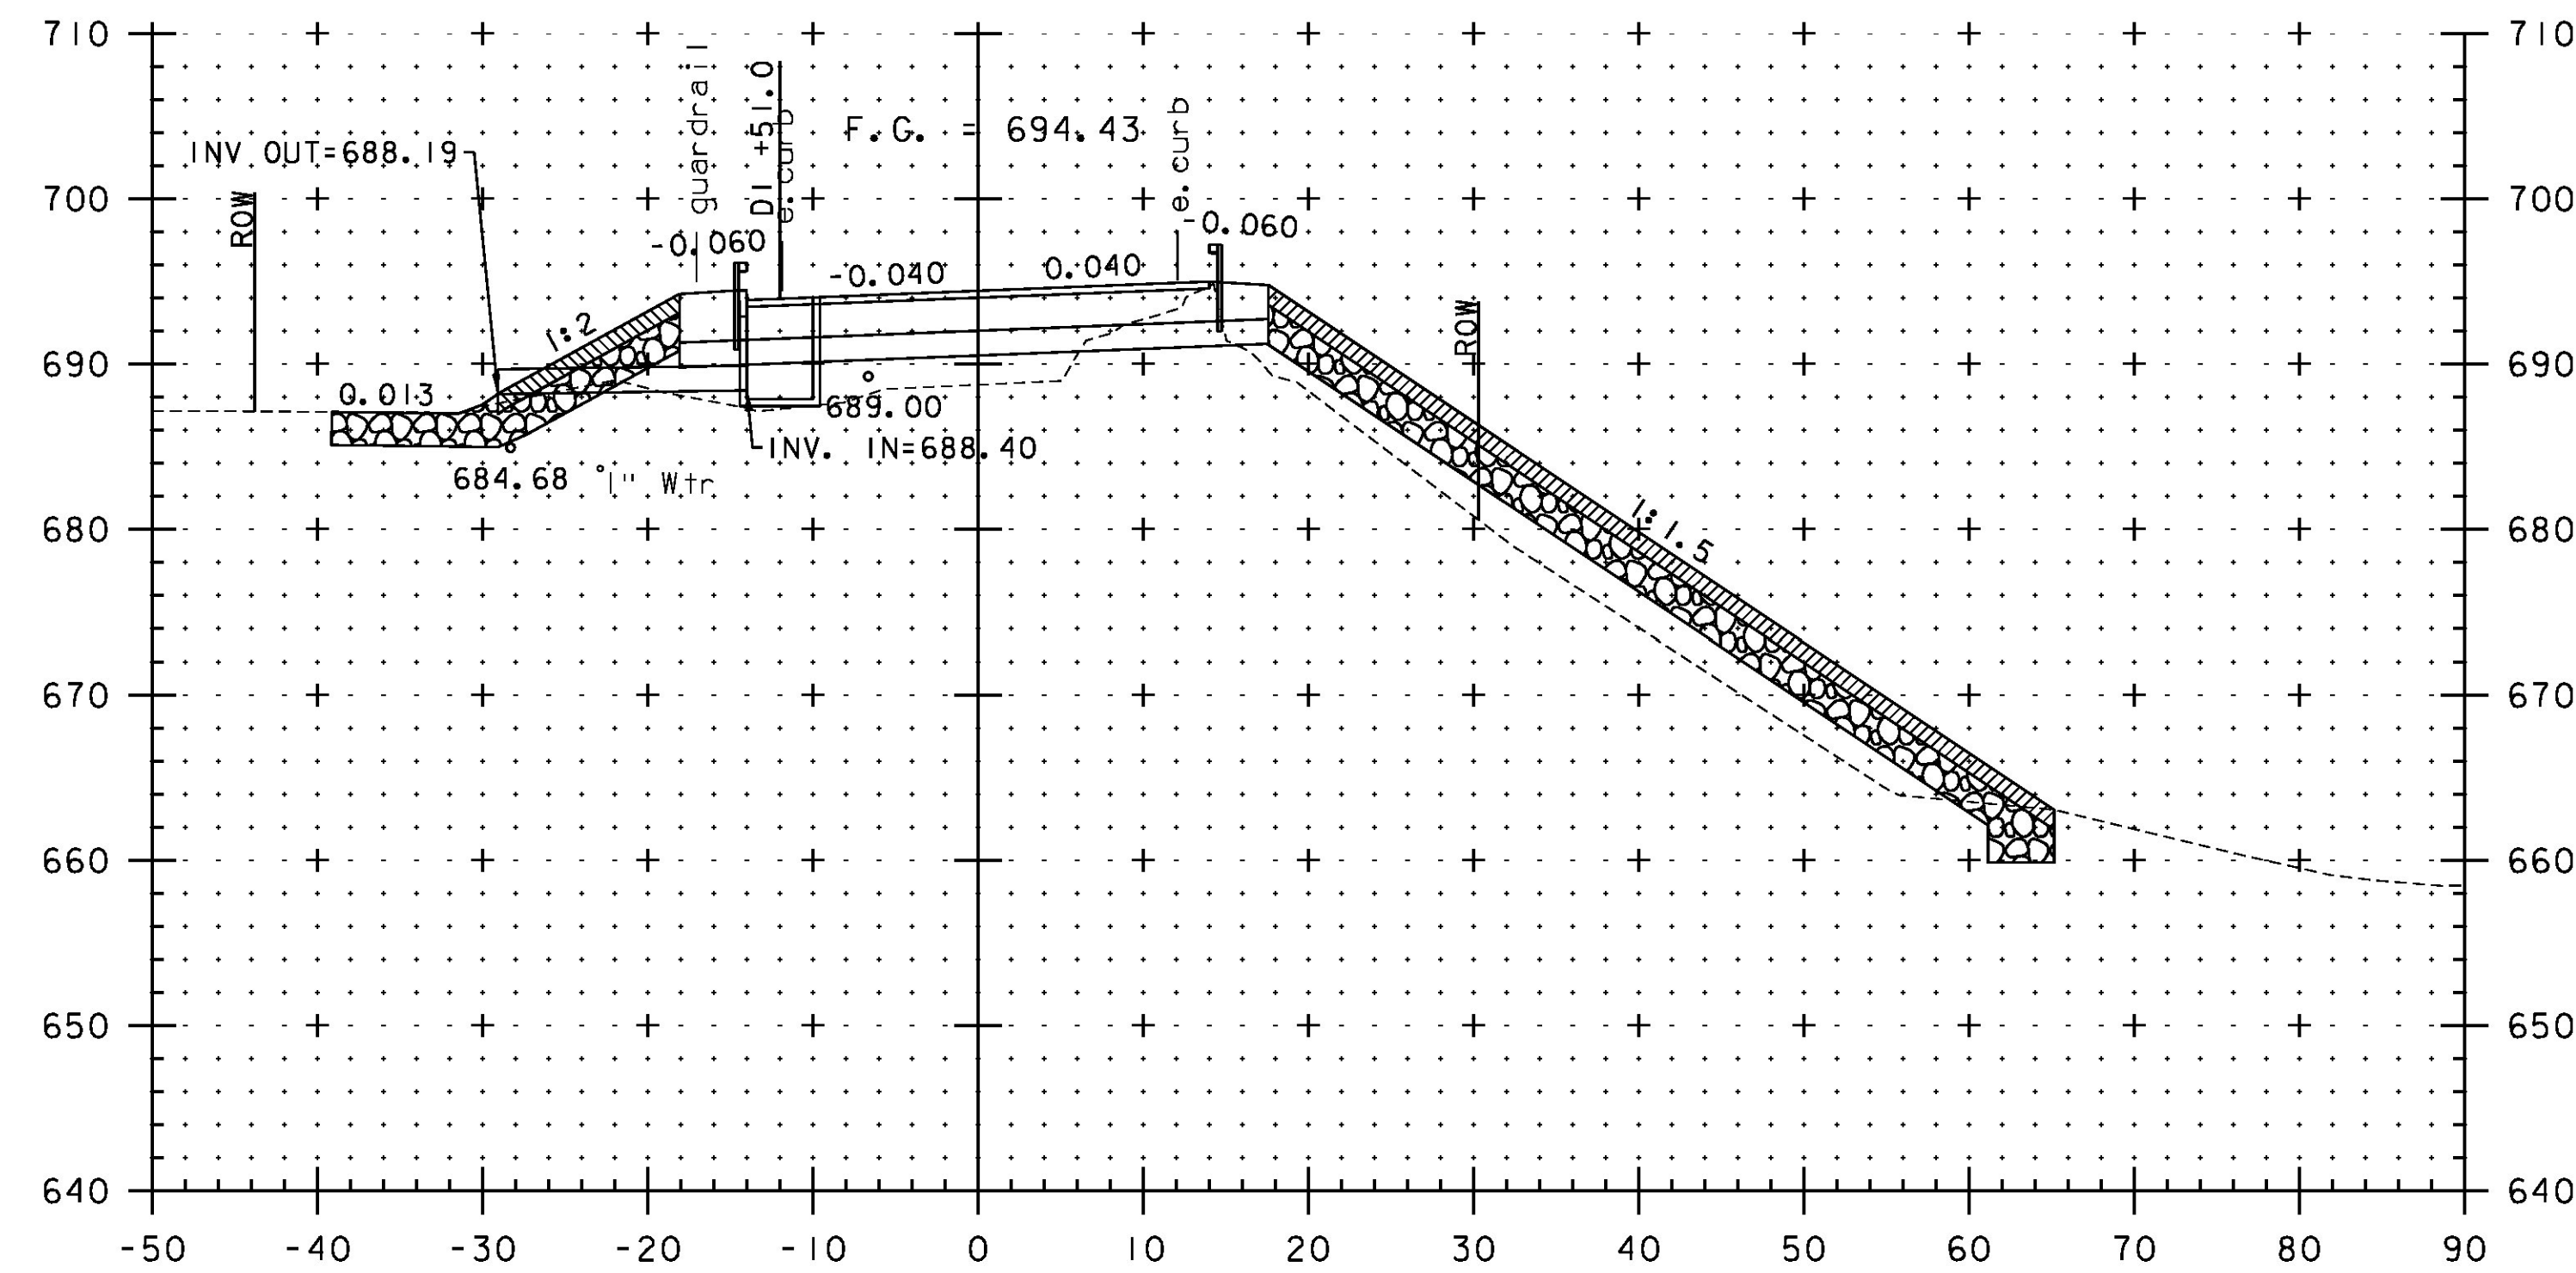

END PROJECT

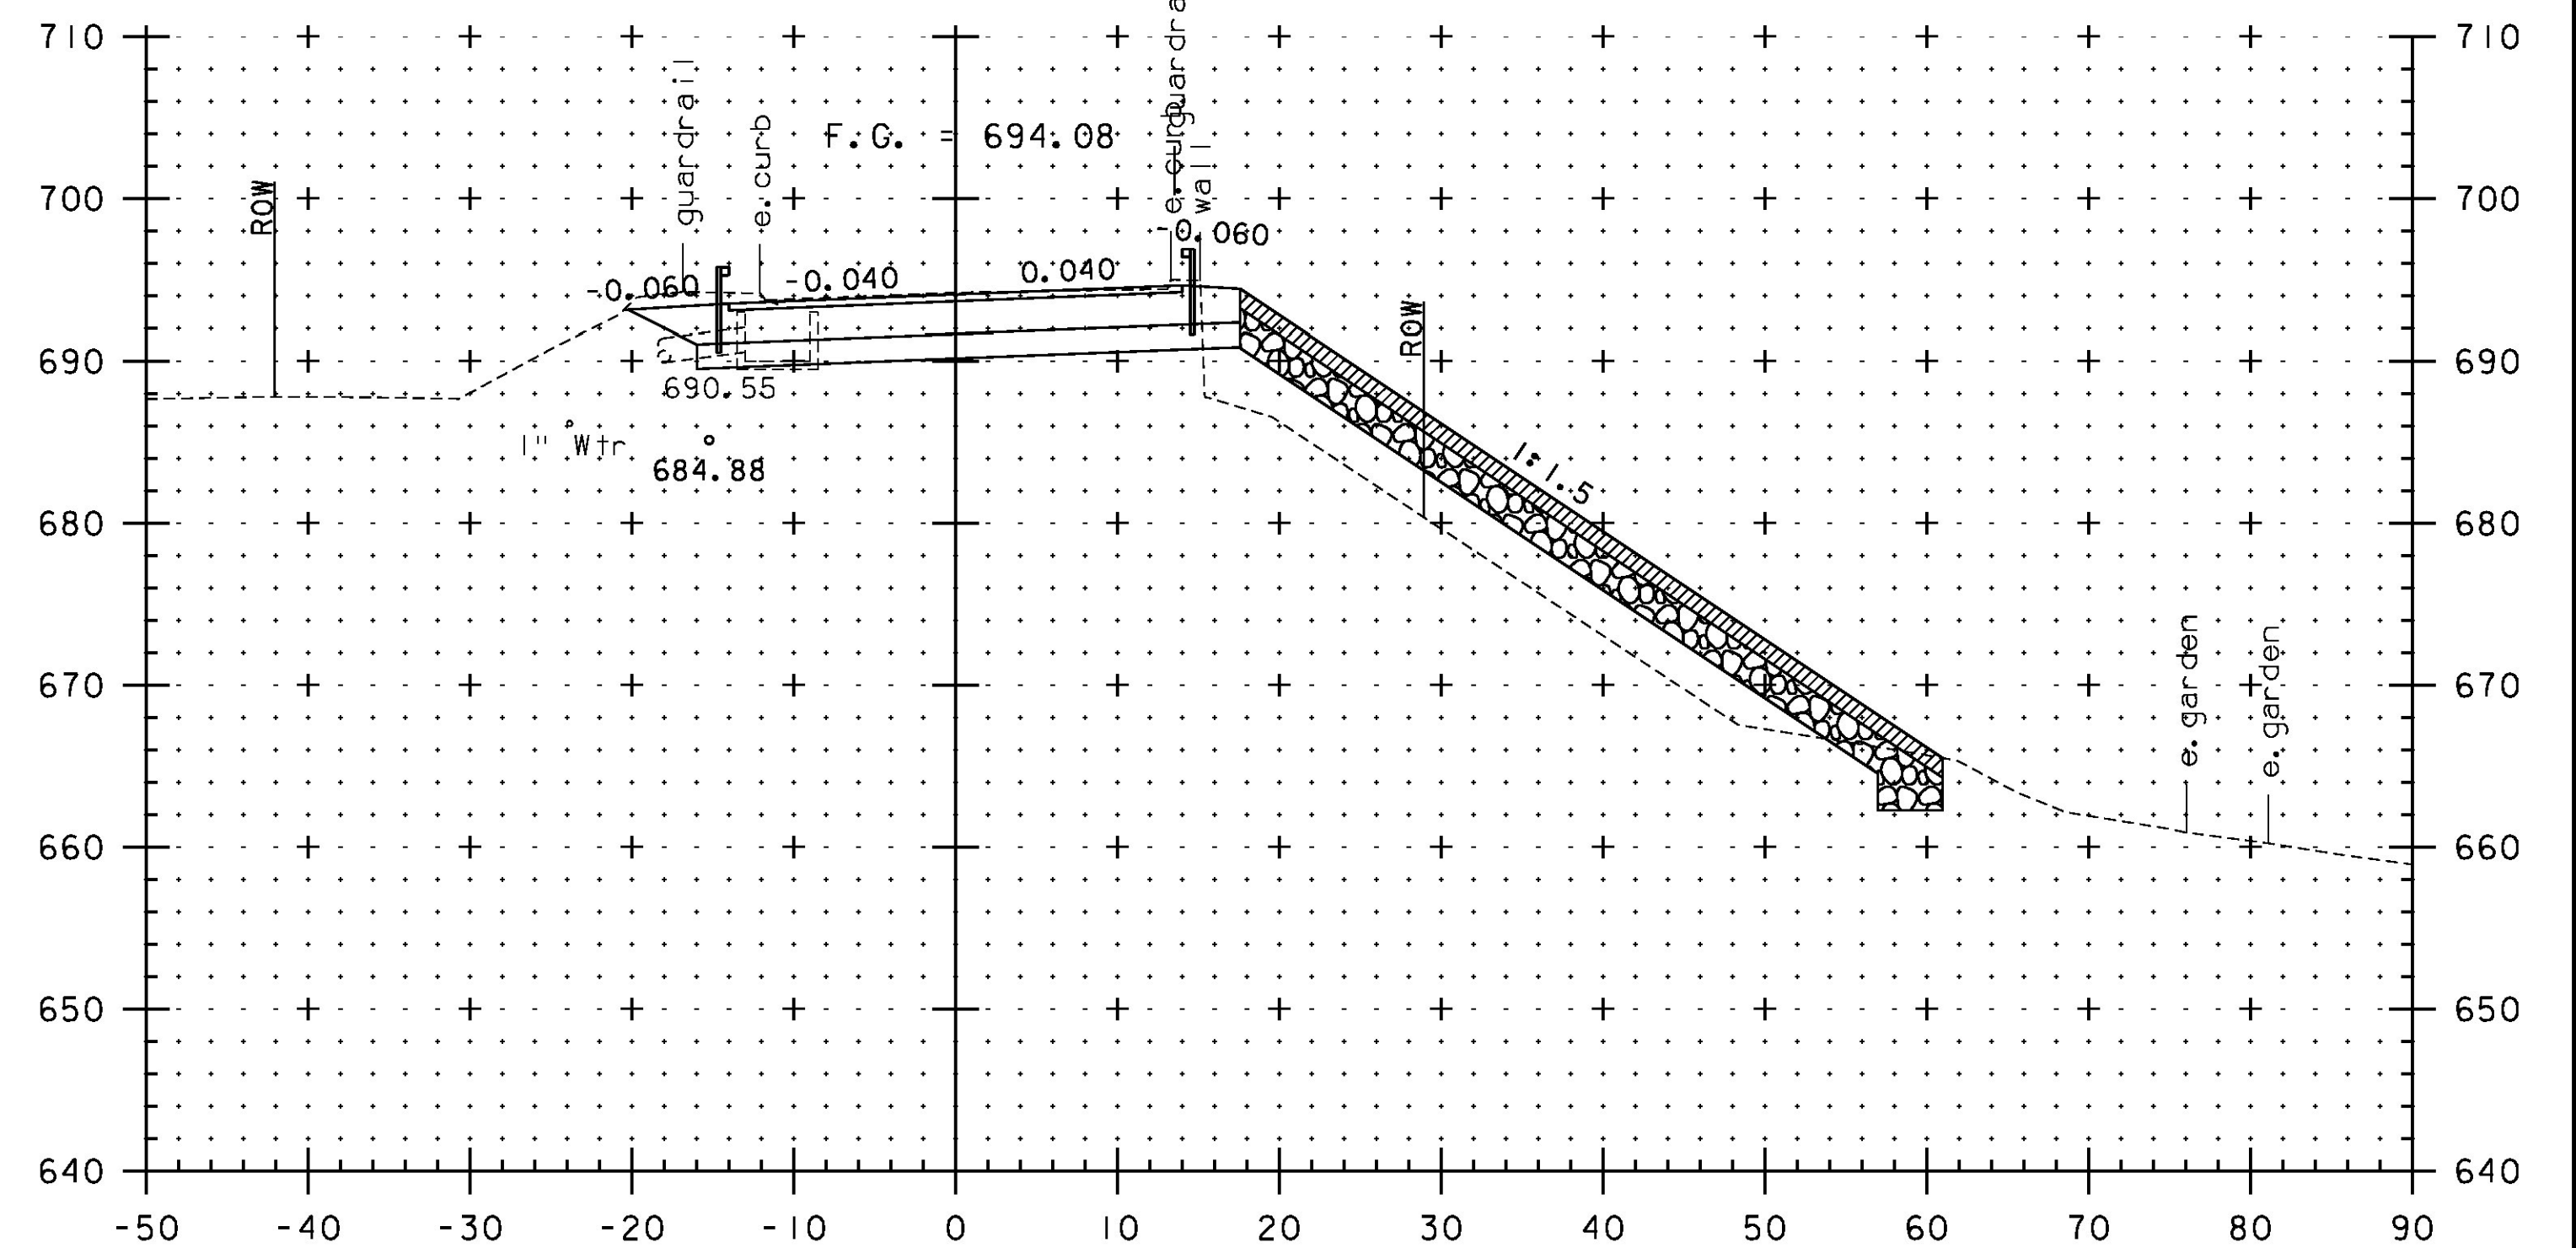

STA. 63+25 TO STA. 63+75

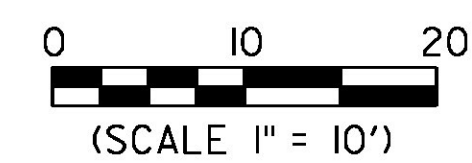

PROJECT NAME:	ST. JOHNSBURY
PROJECT NUMBER:	BF 7000(20)
FILE NAME:	86e048/cos/z86e048xs.dgn
PROJECT LEADER:	J. BYATT
DESIGNED BY:	M. HALEY
VT 2B CROSS SECTIONS	4
PLOT DATE:	10/26/2016
DRAWN BY:	M. HALEY
CHECKED BY:	P. SHEDD
SHEET	56 OF 70