



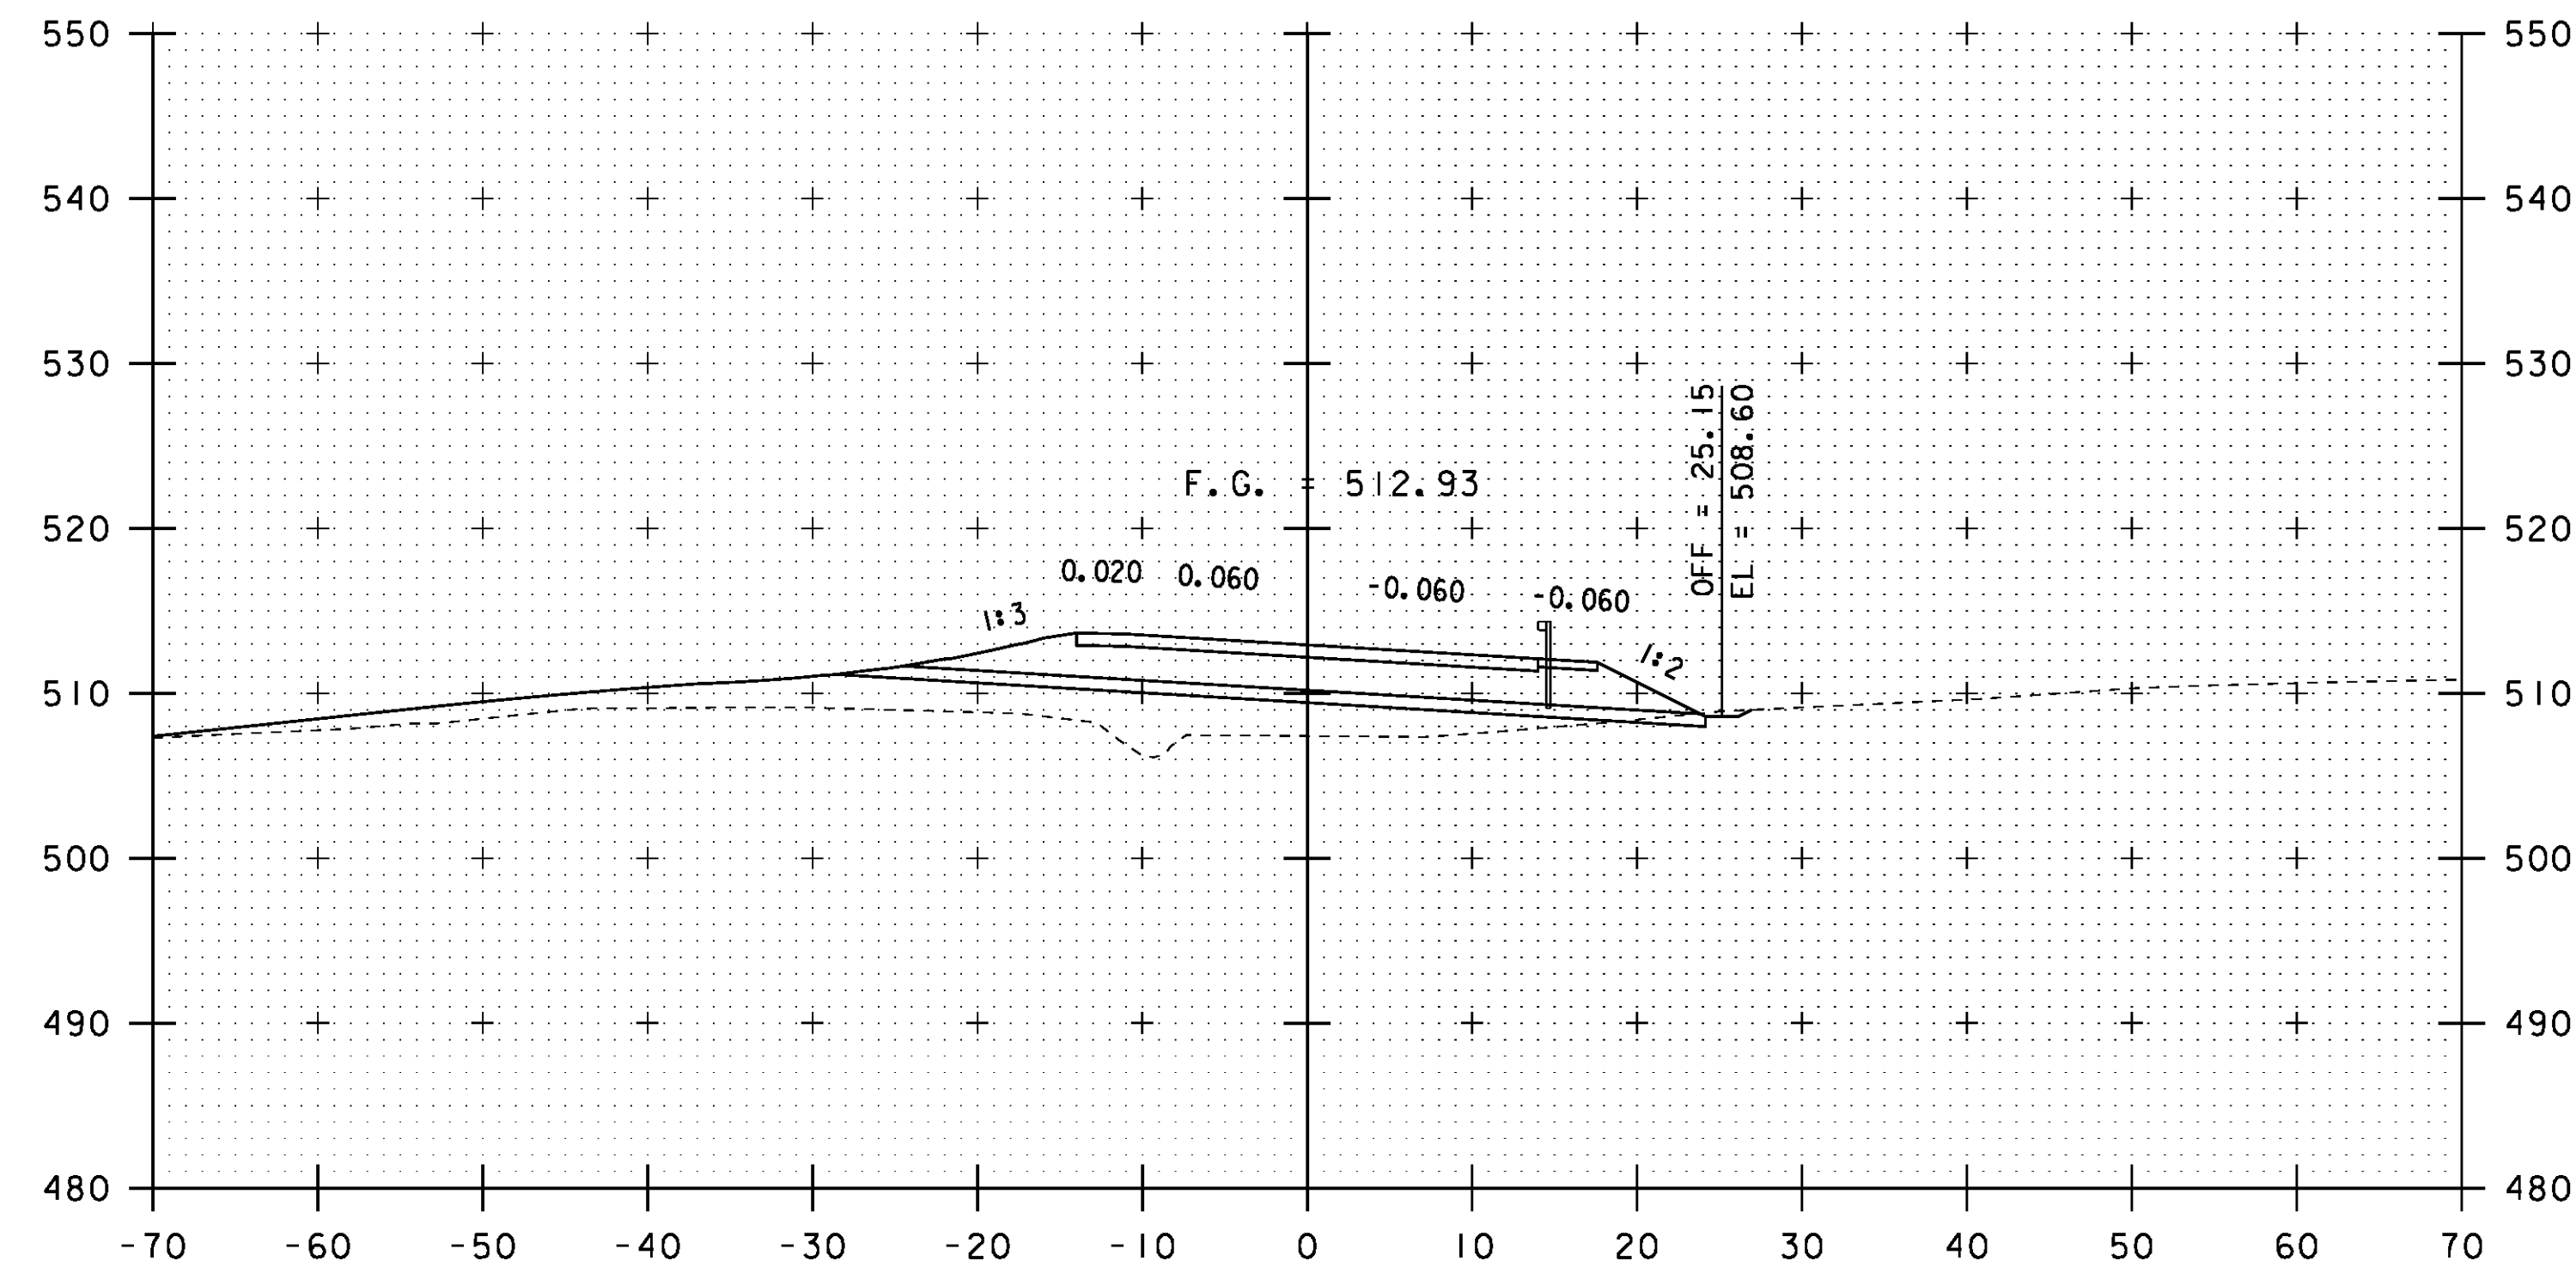


392+50

STA 392+47.3 RT - STA 393+75.0 RT
CONSTRUCT NEW GRASS-LINED DITCH

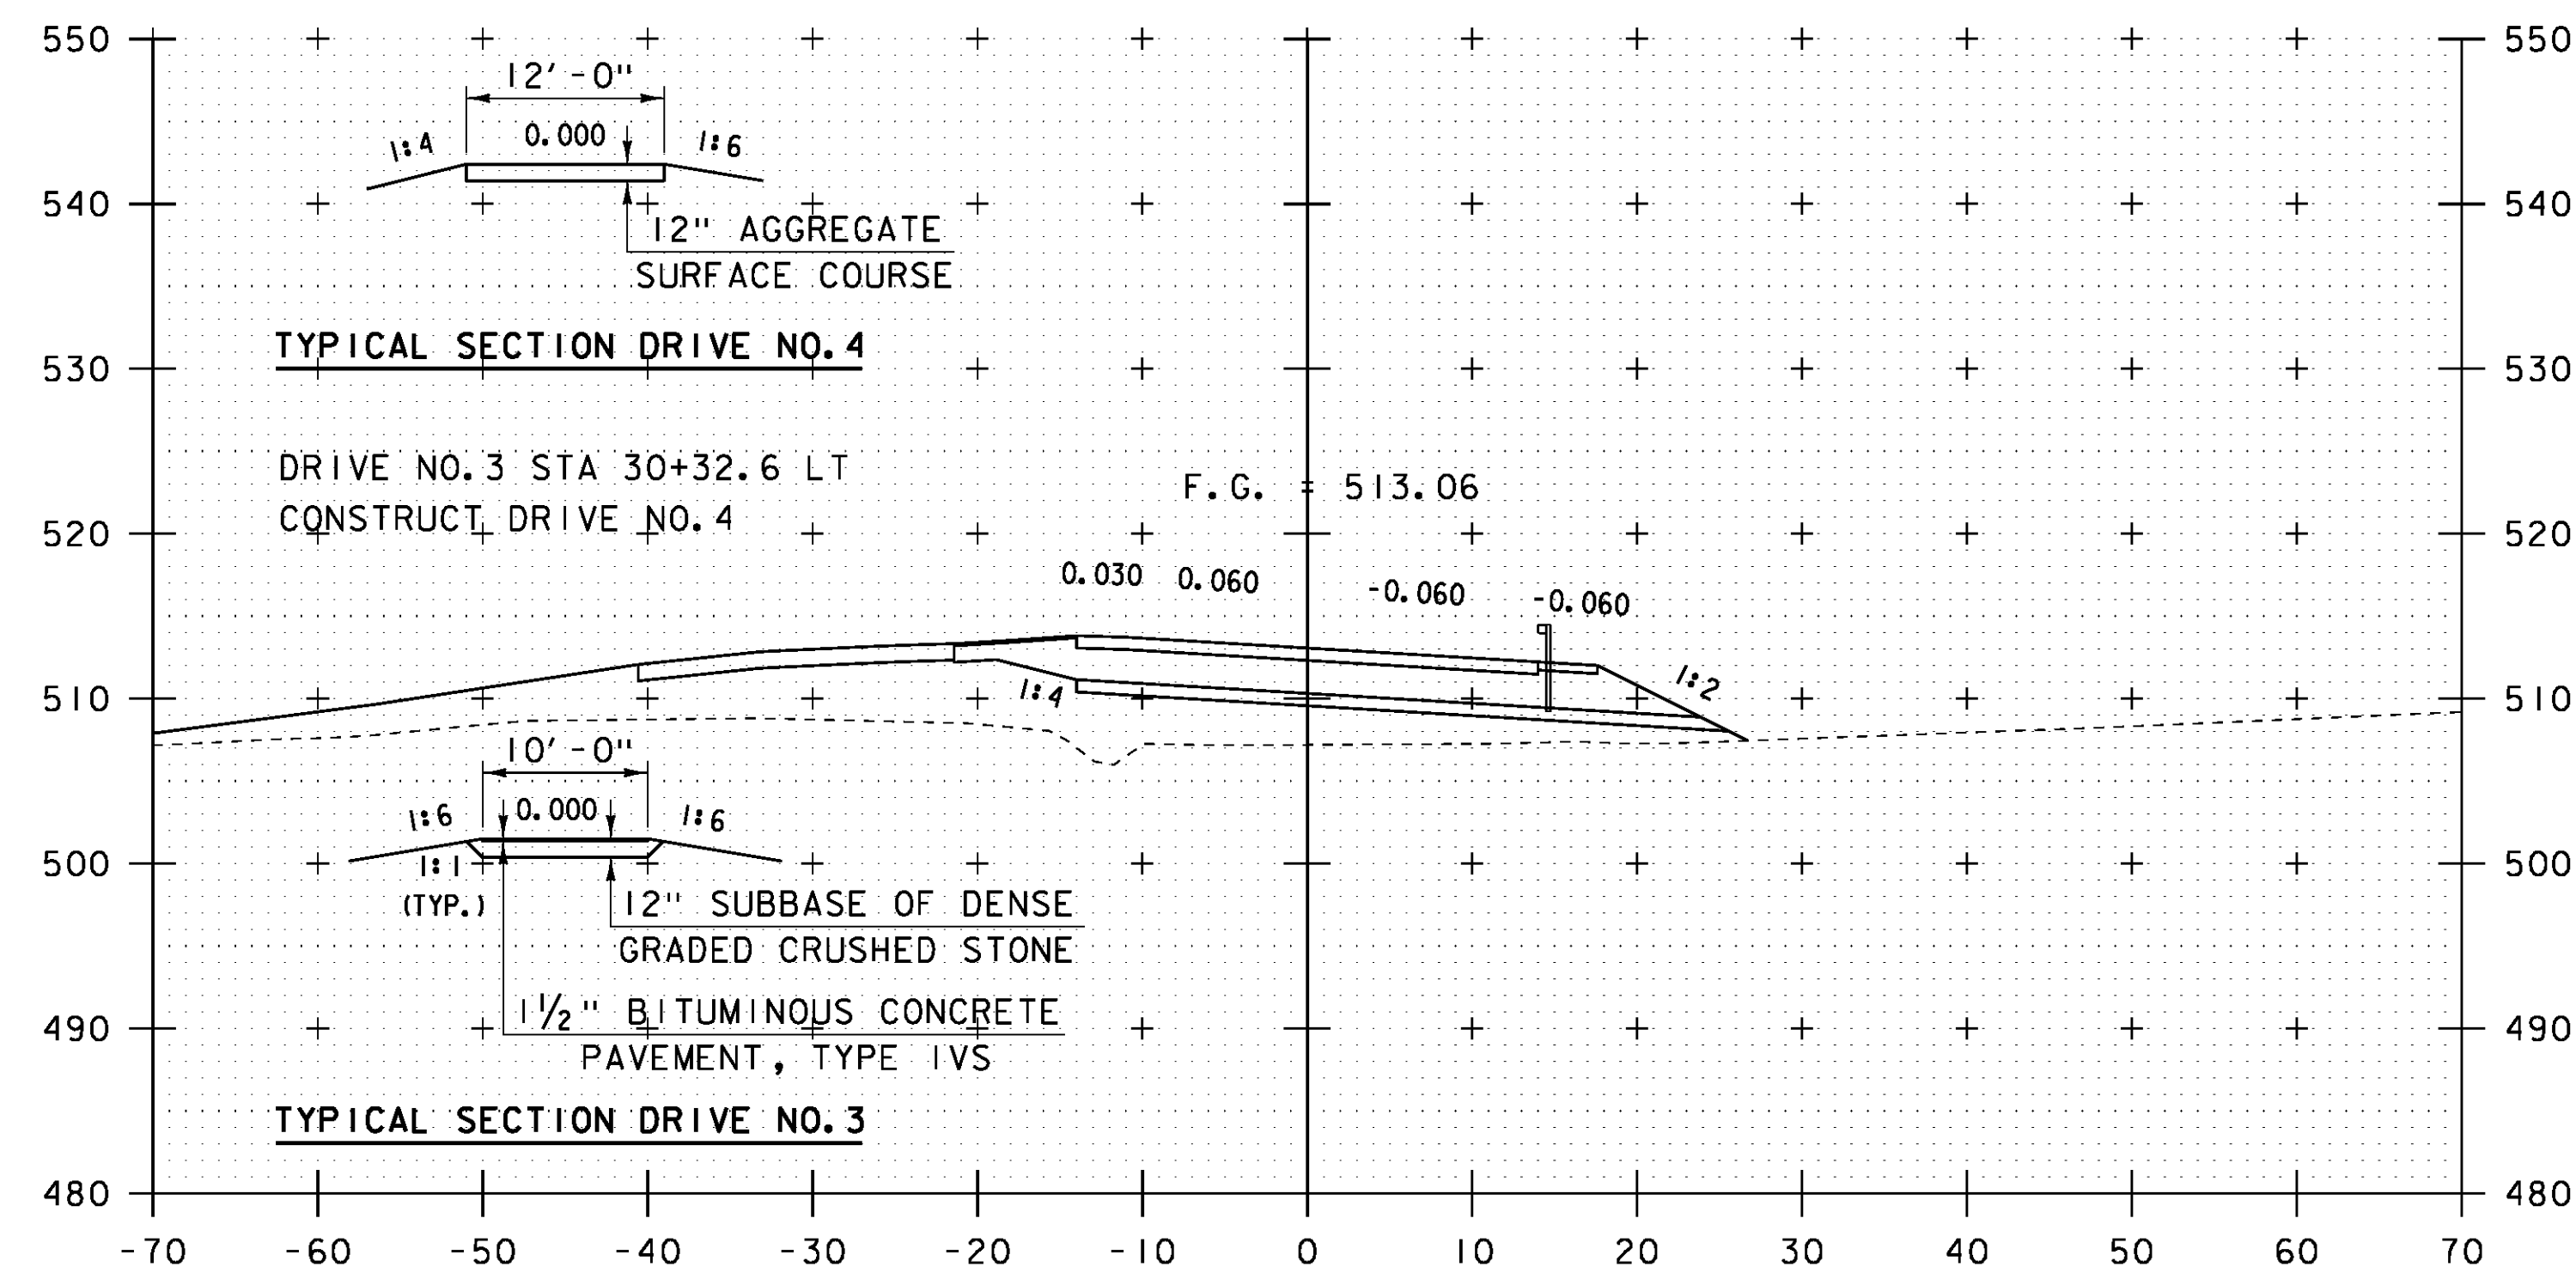


392+25

STA 392+31.5 LT
CONSTRUCT DRIVE NO. 3

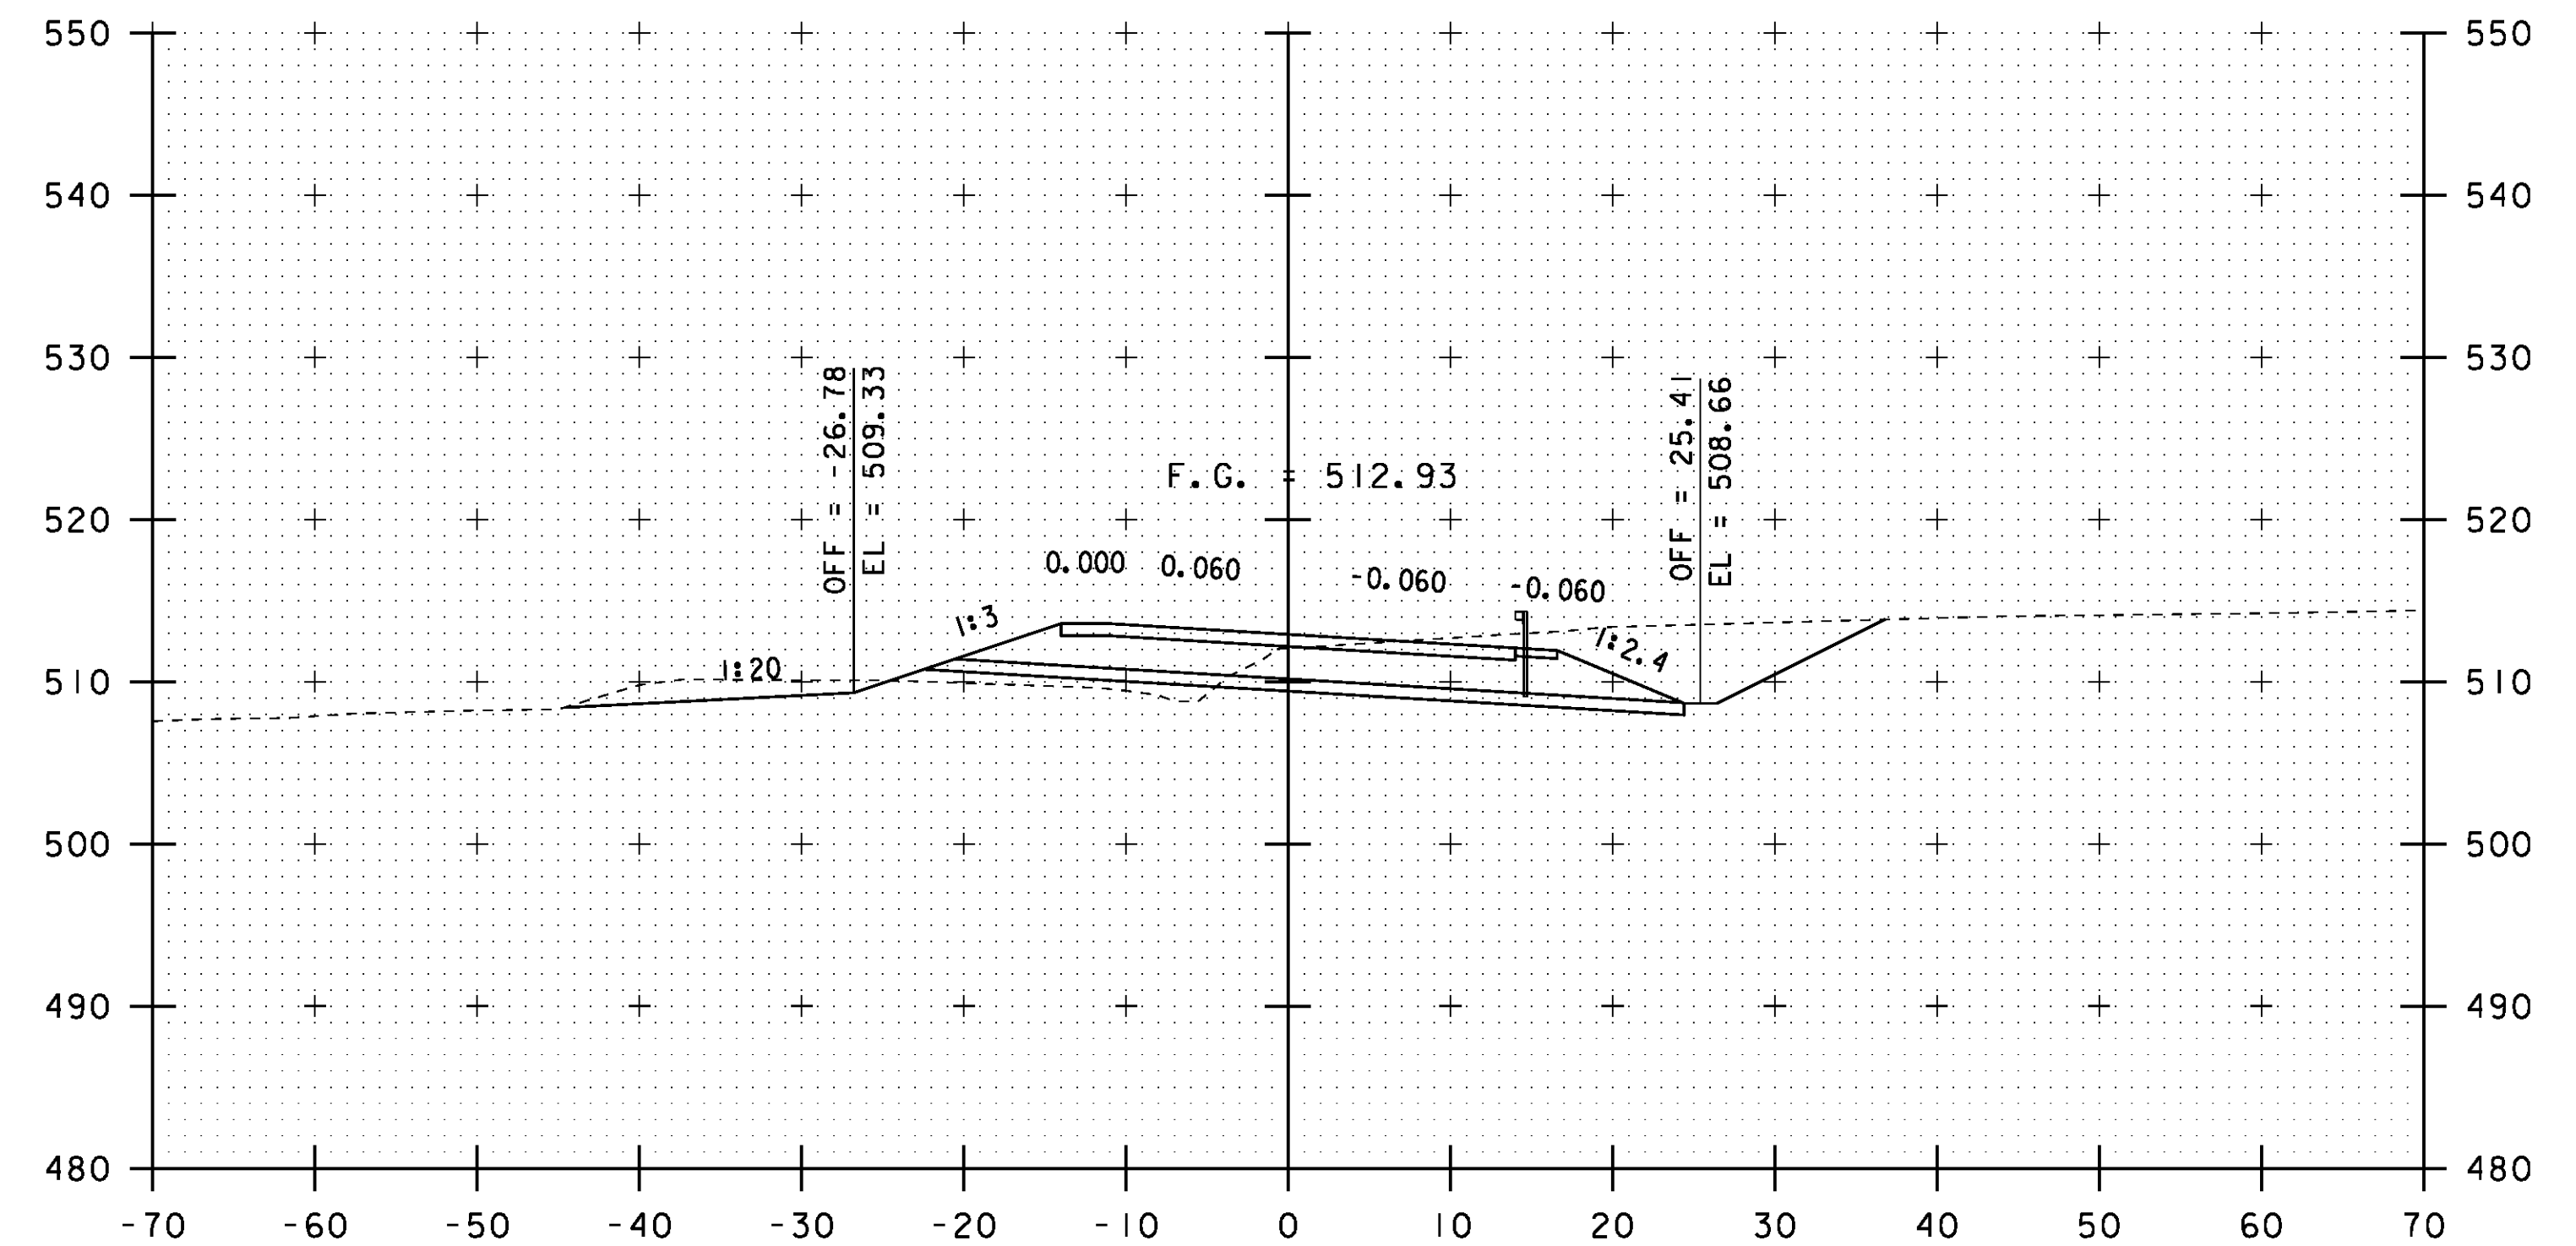

393+00

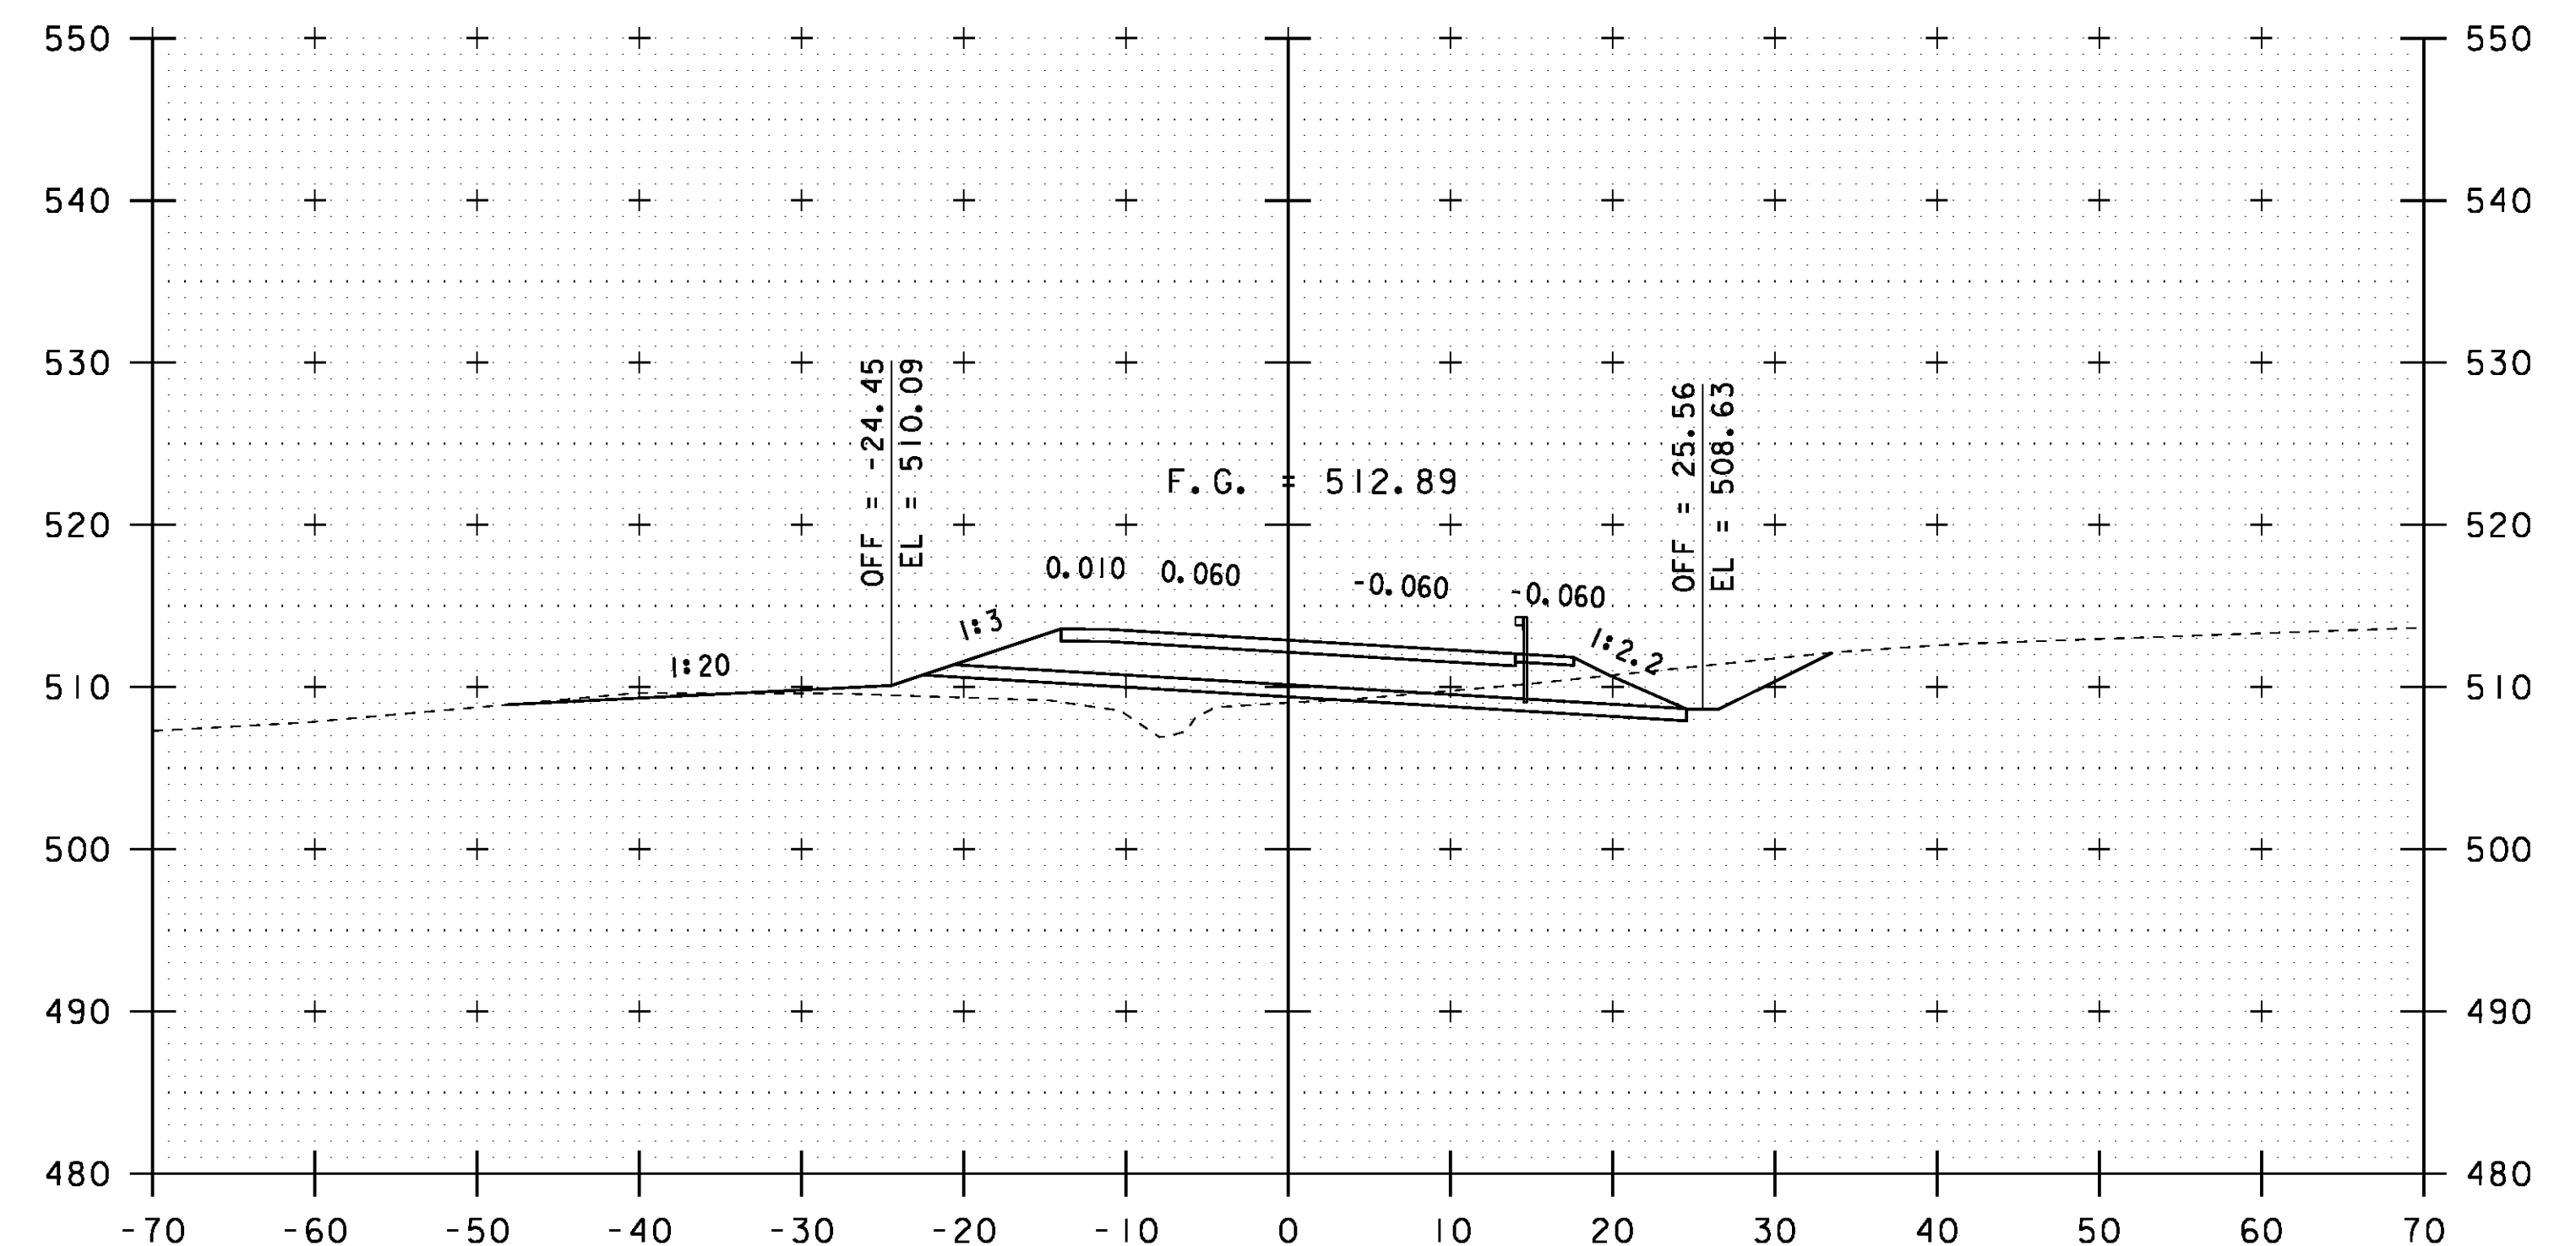

392+75



STA. 392+25 TO STA. 393+00

PROJECT NAME:	ROYALTON
PROJECT NUMBER:	BRS 0147 (13)
FILE NAME:	BR 27\86e055xsl.27.dgn
PROJECT LEADER:	C. CARLSON
DESIGNED BY:	G. ROY
BRIDGE 27 VT 14 CROSS SECTIONS (8)	
PLOT DATE:	08-OCT-2013
DRAWN BY:	G. ROY
CHECKED BY:	D. PETERSON
SHEET	58 OF 186