


117 STRUCTURAL
STEEL

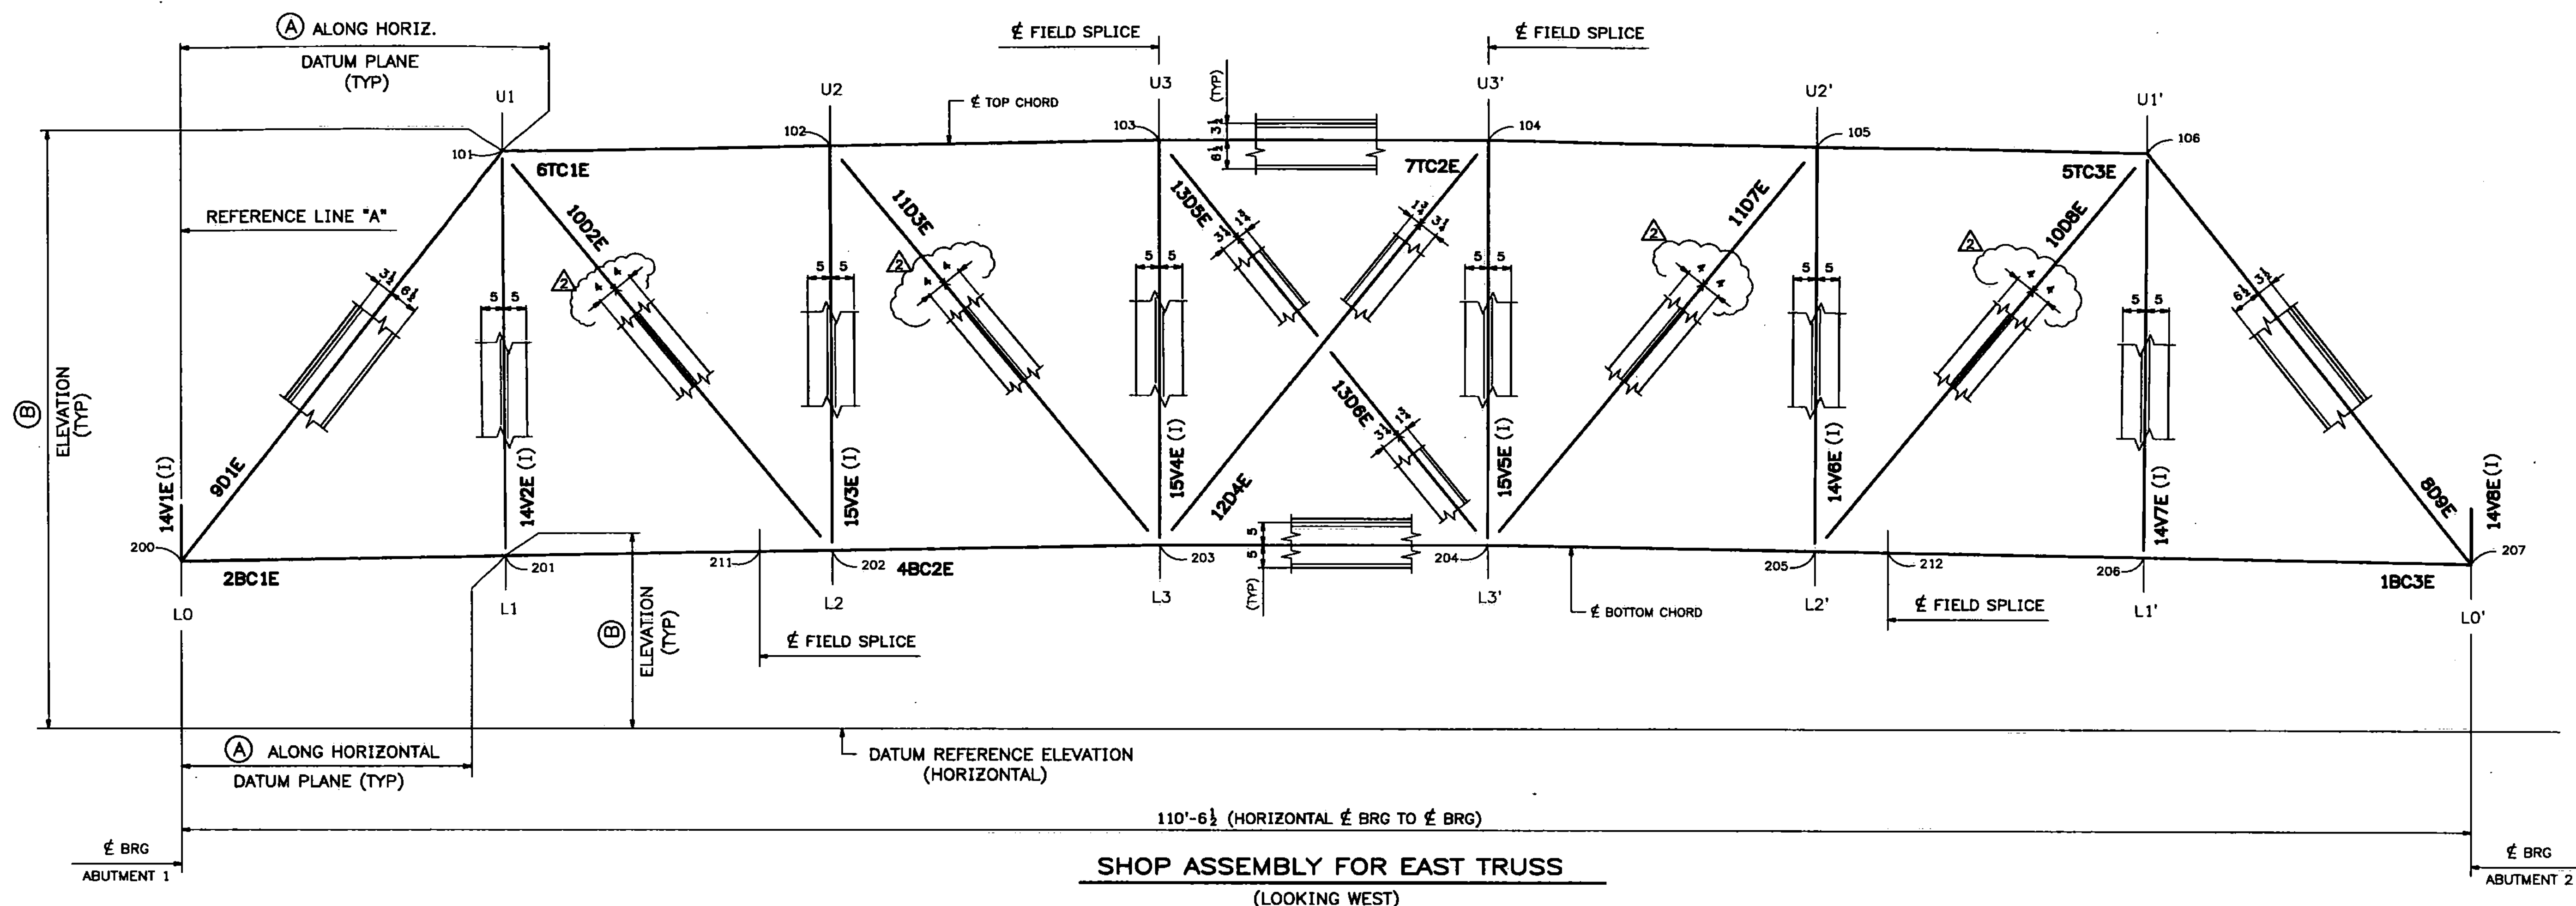

POINT NUMBER	LONGIT. EXTENSION (A)	ELEVATION (B)
200	0"	2'-0
201	15'-9 1/2	2'-2 1/8
202	31'-7	2'-3 1/2
203	47'-4 1/2	2'-3 1/8
204	63'-2	2'-3 1/8
205	78'-11 1/2	2'-3 1/2
206	94'-9	2'-2 1/8
207	110'-6 1/2	2'-0

(FOR BOTTOM CHORD)

POINT NUMBER	LONGIT. EXTENSION (A)	ELEVATION (B)
101	15'-7 1/2	22'-2 1/8
102	31'-5 1/8	22'-3 1/2
103	47'-4 1/8	22'-3 1/8
104	63'-2 1/8	22'-3 1/8
105	79'-0 3/4	22'-3 1/2
106	94'-11 1/8	22'-2 1/8

(FOR TOP CHORD)

POINT NUMBER	LONGIT. EXTENSION (A)	ELEVATION (B)
211	28'-1	2'-3 1/8
212	82'-5 1/2	2'-3 1/8

(FOR FIELD SPLICES)

Vermont Agency of Transportation

RECEIVED

CK'D BY TCF OK'D BY SSS

7:43 am, Apr 12, 2011

RESUBMIT APPROVED X
BY KMH DATE 4-12-11

- NOTES:
1. ALL DIMENSIONS ARE GIVEN TO THE $\bar{E}$ OF EAST TRUSS.
 2. ALL LONGITUDINAL EXTENSION DIMENSIONS (ALONG HORIZ. DATUM PLANE) ARE GIVEN FROM REFERENCE LINE "A".
 3. ALL ELEVATIONAL OFFSETS (ELEVATIONS) ARE GIVEN VERTICALLY FROM THE HORIZONTAL DATUM PLANE.

NOTE:
(1) INDICATES THAT THE SHIPPING MARK IS ON THE MEMBERS INNER FACE (FLOOR BEAM SIDE).

03/23/11	REVISED AS PER APPROVAL COMMENTS	JM	PWR		
03/09/11	RESUBMIT FOR APPROVAL	JM	PWR		
0					
REV.	DATE	REMARKS	DWN	CHK	APVL
MATERIAL:		SURFACE PREP. & PAINT:	HOLES:		SHOP BOLTS:
DESCRIPTION: SHOP ASSEMBLY FOR EAST TRUSS					
CASCO BAY STEEL STRUCTURES, INC.					
75 SPRING HILL ROAD SACO, MAINE 04072					
PHONE (207) 282-7360 FAX. (207) 282-1179					
STRUCTURE:		Vermont Route 100A		DRAWN:	DATE:
		Bridge No. 14		RB	10/12/10
		Bridgewater		CHKD:	DATE:
		County of Windsor		WJL	10/20/10
LOCATION:		BRIDGEWATER, VERMONT		JOB NO.	DWG NO.
PROJ NO.		BRS 0149(4)		454	SA2
CUSTOMER:		VT AOT		REV.	