



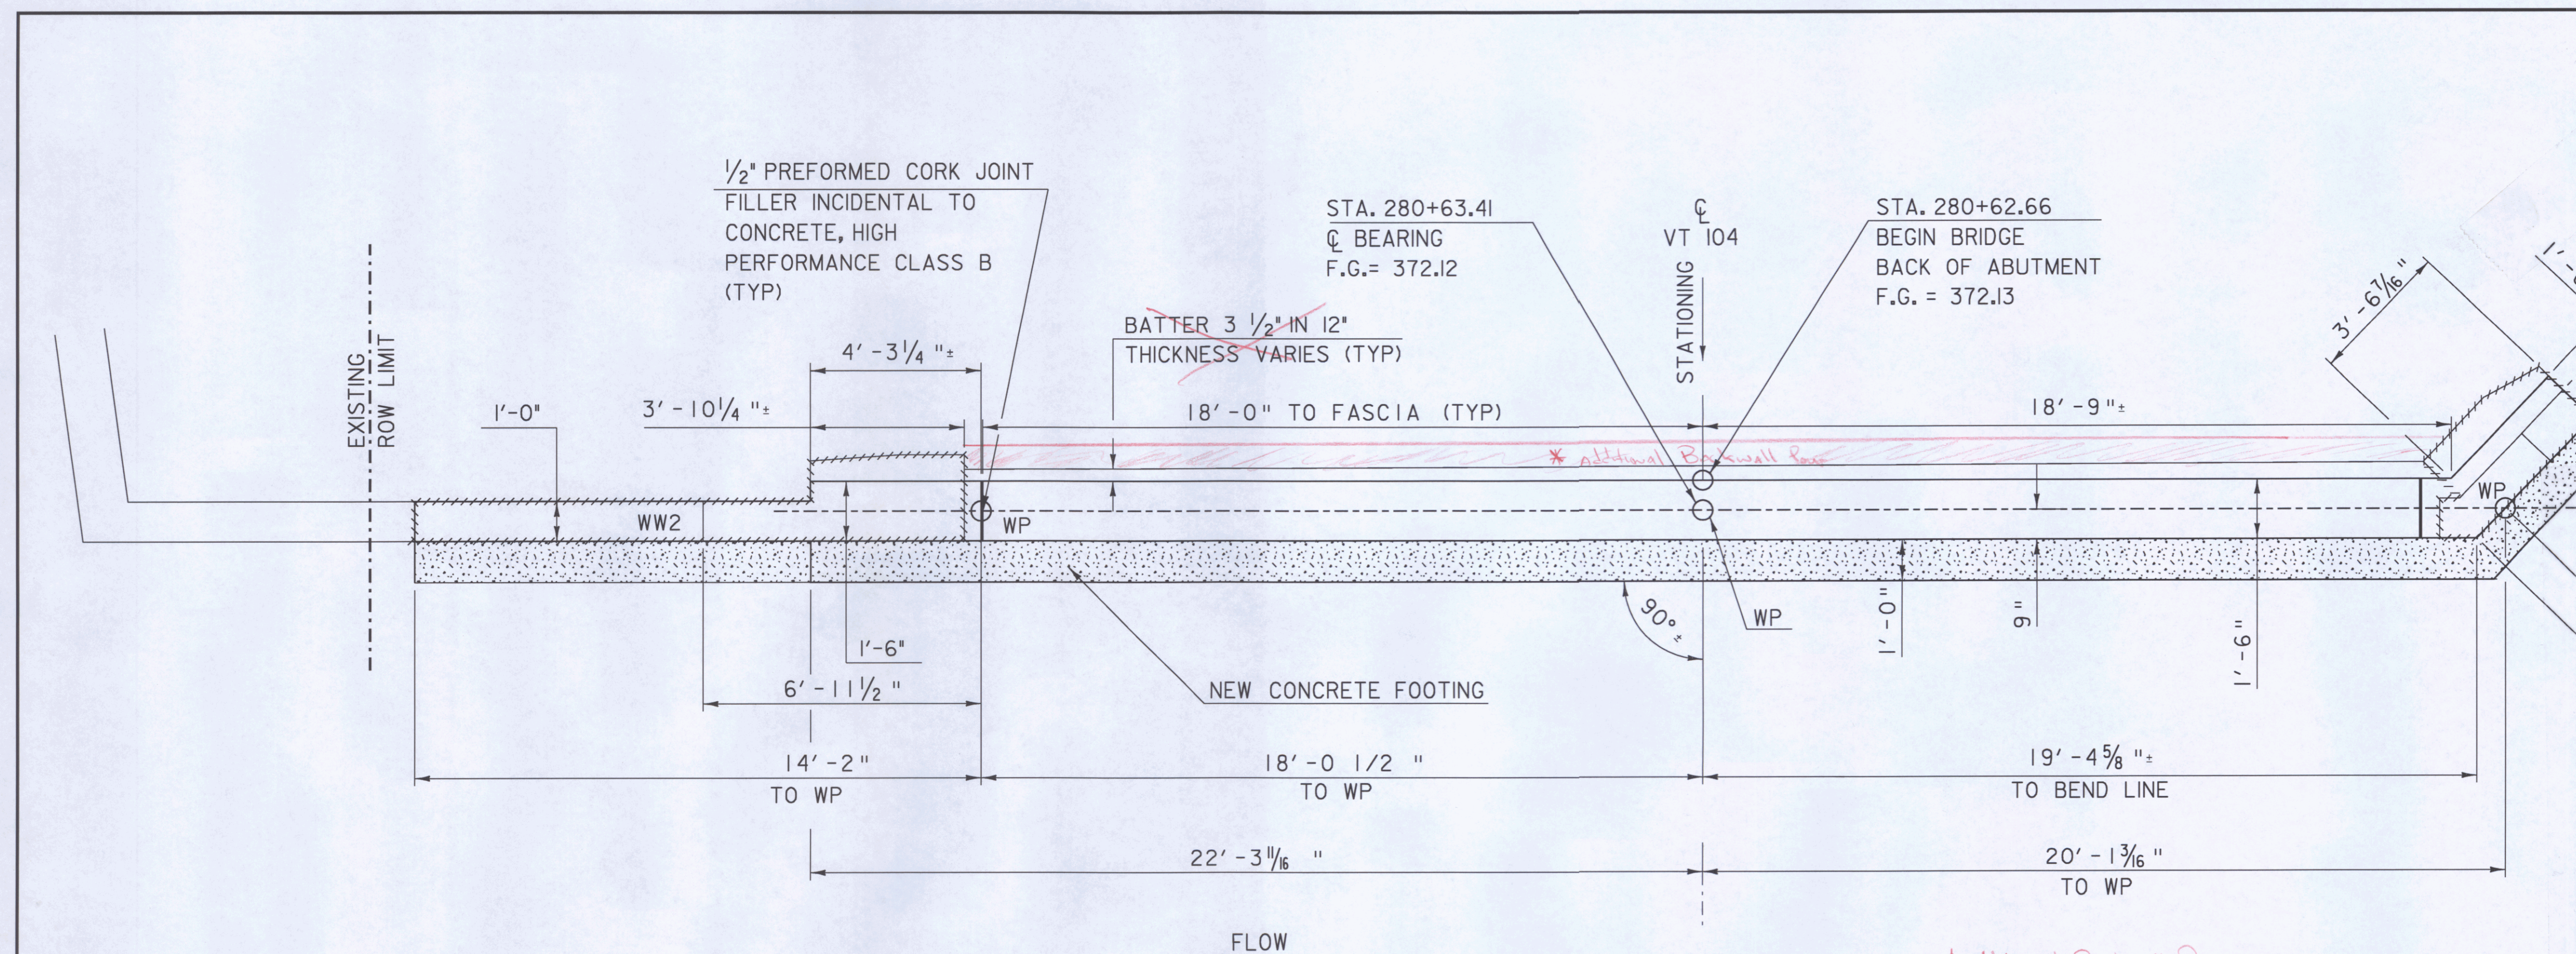

ABUTMENT I PLAN

SCALE $\frac{3}{8}" = 1'-0"$


* Additional Backwall Pour, Dimensions typical Abutment #1 & #2
 1 1/2' deep
 15' deep
 2' deep
 36.5'

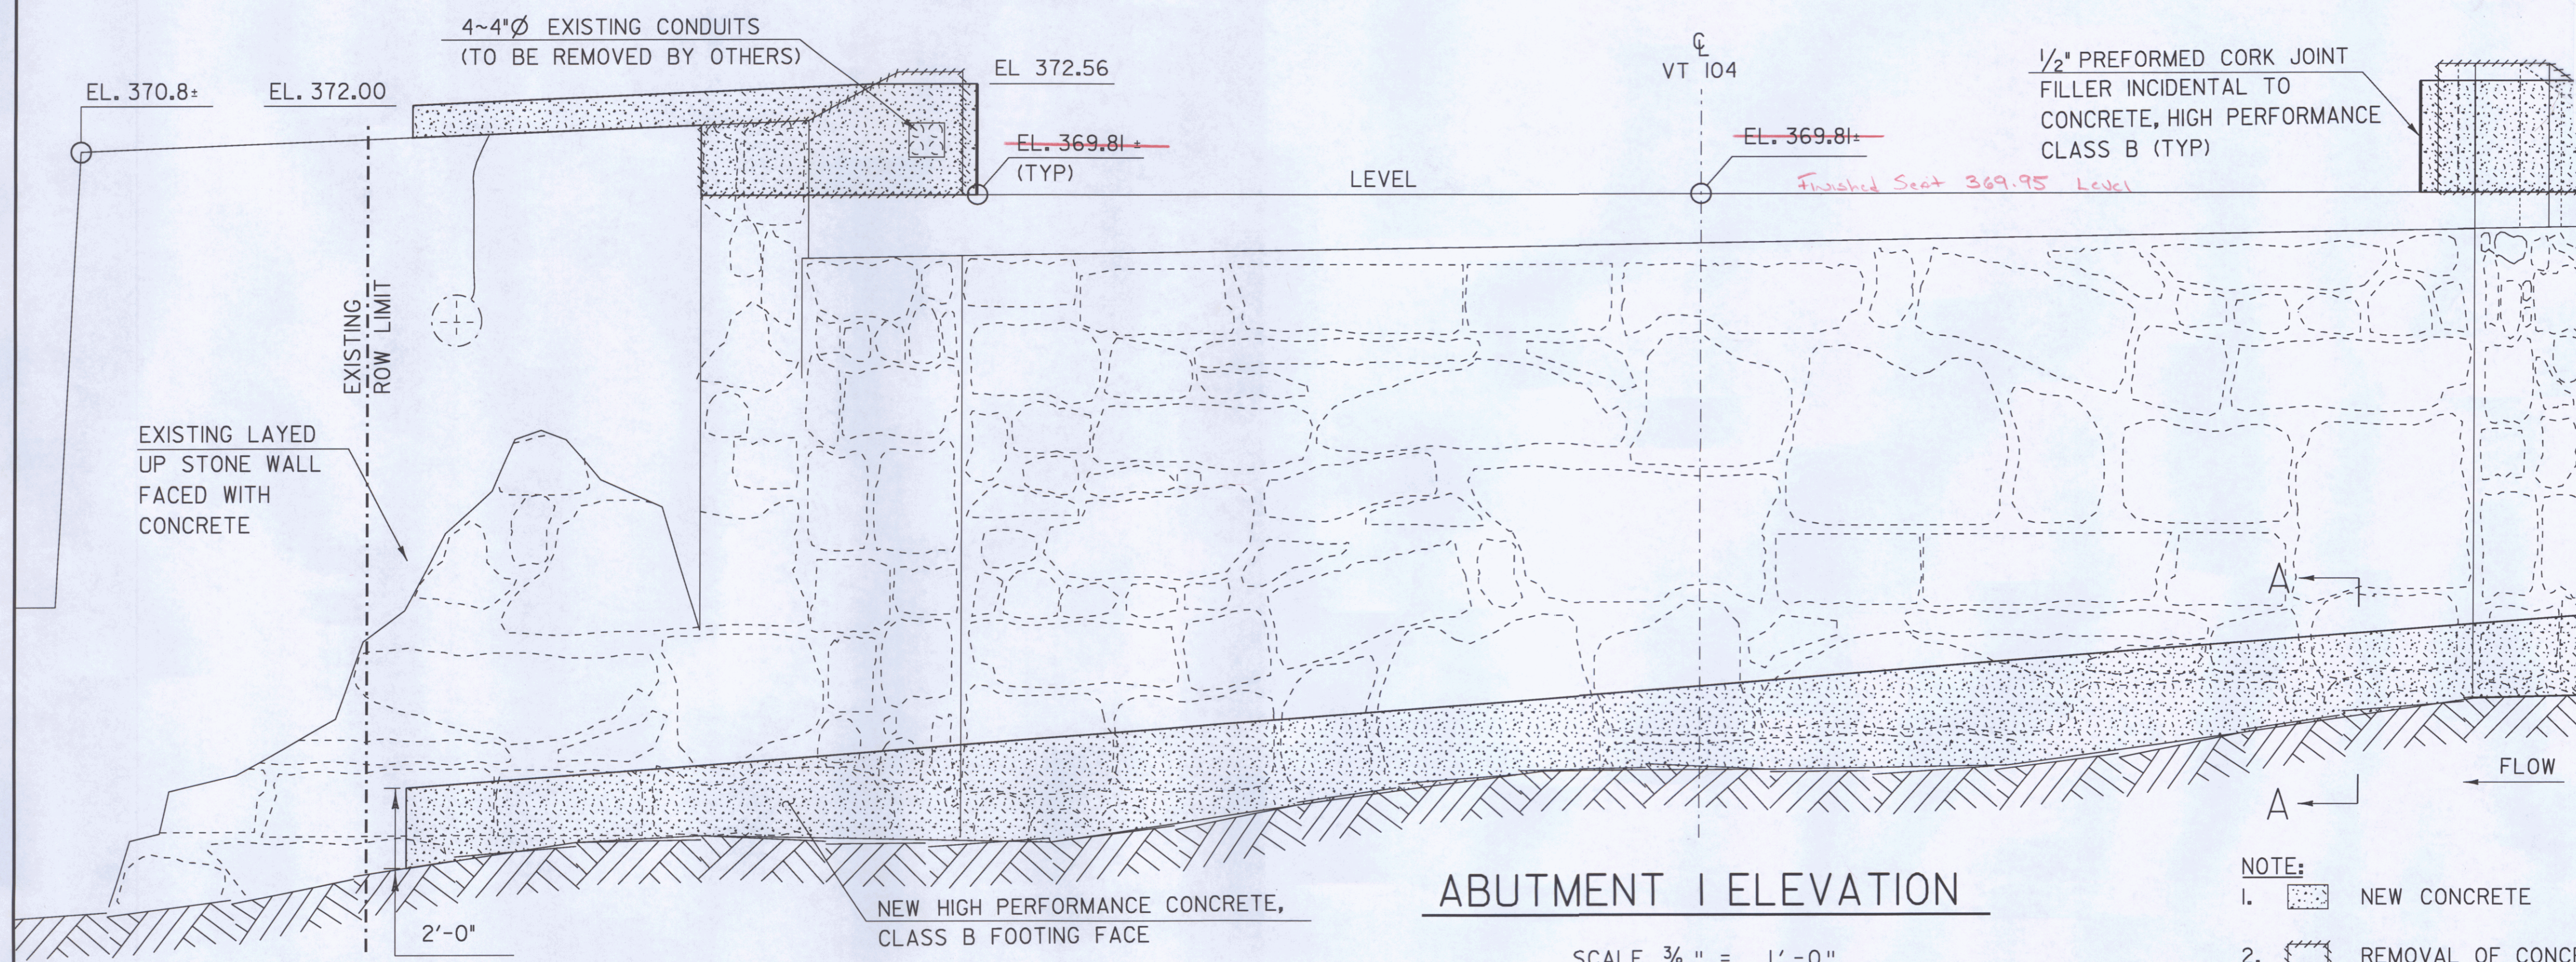

ABUTMENT I ELEVATION


SCALE $\frac{3}{8}" = 1'-0"$

- NOTE:
1. [Pattern] NEW CONCRETE
 2. [Pattern] REMOVAL OF CONCRETE OR MASONRY
 3. SEE SHEET 43 FOR WINGWALL DETAILS

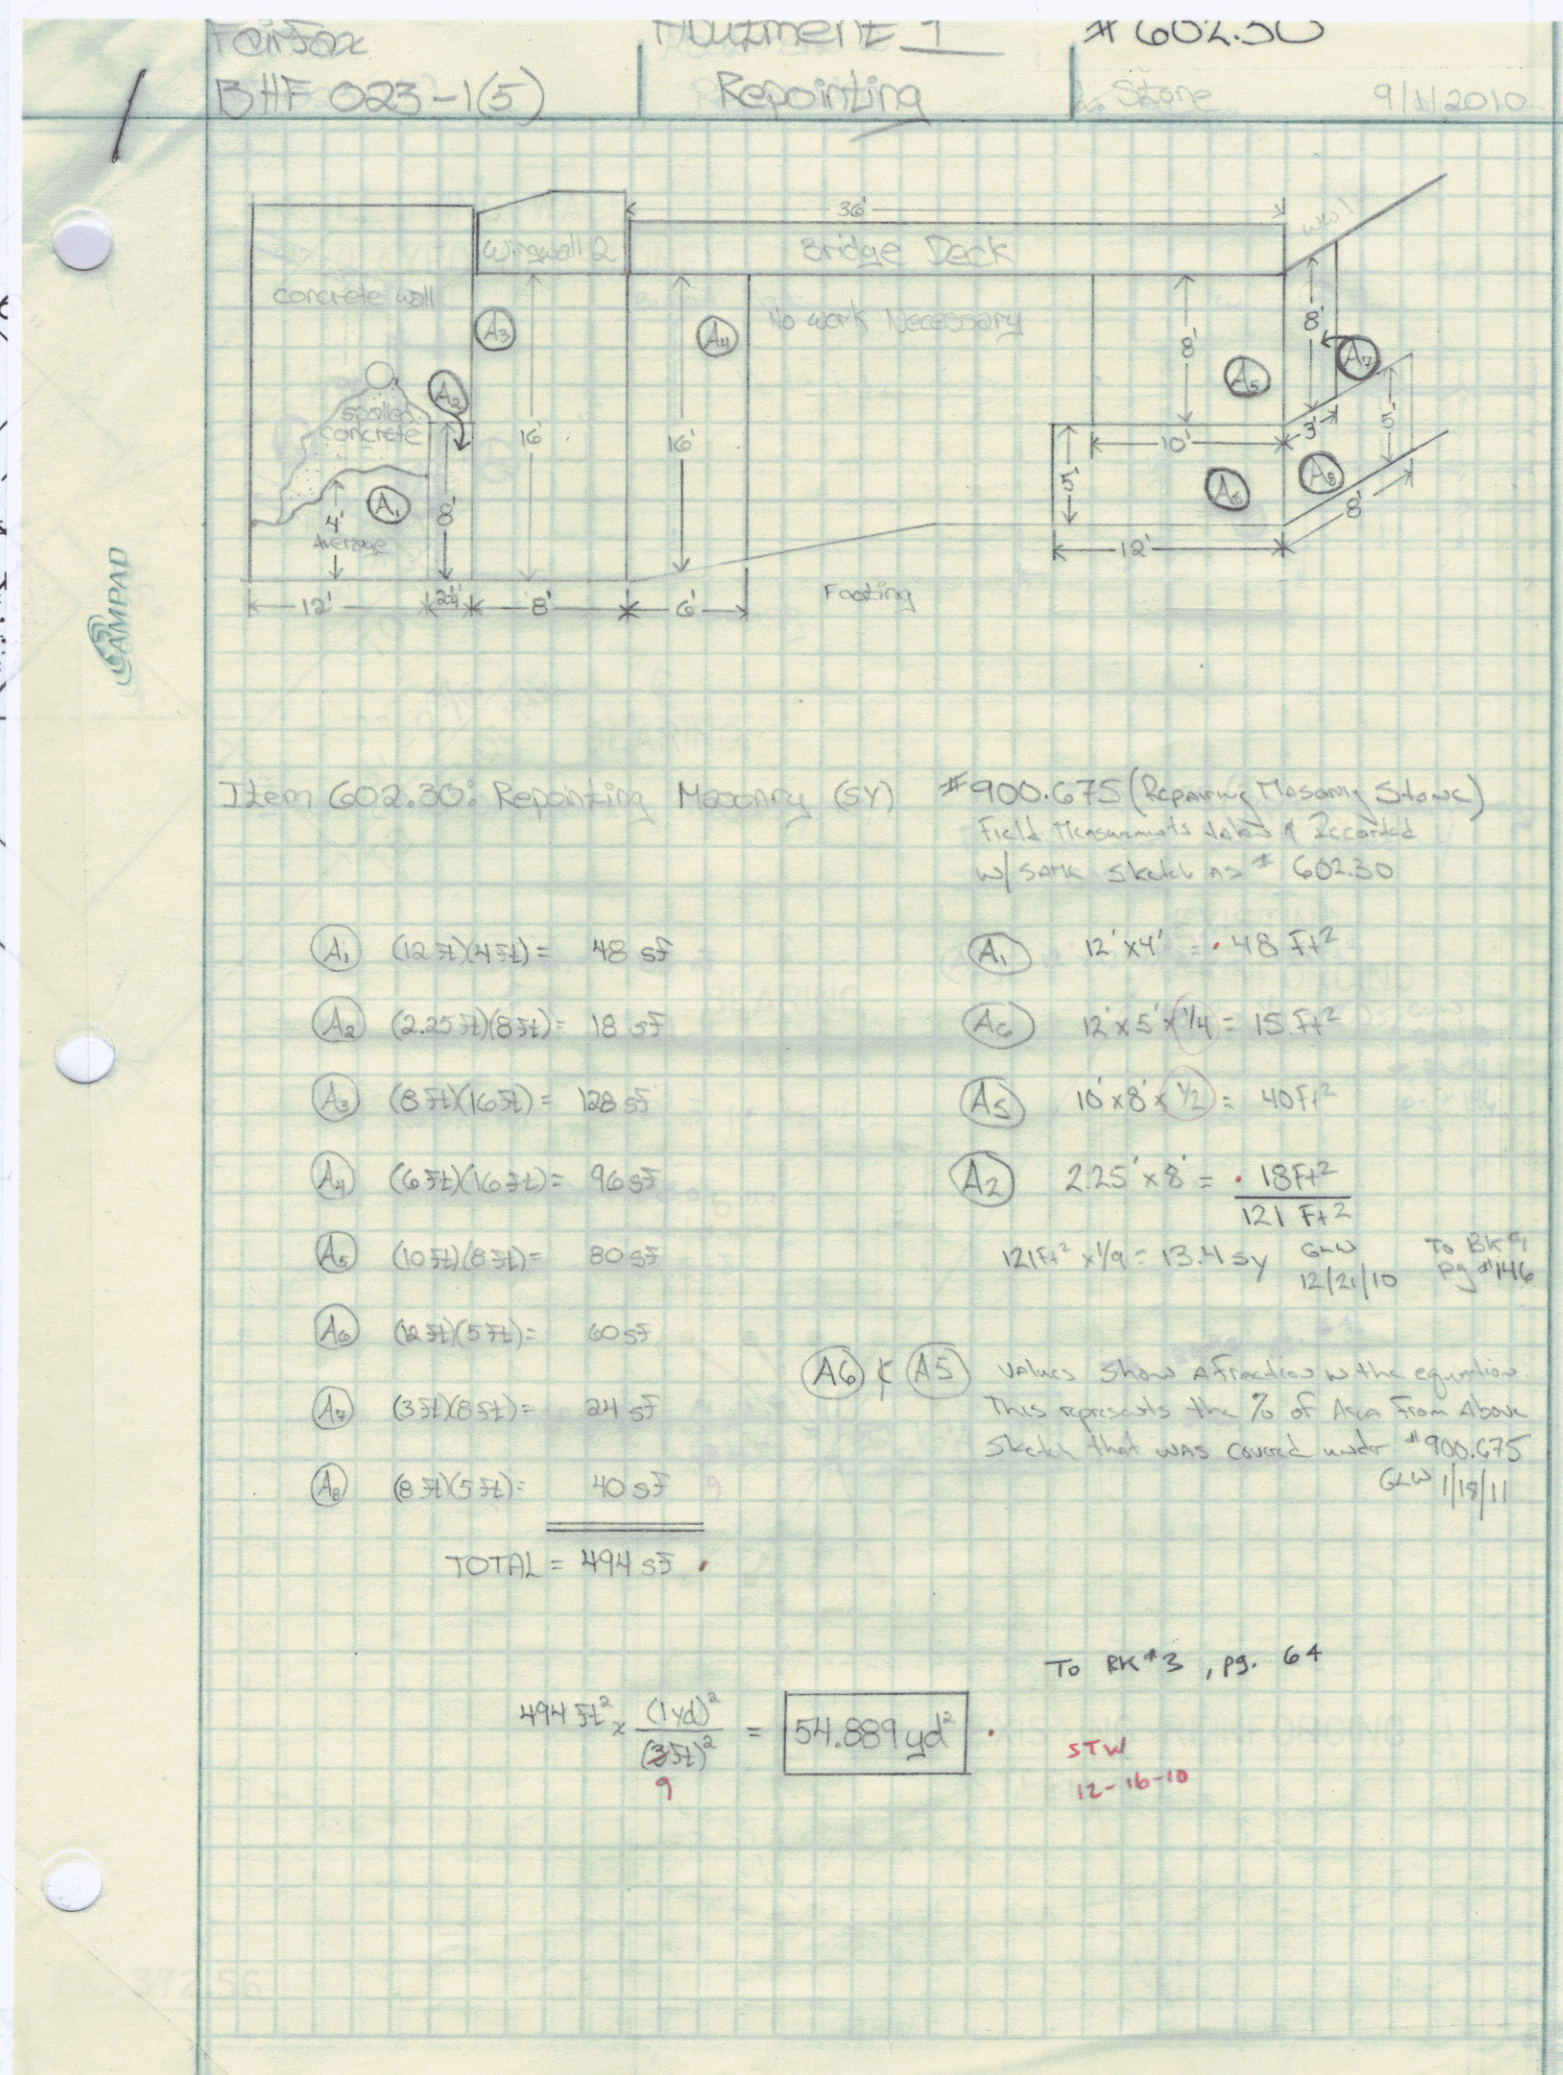

EXISTING ABUTMENT I TYPICAL

SCALE 1" = 1'-0"

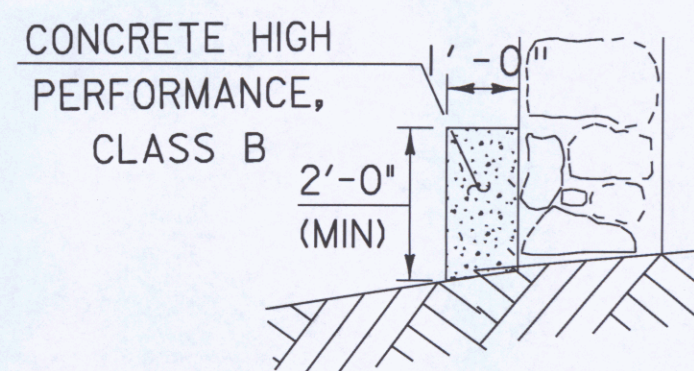

SECTION A-A

SCALE $\frac{3}{8}" = 1'-0"$

ABUTMENT I DETAILS

PROJECT NAME:	FAIRFAX	FILE NAME:	s86e064sub.dgn	PLOT DATE:	20-JUL-2009
PROJECT NUMBER:	BHF 023-1(5)	PROJECT LEADER:	C. CARLSON	DRAWN BY:	C. MOONEY
		DESIGNED BY:	C. CARLSON	CHECKED BY:	C. CARLSON
				SHEET	41 OF 61