

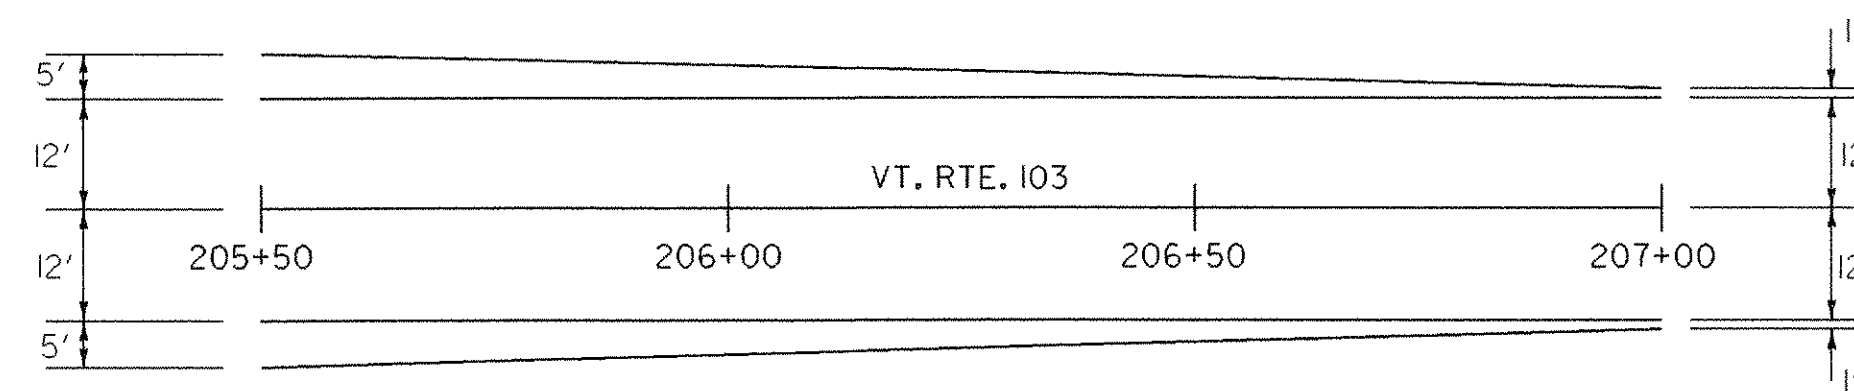





APPROACH TRANSITION DETAILS

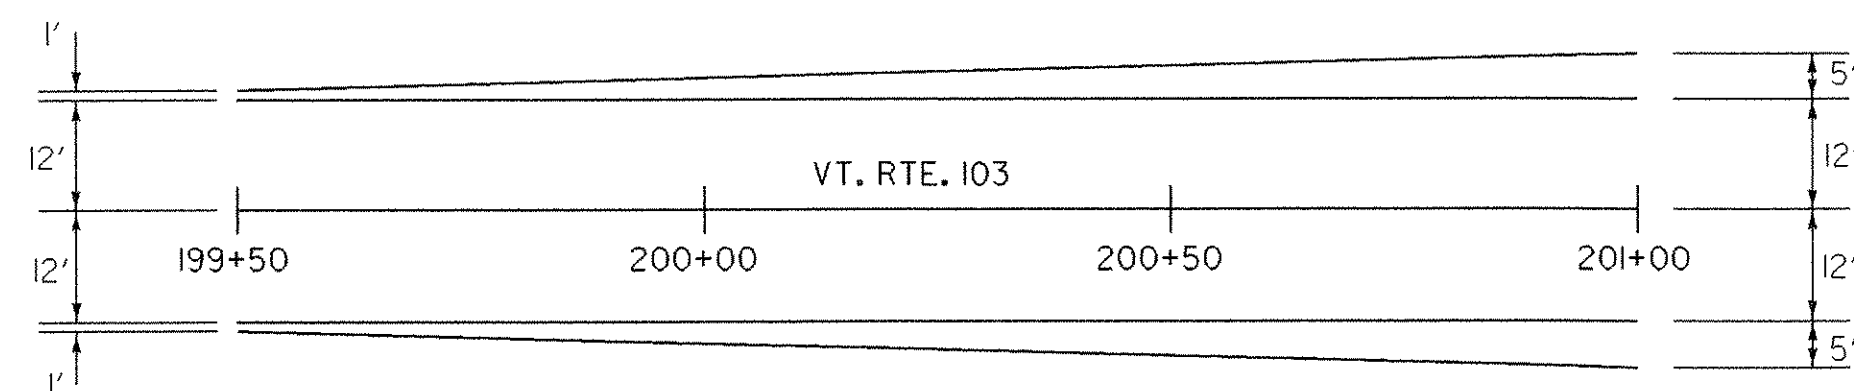

TH #6 TRANSITION DETAIL

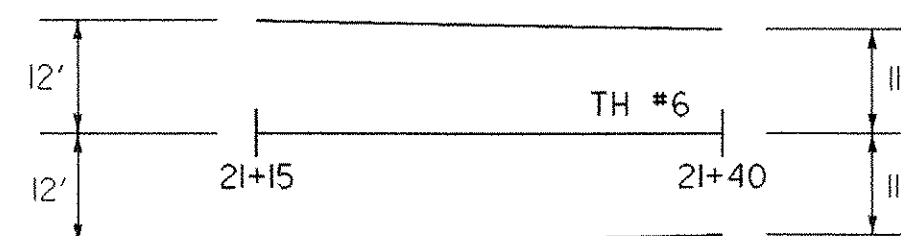

GUARD RAIL DETAILS

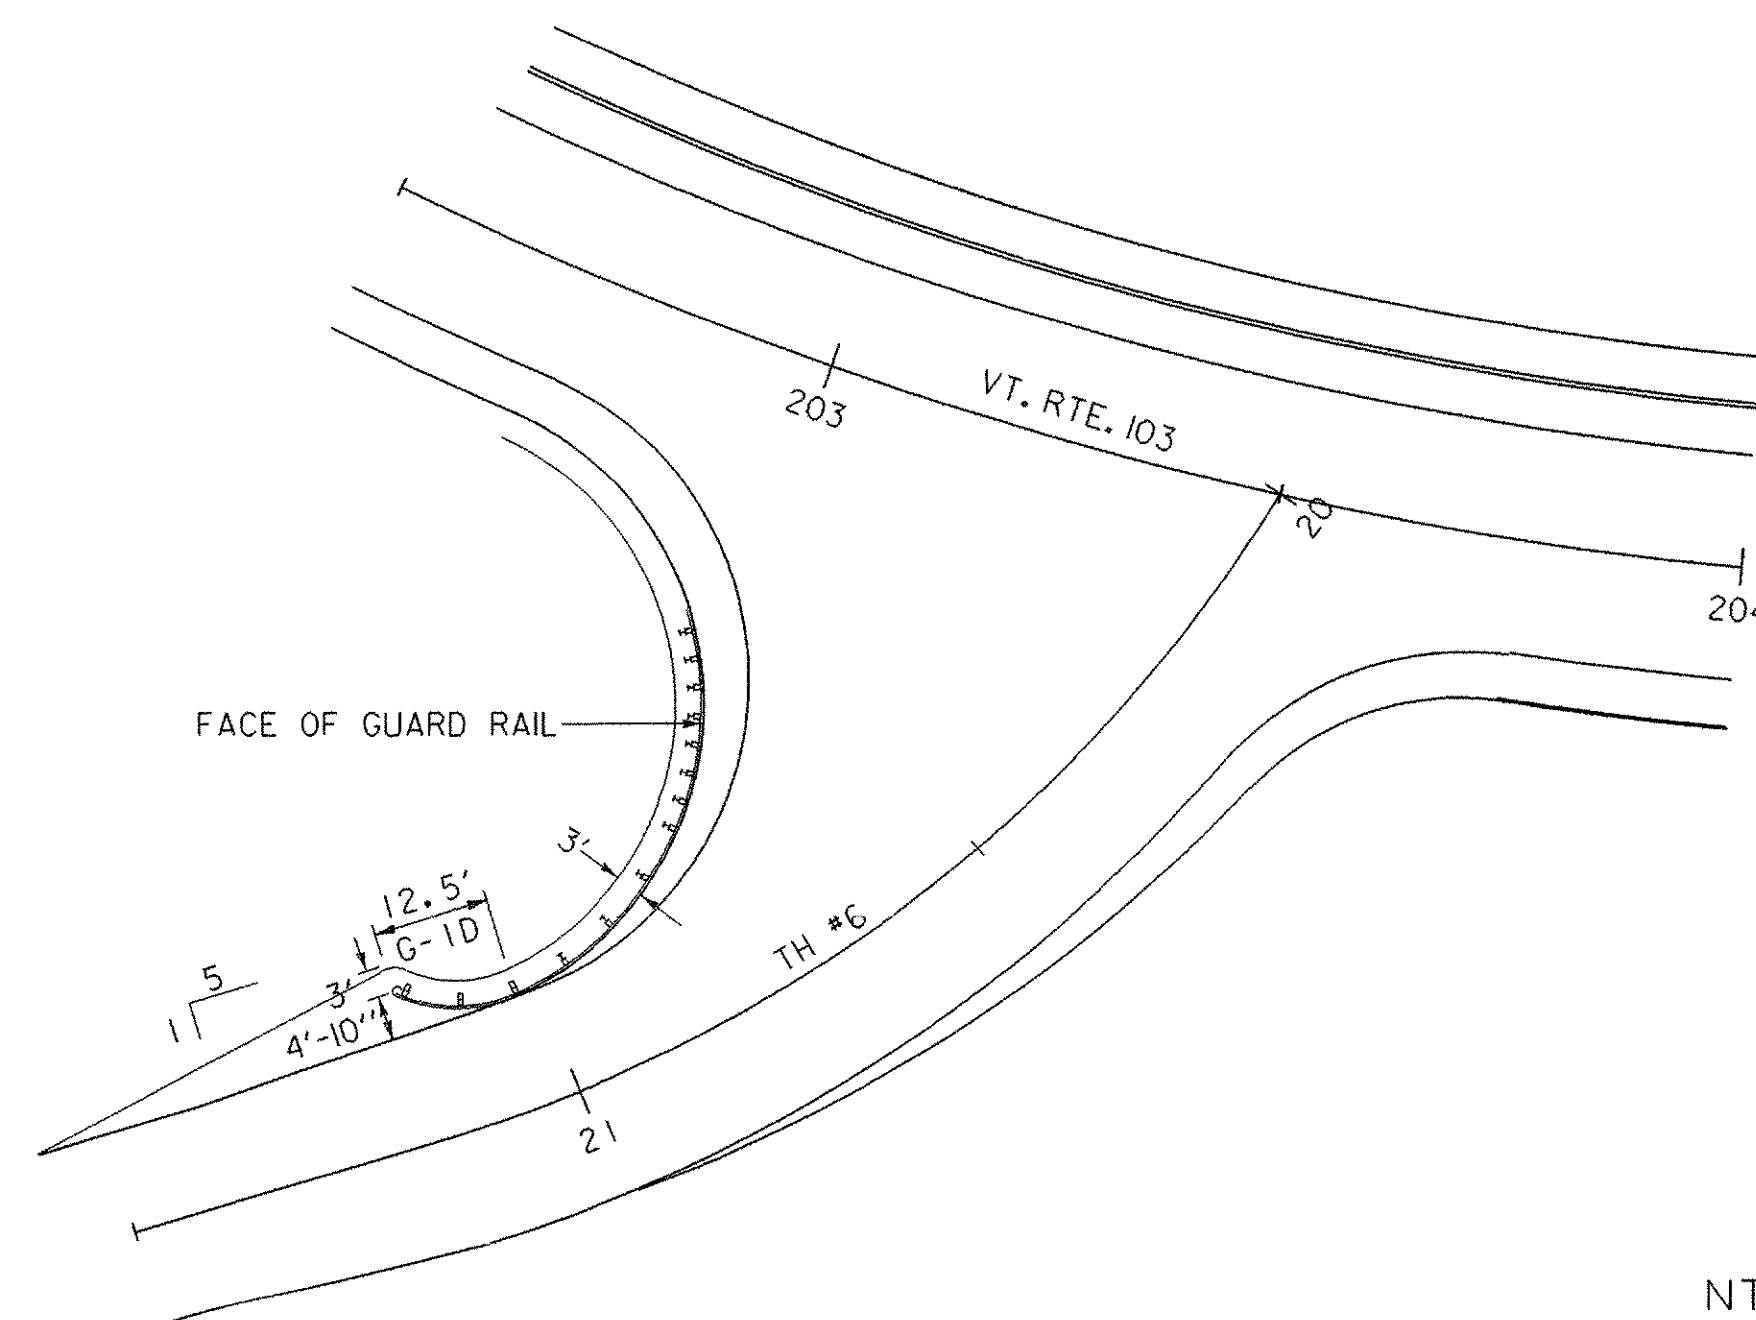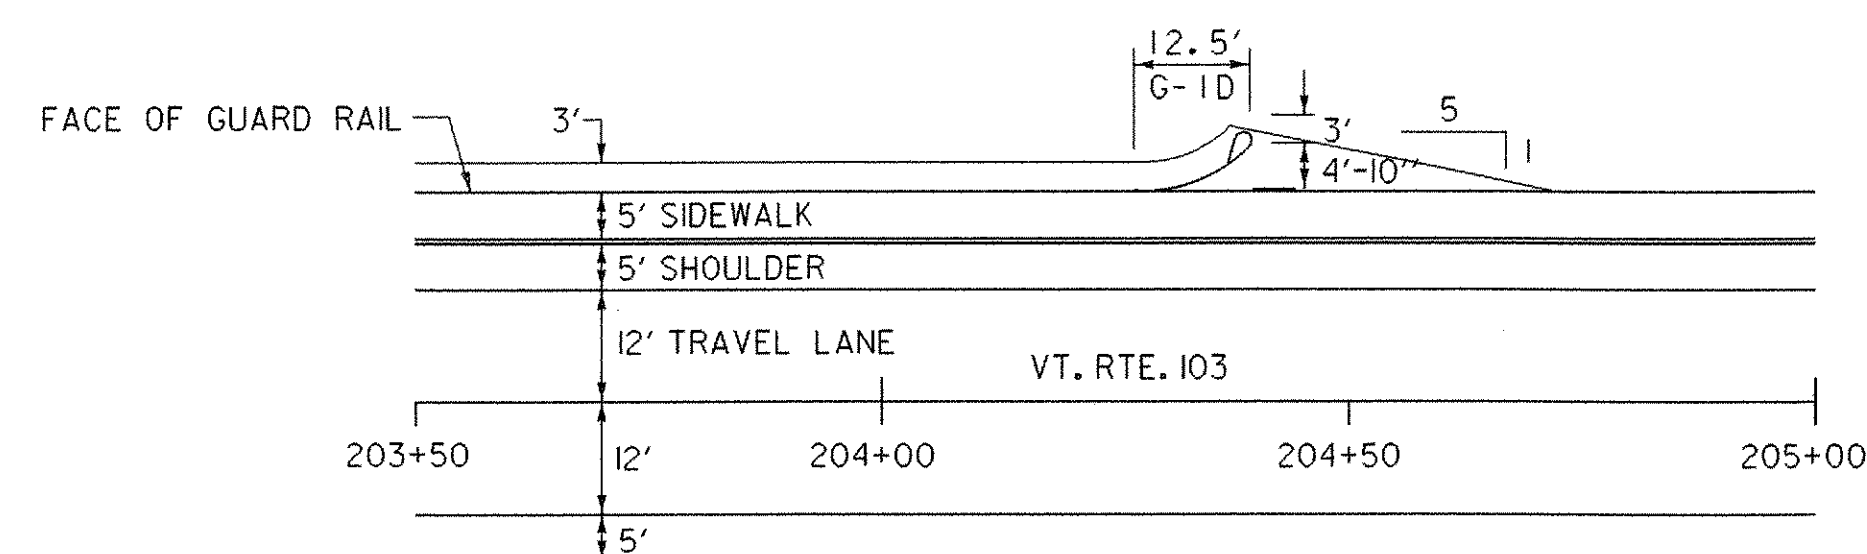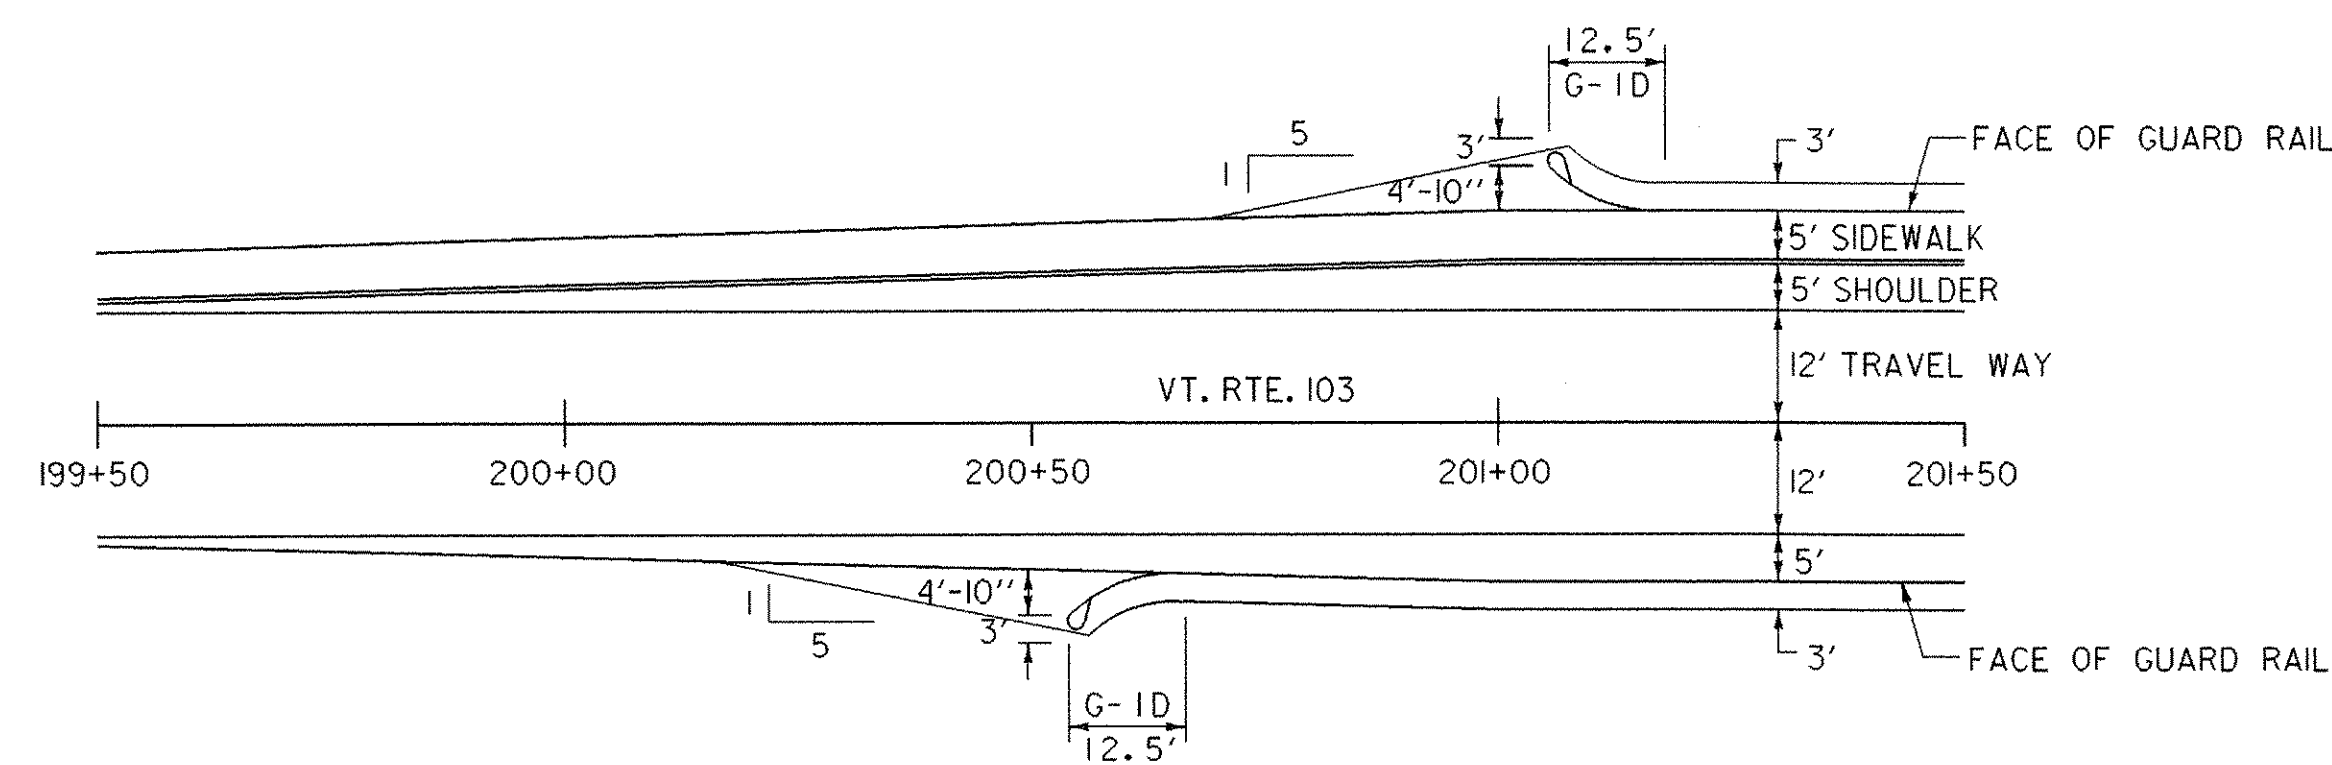

NTS

DATUM	
VERTICAL	N/A
HORIZONTAL	N/A

PROJECT:	CHESTER	PROJECT NO.:	BRF 025-1(35)
DESIGN FILE NAME:	M:\1549100 VAOT Chester Curv\HWY\DRAW\zf134frm.dgn	IPARM FILE NAME:	zf134d+li
SURVEYED BY:	SHERIDAN	SURVEY DATE:	8/90
SQUAD LEADER:	PORTALUPI	DRAWN BY:	L. BULLOCK
		SHEET:	29 OF 79