




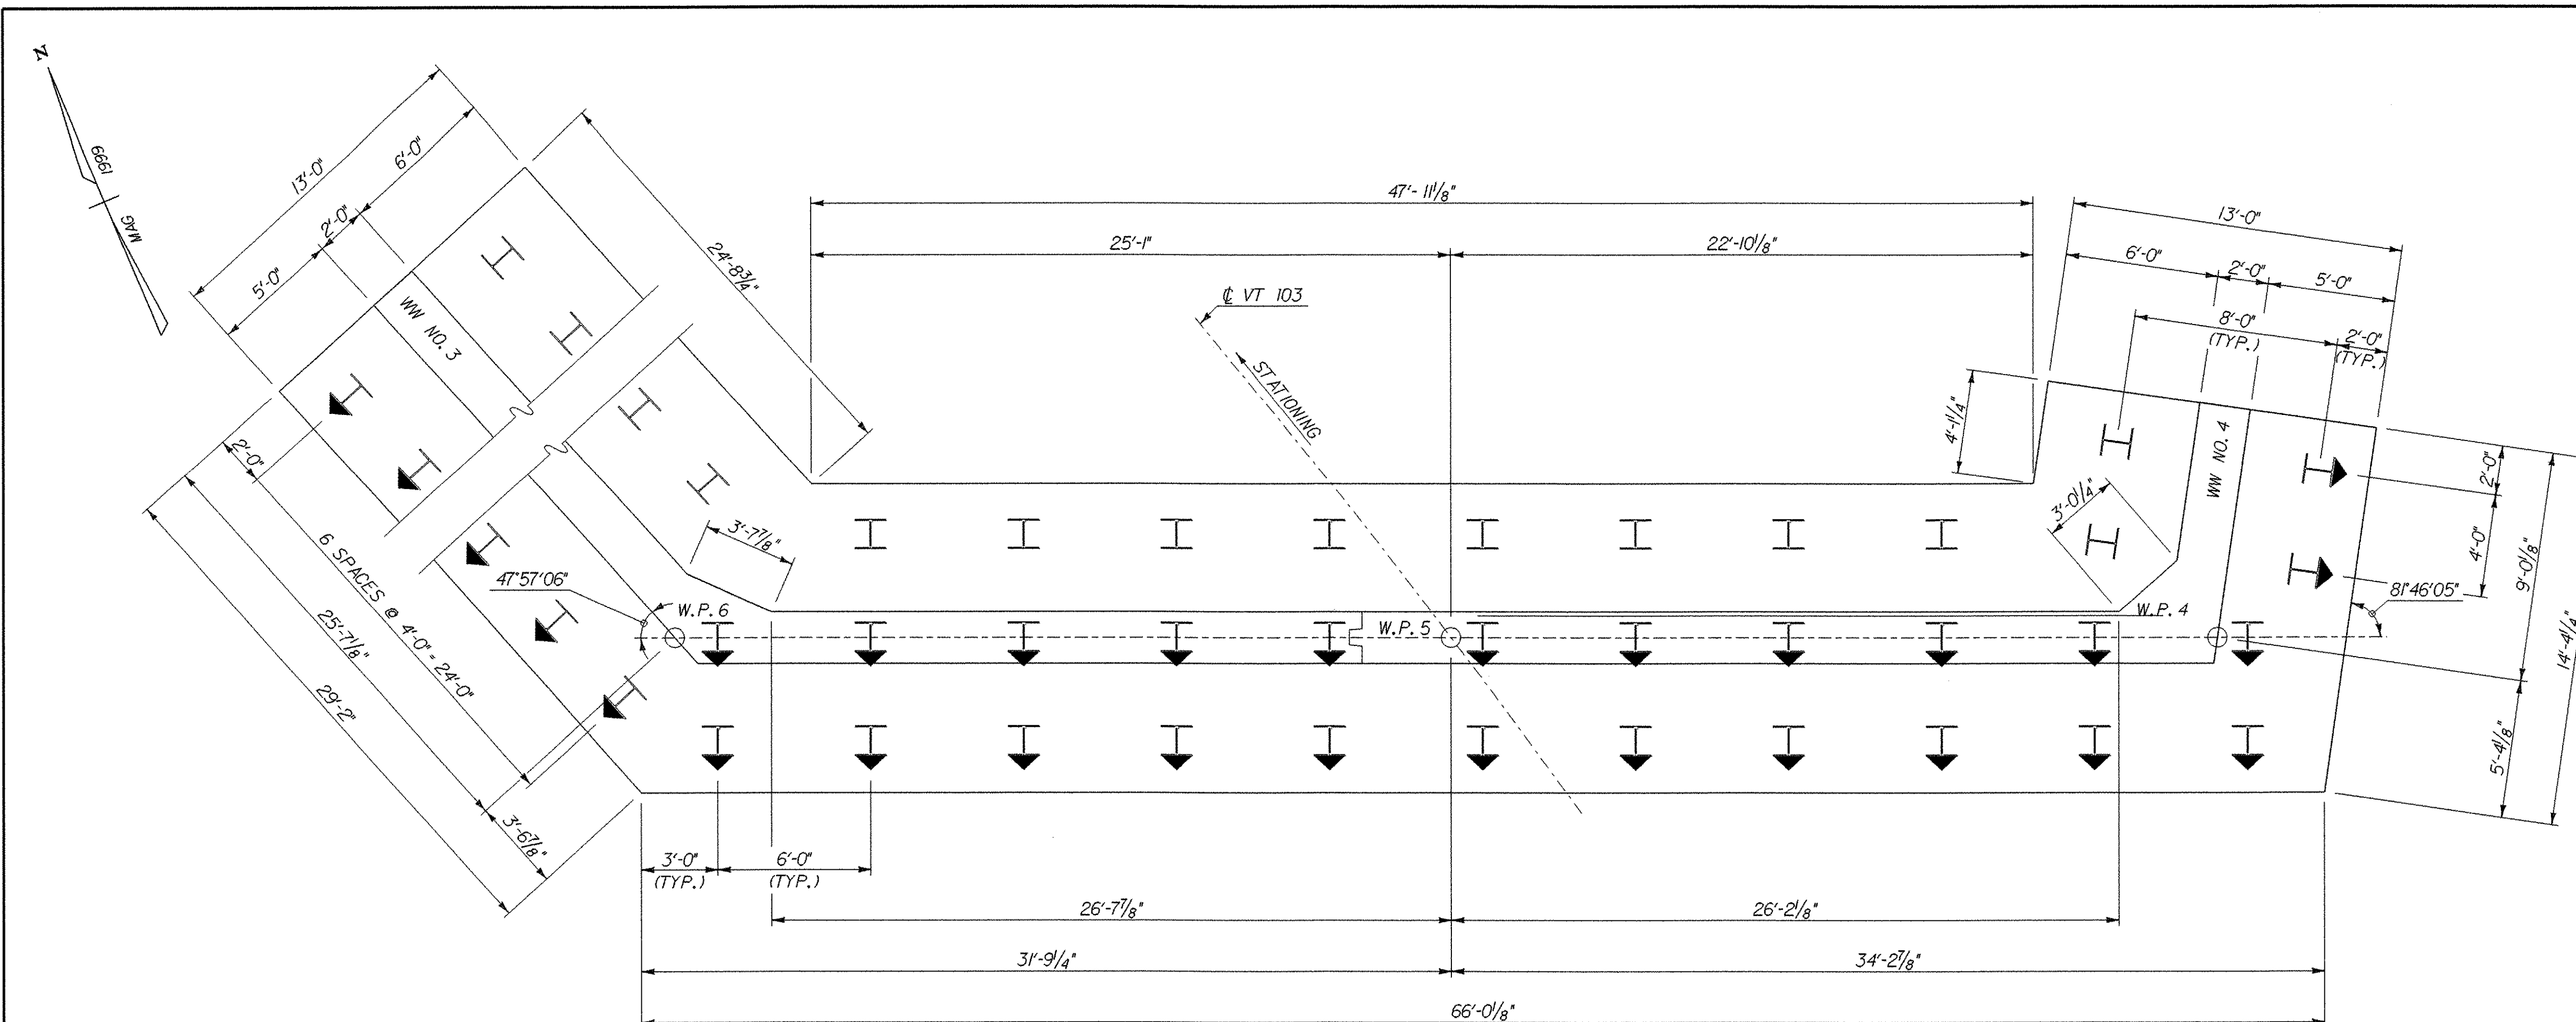


FOOTING NO. 2 MASONRY
SCALE: 1/4" = 1'-0"

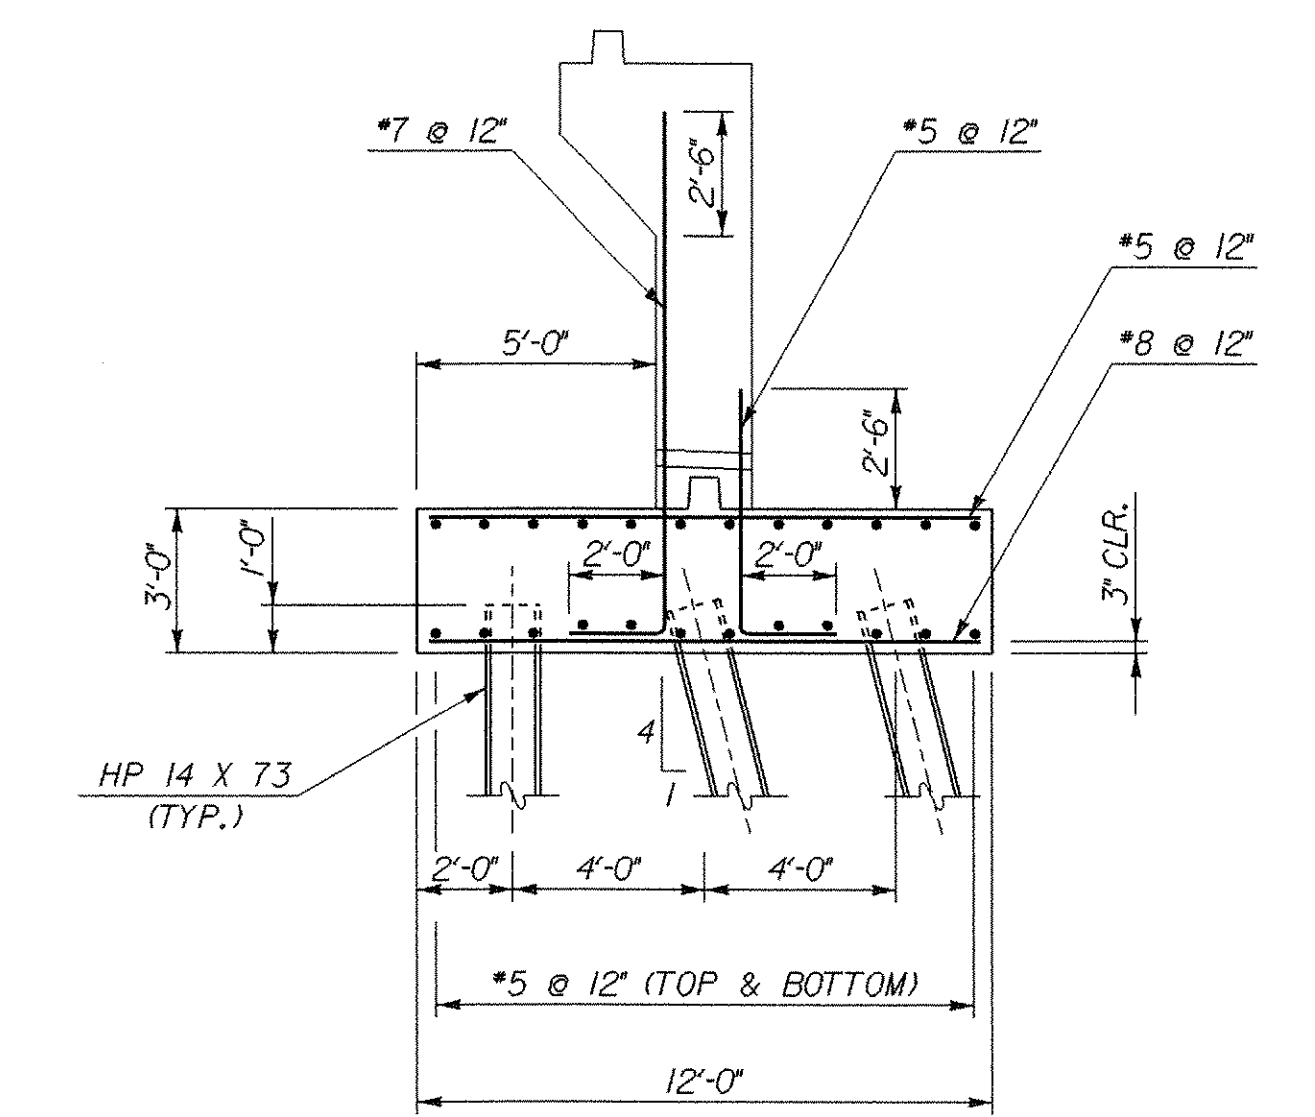

SECTION A-A
SCALE: 1/4" = 1'-0"

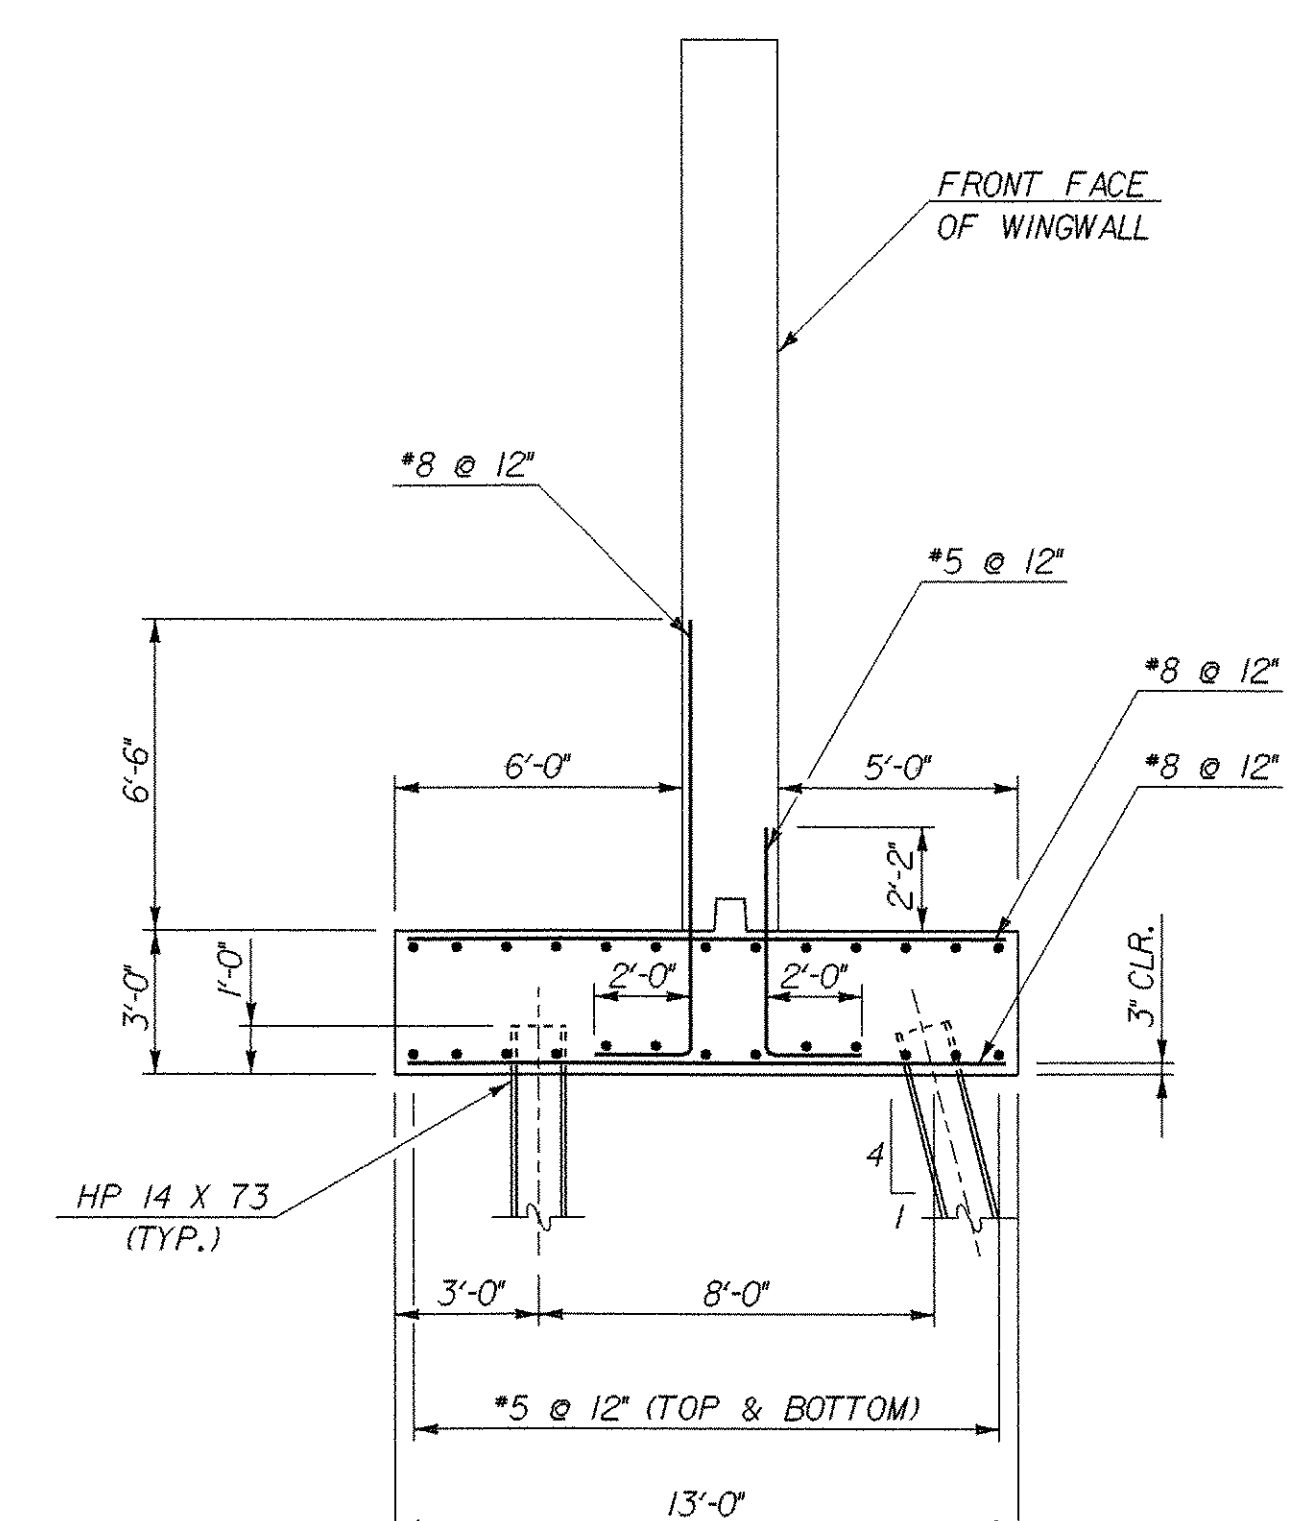

SECTION B-B
SCALE: 1/4" = 1'-0"

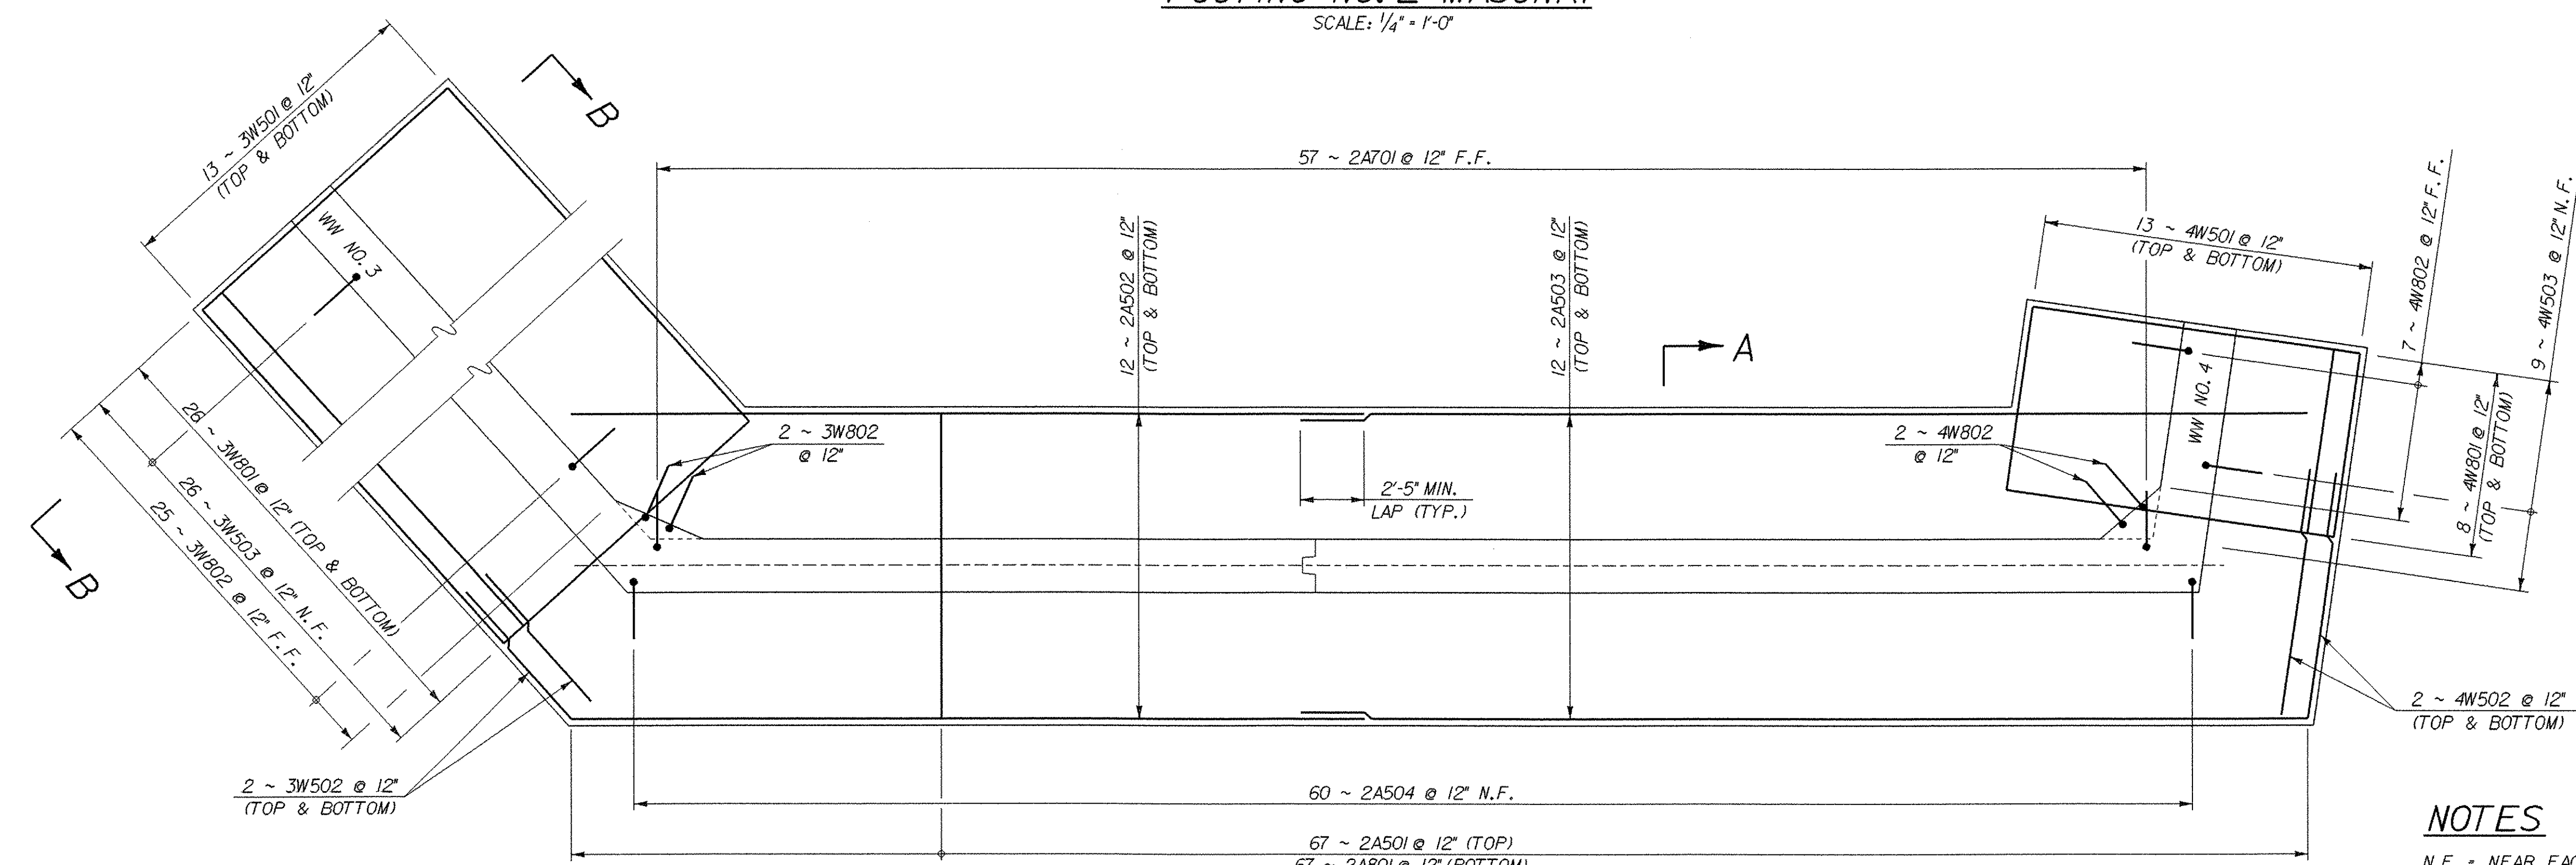

FOOTING NO. 2 REINFORCING
SCALE: 1/4" = 1'-0"

NOTES
N.F. = NEAR FACE
F.F. = FAR FACE
E.F. = EACH FACE
▲ = CUT TO FIT IN FIELD

STATE OF VERMONT AGENCY OF TRANSPORTATION			
Town Of	CHESTER	Bridge No.	12
Highway No.	VT 103	Log Sta.	
		Surv. Sta.	
VT 103 OVER THE WILLIAMS RIVER			
FOOTING NO. 2 DETAILS			
Designed By	L. WIXSON	Drawn By	P. DUSTIN
Checked By	T. GRANT	Date	10/00
		Bridge Design Supervisor	M. ZYDEL
PROJECT	CHESTER	PROJECT NO.	BRF 025-1(35)
I.G.C. Info.	M:\87b134\Structures\zbl34cf2.dgn		zbl34cf2J
Bridge Sheet No.	BR122	Sheet	66 of 79
PLOTTED 28-MAY-2003			

McFARLAND + JOHNSON, INC.