


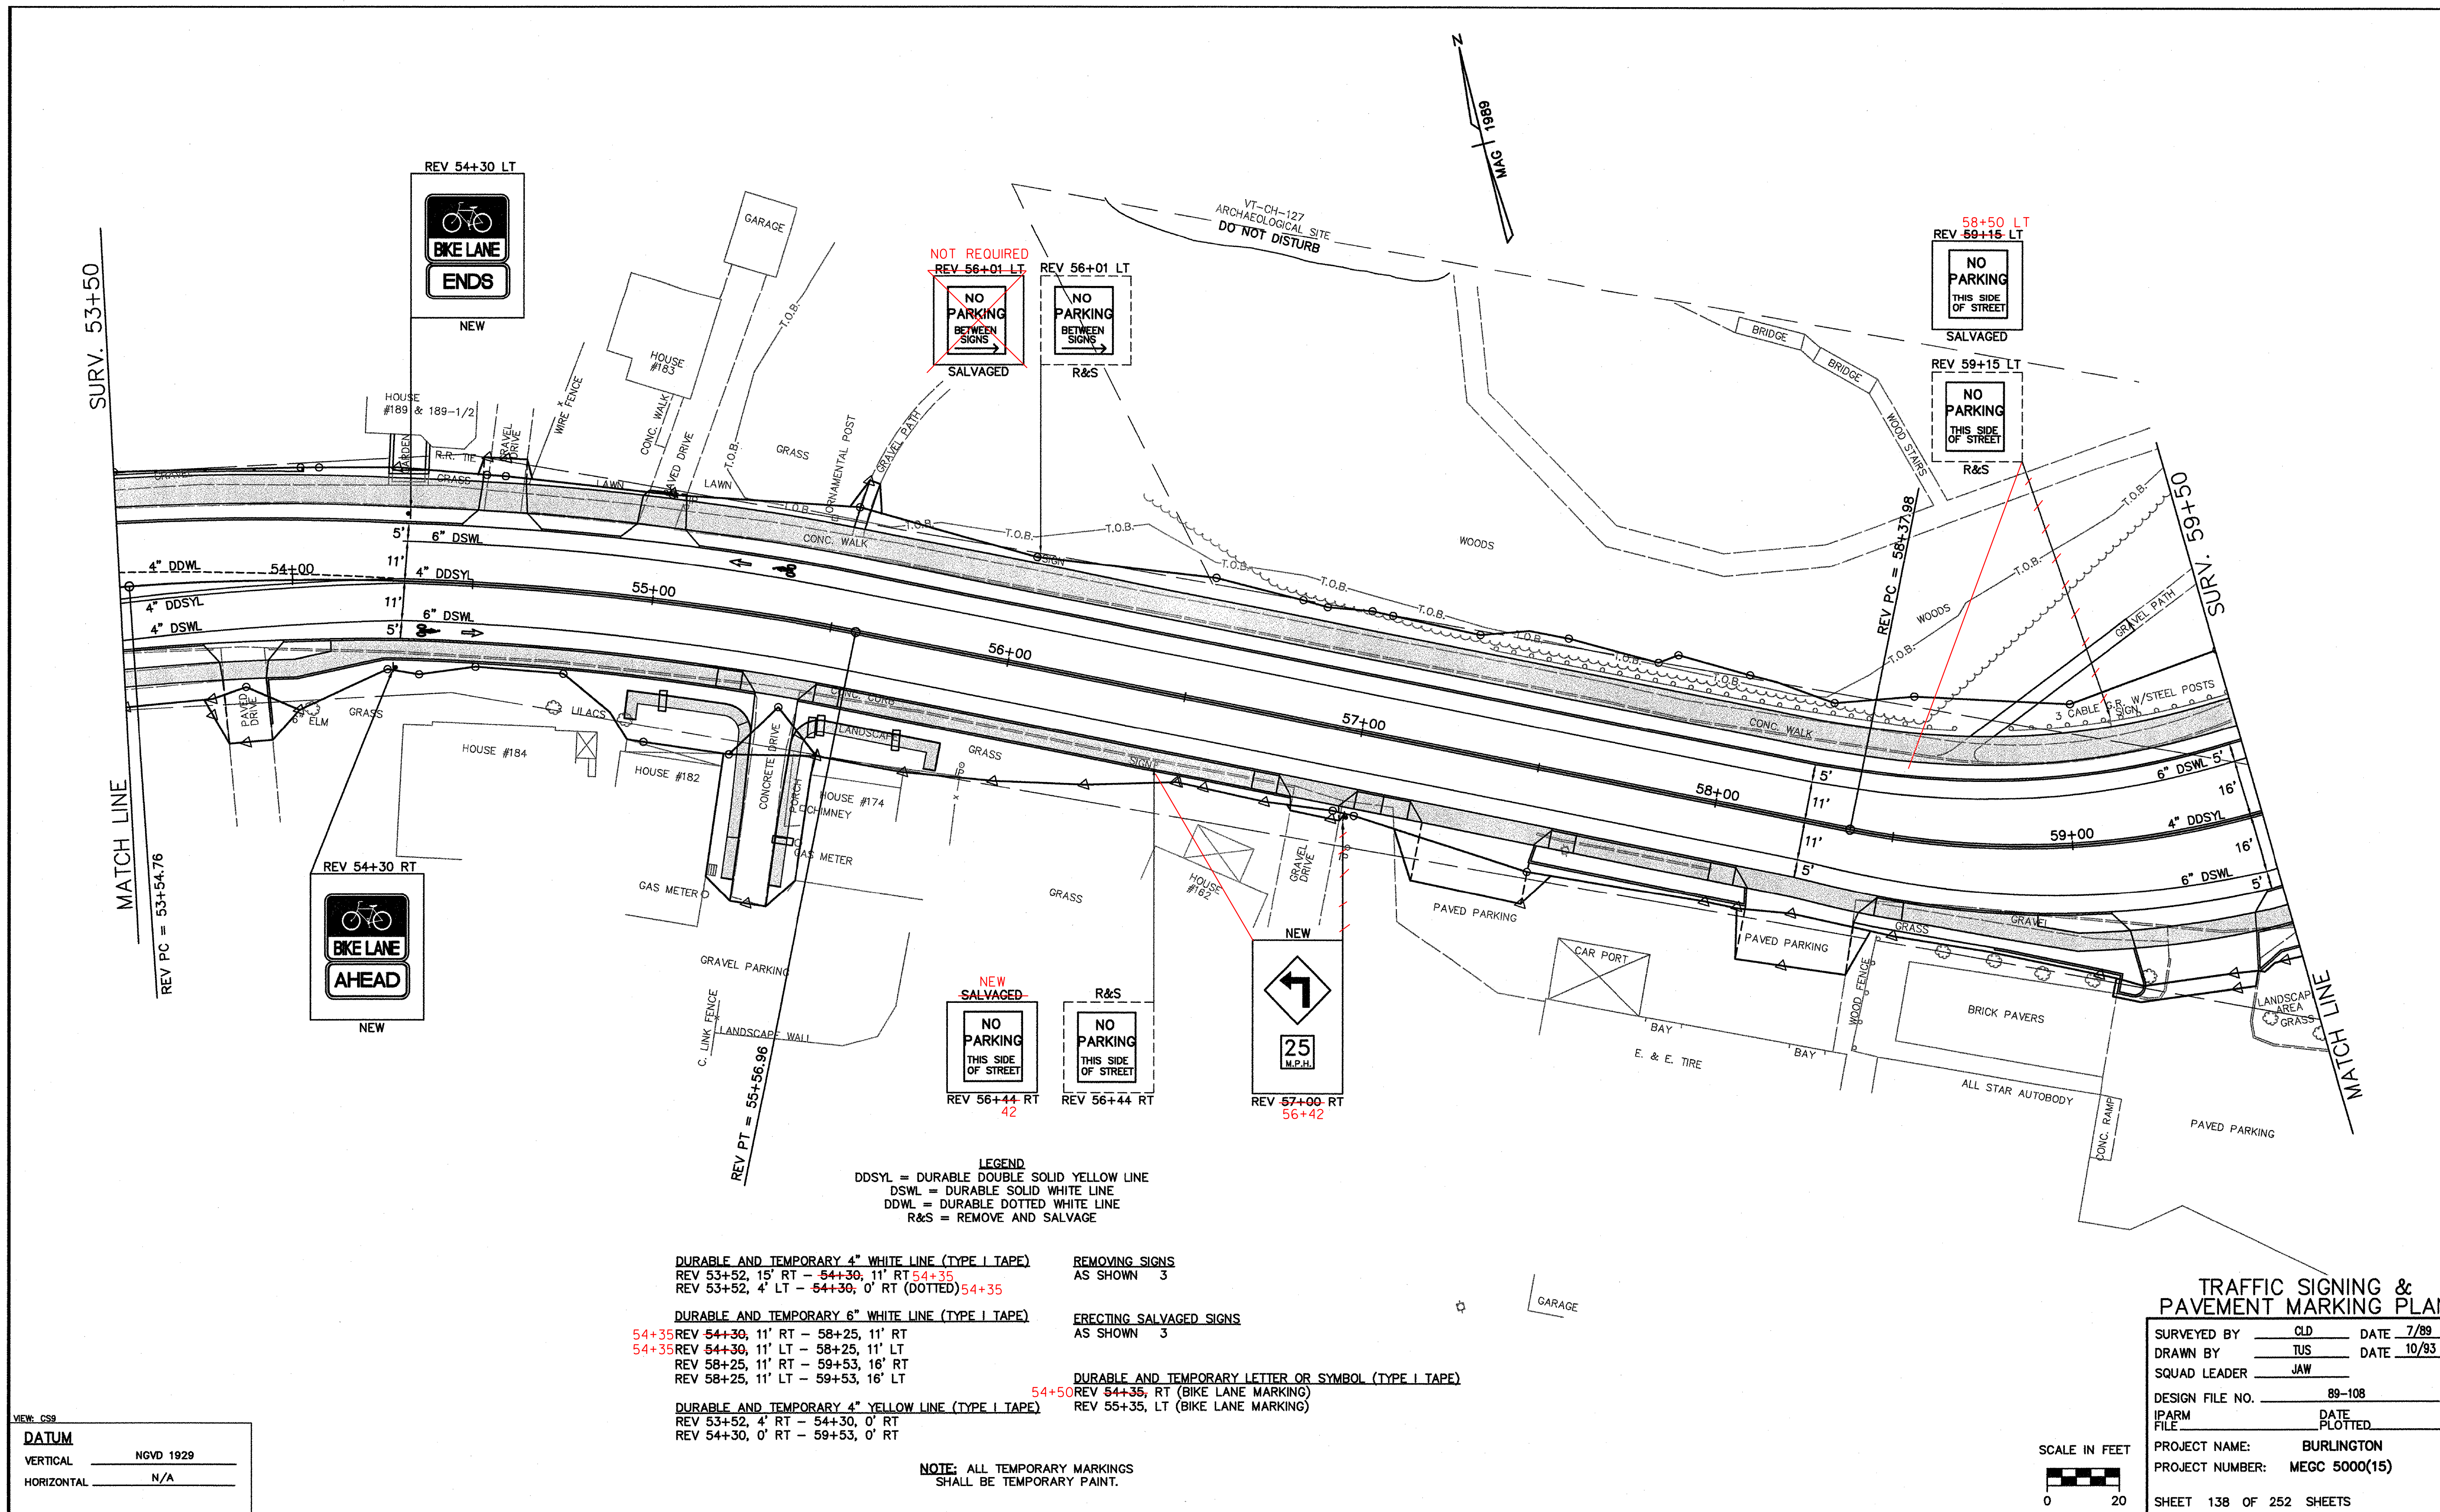

VIEW: CS9

DATUM	NGVD 1929
VERTICAL	N/A
HORIZONTAL	N/A

- DURABLE AND TEMPORARY 4" WHITE LINE (TYPE I TAPE)**

REV 53+52, 15' RT - **54+30**, 11' RT **54+35**

REV 53+52, 4' LT - **54+30**, 0' RT (DOTTED) **54+35**
- DURABLE AND TEMPORARY 6" WHITE LINE (TYPE I TAPE)**

54+35 REV **54+30**, 11' RT - 58+25, 11' RT

54+35 REV 54+30, 11' LT - 58+25, 11' LT

REV 58+25, 11' RT - 59+53, 16' RT

REV 58+25, 11' LT - 59+53, 16' LT
- DURABLE AND TEMPORARY 4" YELLOW LINE (TYPE I TAPE)**

REV 53+52, 4' RT - 54+30, 0' RT

REV 54+30, 0' RT - 59+53, 0' RT
- REMOVING SIGNS**


AS SHOWN 3
- ERECTING SALVAGED SIGNS**

AS SHOWN 3
- DURABLE AND TEMPORARY LETTER OR SYMBOL (TYPE I TAPE)**

54+50 REV **54+35**, RT (BIKE LANE MARKING)

REV 55+35, LT (BIKE LANE MARKING)

NOTE: ALL TEMPORARY MARKINGS SHALL BE TEMPORARY PAINT.

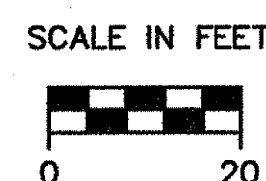

TRAFFIC SIGNING & PAVEMENT MARKING PLAN

SURVEYED BY	CLD	DATE	7/89
DRAWN BY	TUS	DATE	10/93
SQUAD LEADER	JAW		
DESIGN FILE NO.	89-108		
IPARM FILE		DATE PLOTTED	
PROJECT NAME:	BURLINGTON		
PROJECT NUMBER:	MEGC 5000(15)		
SHEET	138	OF 252 SHEETS	