


FINAL SURVEY	SURVEYED	DATE
NO	PLOTTED	BY
NO	TEMPLATE	
NO	NOTES	
NO	AREAS CHECKED	

ORIGINAL SURVEY	SURVEYED	DATE
NO	PLOTTED	BY
NO	TEMPLATE	
NO	NOTES	
NO	AREAS CHECKED	

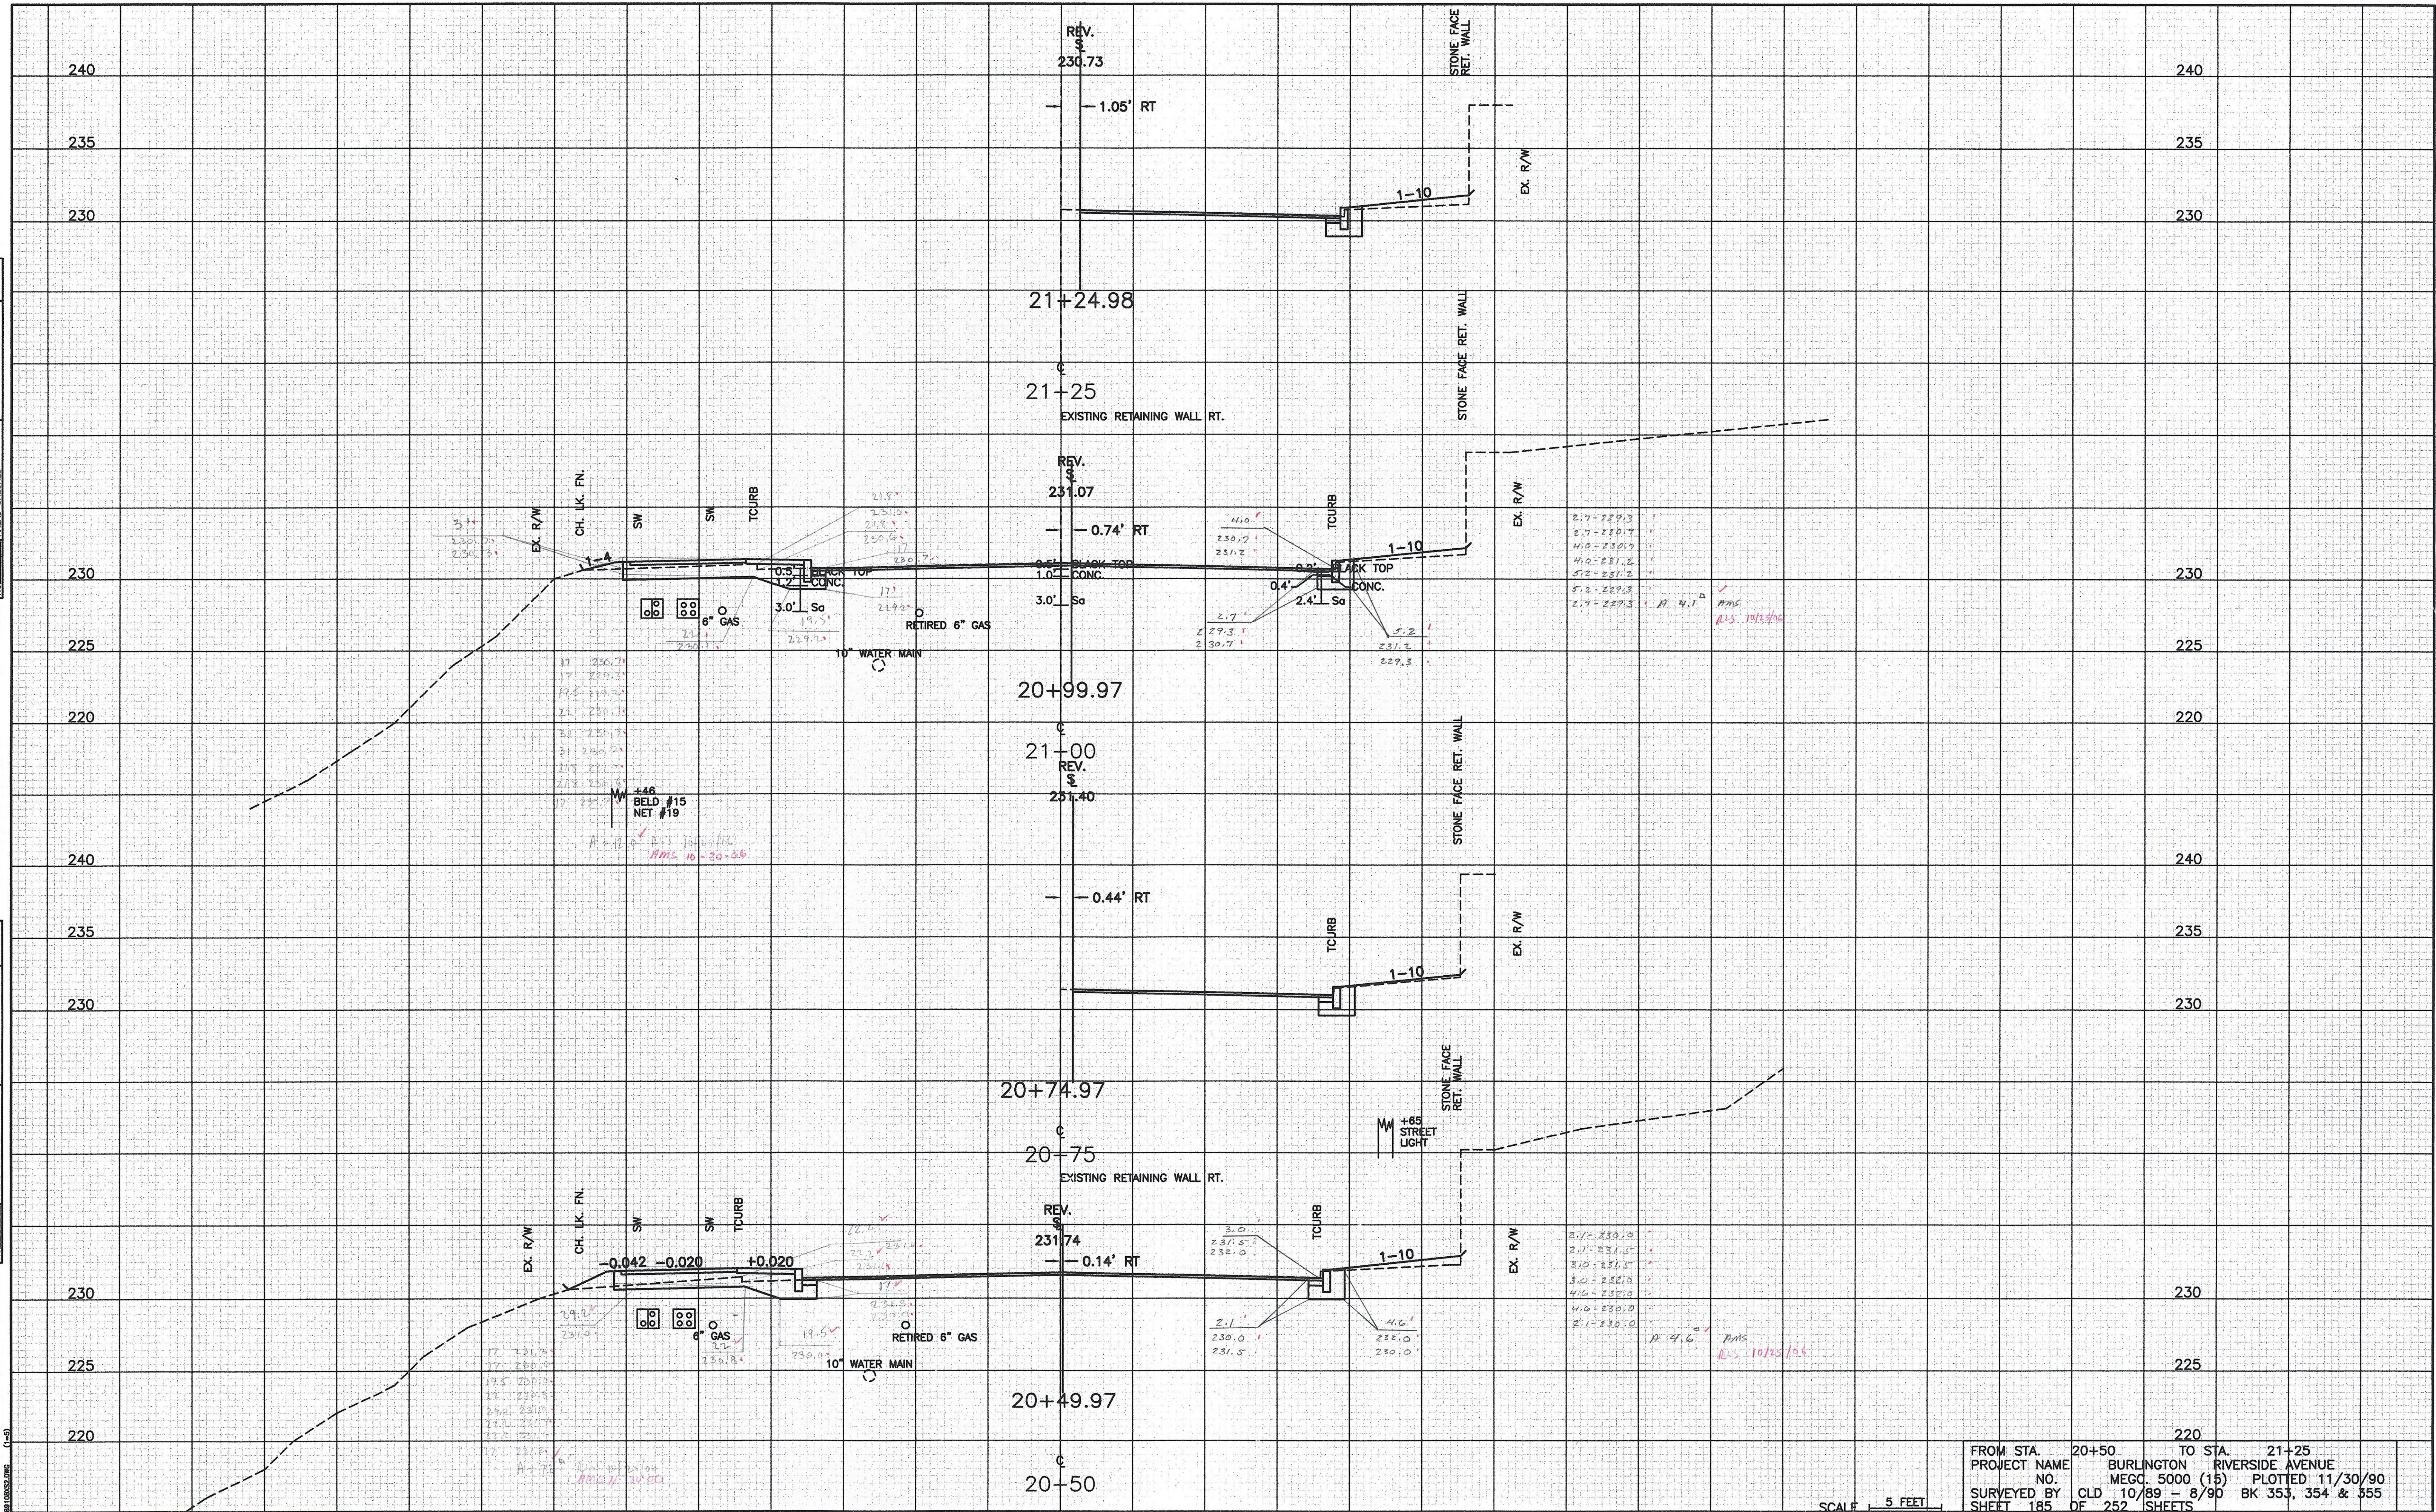

SCALE 5 FEET

FROM STA. 20+50 TO STA. 21+25
 PROJECT NAME: BURLINGTON RIVERSIDE AVENUE
 NO. 5000 (15)
 SURVEYED BY: CLD 10/89 - 8/90
 SHEET 185 OF 252 SHEETS