


14 Mc Albert

FINAL SURVEY		BY	DATE
SURVEYED			
PLOTTED			
TEMPLATE			
AREAS			
AREAS CHECKED			
NO			

ORIGINAL	BY	DATE
SURVEYED		
PLOTTED		
TEMP. PLATE		
AREAS		
AREAS		
ALIGNED		

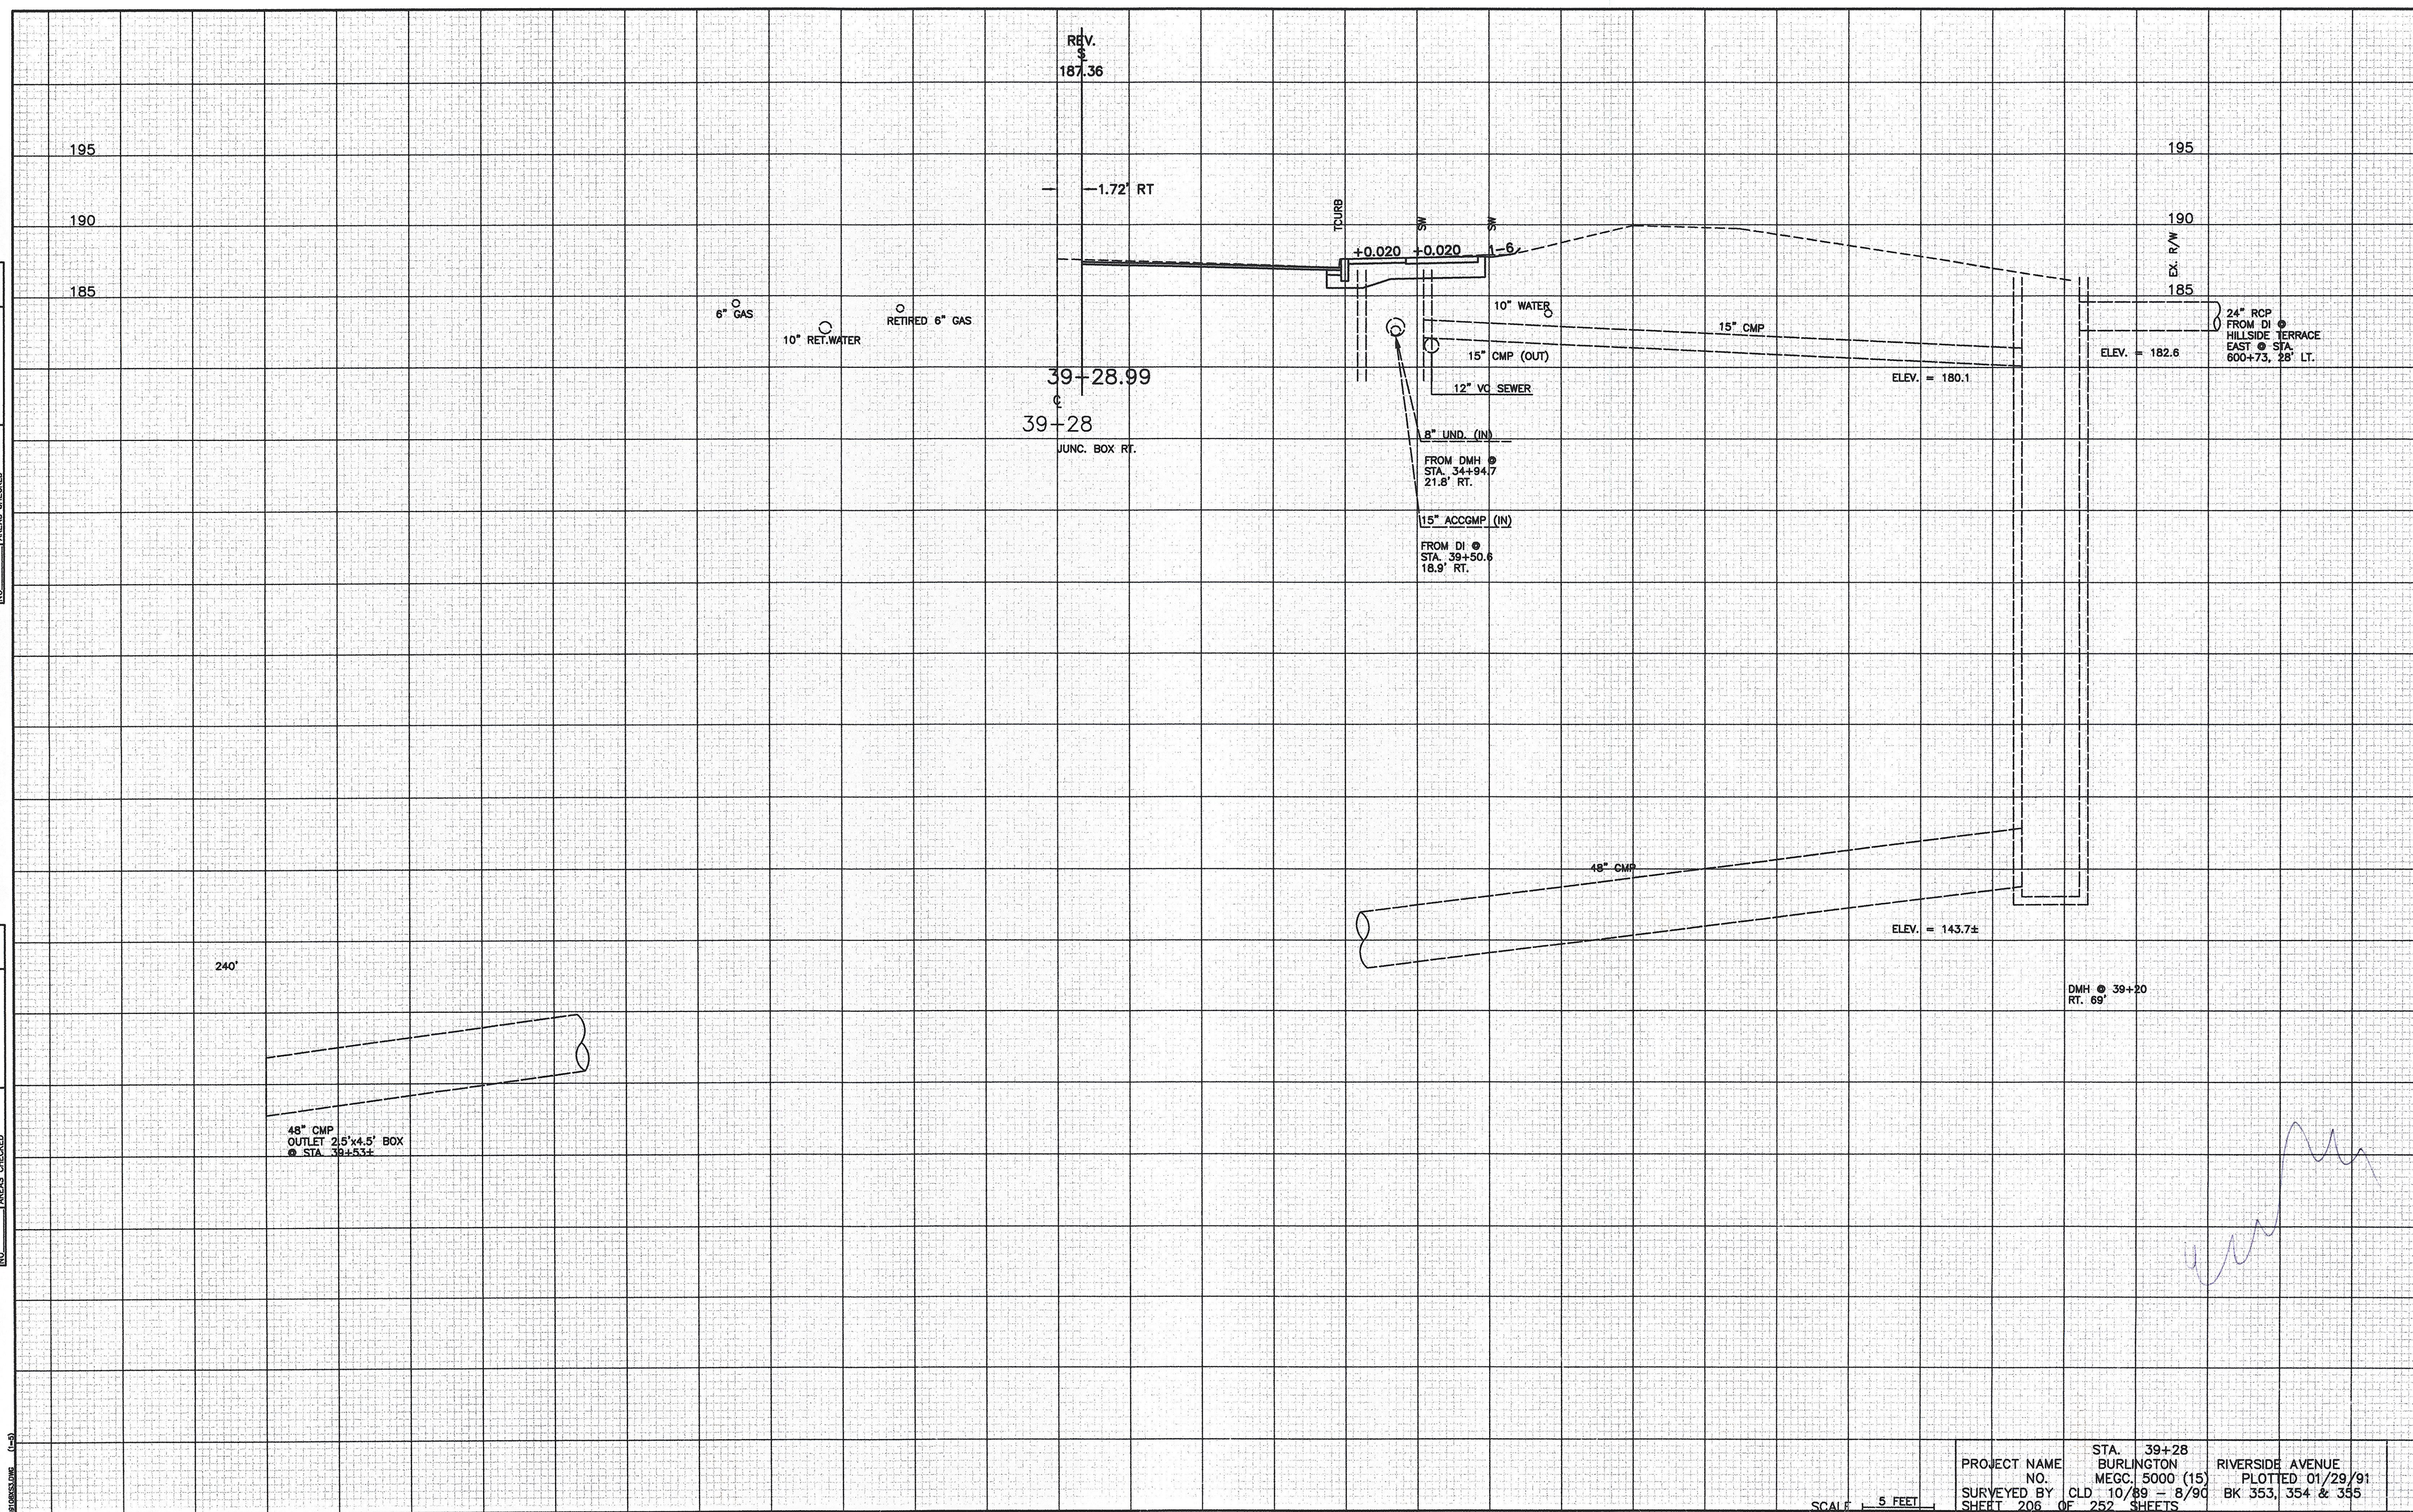

39108Y53.DWG (1-5)