


FINAL	SURVEYED	BY	DATE
SURVEY	PLOTTED		
NOTED	DATE		
NO	AREAS CHECKED		

ORIGINAL	SURVEYED	BY	DATE
SURVEY	PLOTTED		
NOTED	DATE		
NO	AREAS CHECKED		

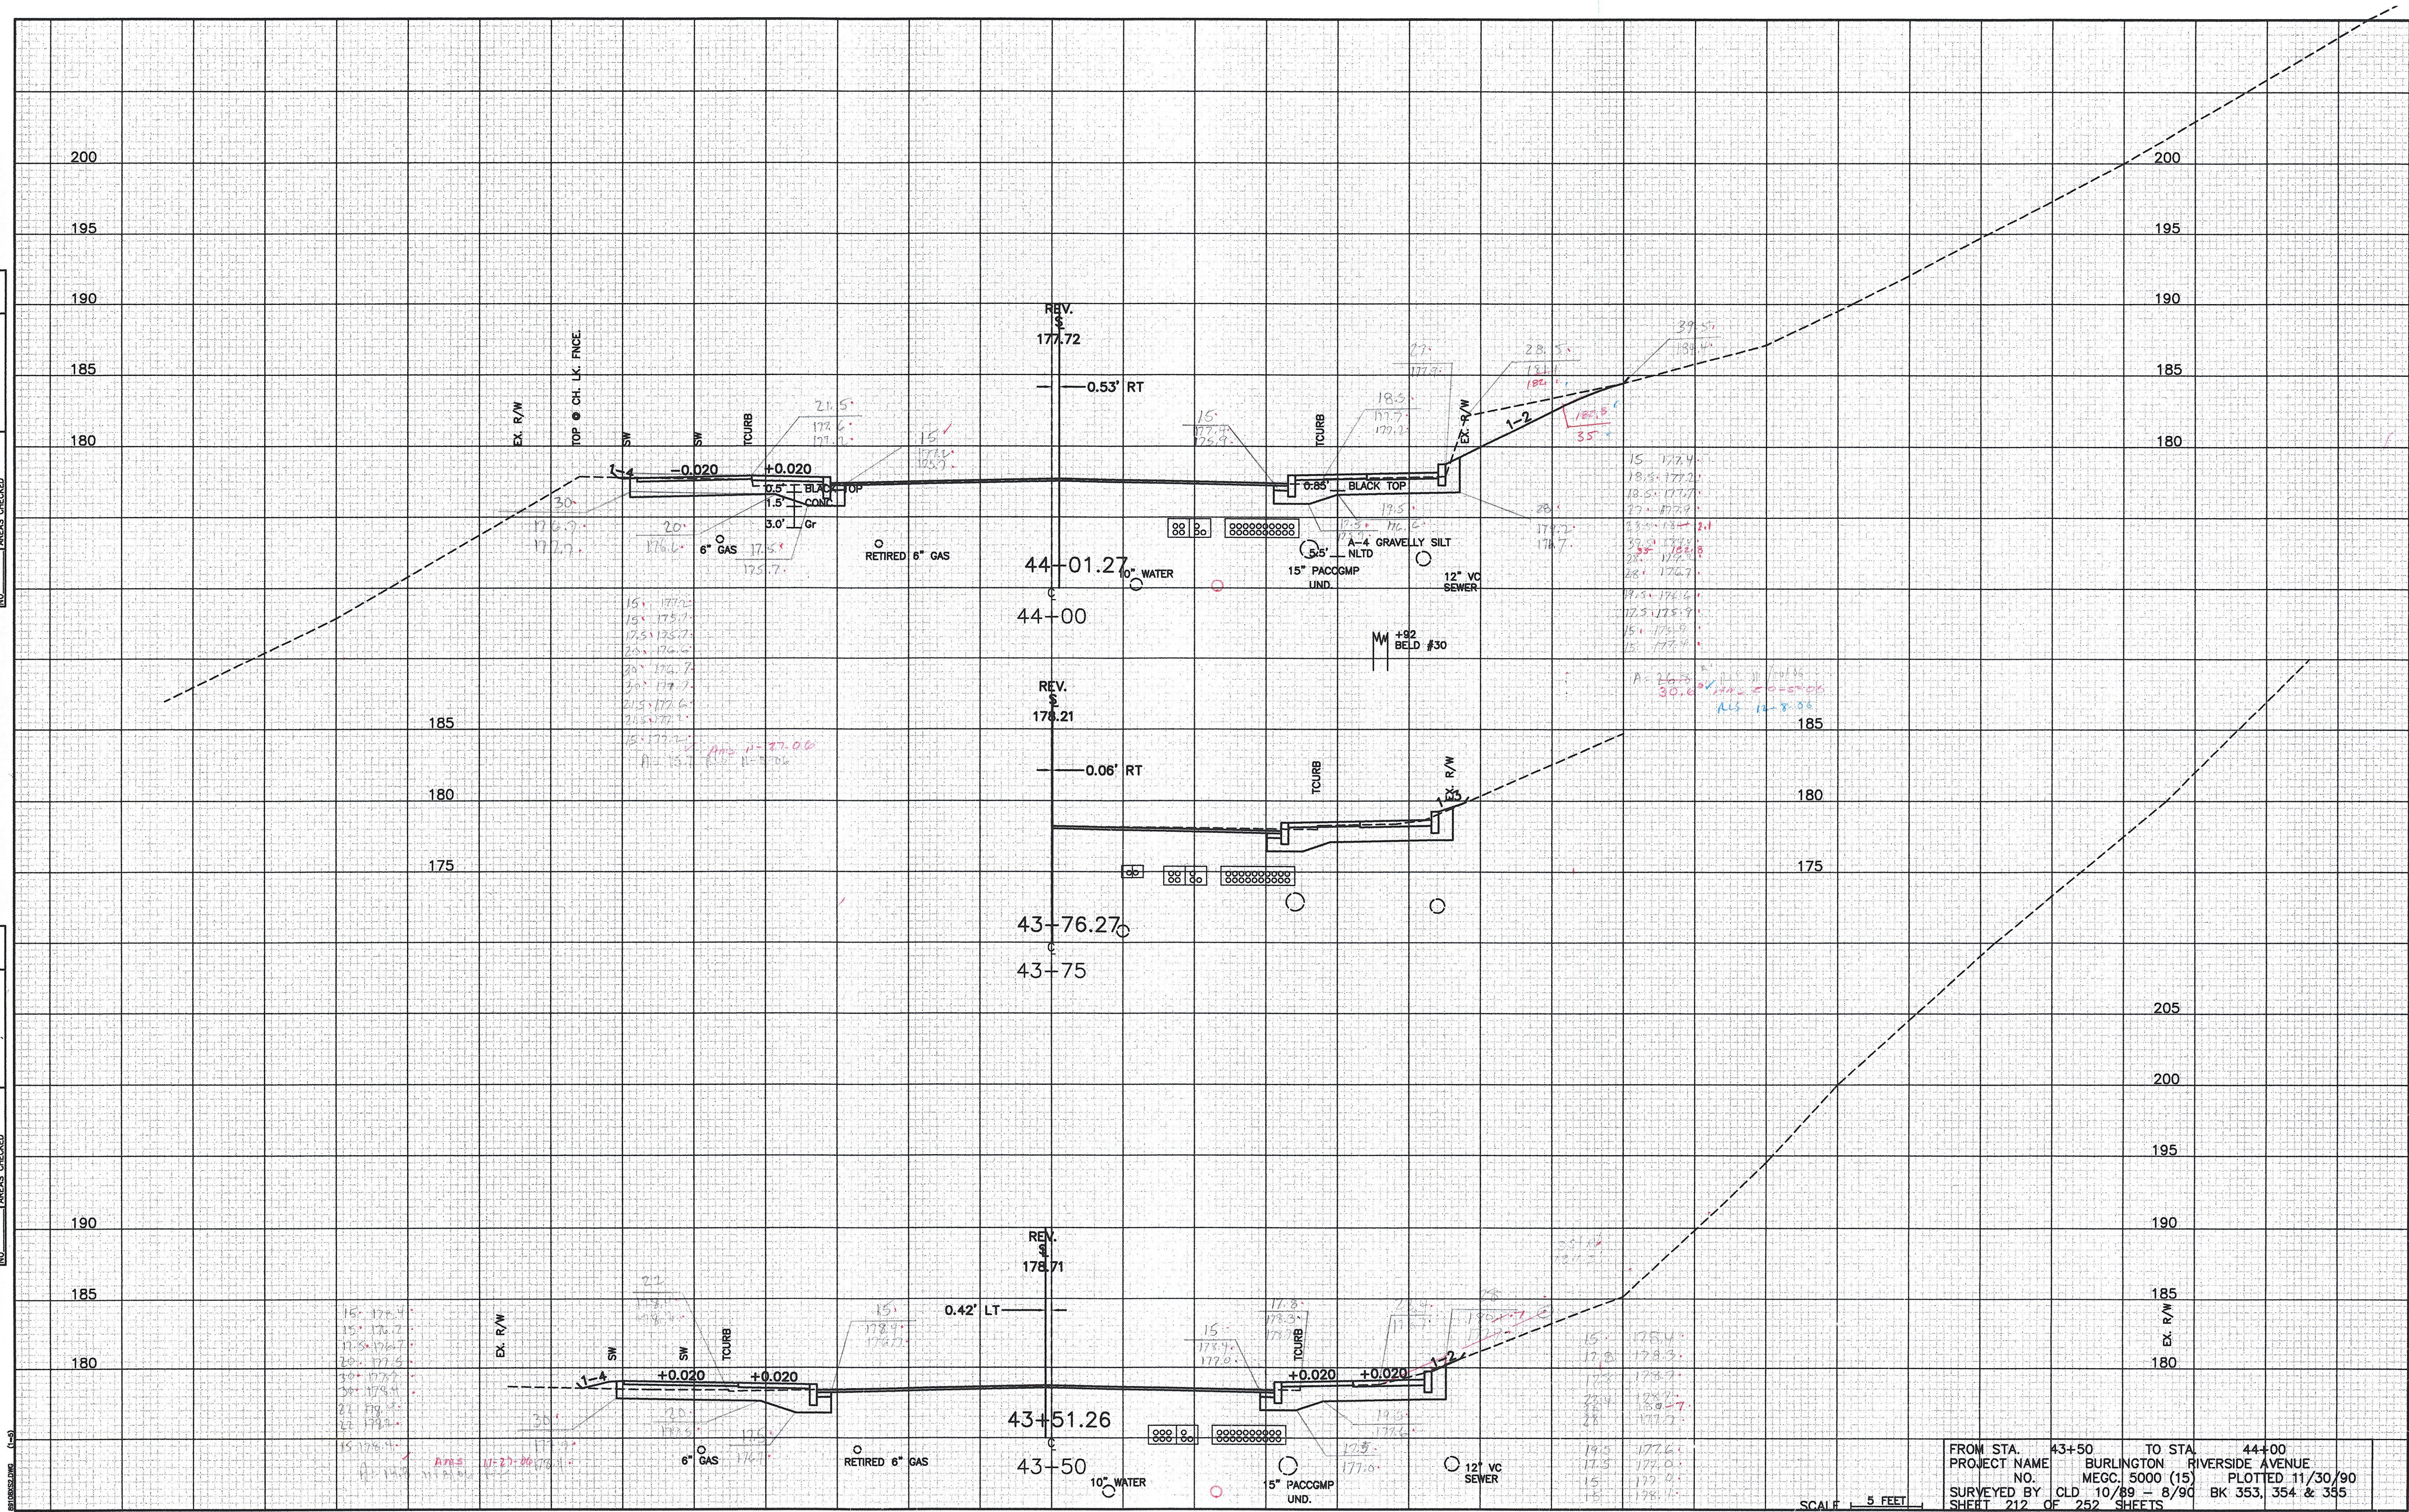

FROM STA.	43+50	TO STA.	44+00
PROJECT NAME	BURLINGTON RIVERSIDE AVENUE		
NO.	MECC. 5000 (15)		
SURVEYED BY	CLD	10/89 - 8/90	PLOTTED 11/30/90
SHEET	212	OF 252 SHEETS	BK 353, 354 & 355

SCALE 5 FEET

AMS 12-5-00
AMS 12-8-06