


FINAL	SURVEYED	DATE
SURVEY	PLOTTED	BY
NOTEBOOK	TEMPLATE	NO.
	AREAS CHECKED	

ORIGINAL	SURVEYED	DATE
SURVEY	PLOTTED	BY
NOTEBOOK	TEMPLATE	NO.
	AREAS CHECKED	

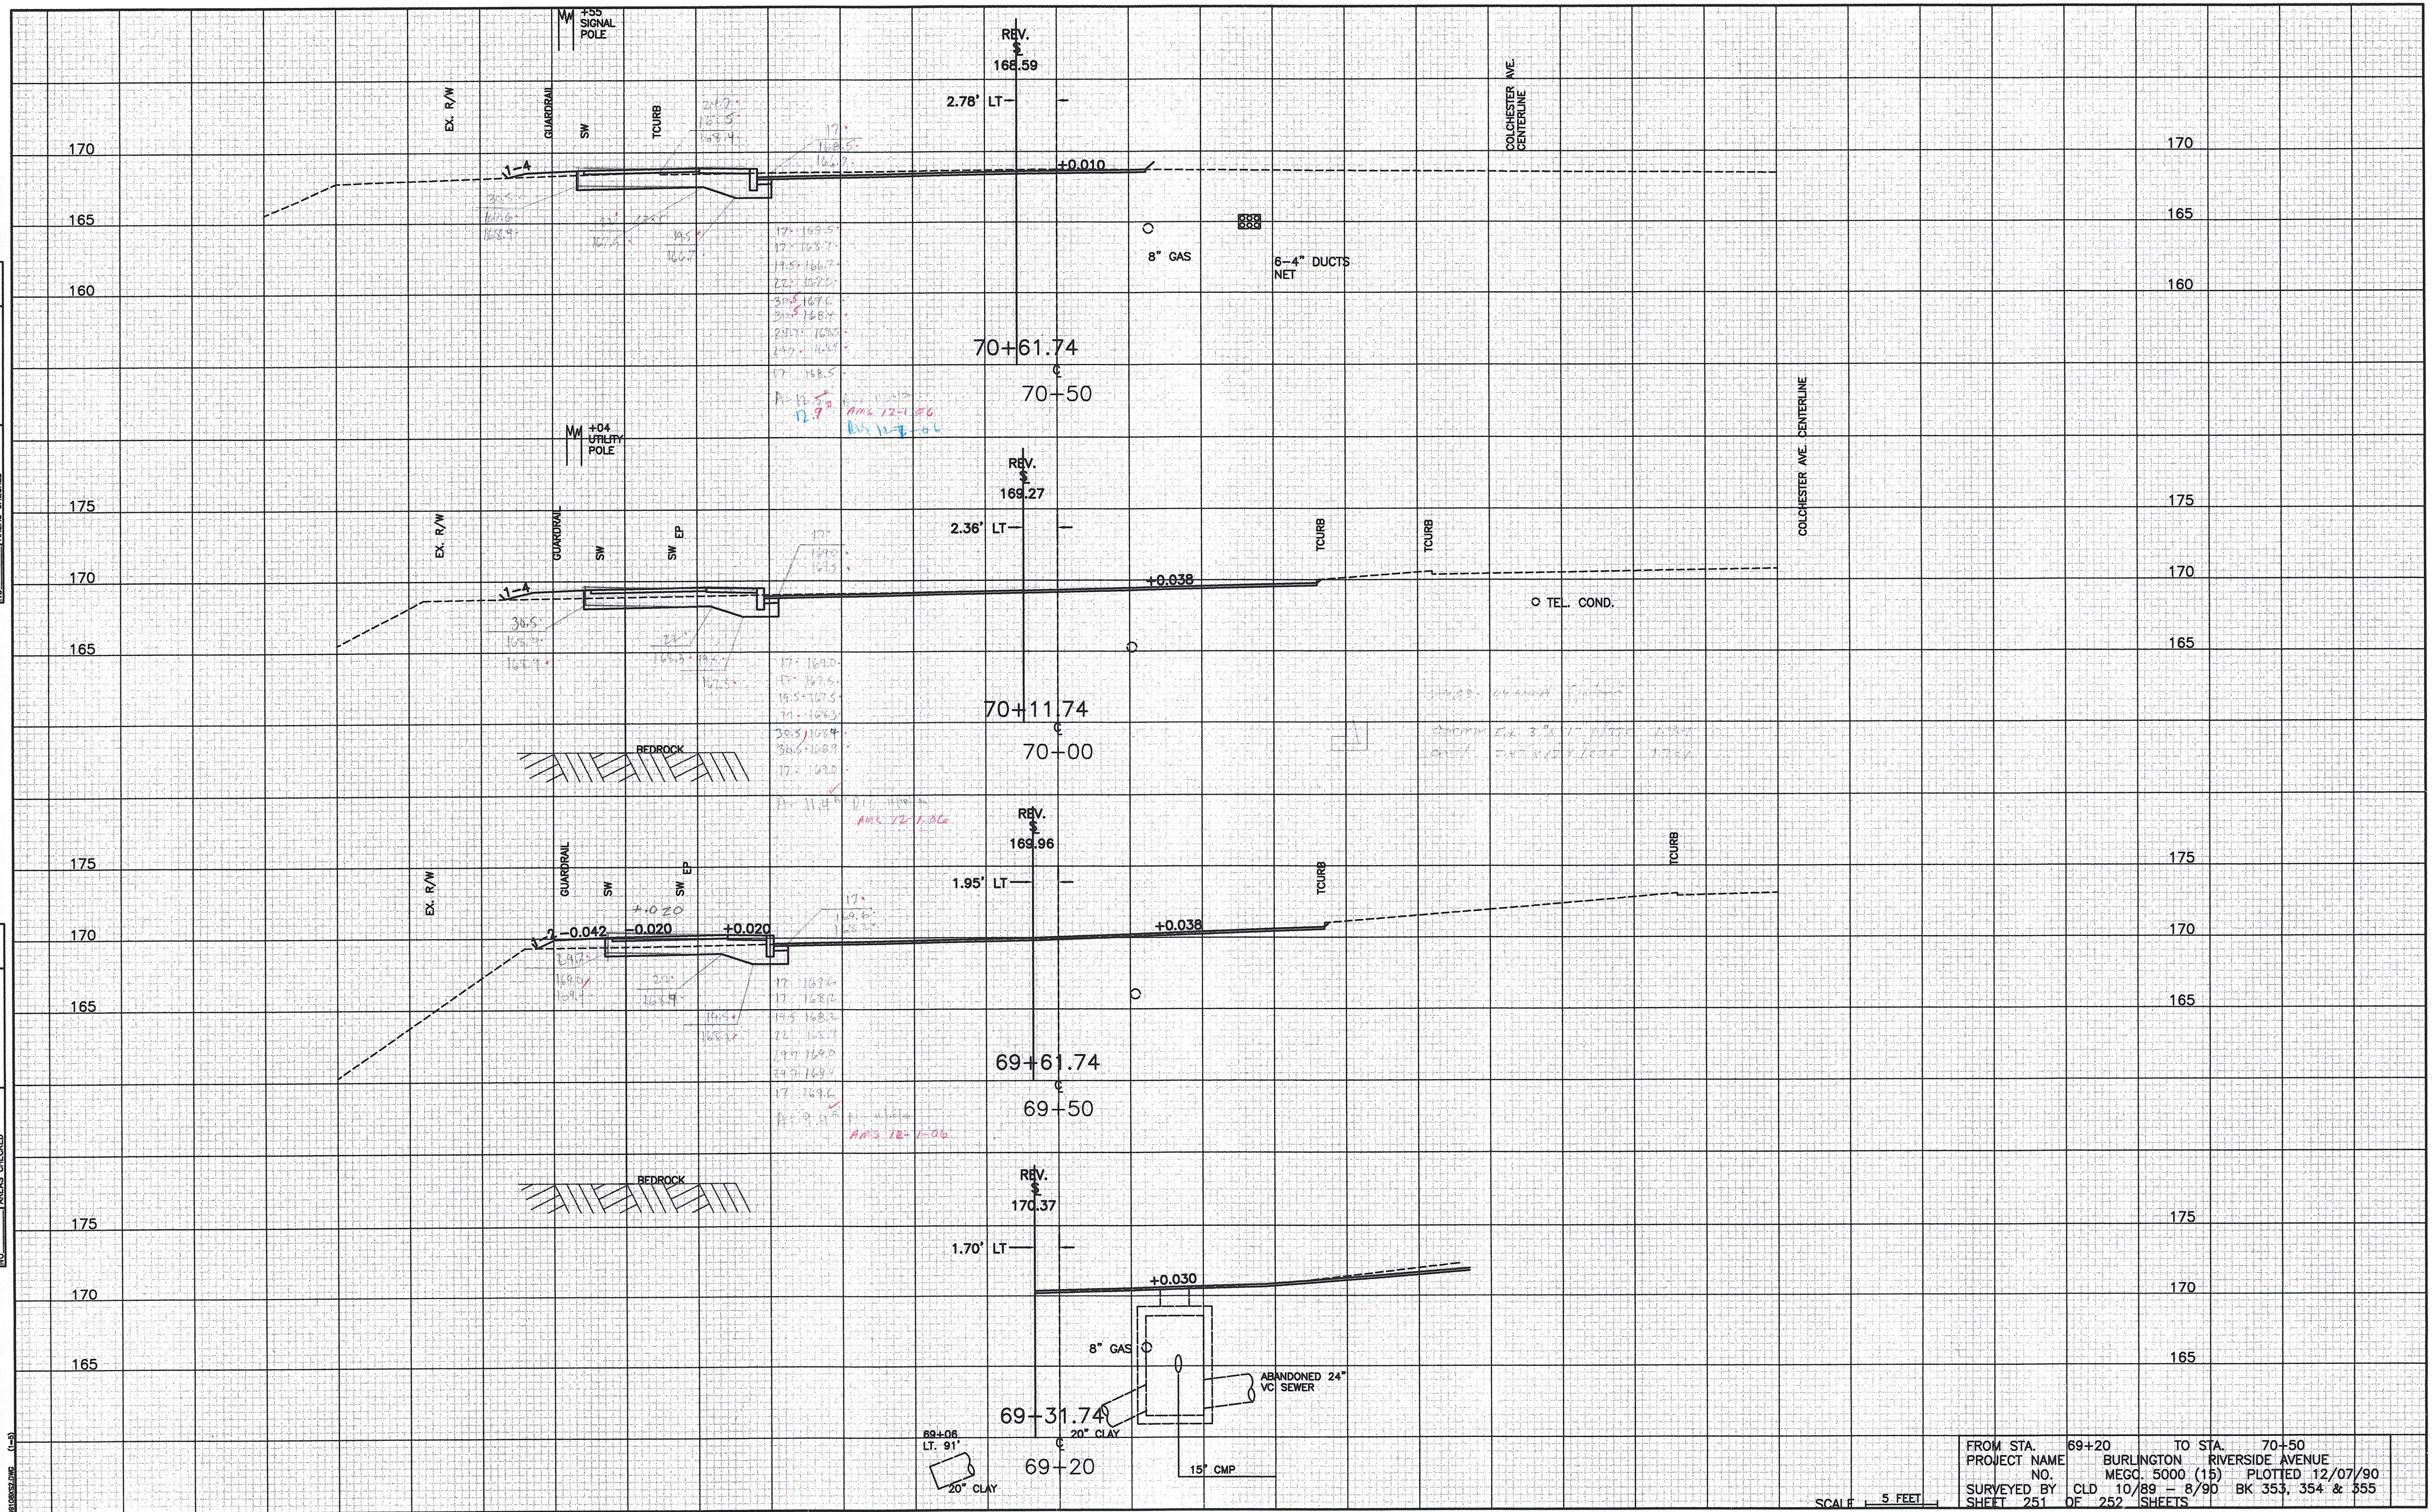

SCALE 5 FEET

FROM STA.	69+20	TO STA.	70+50
PROJECT NAME	BURLINGTON	PROJECT NAME	RIVERSIDE AVENUE
NO.	MEGG. 5000 (15)	NO.	MEGG. 5000 (15)
SURVEYED BY	CLD	SURVEYED BY	CLD
SHEET 251	OF 252	SHEET 251	OF 252