

INDEX OF SHEETS

1. TITLE SHEET
2. QUANTITY SHEET
- 3-12. GRANVILLE HMA 2860
- 13-22. HANCOCK-GRANVILLE HMA 2823
- 23-32. ROCHESTER-HANCOCK HMA 2828

STANDARDS

- | | | |
|----------|-----------------------------------|---------|
| 33. E-2 | APPROACH SIGNS, ROAD CONSTRUCTION | 2-3-86R |
| 34. E-6 | CONSTRUCTION SIGNS, ON PROJECT | 2-3-86R |
| 35. E-7 | DELINEATION, BARRICADES & DETOURS | 2-3-86R |
| 36. E-7A | BREAKAWAY BARRICADE DETAILS | 2-3-86R |
| 37. E-8 | APPROACH SIGNS, MAJOR MAINTENANCE | 2-3-86R |
| 38. E-10 | APPROACH SIGNS, MINOR MAINTENANCE | 2-3-86R |

STATE OF VERMONT AGENCY OF TRANSPORTATION




PROPOSED IMPROVEMENT TOWNS OF GRANVILLE, HANCOCK & ROCHESTER

RESURFACING PROJECTS

WORK PERFORMED UNDER THIS PROJECT SHALL CONSIST OF RESURFACING THE HIGHWAY, INCLUDING SHOULDERS AND NEW PAVEMENT MARKINGS.

CONTRACT PLANS

THESE PLANS DO NOT REFLECT
CHANGES MADE ON THE PROJECT.

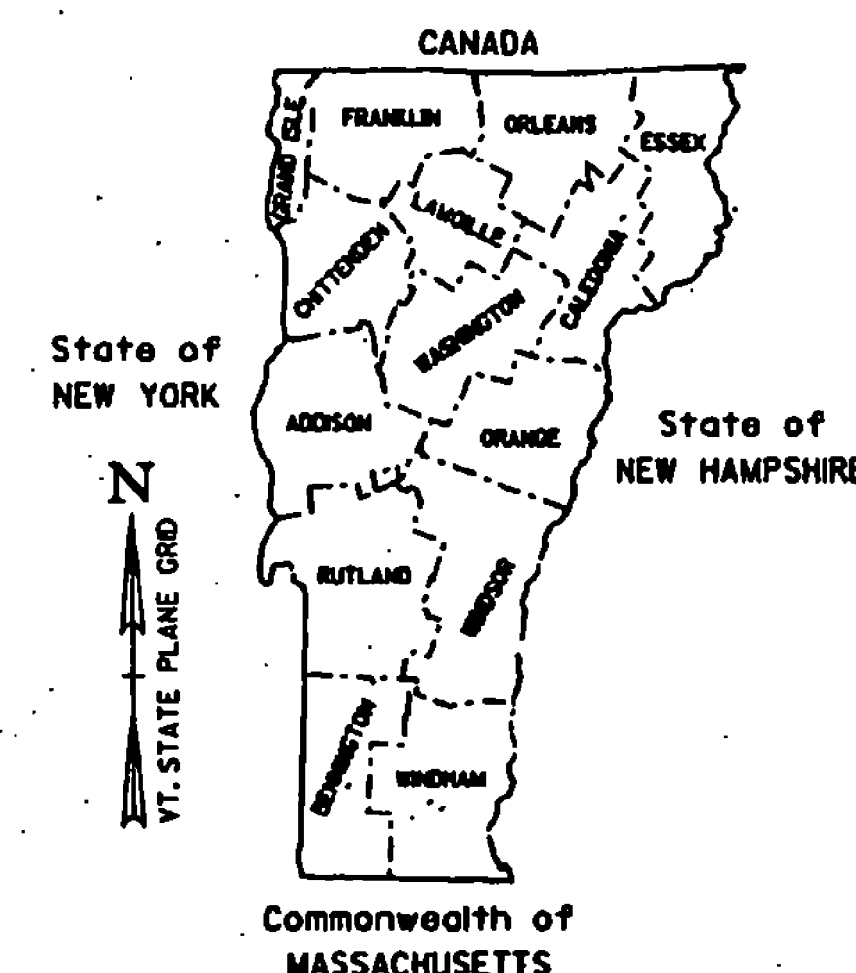


Date SEP 10 1987

PIKE INDUSTRIES INC.
Contractor

Don D. Marts
Signature

VICE PRESIDENT
Title

Arthur G. Hull
ACTING Transportation Secretary's Signature

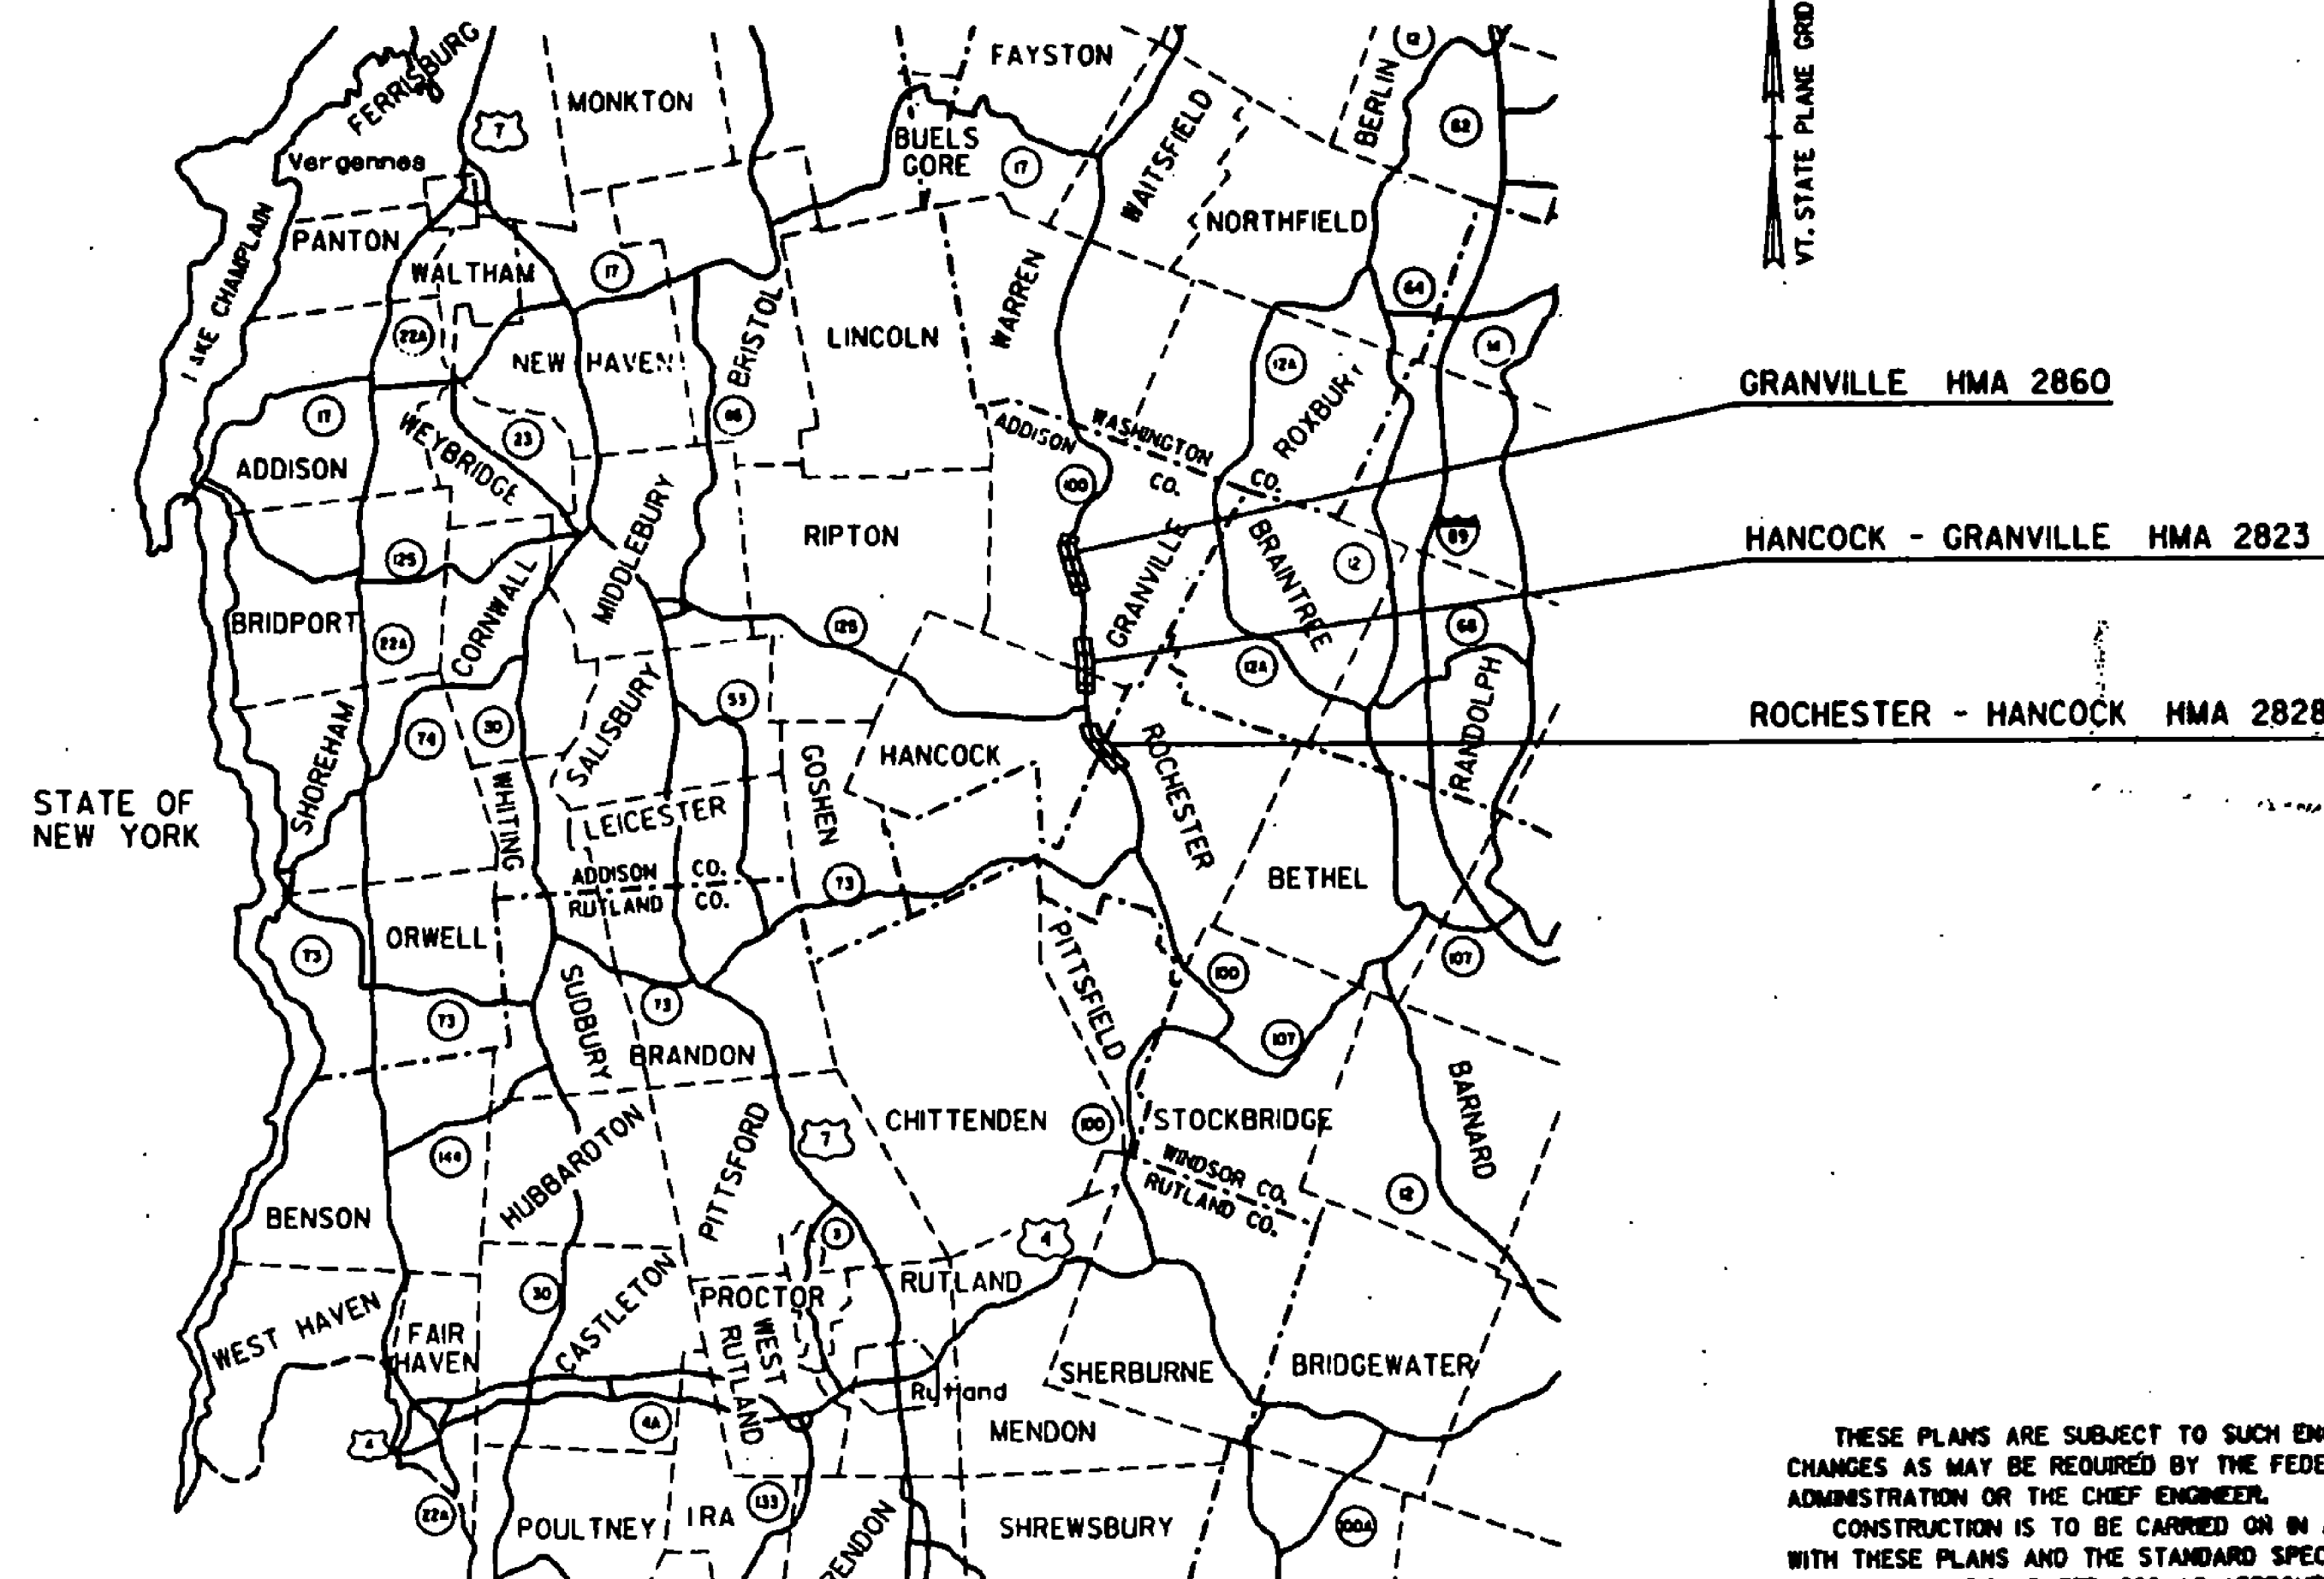


PROJECT	NUMBER	ROUTE	LOCATION	LENGTH
GRANVILLE	HMA 2860	VT. 100	MM 0.570 TO MM 2.971	2.401 MILES
HANCOCK-GRANVILLE	HMA 2823	VT. 100	MM 1.320 TO MM 2.511 MM 0.000 TO MM 0.110	1.300 MILES
ROCHESTER-HANCOCK	HMA 2828	VT. 100	MM 7.273 TO MM 8.353 MM 0.000 TO MM 0.650	1.730 MILES
TOTALS				5.431 MILES

THESE PLANS ARE SUBJECT TO SUCH ENGINEERING CHANGES AS MAY BE REQUIRED BY THE FEDERAL HIGHWAY ADMINISTRATION OR THE CHIEF ENGINEER.
CONSTRUCTION IS TO BE CARRIED ON IN ACCORDANCE WITH THESE PLANS AND THE STANDARD SPECIFICATIONS FOR CONSTRUCTION DATED 1986, AS APPROVED BY THE FEDERAL HIGHWAY ADMINISTRATION ON NOVEMBER 21, 1985 FOR USE ON THIS PROJECT, INCLUDING ALL SUBSEQUENT REVISIONS AND SUCH REVISED SPECIFICATIONS AND SPECIAL PROVISIONS AS ARE INCORPORATED IN THESE PLANS.

SUBMITTED BY ORDER OF THE STATE TRANSPORTATION BOARD	
APPROVED <u>David B. Kelly</u>	DATE <u>7/1/87</u>
CHIEF ENGINEER	
DEPARTMENT OF TRANSPORTATION FEDERAL HIGHWAY ADMINISTRATION	
APPROVED _____	DATE _____
DIVISION ADMINISTRATOR	
PROJECT <u>RESURFACING PROJECTS</u>	
SHEET <u>1 OF 38</u> SHEETS	

STATE OF VERMONT
AGENCY OF TRANSPORTATION

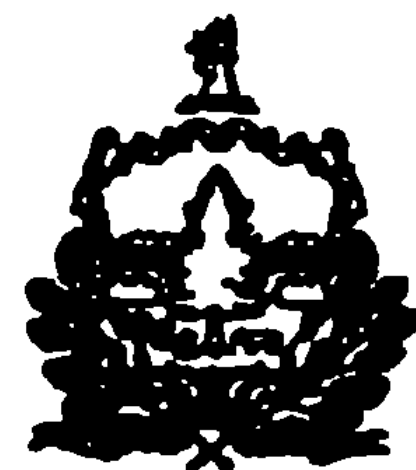


PROPOSED IMPROVEMENT

TOWN OF Granville


COUNTY OF Addison

ROUTE NO. VT 100

ROUTE CLASS FAP

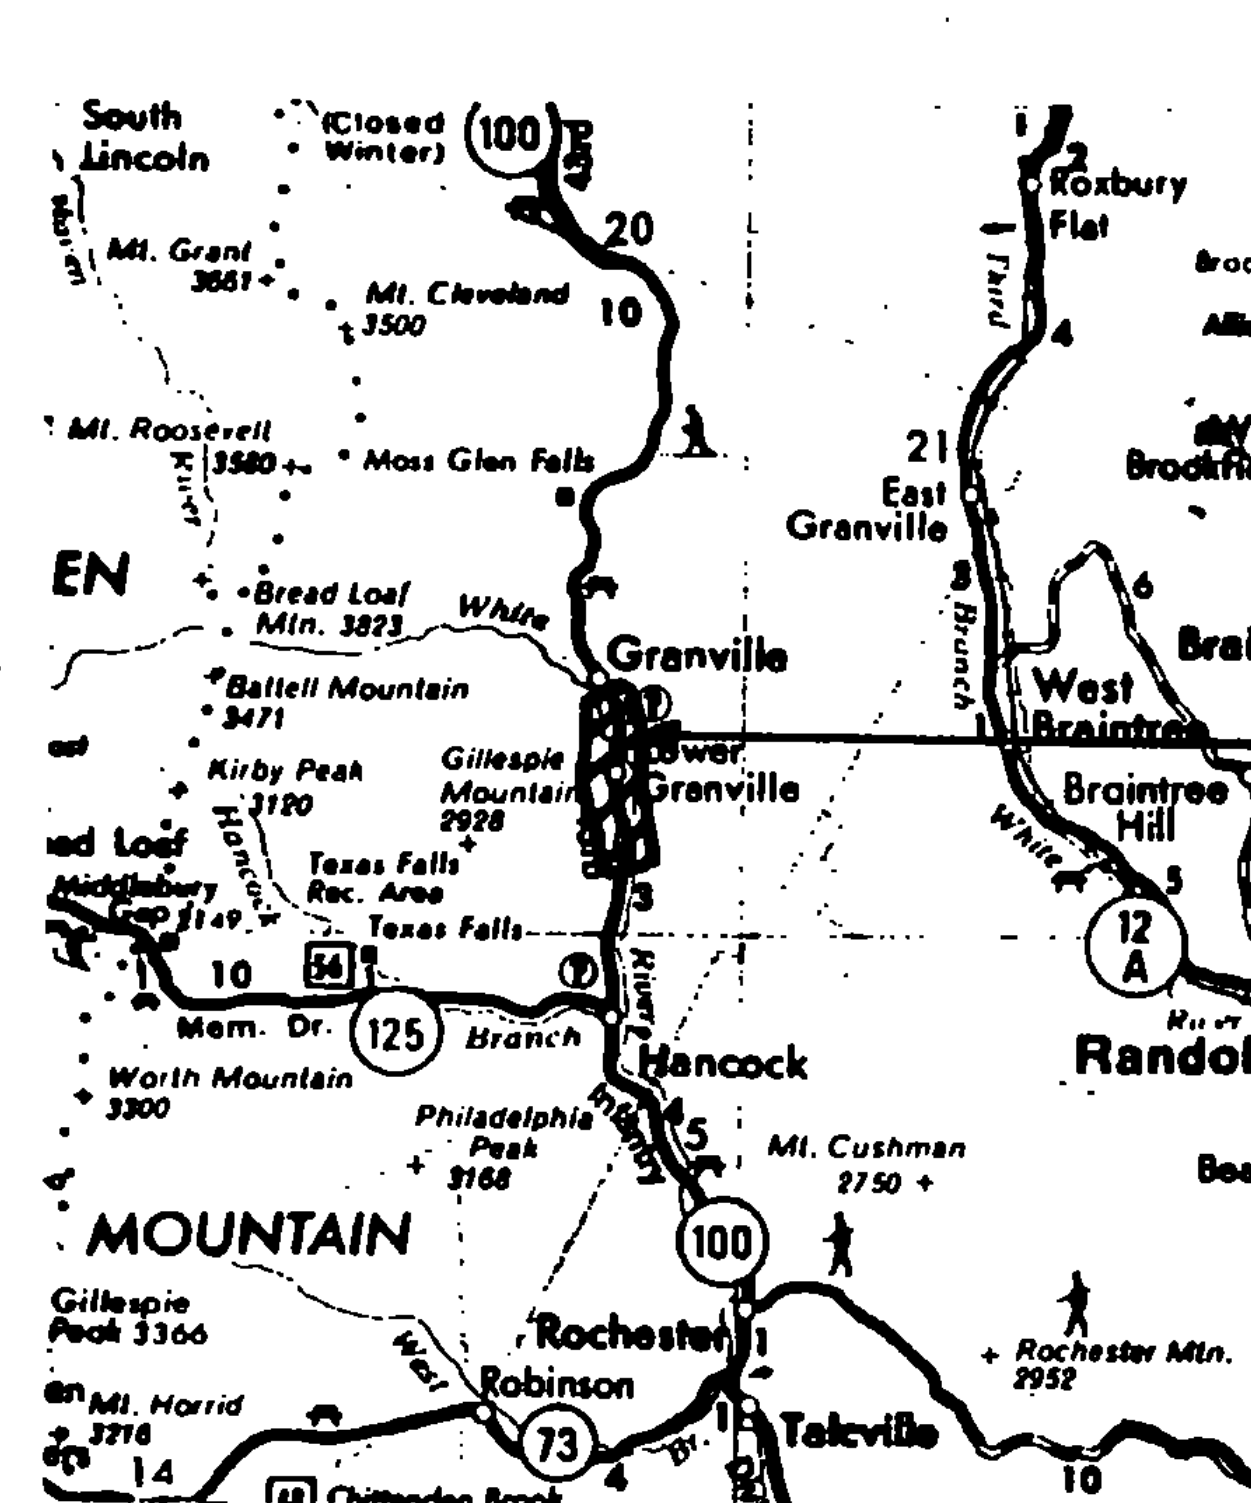

PROJECT
HMA 2860

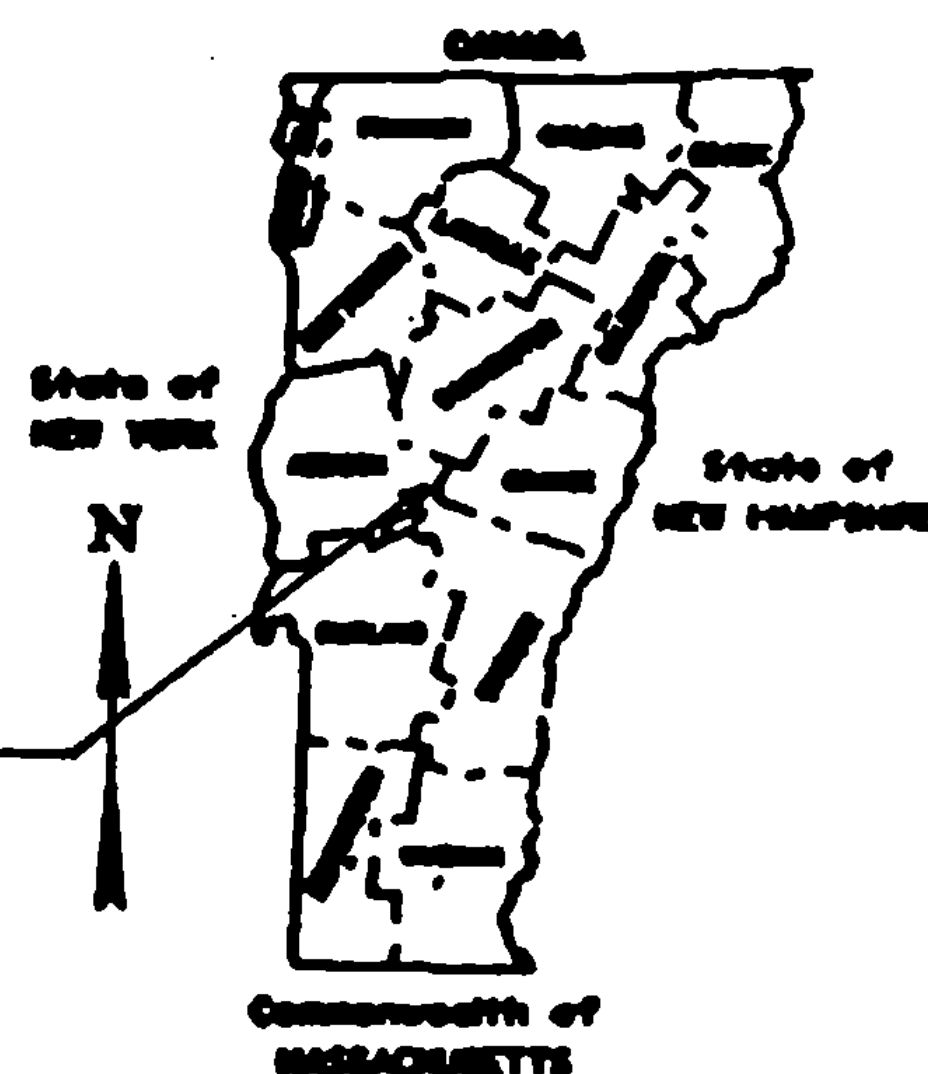

THESE PLANS ARE SUBJECT TO SUCH ENGINEERING CHANGES AS MAY BE REQUIRED BY THE FEDERAL HIGHWAY ADMINISTRATION OR THE CHIEF ENGINEER. CONSTRUCTION IS TO BE CARRIED ON IN ACCORDANCE WITH THESE PLANS AND THE STANDARD SPECIFICATIONS FOR CONSTRUCTION DATED 1966, AS APPROVED BY THE FEDERAL HIGHWAY ADMINISTRATION ON NOVEMBER 8, 1966 FOR USE ON THIS PROJECT, INCLUDING ALL SUBSEQUENT REVISIONS AND SUCH REVISED SPECIFICATIONS AND SPECIAL PROVISIONS AS ARE INCORPORATED IN THESE PLANS.

SUBMITTED BY ORDER OF THE STATE TRANSPORTATION BOARD

APPROVED _____ DATE _____
CHIEF ENGINEER

DEPARTMENT OF TRANSPORTATION
FEDERAL HIGHWAY ADMINISTRATION

APPROVED _____ DATE _____
DIVISION ADMINISTRATOR

Granville
PROJECT HMA 2860

SHEET 10 OF 10 SHEETS

See Sheet 1 For Index

SHEET 3 OF 38 SHEETS

INDEX . OF SHEETS

1. Title Page
2. Index Of Sheets
3. Description And Location
4. Typical Sections And Design Data
5. Paving Limits For Drives And Town Roads
6. Pavement Marking Locations
7. Guidelines For Minimum Interim Pavement Markings In Construction Zones
8. Mainline Pavement Marking At Intersecting Side Road
- 9-10 Project Lengths And Item Quantities


PROJECT Granville

NO. HMA 2860

SHEET 20F10SHEETS

SHEET 4 OF 38 SHEETS

DESCRIPTION AND LOCATION

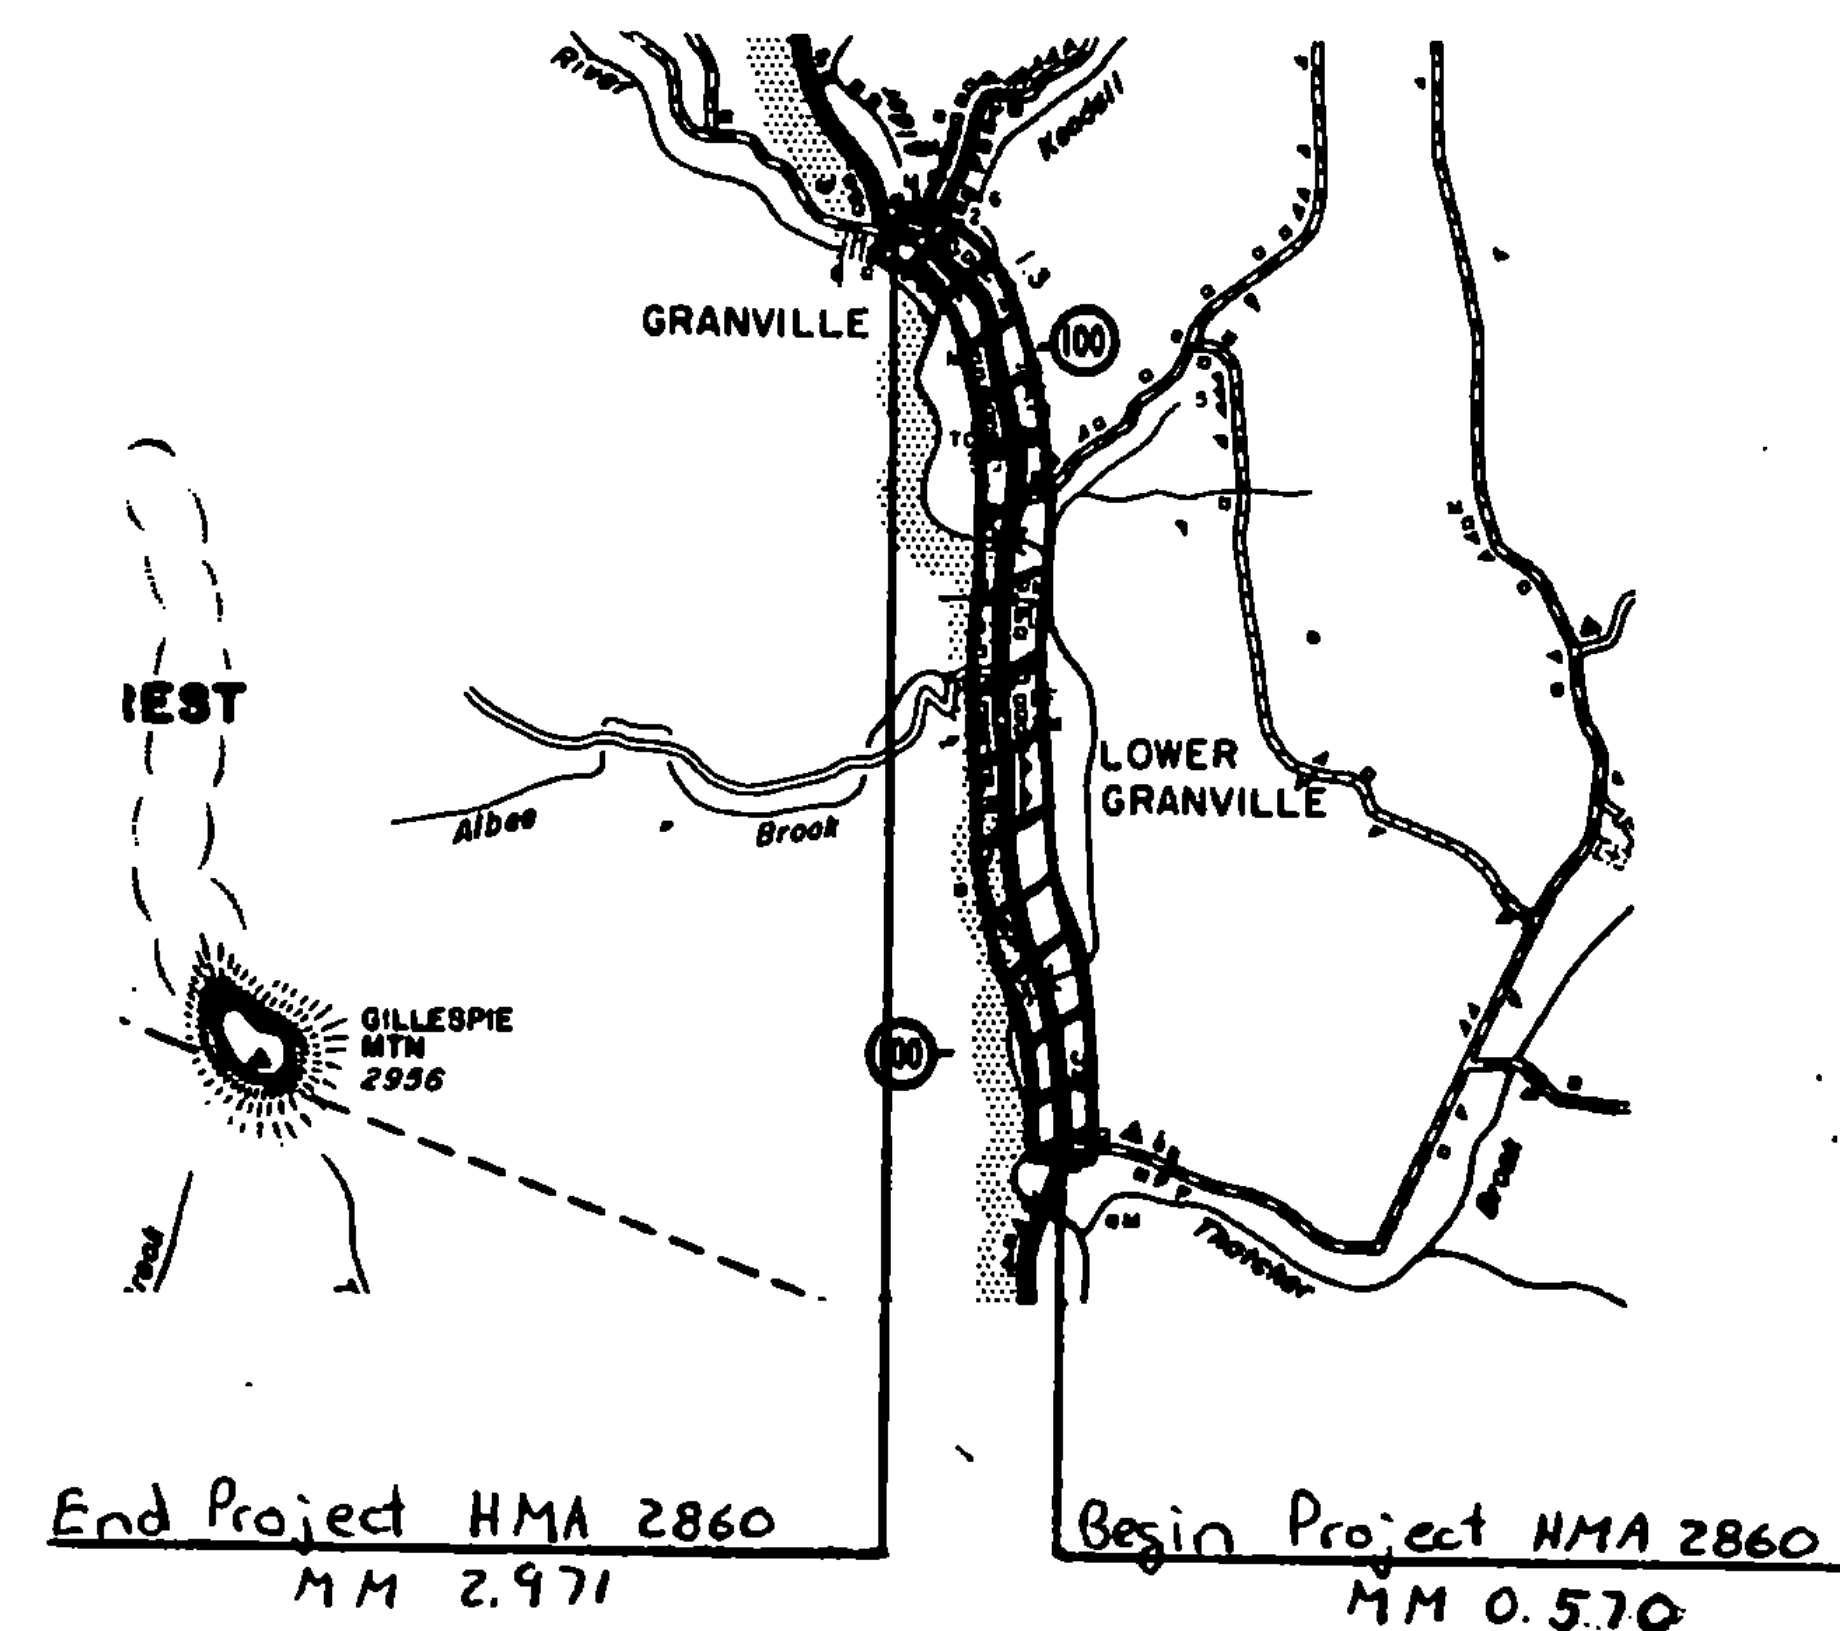

Scale: 1" = 1 mile

Beginning on UT 100, 0.570 miles northerly of the Hancock-Granville town line and extending northerly 2.401 miles to MM 2.971

Work consists of resurfacing of the highway, including shoulders and pavement markings

1986 ADT 1410

Length of Project 2.401 miles
12677 feet

PROJECT Granville


NO. HMA 2860

SHEET 3 OF 10 SHEETS

SHEET 5 OF 38 SHEETS

TYPICAL SECTIONS & DESIGN DATA

BITUMINOUS CONCRETE PAVEMENT
LEVELING COURSE TYPE IV (414 TONS/MILE)
AS DIRECTED BY THE ENGINEER.
1 1/4" WEARING COURSE TYPE III (±1/4" THICKNESS TOLERANCE)

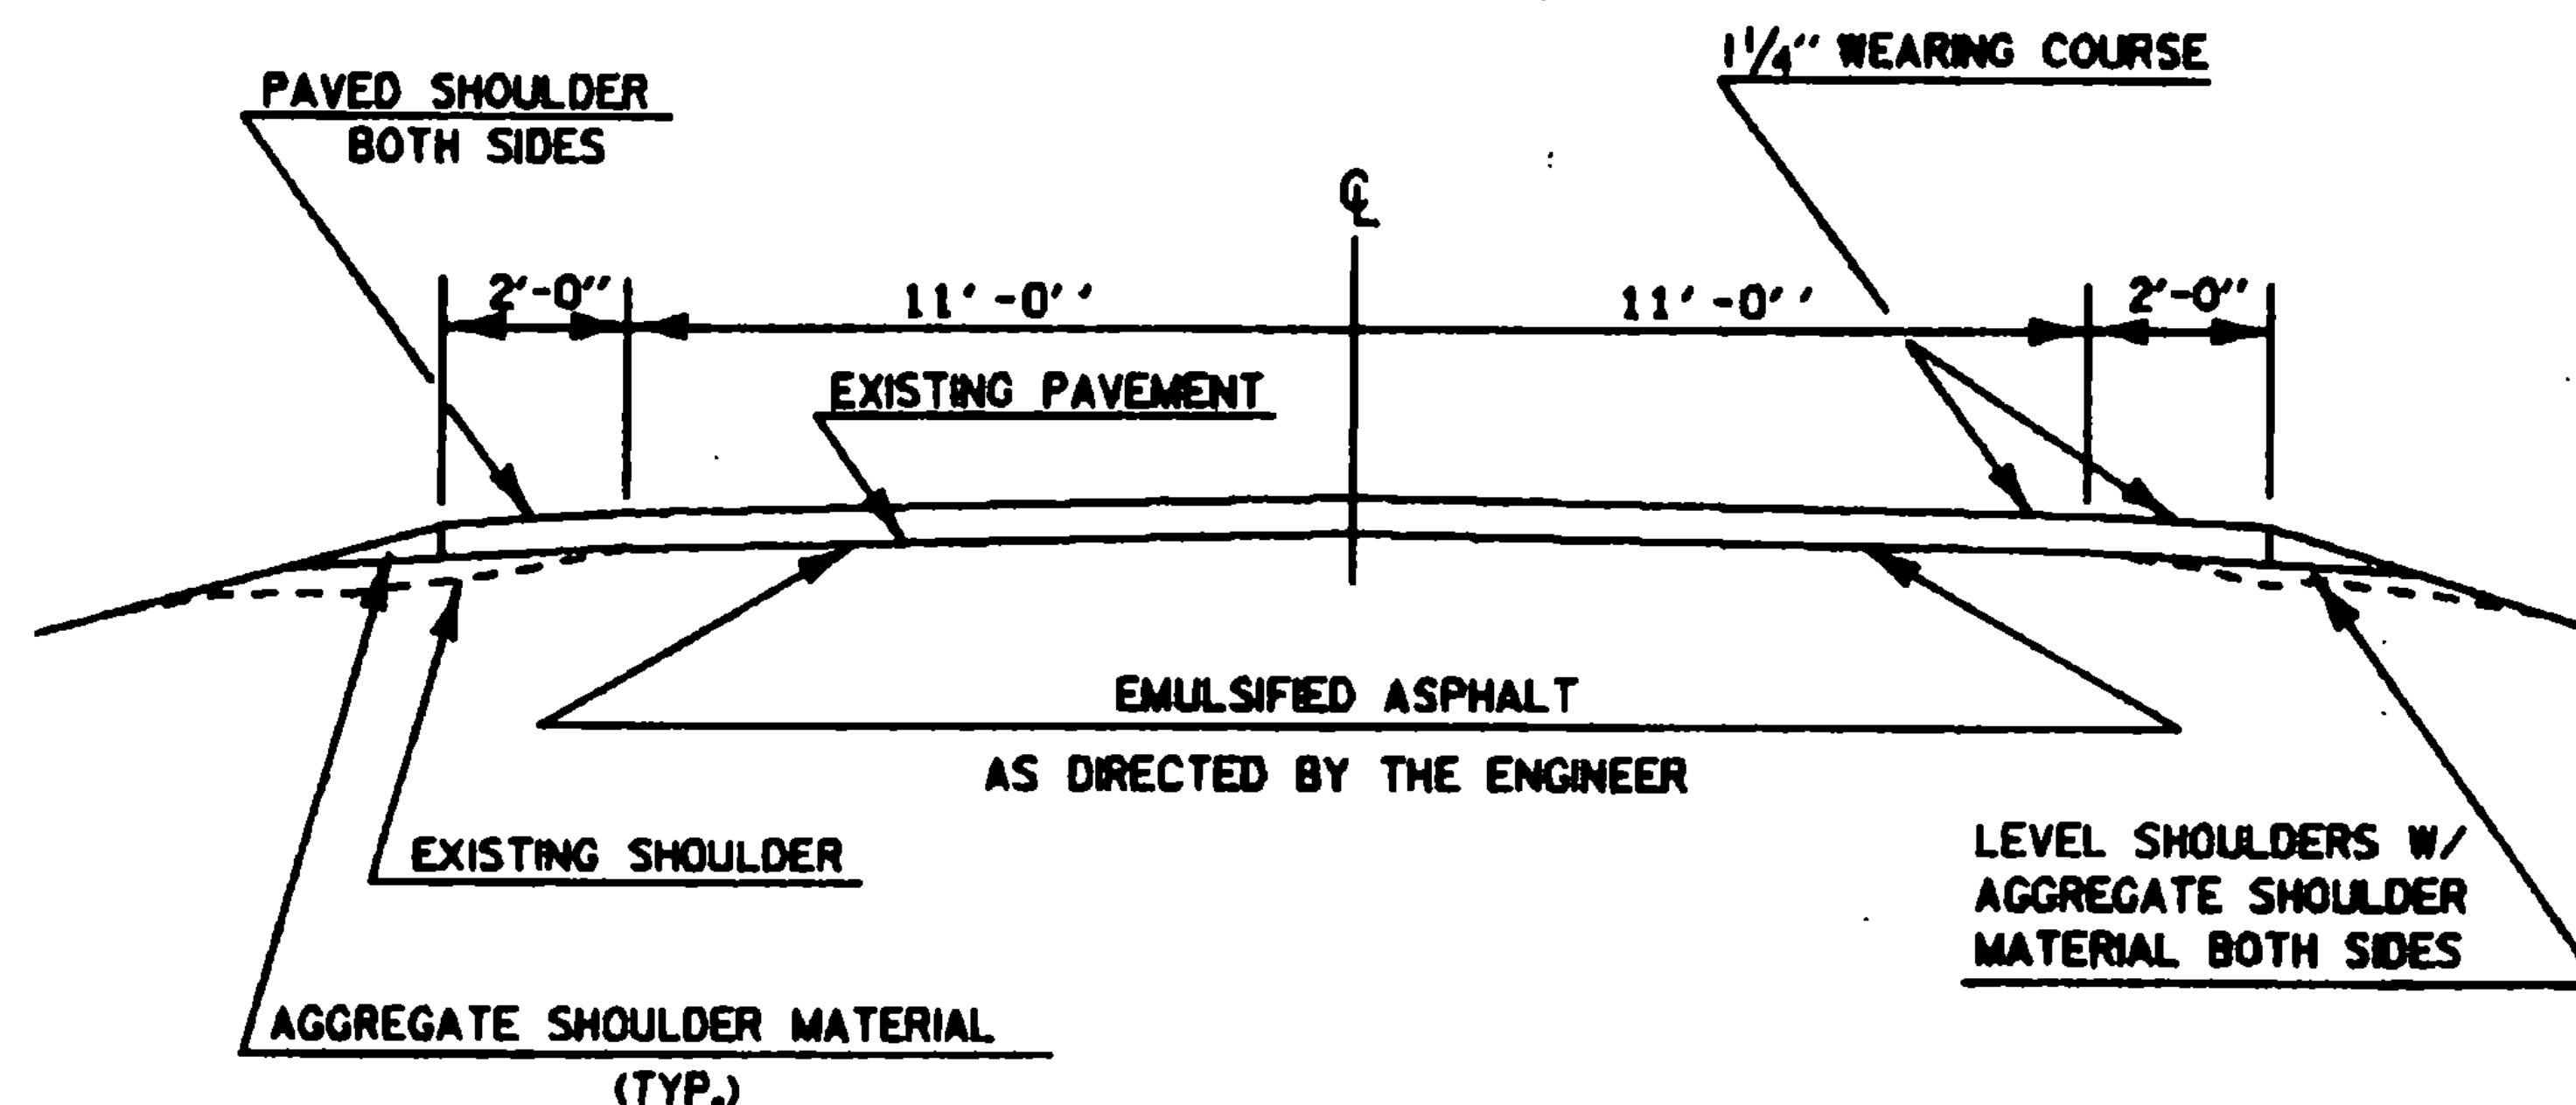

VT.100 MM 0.570 ~ MM 2.971

NOTE : BRIDGES AT MM 2.07 AND MM 2.74 ARE NOT TO BE PAVED.


NOTE : WHEN ENCOUNTERING VEGETATION OR POOR MATERIAL IN THE SHOULDER AREA, REMOVE 2" BELOW EXISTING PAVEMENT LEVEL AND REPLACE WITH AGGREGATE SHOULDER MATERIAL. REMOVAL OF THIS MATERIAL WILL BE PAID FOR UNDER THE ITEM 'ALL PURPOSE EXCAVATOR RENTAL' OR 'GRADER RENTAL'.

PROJECT GRANVILLE


NO. HMA 2860
SHEET 4 OF 10 SHEETS
SHEET 6 OF 38 SHEETS

PAVING LIMITS FOR DRIVES & TOWN ROADS

PAVING LIMITS FOR TOWN ROADS

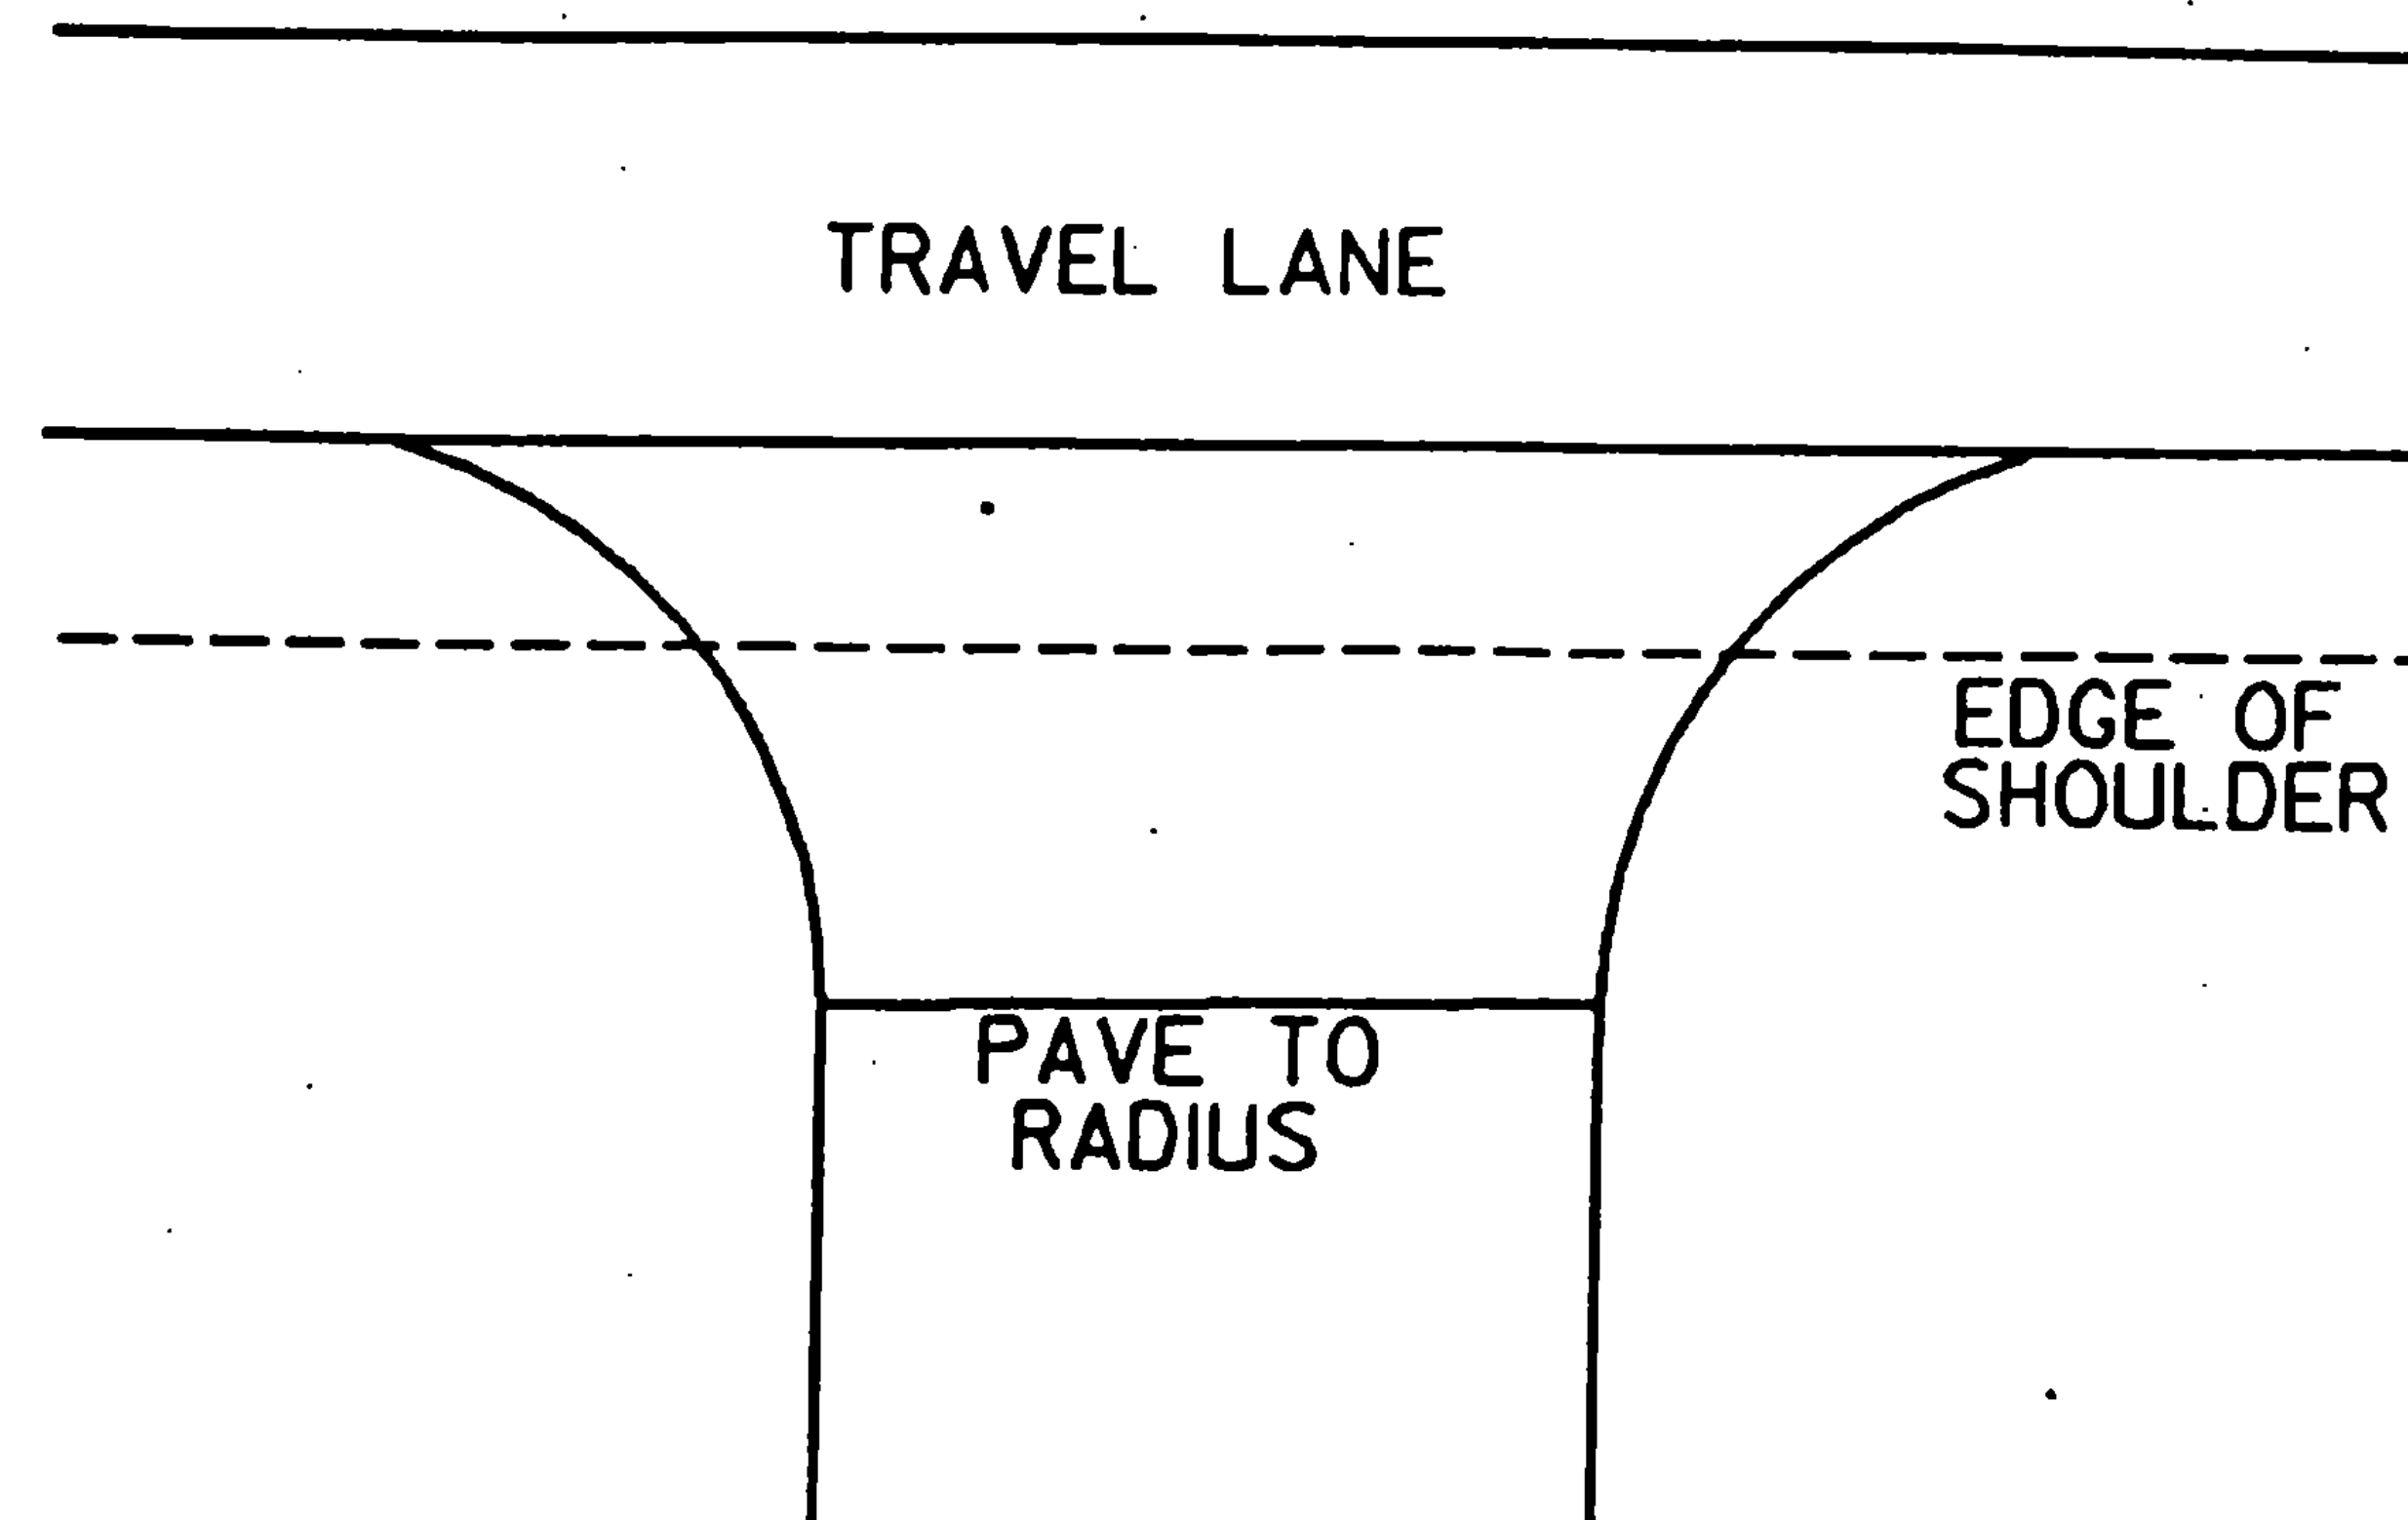

PAVING LIMITS FOR DRIVES

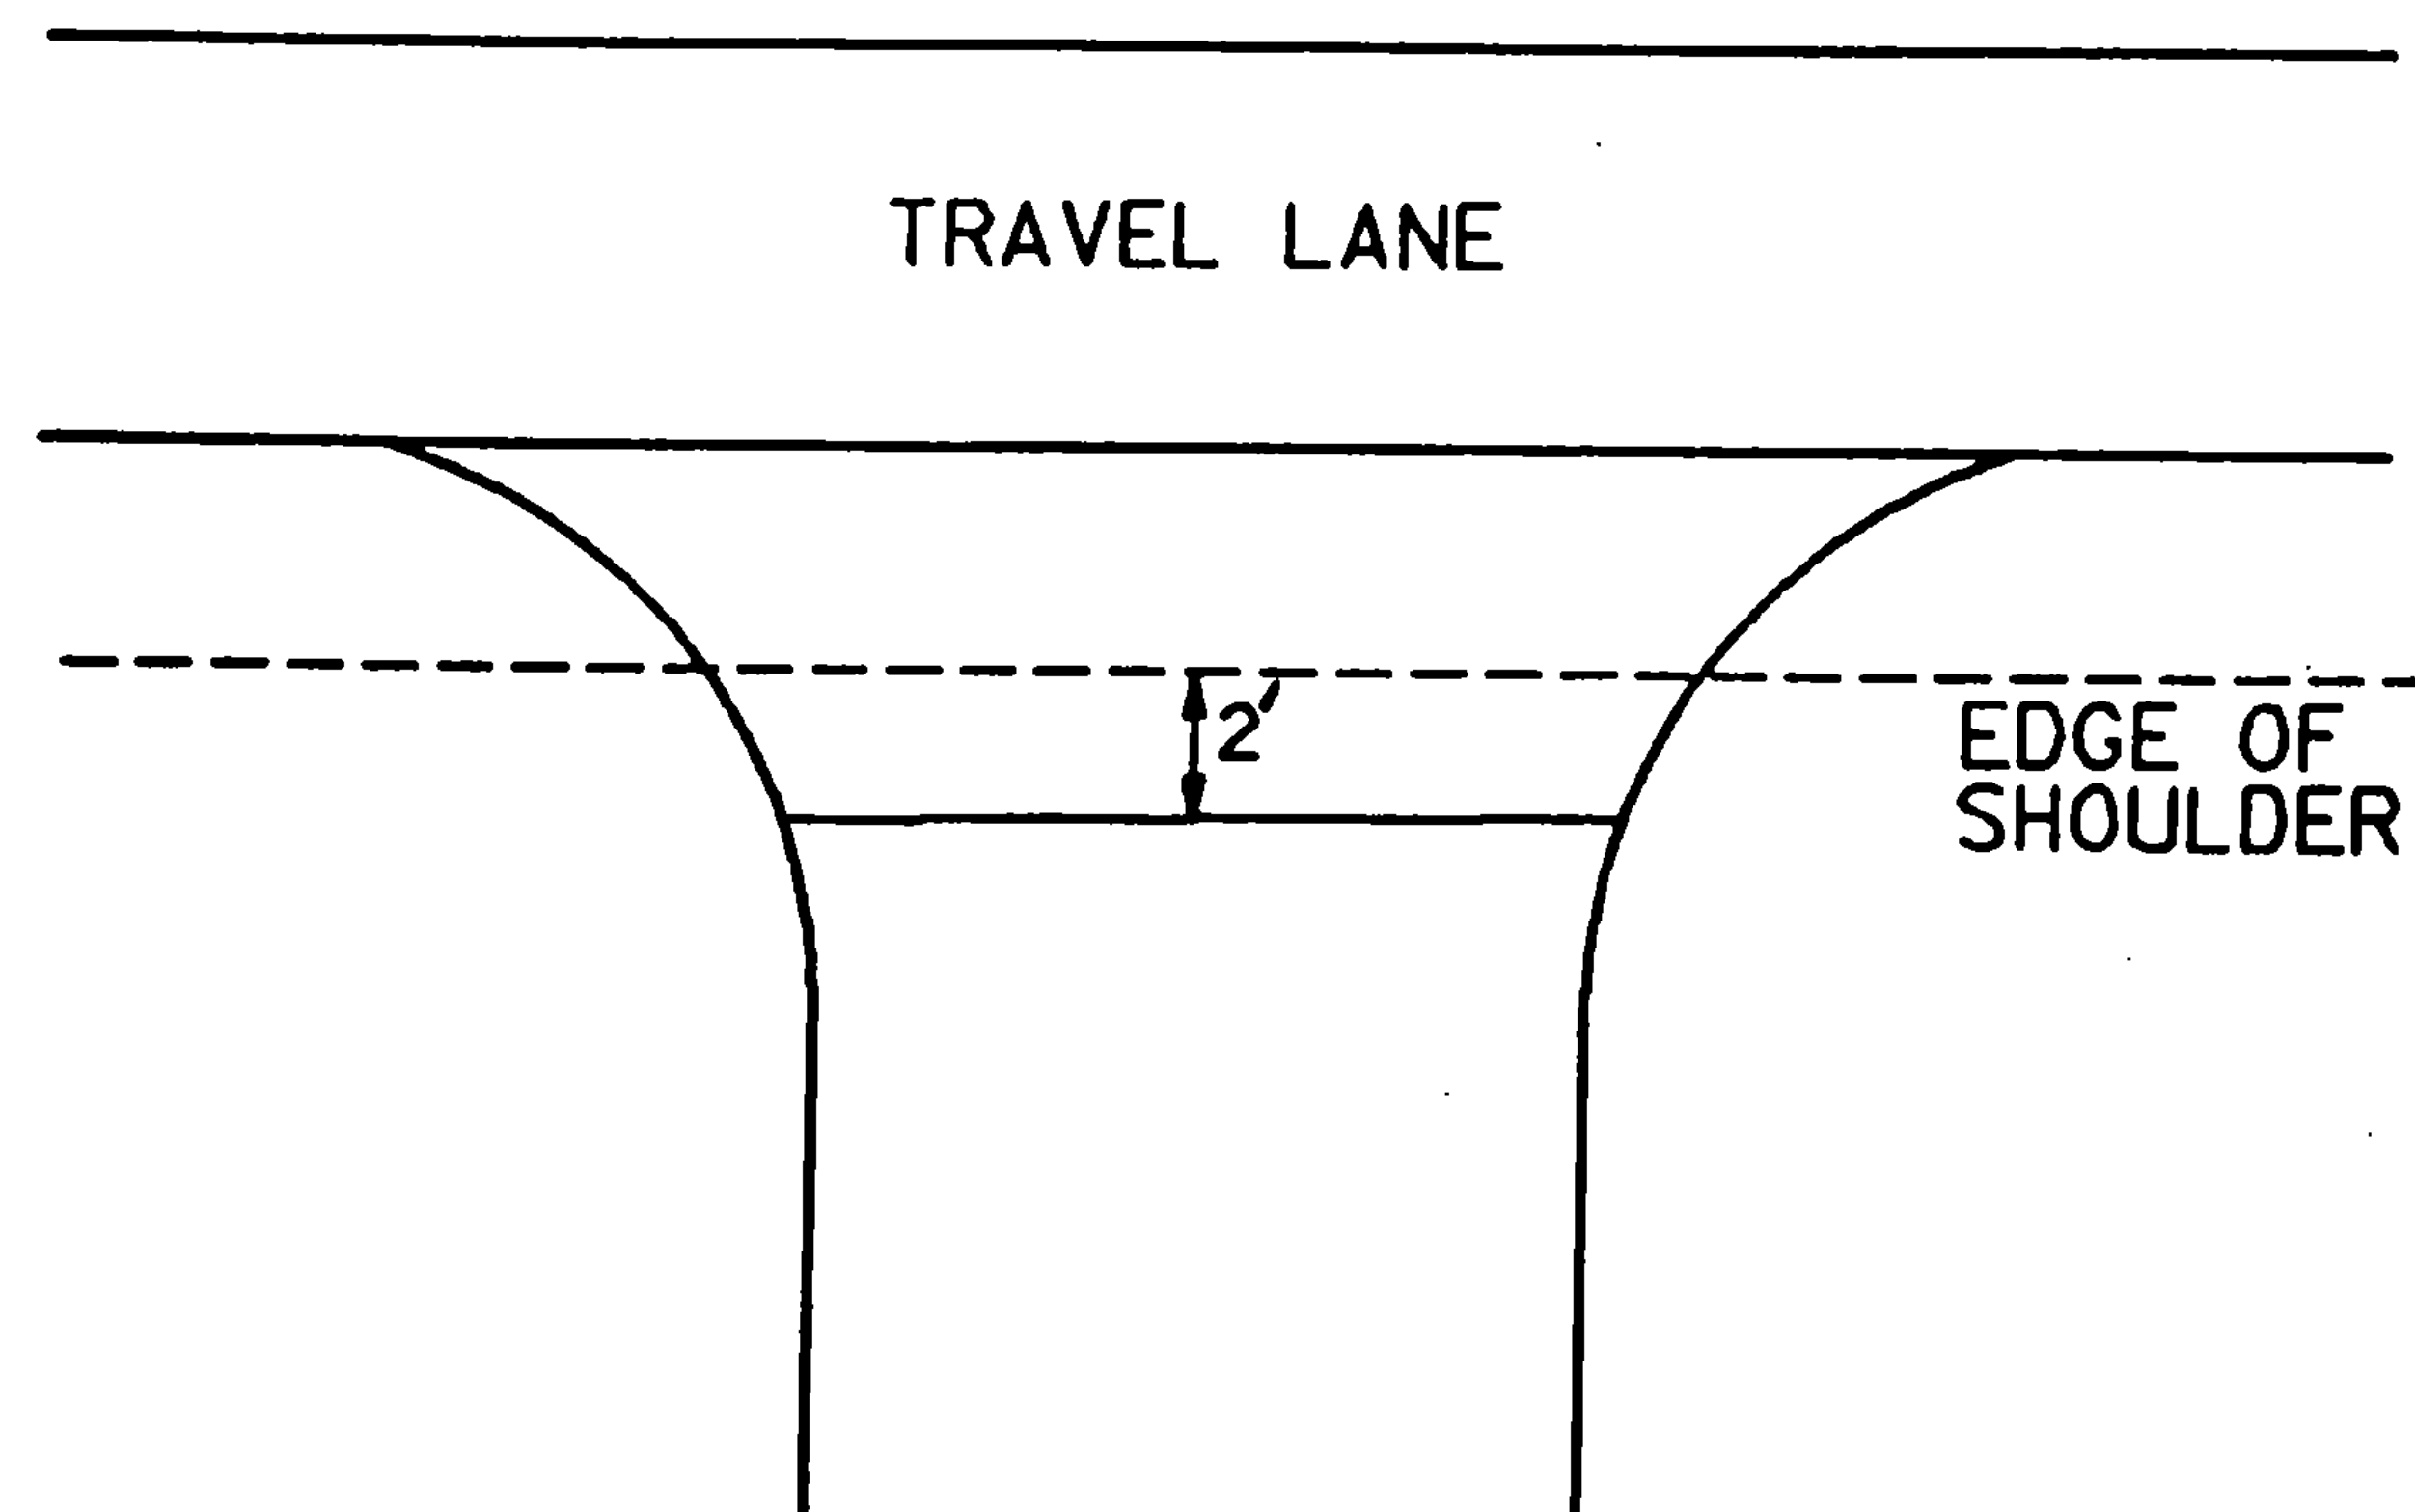

PROJECT Granville

NO. HMA 2860

SHEET 5 OF 10 SHEETS

SHEET 7 OF 38 SHEETS

TEMPORARY 4" YELLOW LINE

[illegible]

TEMPORARY 4" WHITE LINE

[illegible]

PROJECT Granville

NO. HMA 2860
SHEET 6 OF 10 SHEETS
SHEET 8 OF 38 SHEETS

GUIDELINES FOR MINIMUM INTERIM PAVEMENT MARKINGS
IN CONSTRUCTION ZONES

- A. CENTERLINE AND GORE AREA MARKINGS SHALL BE APPLIED AT THE END OF EACH WORKING DAY. THE FOLLOWING LAYOUT REQUIREMENTS SHALL BE MET:

NO PASSING BARRIER
SOLID STRIPES.

DASHED LINE
10-FOOT SOLID LINE WITH 30-FOOT GAP.

GORE AREA
(GORE AREAS TO INCLUDE 8' CHANNELIZING LINE AND DASHED LINE)
PER STANDARD SHEET E-50

- B. EDGE LINES

WHEN SPECIFIED, EDGE LINES ARE NOT REQUIRED UNTIL COMPLETION OF THE PROJECT. ON INTERSTATE PROJECTS, TEMPORARY EDGE LINES SHOULD BE APPLIED WHERE TRAFFIC VOLUMES AND SPEEDS ARE HIGH AND DELAY OF SEVERAL DAYS IS ANTICIPATED.

- C. TEMPORARY MARKINGS MAY CONSIST OF PAINT, TAPE OR RAISED PAVEMENT MARKERS (RPM'S). THE TAPE SHALL BE A RETRO-REFLECTIVE FILM ON A CONFORMABLE METALLIC BACKING THAT CAN BE PAVED OVER. TAPE MAY BE USED ON THE FINAL SURFACE COURSE IF IT WILL NOT INTERFERE WITH THE FINAL MARKING APPLICATION. TEMPORARY TAPE MARKINGS WILL BE OFFSET AND REMOVED WHEN PROJECT IS FINISHED AND FINAL CENTERLINE PAINTED. THE TAPE SHALL BE THE TYPE THAT IS REMOVABLE INTACT AND NOT SEPERATE AT ANY TIME. THE RPM'S SHALL HAVE A SELF-ADHESIVE BACKING EASILY REMOVED BEFORE PAVING AND SHALL CONFORM TO THE FOLLOWING LAYOUT PATTERN:

NO PASSING BARRIER
NO RPM'S ALLOWED.

DASHED LINE
FOUR RETRO-REFLECTIVE RPM'S ON 3 1/2 FOOT CENTERS WITH A 30' GAP.


SOLID LINE - EDGE LINES
INTERSTATE MEDIAN SIDE-RETRO-REFLECTIVE RPM'S ON 4 TO 5 FOOT CENTER.
DRIVERS RIGHT SIDE-RPM'S NOT ALLOWED.

- D. WHEN PAINT IS USED FOR TEMPORARY MARKING, AN ALTERNATE MATERIAL SUCH AS TAPE OR RPM'S SHALL BE ON HAND IN THE EVENT RAIN PREVENTS THE PAINT APPLICATION FROM BEING COMPLETED. ALL PAINT SHALL BE REFLECTORIZED.
- E. PAYMENT FOR PAINT AND TAPE SHALL BE COMPUTED ON A LINEAR FOOT BASIS AS IF PAINT WAS USED. PAYMENT FOR THE RPM'S SHALL BE COMPUTED AS IF AN EQUIVALENT PAINT LINE WAS USED. (FOR EXAMPLE, DASHED LINE PAID AS 10 FEET OF PAINT, SOLI LINE PAID AS THE TOTAL DISTANCE COVERED WITH THE MARKERS).
- F. PRIOR TO ACCEPTANCE, THE PAVEMENT MARKINGS SHALL BE COMPLETED FOR THE ENTIRE PROJECT BY THE CONTRACTOR AS DETAILED ON THE PLANS OR DIRECTED BY THE RESIDENT ENGINEER.


REVISED
02/11/85

HMA 2860
Sheet 7 of 10 Sheets
Sheet 9 of 38 Sheets

Granville

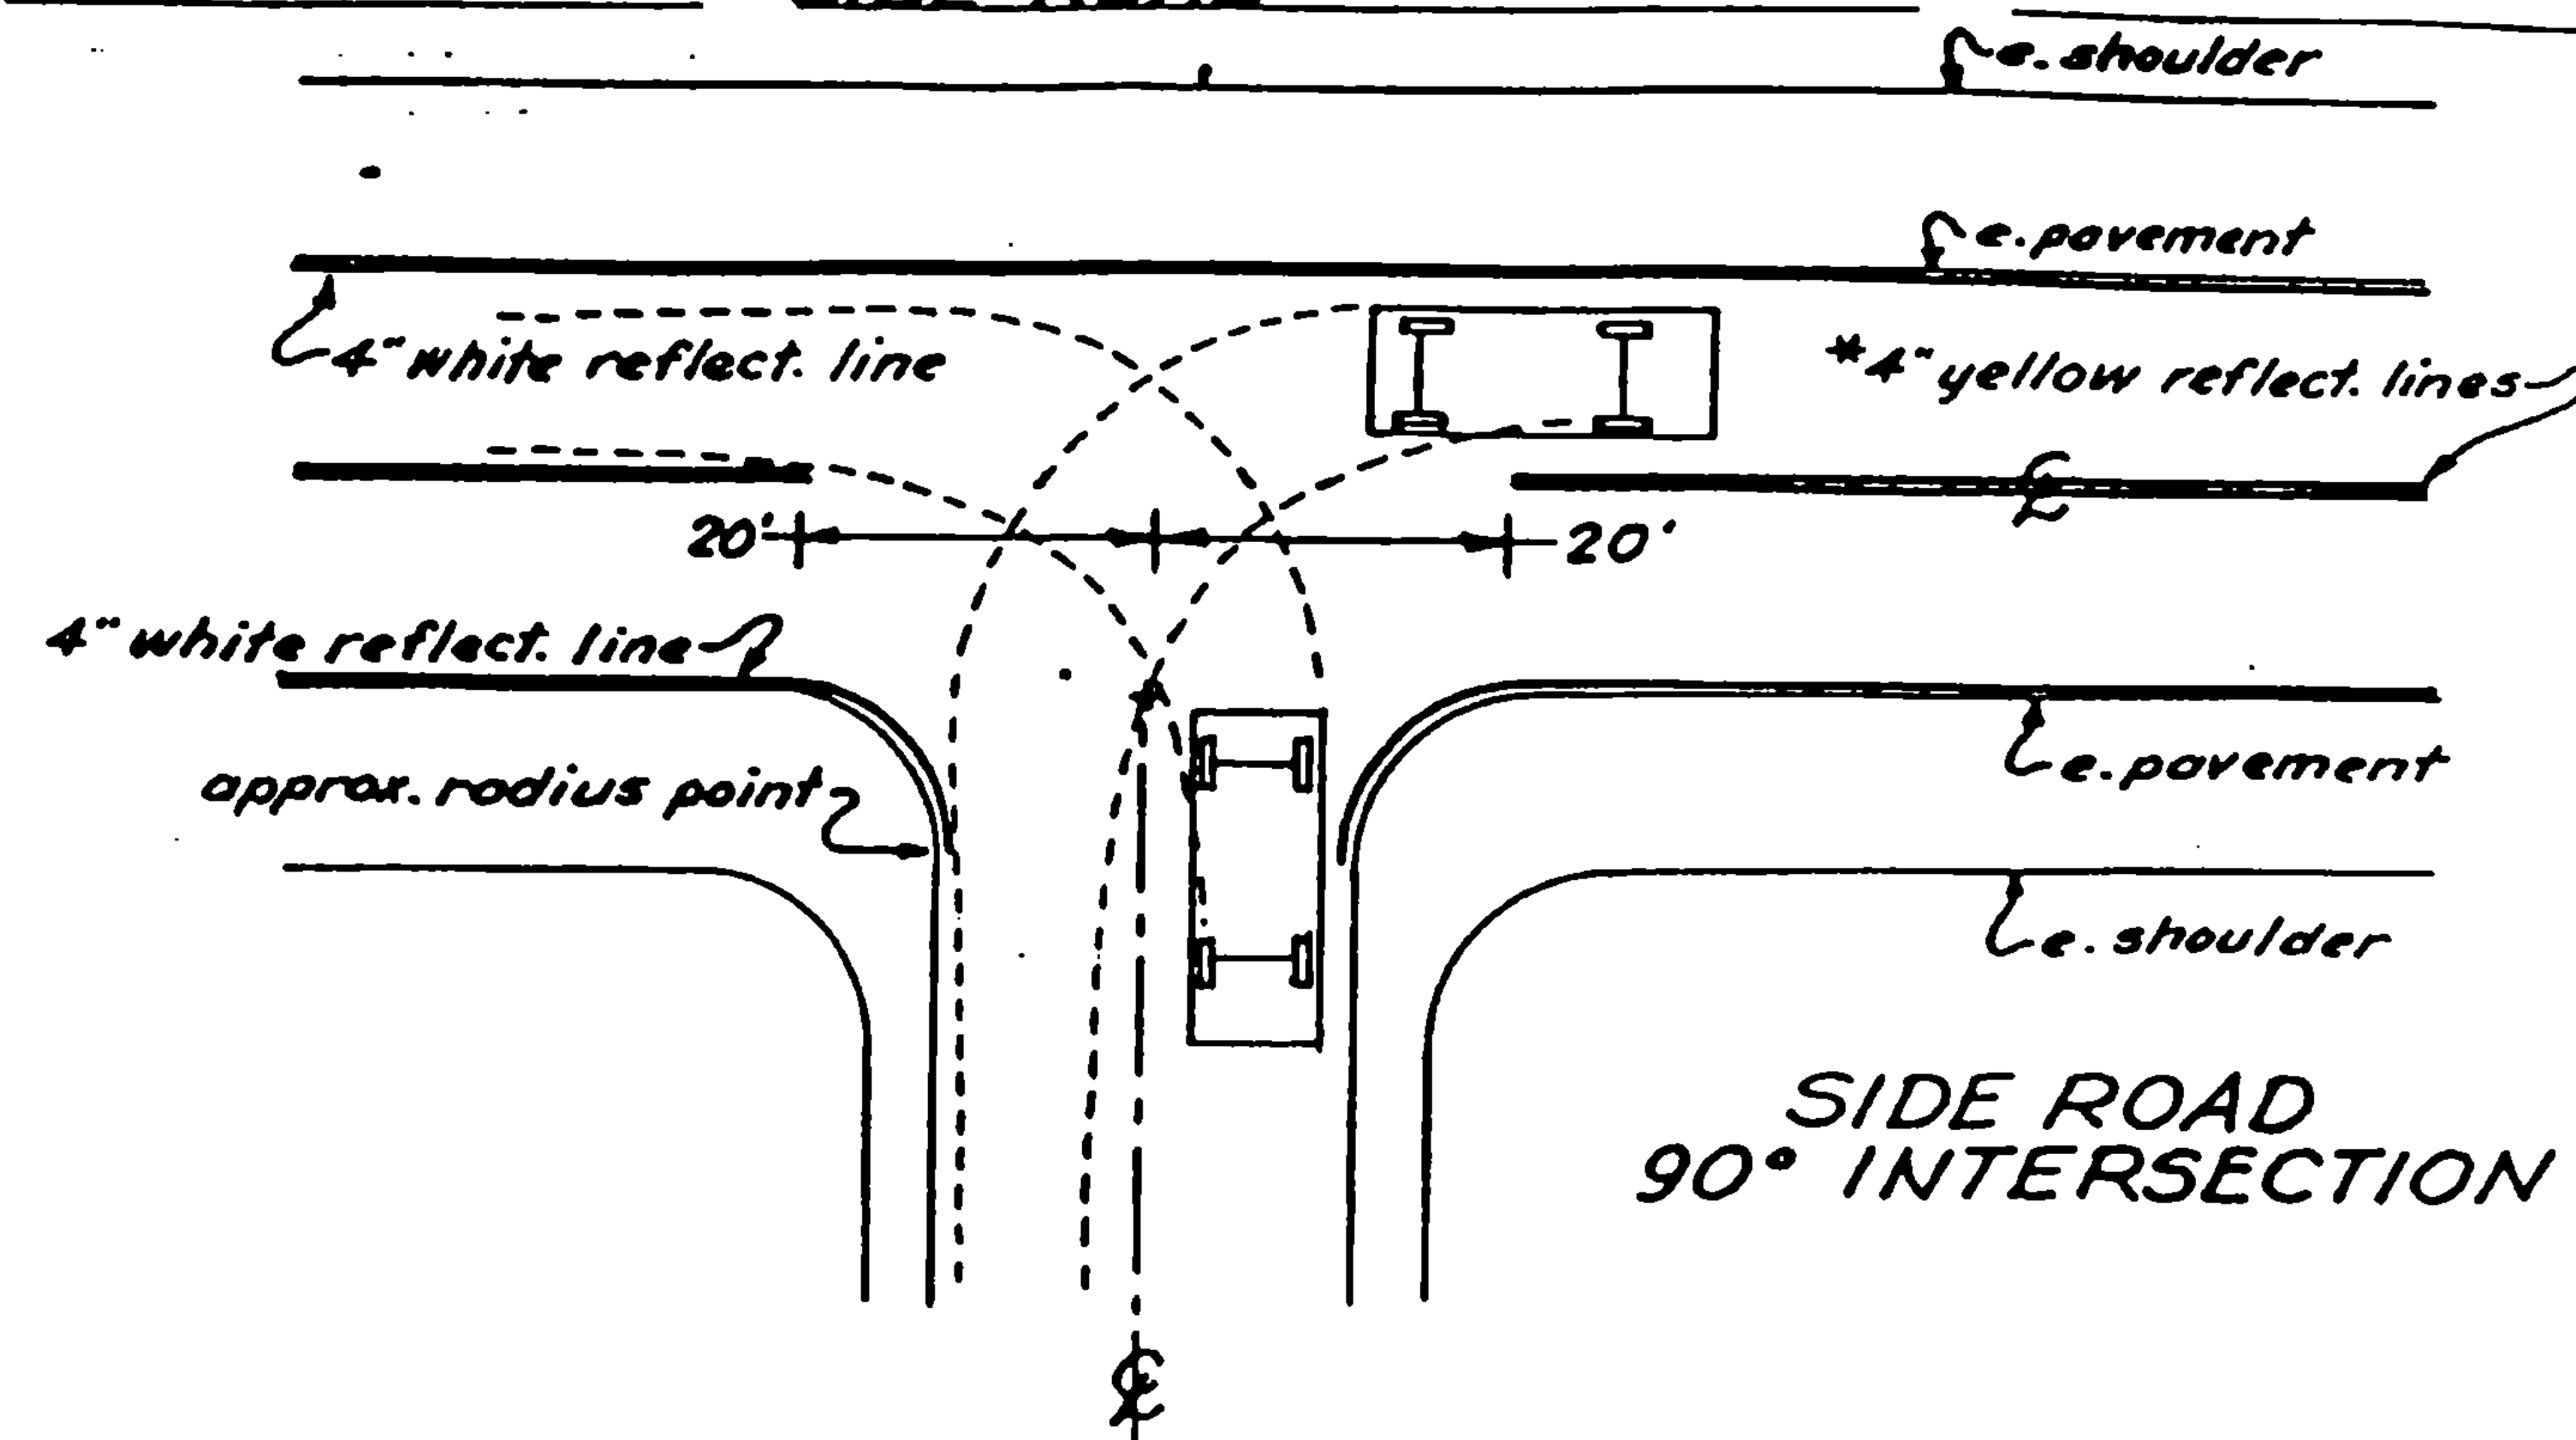

* Centerline treatment shall consist of a minimum of 400 feet of solid line in advance of the intersection and shall be paired with either a solid or dashed line depending on sight distance availability in the opposing lane.

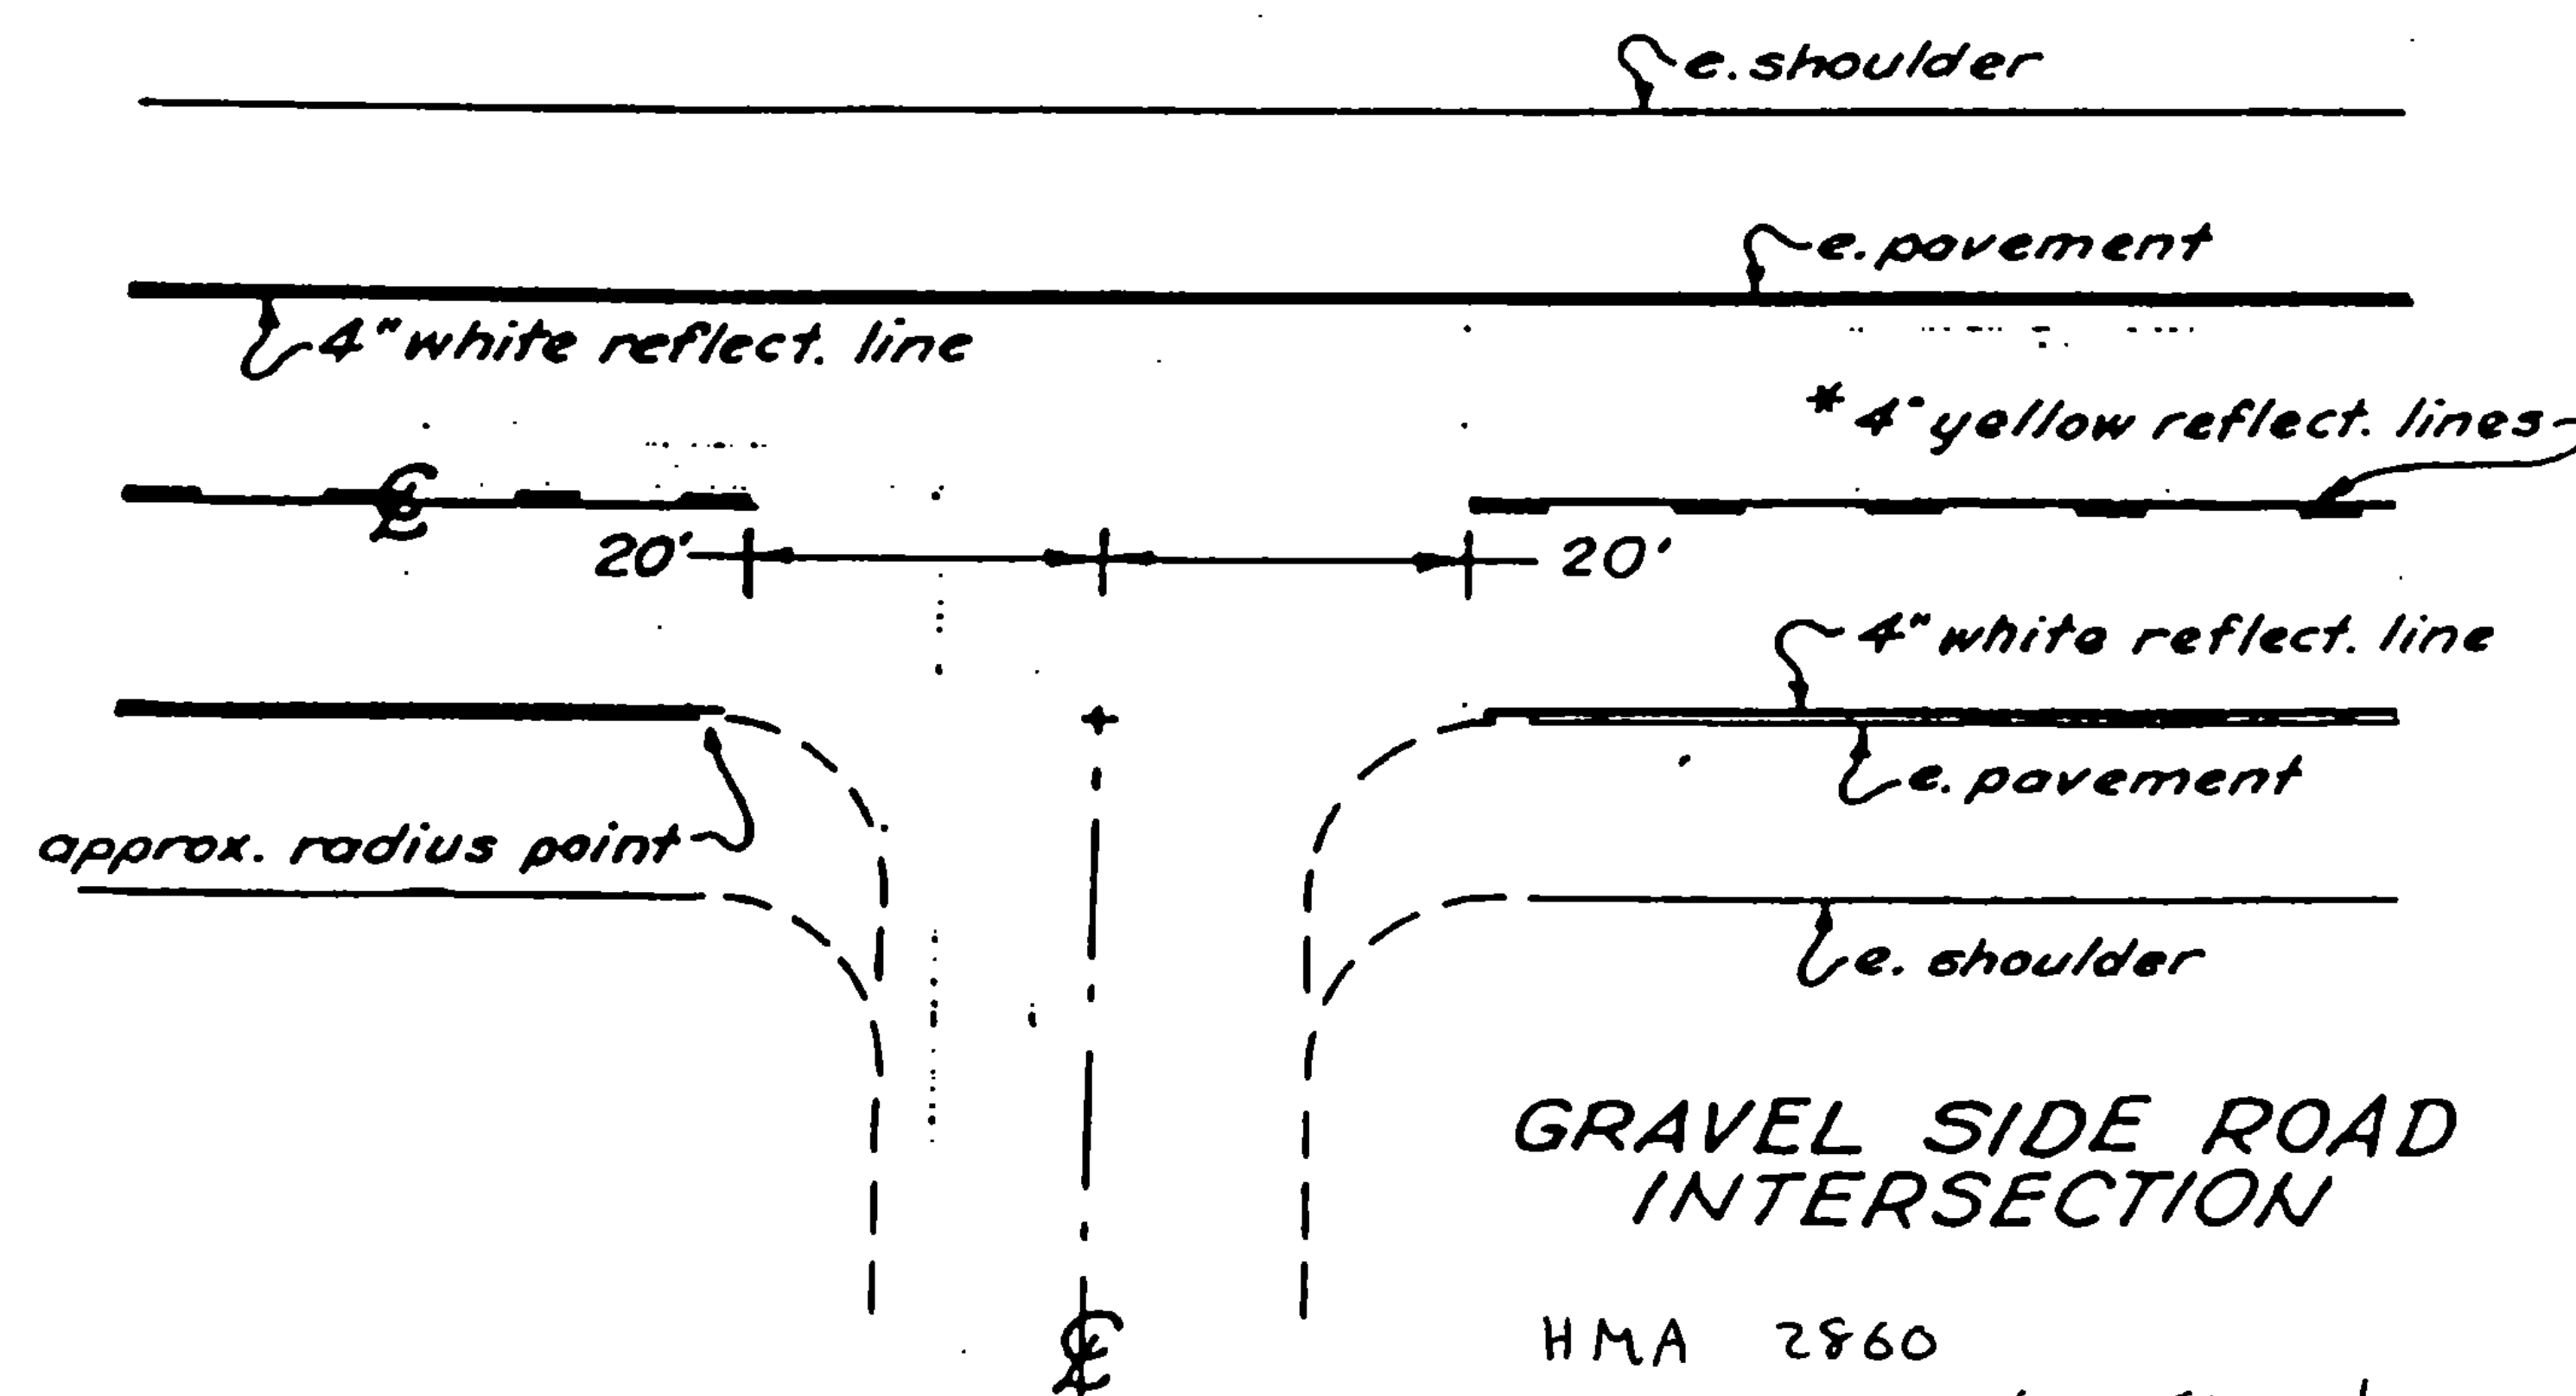

HMA 2860
Sheet 8 of 10 Sheets
Sheet 10 of 38 Sheets

Granville

PROJECT LENGTHS AND ITEM QUANTITIES

ITEM NO.	UNIT	Length FT	Width FT	Overlay Depth IN		402.10	402.12	404.65	406.25	608.15	608.25	608.30	608.37	630.10	630.15	635.10	
						CY	TON	CWT	TON	HR	HR	HR	HR	HR	HR	LS	
MM 0.570 2.971		12677	26	1 1/4		1056	1848	45	2543	24	24	19	24	304	352	0.44	Includes Shoulders Level Course
Drives + Approaches						152	266		95								
Rounding						2	6	-	8	-	-	1	-	1	3	-	
TOTAL						1210	2120	45	3640	24	24	20	24	305	355	0.44	

PROJECT Granville

NO. HMA 2860

SHEET 9 OF 10 SHEETS
SHEET 11 OF 38 SHEETS

• 1991 •


ION

Temporary 4" White Line

Temporary 4" Yellow Line

PROJECT Granville. NO. HMA 2860 SHEET 10 OF 10 SHEETS
SHEET 12 OF 38 SHEETS

STATE OF VERMONT
AGENCY OF TRANSPORTATION

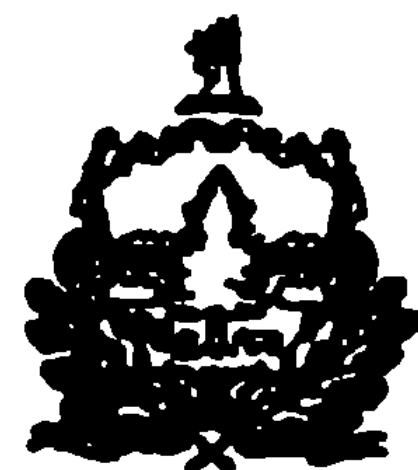


PROPOSED IMPROVEMENT

TOWN OF Hancock - Granville

COUNTY OF Addison

ROUTE NO. VT 100

ROUTE CLASS FAP

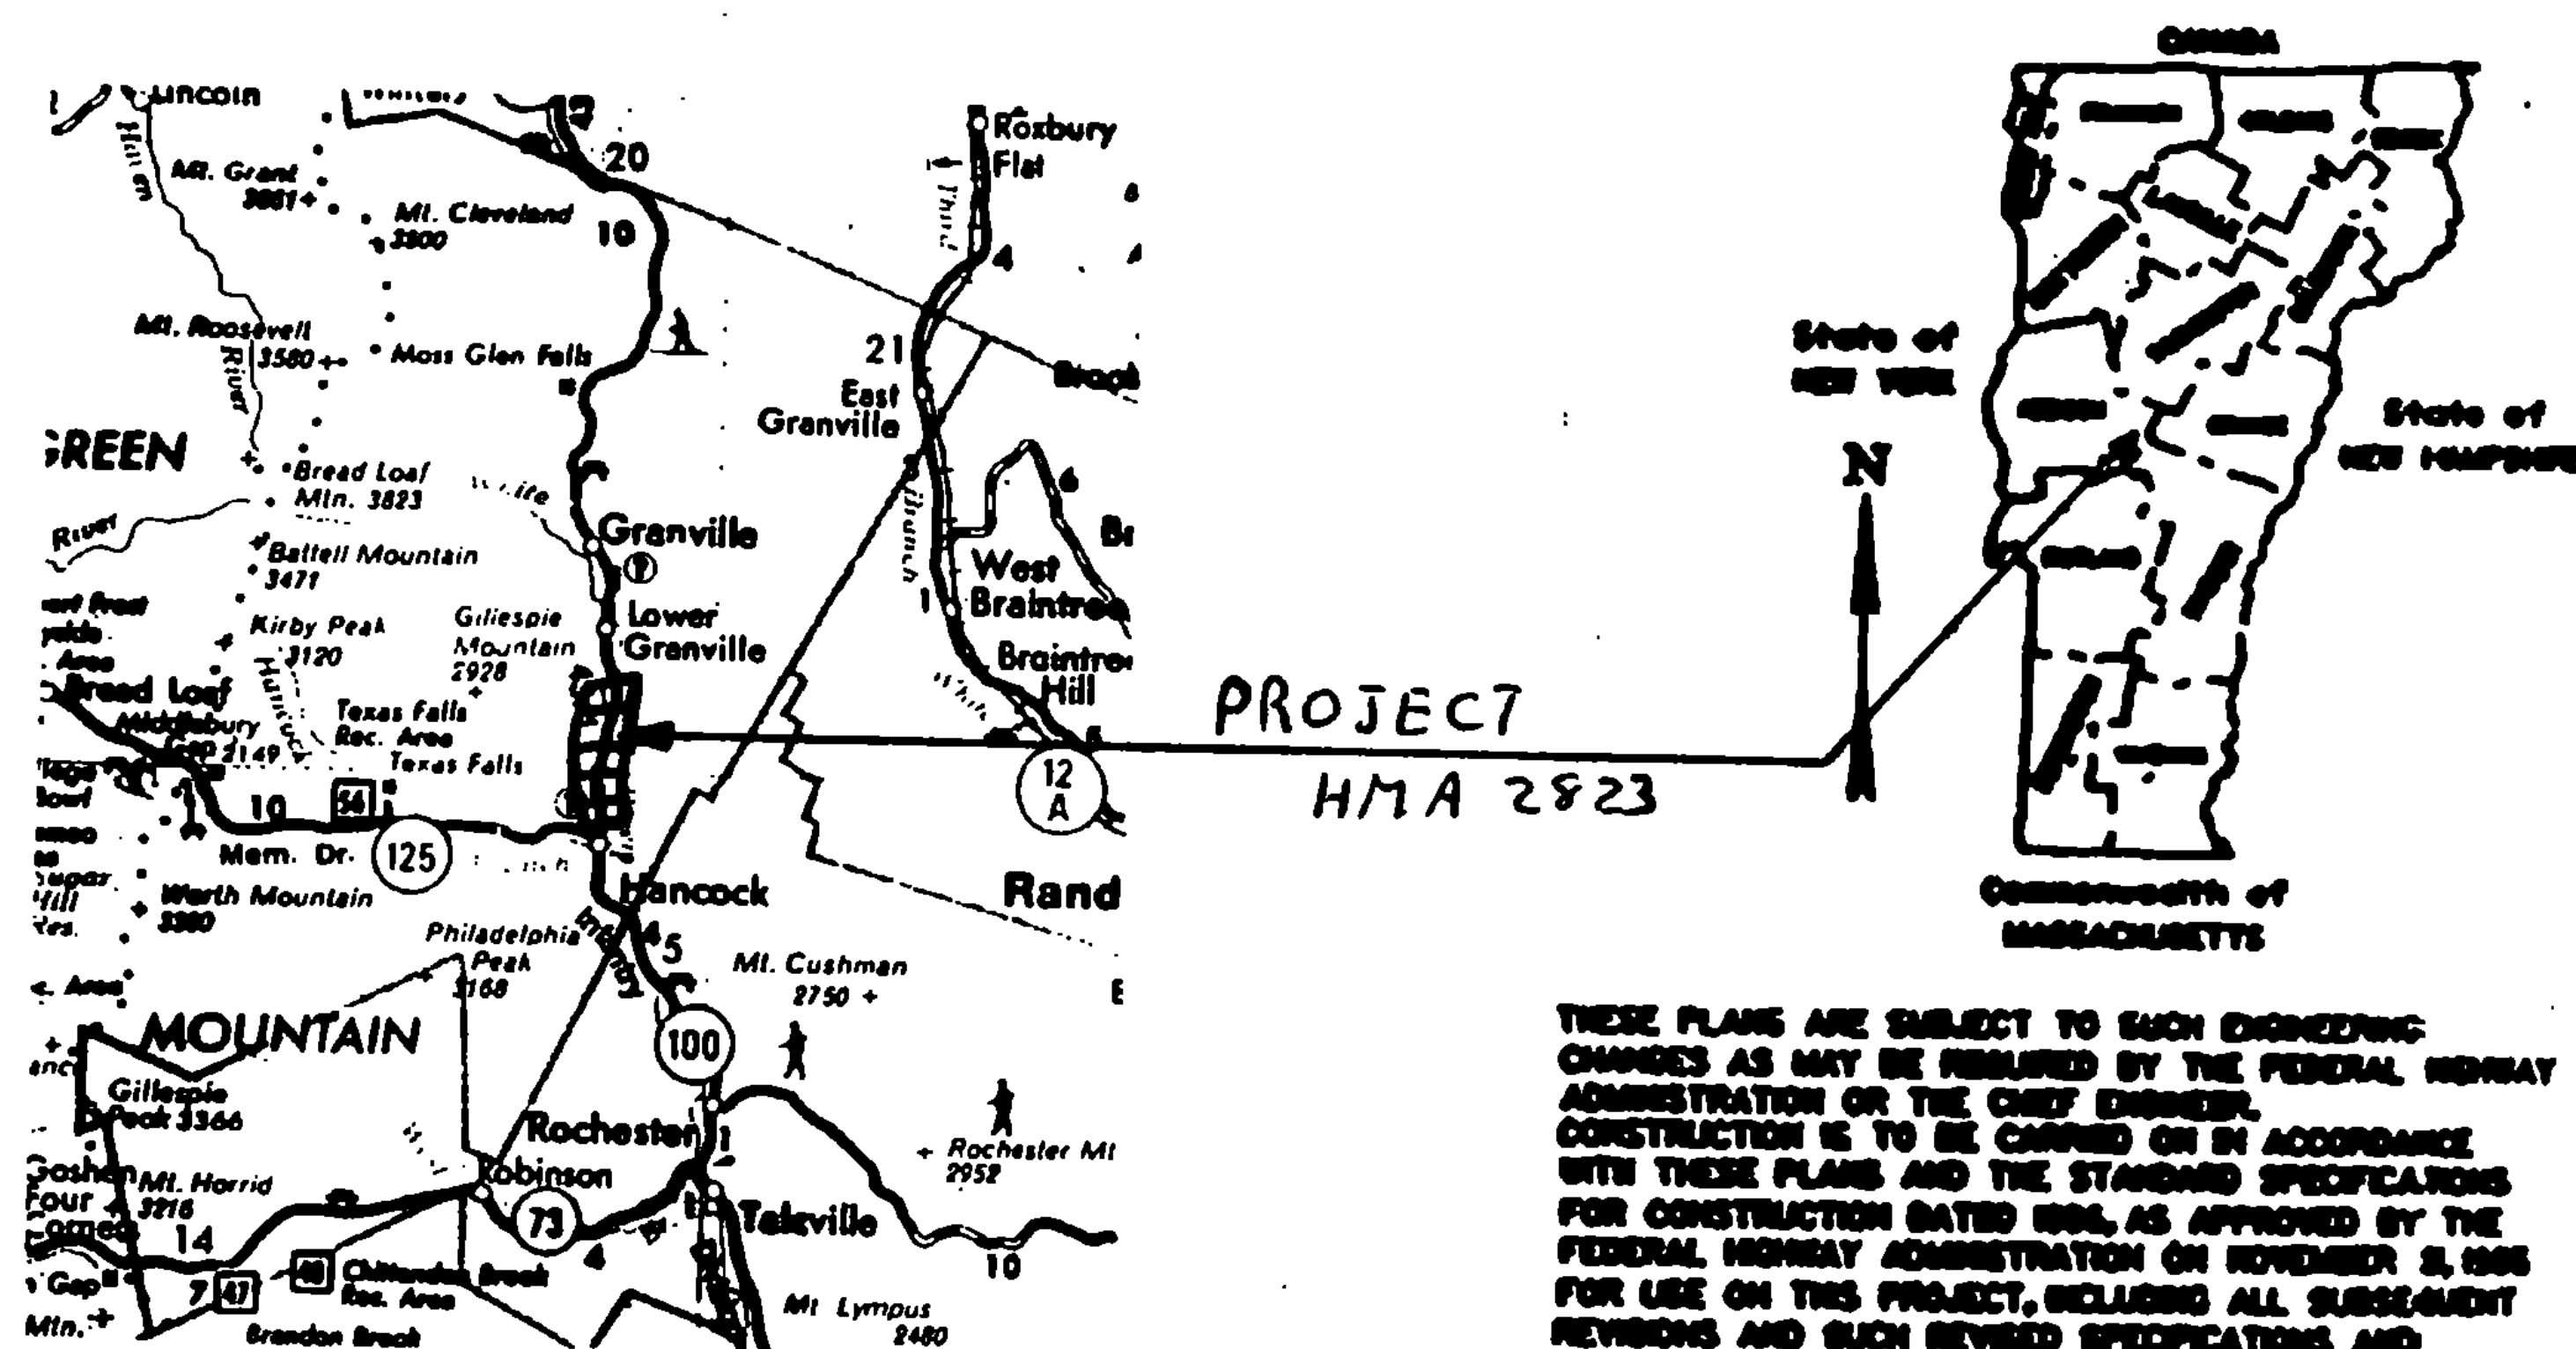

THESE PLANS ARE SUBJECT TO SUCH ENGINEERING CHANGES AS MAY BE REQUIRED BY THE FEDERAL HIGHWAY ADMINISTRATION OR THE CHIEF ENGINEER. CONSTRUCTION IS TO BE CARRIED ON IN ACCORDANCE WITH THESE PLANS AND THE STANDARD SPECIFICATIONS FOR CONSTRUCTION DATED 1966, AS APPROVED BY THE FEDERAL HIGHWAY ADMINISTRATION ON NOVEMBER 2, 1966 FOR USE ON THIS PROJECT, INCLUDING ALL SUBSEQUENT REVISIONS AND SUCH REVISED SPECIFICATIONS AND SPECIAL PROVISIONS AS ARE INCORPORATED IN THESE PLANS.

DESIGNED BY ORDER OF THE STATE TRANSPORTATION BOARD

APPROVED _____ DATE _____
CHIEF ENGINEER

DEPARTMENT OF TRANSPORTATION
FEDERAL HIGHWAY ADMINISTRATION

APPROVED _____ DATE _____
DIVISION ADMINISTRATOR

Hancock - Granville
PROJECT HMA 2823

SHEET 1 OF 10 SHEETS

See Sheet 1 For Index

SHEET 13 OF 38 SHEETS

INDEX . OF SHEETS

1. Title Page
2. Index Of Sheets
3. Description And Location
4. Typical Sections And Design Data
5. Paving Limits For Drives And Town Roads
6. Pavement Marking Locations
7. Guidelines For Minimum Interim Pavement Markings In Construction Zones
8. Mainline Pavement Marking At Intersecting Side Road
- 9-10 Project Lengths And Item Quantities


PROJECT Hancock-Granville

NO. HMA 2823

SHEET 2 OF 10 SHEETS

SHEET 14 OF 38 SHEETS

DESCRIPTION AND LOCATION

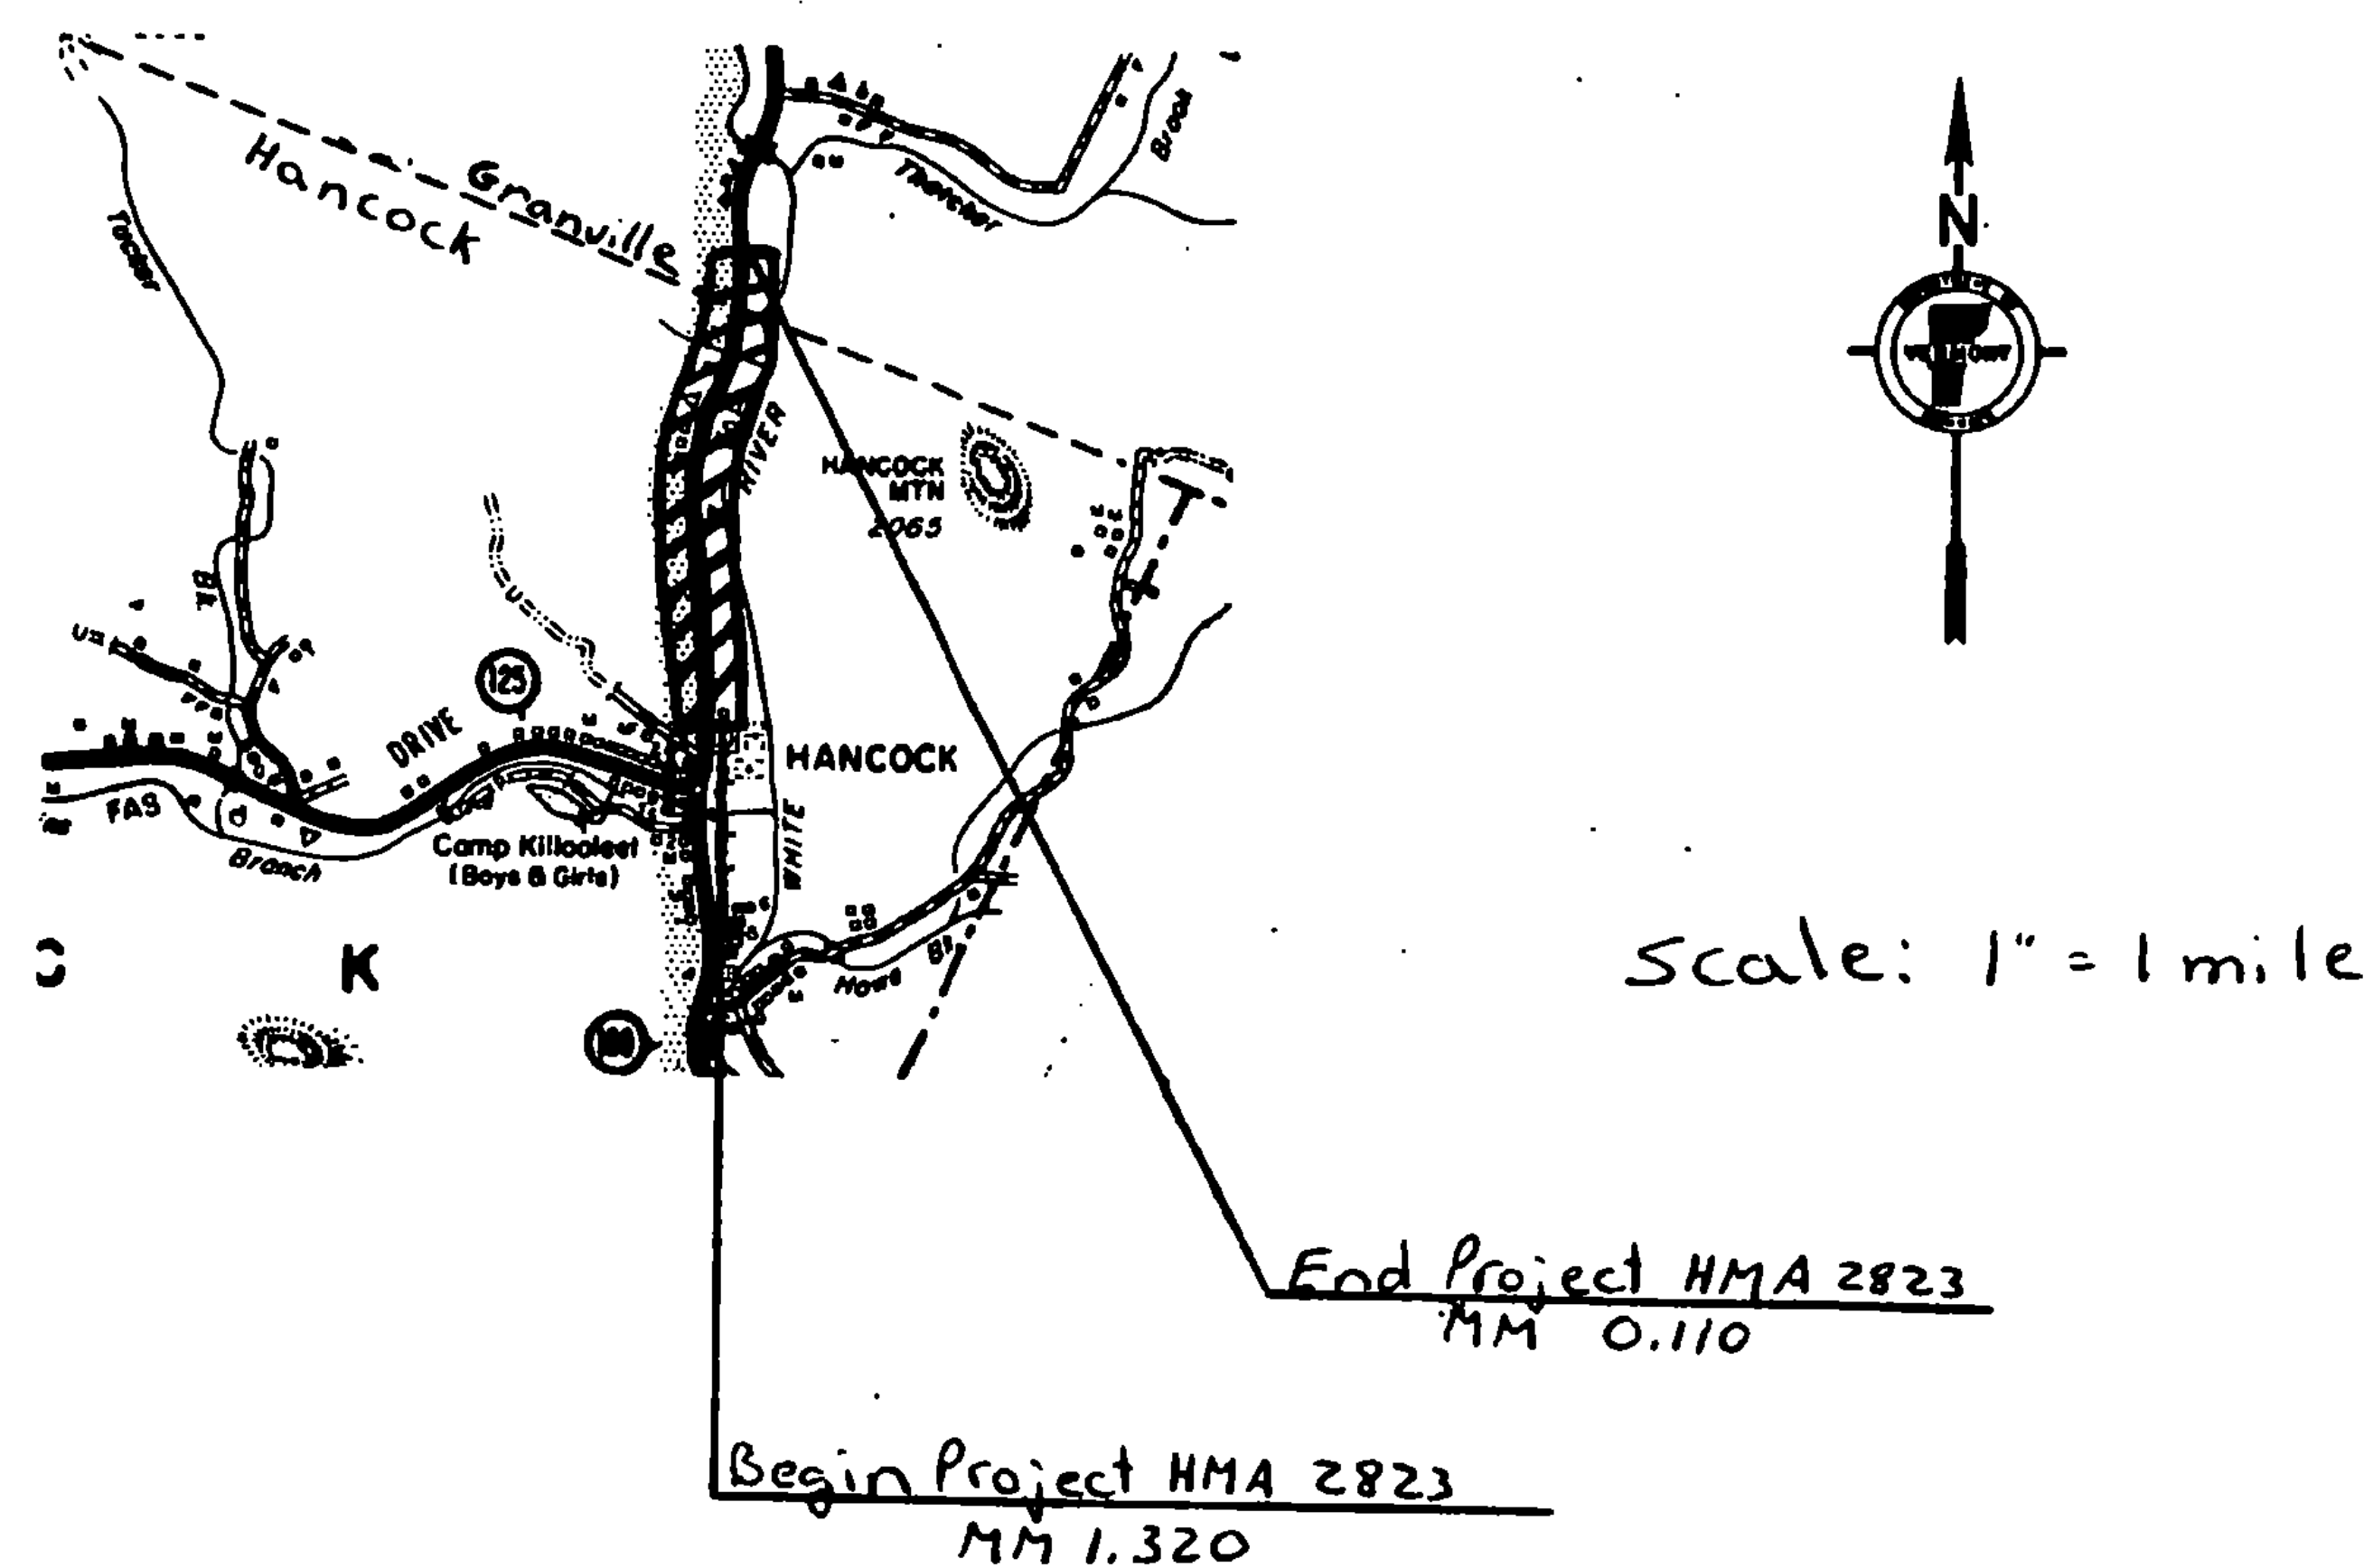

Beginning at a point on VT 100, 1.320 miles northerly of the Rochester - Hancock town line and extending 1.300 miles northerly to MM 0.110 in the town of Granville

Work consists of resurfacing of the highway, including shoulders and new pavement markings

1986 ADT 1810 Length of Project 1.300 miles
6864 feet

PROJECT Hancock - Granville


NO. HMA 2823

SHEET 3 OF 10 SHEETS

SHEET 15 OF 38 SHEETS

TYPICAL SECTIONS & DESIGN DATA

BITUMINOUS CONCRETE PAVEMENT
 LEVELING COURSE TYPE IV (532 TONS/MILE)
 AS DIRECTED BY THE ENGINEER.
 1 1/4" WEARING COURSE TYPE III (±1/4" THICKNESS TOLERANCE)

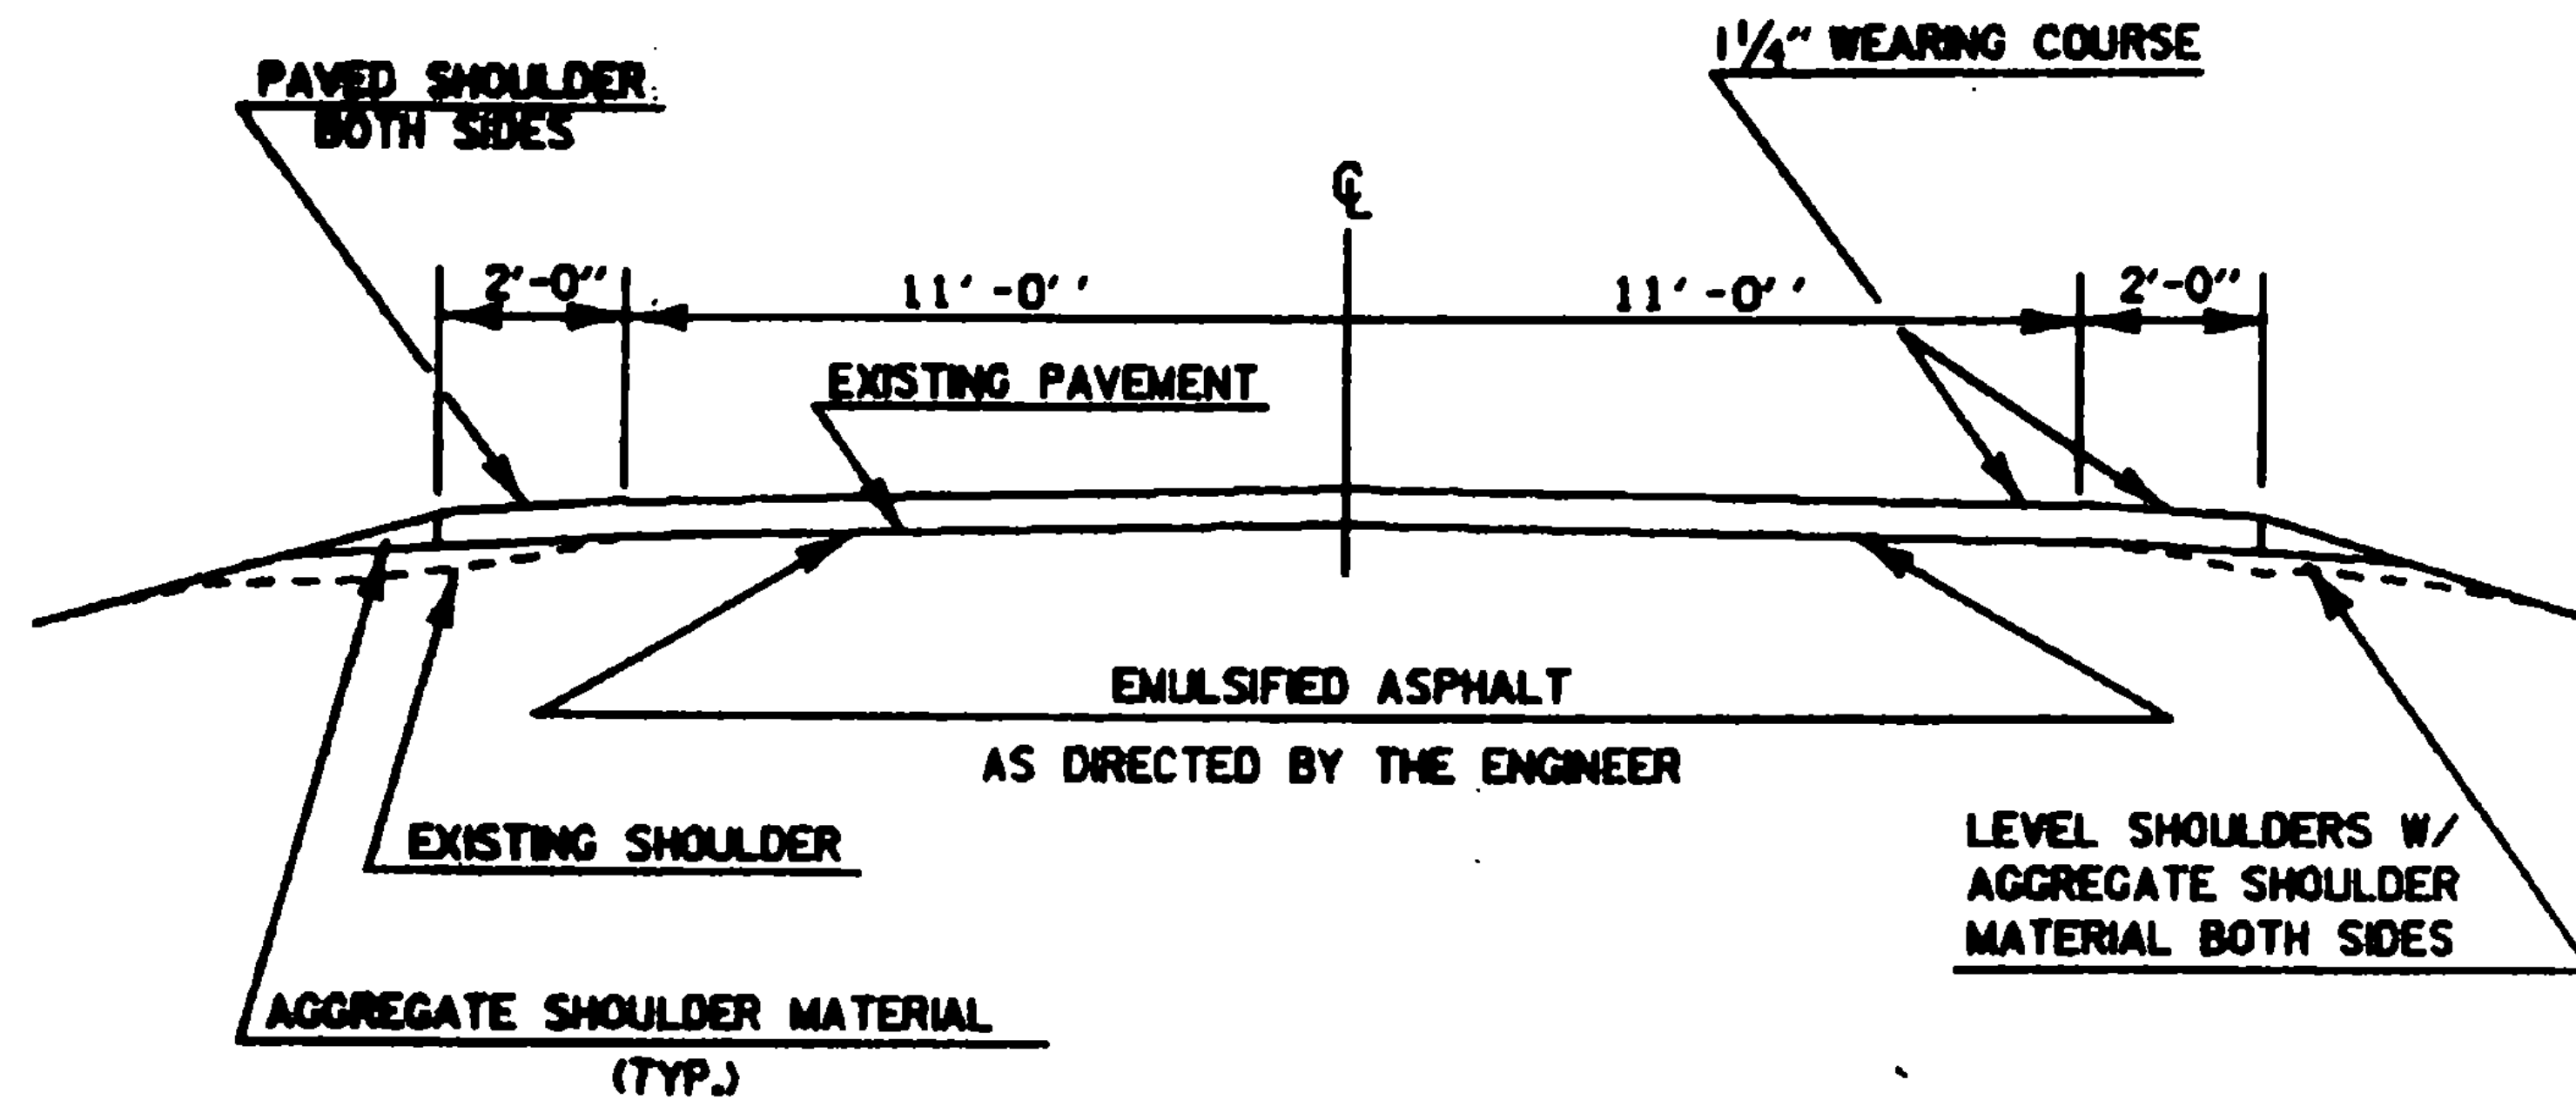

VT. 100 HANCOCK GRANVILLE
 MM 1.320 ~ MM 0.110


NOTE : WHEN ENCOUNTERING VEGETATION OR POOR MATERIAL IN THE SHOULDER AREA, REMOVE 2" BELOW EXISTING PAVEMENT LEVEL AND REPLACE WITH AGGREGATE SHOULDER MATERIAL. REMOVAL OF THIS MATERIAL WILL BE PAID FOR UNDER THE ITEM 'ALL PURPOSE EXCAVATOR RENTAL' OR 'GRADER RENTAL'.

PROJECT HANCOCK-GRANVILLE


NO. HMA 2823
 SHEET 4 OF 10 SHEETS
 SHEET 16 OF 38 SHEETS

PAVING LIMITS FOR DRIVES & TOWN ROADS

PAVING LIMITS FOR TOWN ROADS

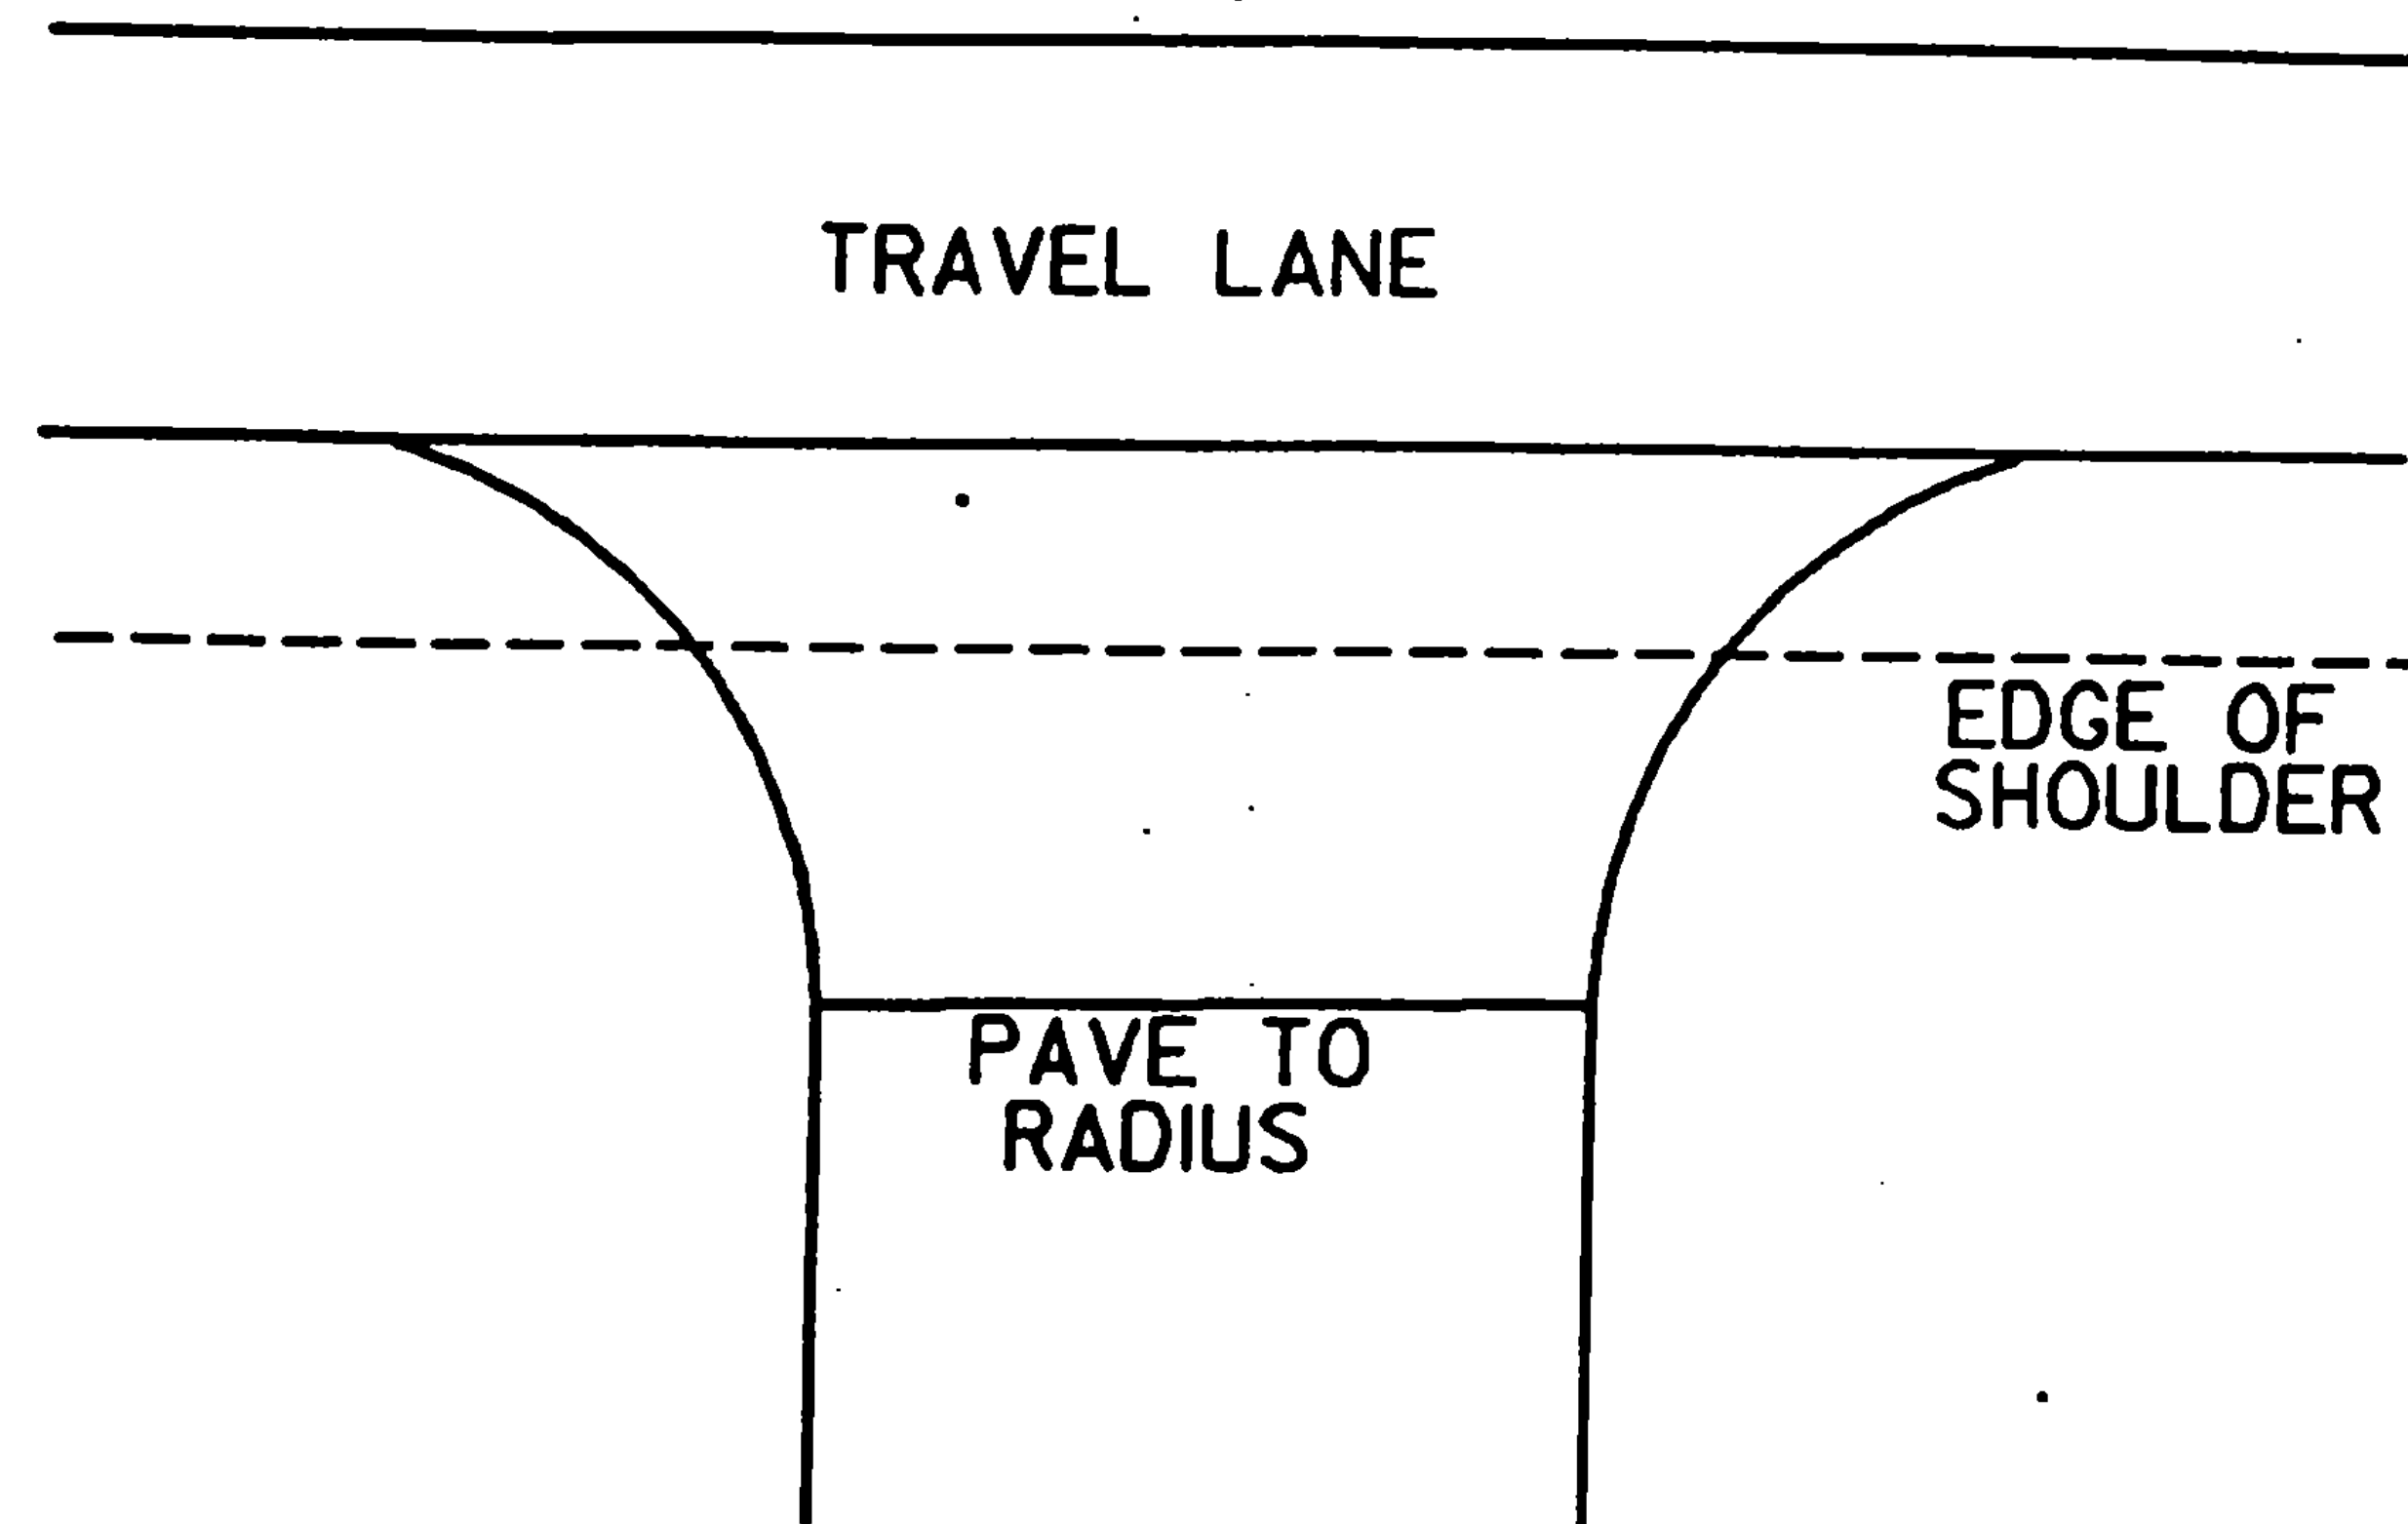

PAVING LIMITS FOR DRIVES

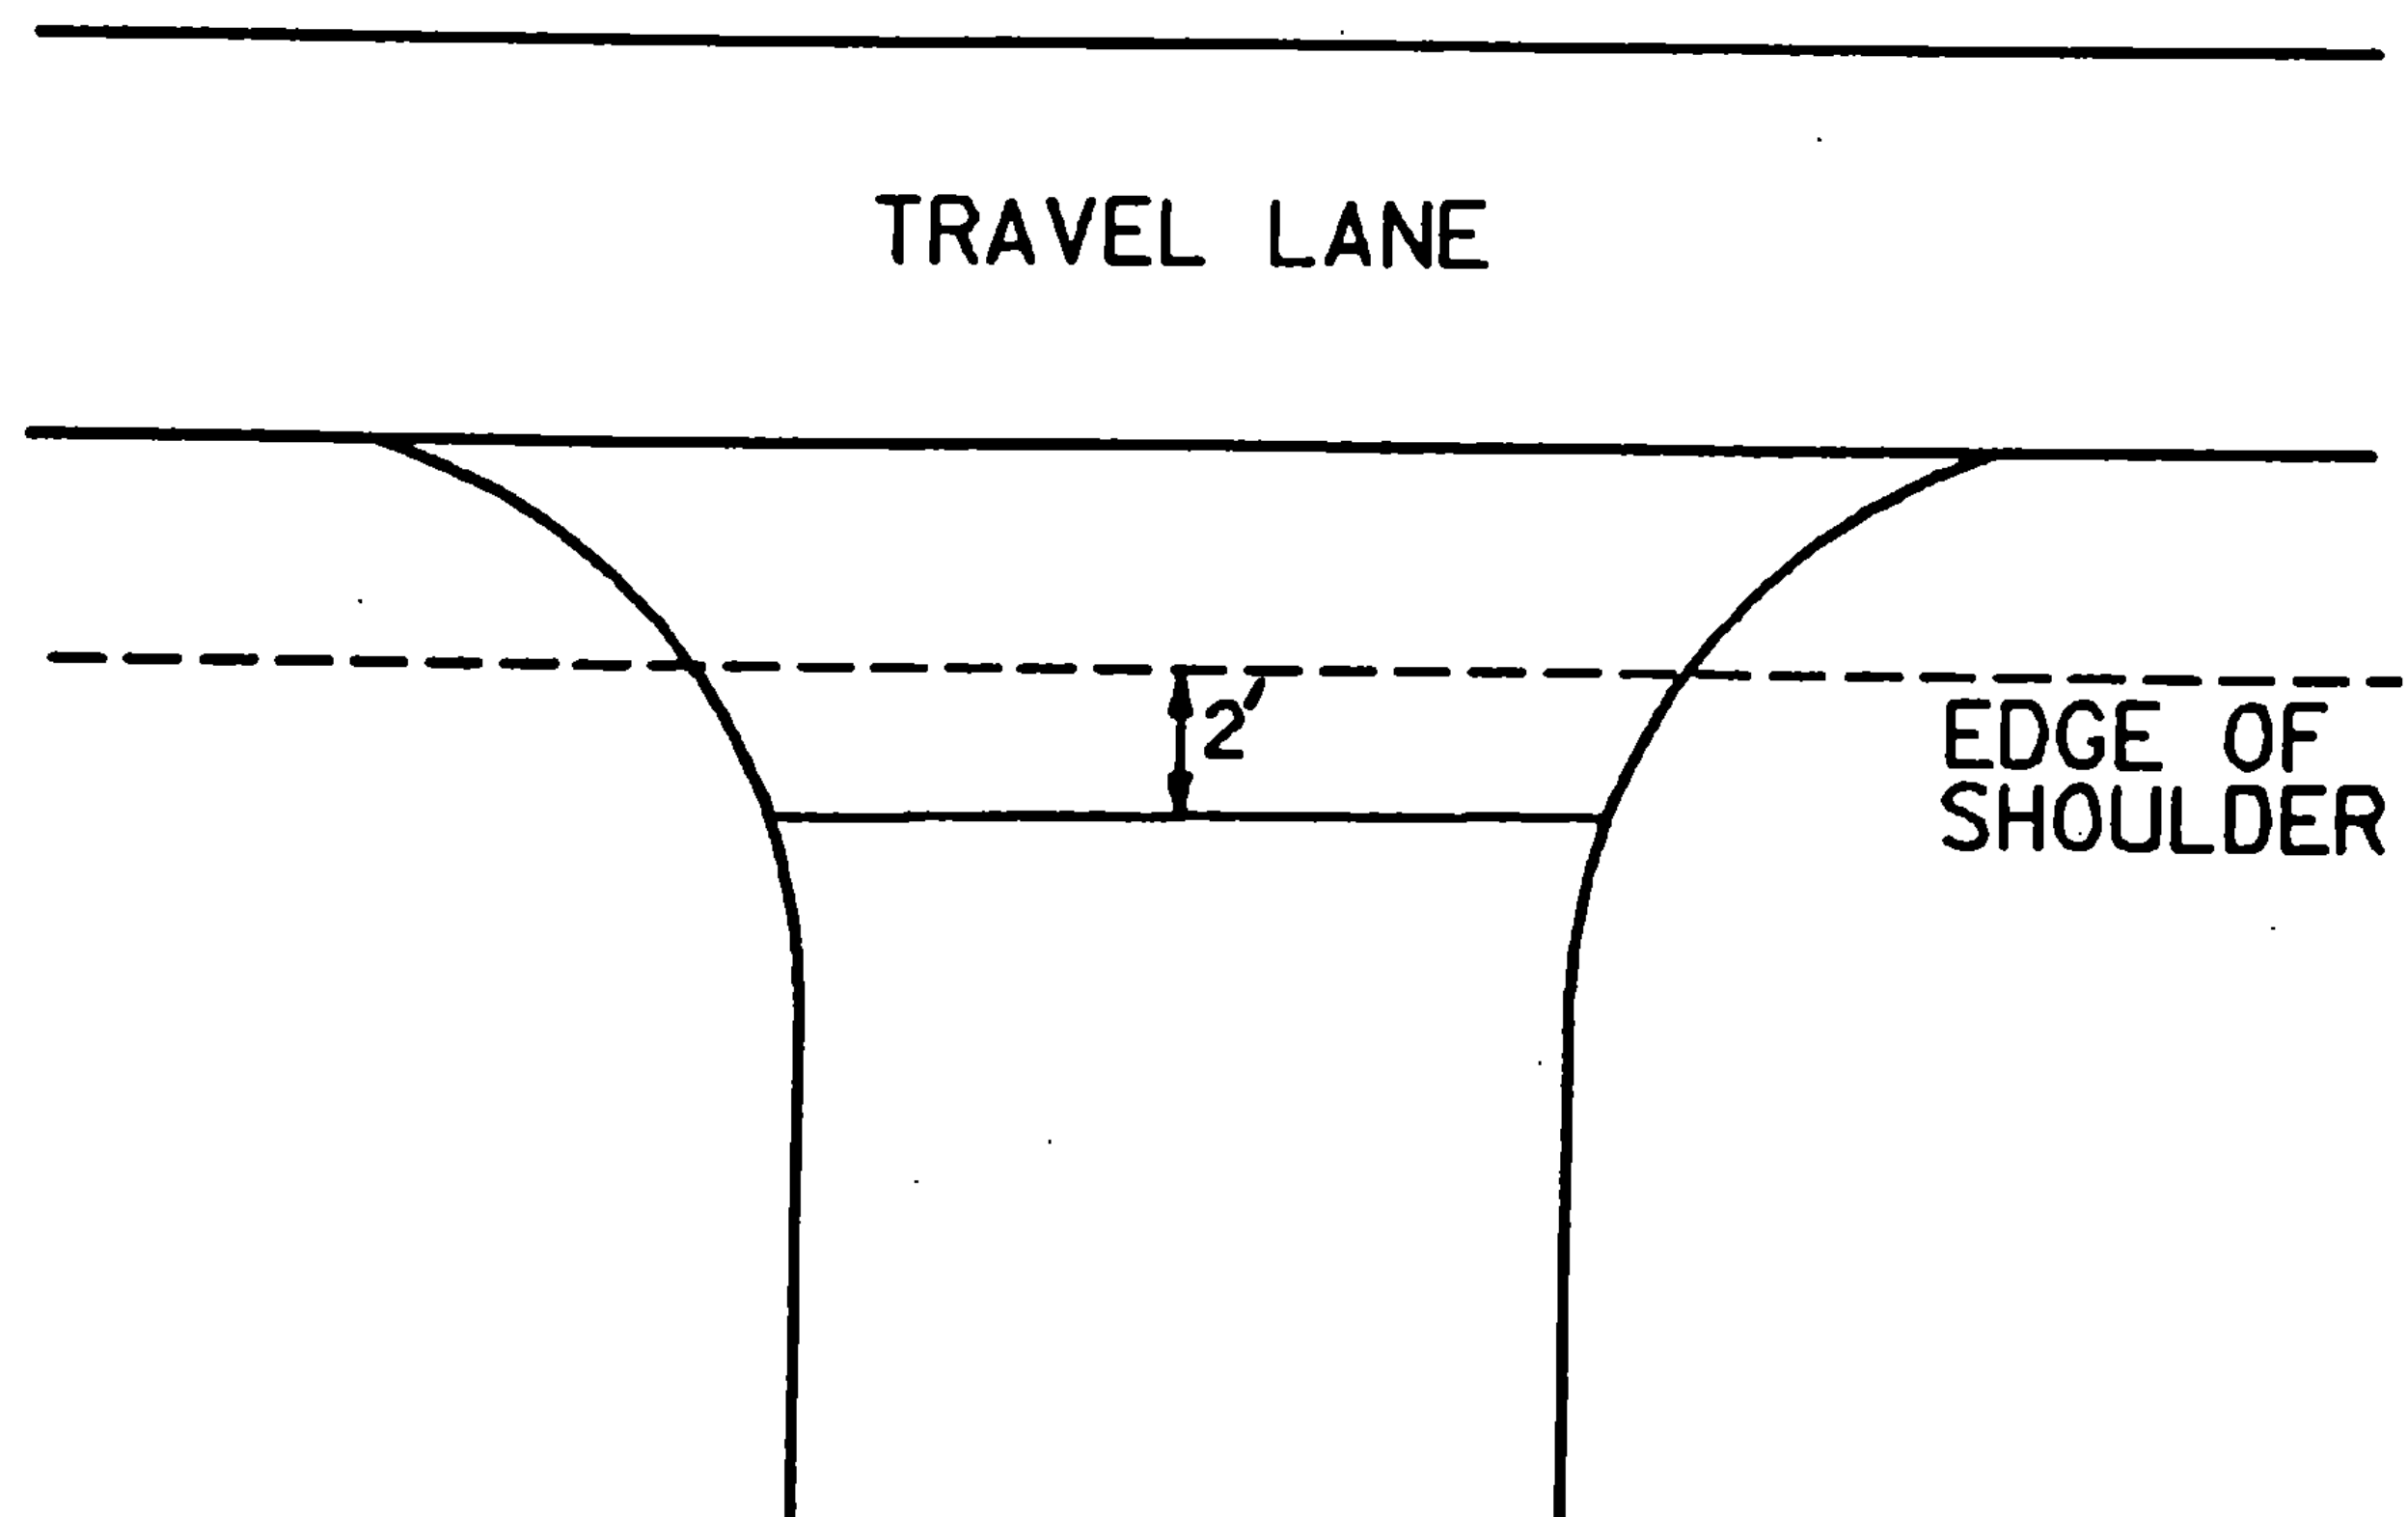

PROJECT Hancock - Granville

NO. HMA 2823

SHEET 5 OF 10 SHEETS

SHEET 17 OF 38 SHEETS

TEMPORARY 4" YELLOW LINE

[illegible]

TEMPORARY 4" WHITE LINE

[illegible]

PROJECT Hancock - Granville

NO. HMA 2823
SHEET 6 OF 10 SHEETS
SHEET 18 OF 38 SHEETS

GUIDELINES FOR MINIMUM INTERIM PAVEMENT MARKINGS
IN CONSTRUCTION ZONES

- A. CENTERLINE AND GORE AREA MARKINGS SHALL BE APPLIED AT THE END OF EACH WORKING DAY. THE FOLLOWING LAYOUT REQUIREMENTS SHALL BE MET:

NO PASSING BARRIER
SOLID STRIPES.

DASHED LINE
10-FOOT SOLID LINE WITH 30-FOOT GAP.

GORE AREA
(GORE AREAS TO INCLUDE 8' CHANNELIZING LINE AND DASHED LINE)
PER STANDARD SHEET E-50

- B. EDGE LINES

WHEN SPECIFIED, EDGE LINES ARE NOT REQUIRED UNTIL COMPLETION OF THE PROJECT. ON INTERSTATE PROJECTS, TEMPORARY EDGE LINES SHOULD BE APPLIED WHERE TRAFFIC VOLUMES AND SPEEDS ARE HIGH AND DELAY OF SEVERAL DAYS IS ANTICIPATED.

- C. TEMPORARY MARKINGS MAY CONSIST OF PAINT, TAPE OR RAISED PAVEMENT MARKERS (RPM'S). THE TAPE SHALL BE A RETRO-REFLECTIVE FILM ON A CONFORMABLE METALLIC BACKING THAT CAN BE PAVED OVER. TAPE MAY BE USED ON THE FINAL SURFACE COURSE IF IT WILL NOT INTERFERE WITH THE FINAL MARKING APPLICATION. TEMPORARY TAPE MARKINGS WILL BE OFFSET AND REMOVED WHEN PROJECT IS FINISHED AND FINAL CENTERLINE PAINTED. THE TAPE SHALL BE THE TYPE THAT IS REMOVABLE INTACT AND NOT SEPERATE AT ANY TIME. THE RPM'S SHALL HAVE A SELF-ADHESIVE BACKING EASILY REMOVED BEFORE PAVING AND SHALL CONFORM TO THE FOLLOWING LAYOUT PATTERN:

NO PASSING BARRIER
NO RPM'S ALLOWED.

DASHED LINE
FOUR RETRO-REFLECTIVE RPM'S ON 3 1/2 FOOT CENTERS WITH A 30' GAP.

SOLID LINE - EDGE LINES
INTERSTATE MEDIAN SIDE-RETRO-REFLECTIVE RPM'S ON 4 TO 5 FOOT CENTER.
DRIVERS RIGHT SIDE-RPM'S NOT ALLOWED.


- D. WHEN PAINT IS USED FOR TEMPORARY MARKING, AN ALTERNATE MATERIAL SUCH AS TAPE OR RPM'S SHALL BE ON HAND IN THE EVENT RAIN PREVENTS THE PAINT APPLICATION FROM BEING COMPLETED. ALL PAINT SHALL BE REFLECTORIZED.
- E. PAYMENT FOR PAINT AND TAPE SHALL BE COMPUTED ON A LINEAR FOOT BASIS AS IF PAINT WAS USED. PAYMENT FOR THE RPM'S SHALL BE COMPUTED AS IF AN EQUIVALENT PAINT LINE WAS USED. (FOR EXAMPLE, DASHED LINE PAID AS 10 FEET OF PAINT, SOLID LINE PAID AS THE TOTAL DISTANCE COVERED WITH THE MARKERS).
- F. PRIOR TO ACCEPTANCE, THE PAVEMENT MARKINGS SHALL BE COMPLETED FOR THE ENTIRE PROJECT BY THE CONTRACTOR AS DETAILED ON THE PLANS OR DIRECTED BY THE RESIDENT ENGINEER.

REVISED
02/11/85


HMA 2823

Sheet 7 of 10 Sheets
Sheet 19 of 38 Sheets

Hancock-Granville

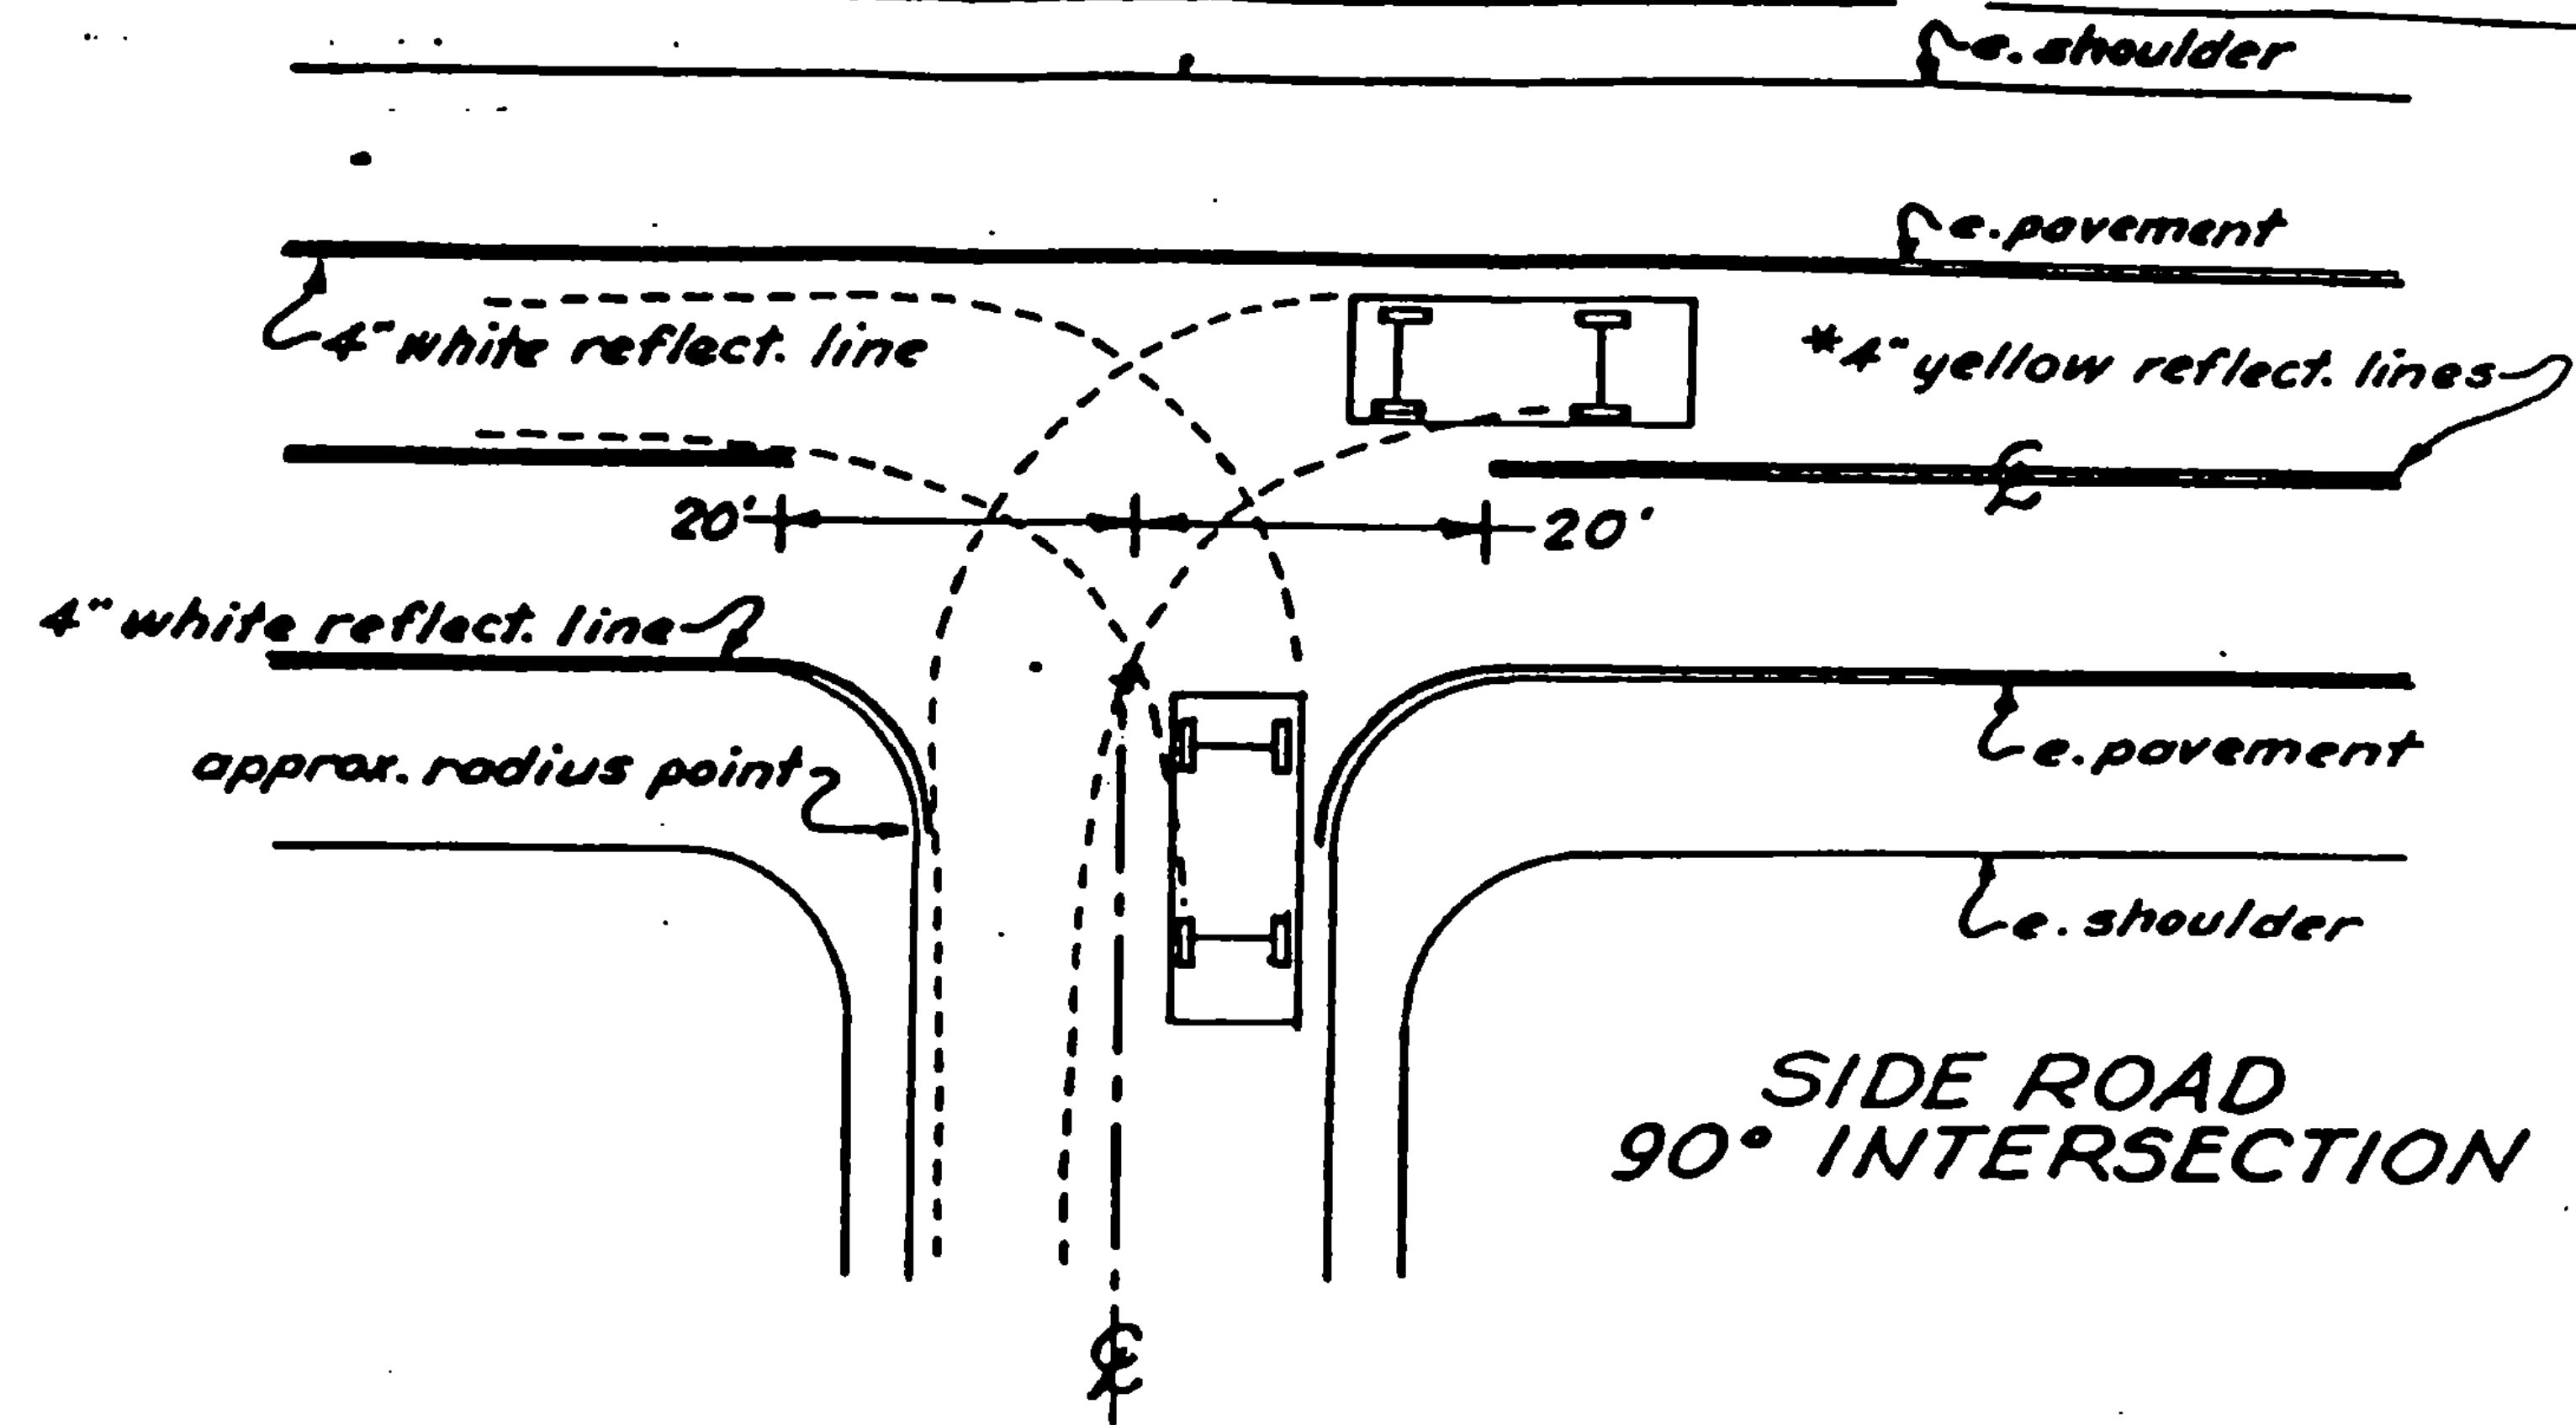

* Centerline treatment shall consist of a minimum of 400 feet of solid line in advance of the intersection and shall be paired with either a solid or dashed line depending on sight distance availability in the opposing lane.

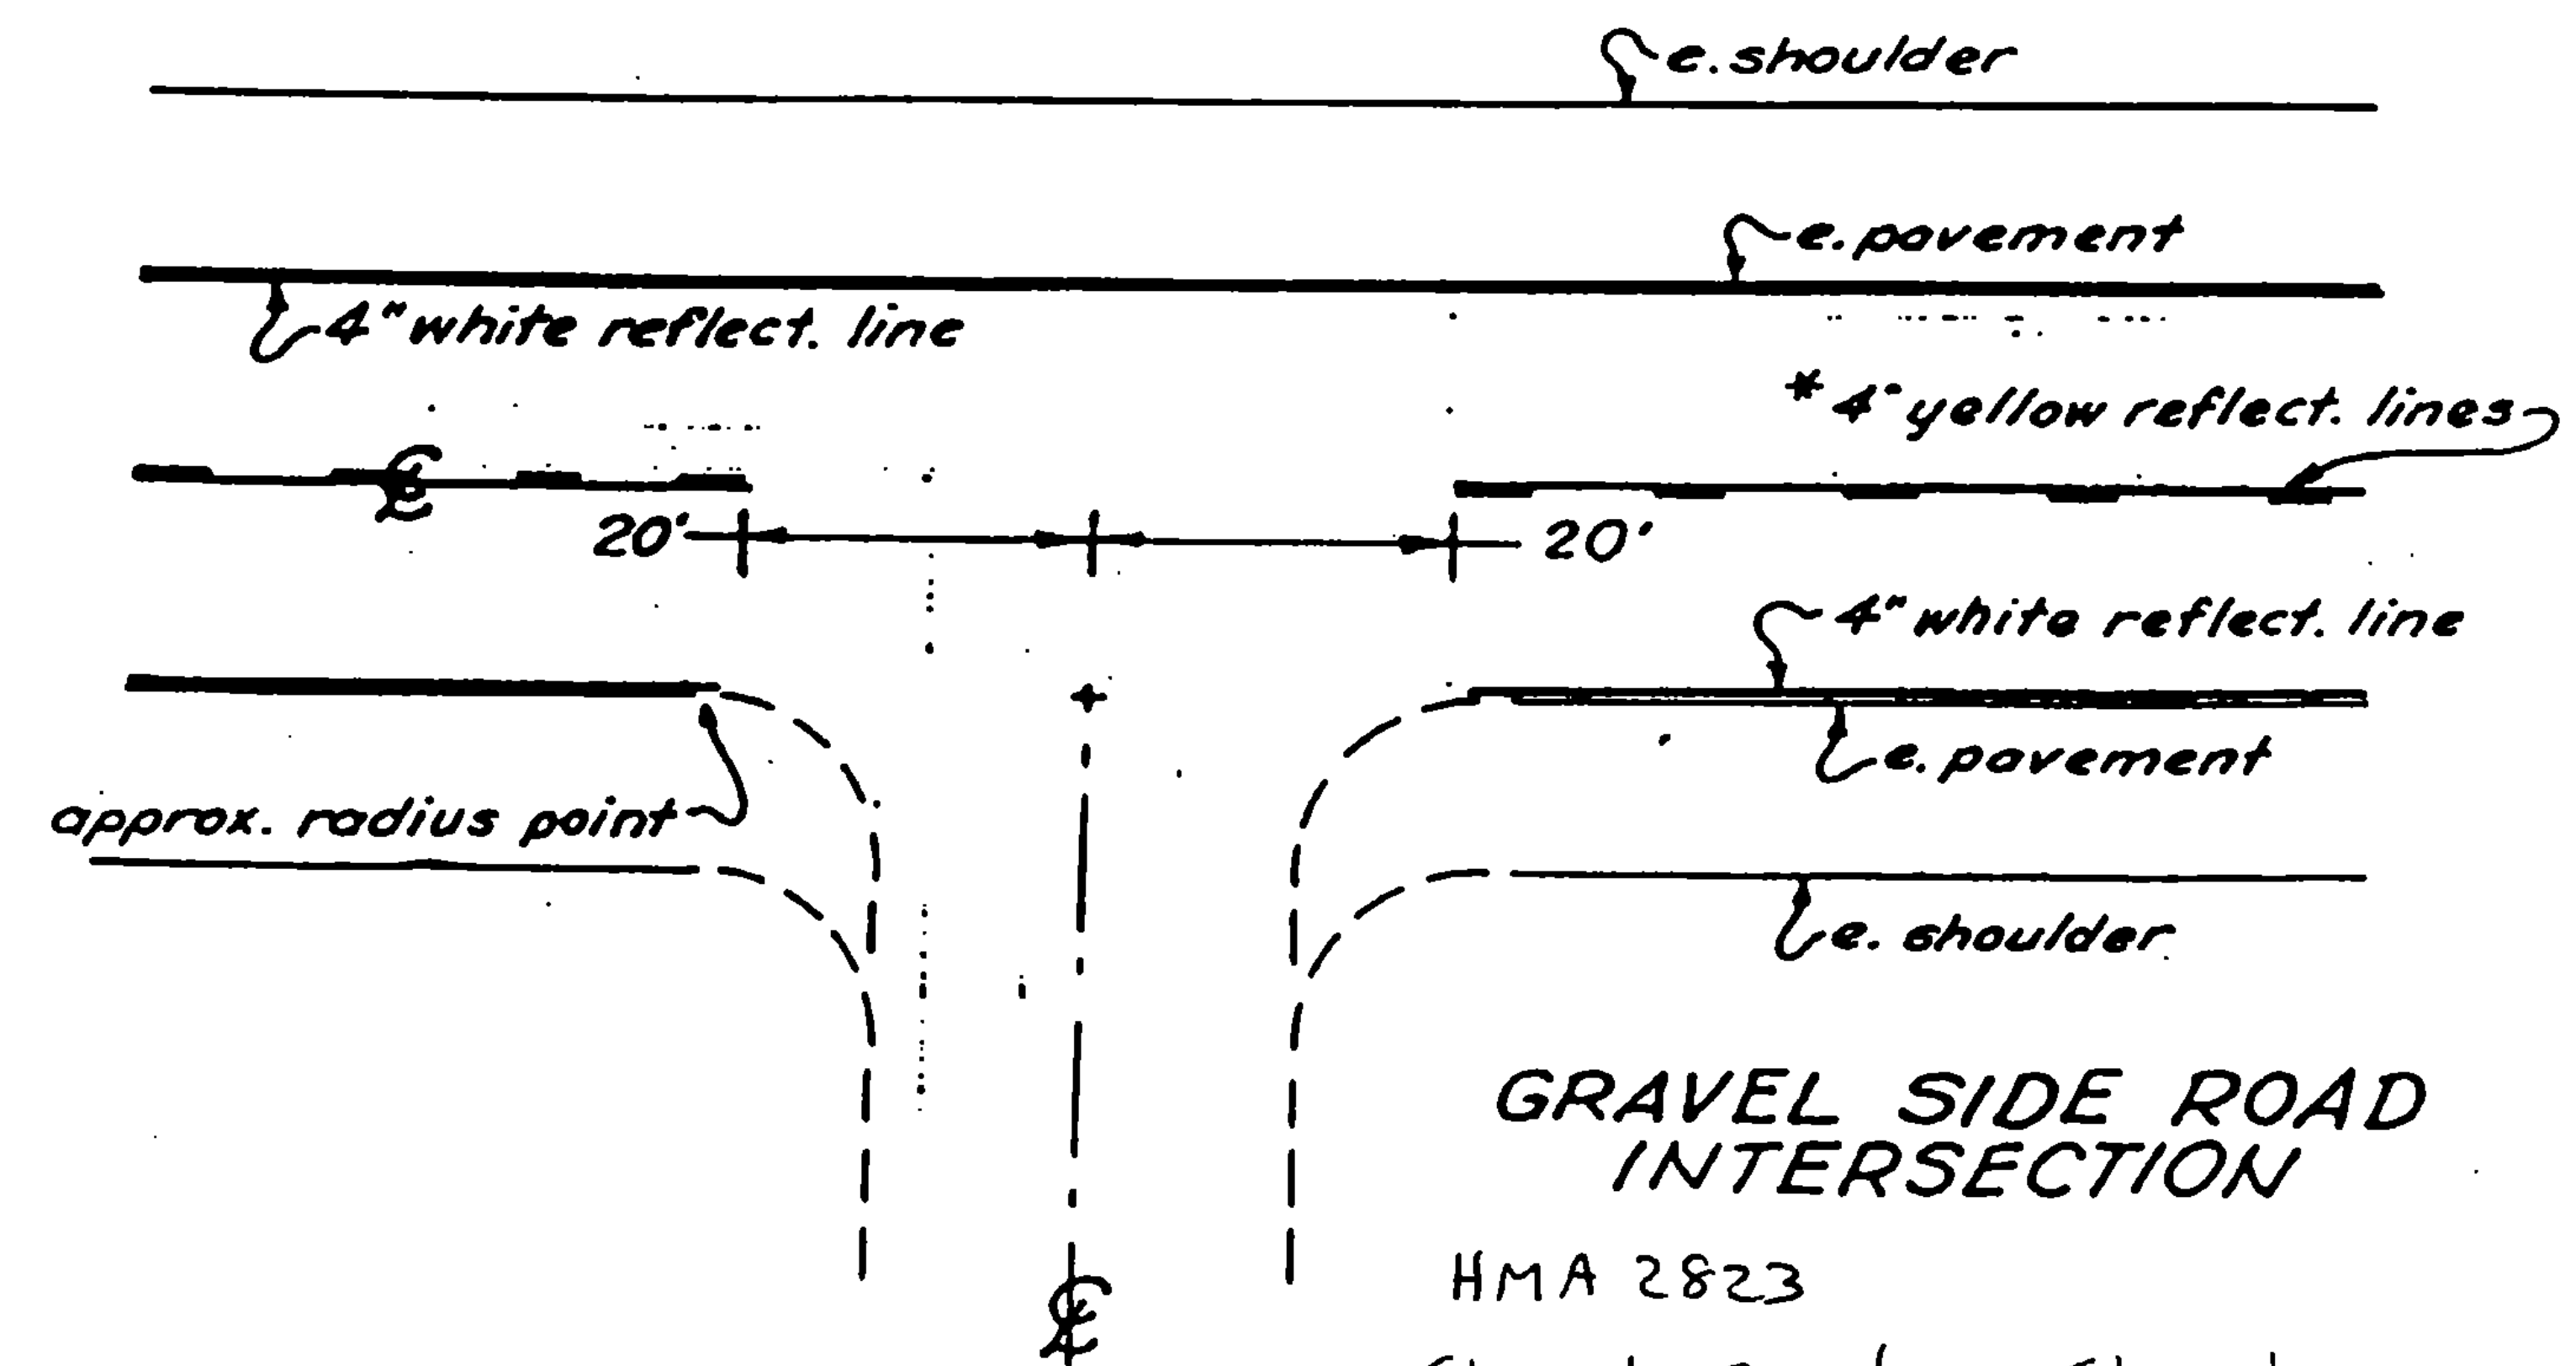

GRAVEL SIDE ROAD INTERSECTION

HMA 2823
Sheet 8 of 10 Sheets
Sheet 20 of 38 Sheets

ITEM DESCRIPTION

SHEET 9 OF 10 SHEETS
SHEET 21 OF 38 SHEETS

PROJECT LENGTHS AND ITEM QUANTITIES

ITEM DESCRIPTION

ION

Temporary 4" White Line

Temporary 4" Yellow Line


[illegible]

PROJECT Hancock - Granville

NO. HMA 2823

SHEET 10 OF 10 SHEETS
SHEET 22 OF 38 SHEETS

STATE OF VERMONT
AGENCY OF TRANSPORTATION

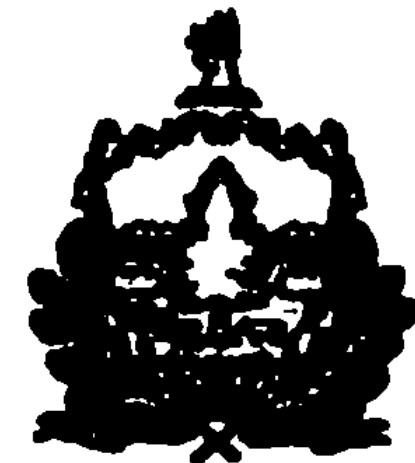


PROPOSED IMPROVEMENT

TOWN OF Rochester - Hancock

COUNTY OF Windsor - Addison

ROUTE NO. VT 100

ROUTE CLASS EAP

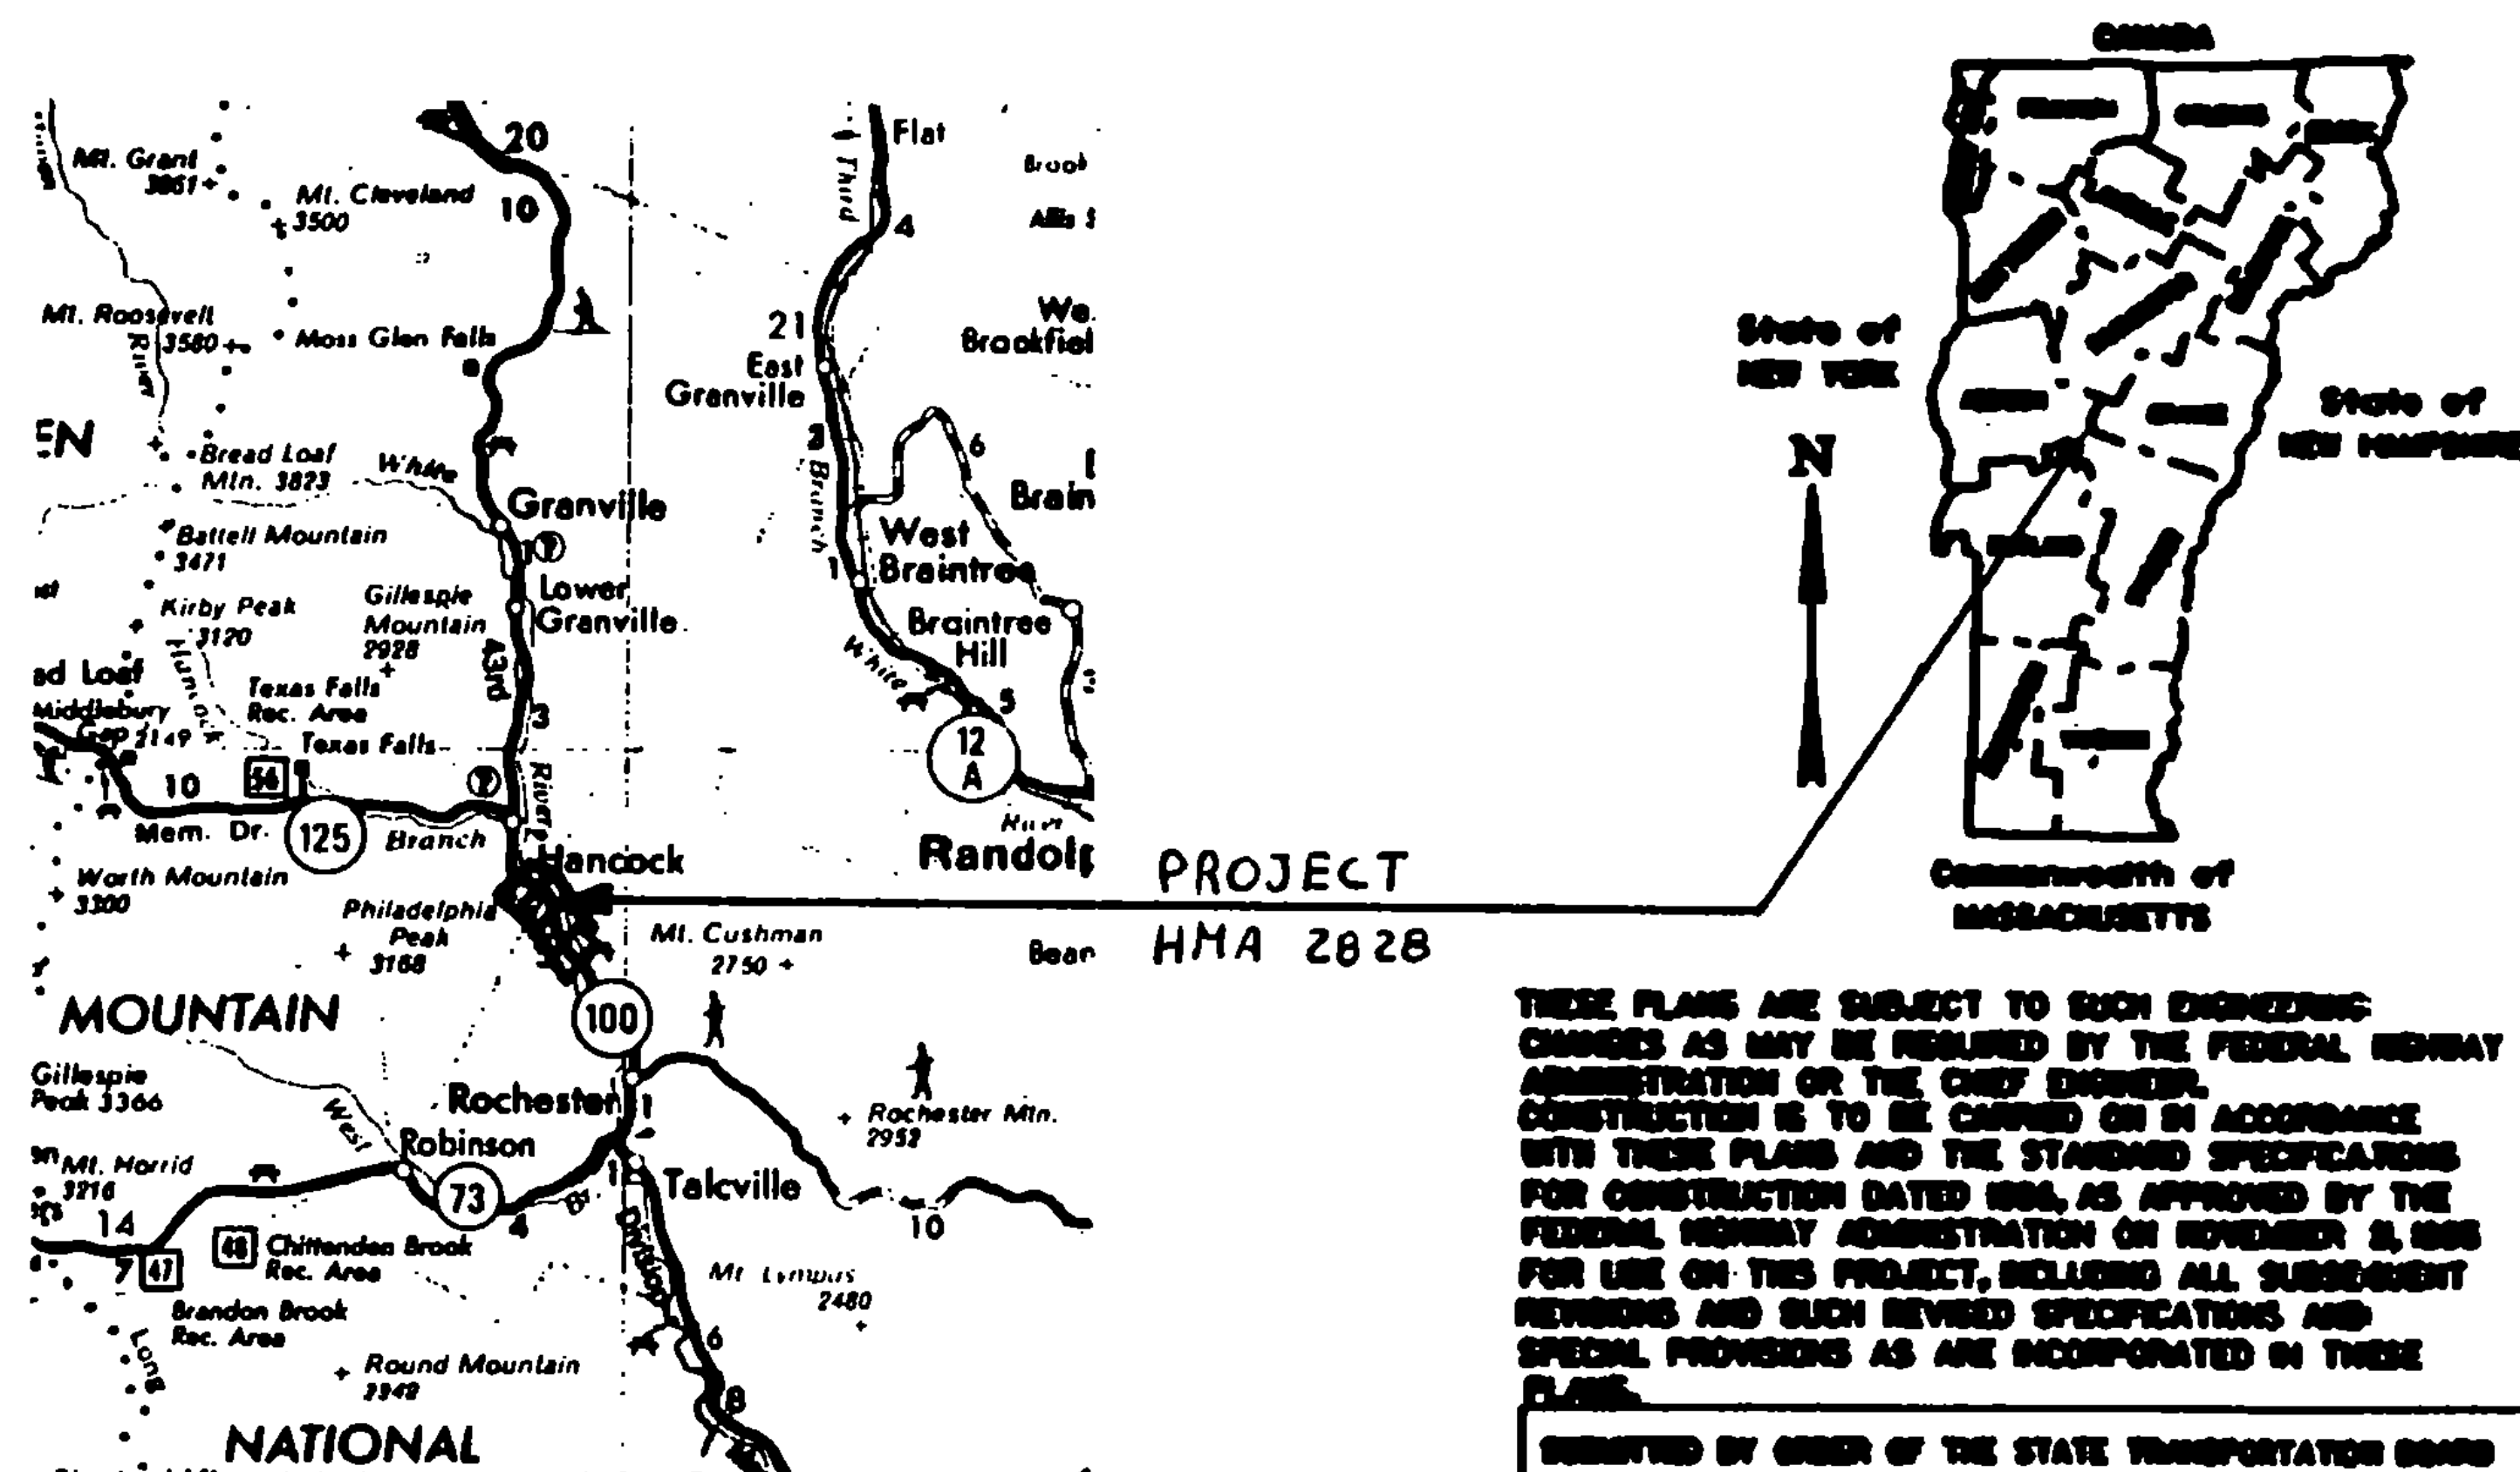

PROJECT
HMA 2828

THESE PLANS ARE SUBJECT TO SUCH ENGINEERING
CHANGES AS MAY BE REQUIRED BY THE FEDERAL HIGHWAY
ADMINISTRATION OR THE CHIEF ENGINEER.
CONSTRUCTION IS TO BE CARRIED ON IN ACCORDANCE
WITH THESE PLANS AND THE STANDARD SPECIFICATIONS
FOR CONSTRUCTION DATED 1964, AS APPROVED BY THE
FEDERAL HIGHWAY ADMINISTRATION ON NOVEMBER 8, 1965
FOR USE ON THIS PROJECT, INCLUDING ALL SUBSEQUENT
REVISIONS AND SUCH REVISED SPECIFICATIONS AND
SPECIAL PROVISIONS AS ARE INCORPORATED IN THESE
PLANS.

DESIGNED BY ORDER OF THE STATE TRANSPORTATION BOARD

APPROVED _____ DATE _____
CHIEF ENGINEER

DEPARTMENT OF TRANSPORTATION
FEDERAL HIGHWAY ADMINISTRATION

APPROVED _____ DATE _____
DIVISION ADMINISTRATOR

Rochester - Hancock
PROJECT HMA 2828

SHEET 1 OF 10 SHEETS

See Sheet 1 For Index

SHEET 23 OF 38 SHEETS

INDEX . OF SHEETS


- 1. Title Page
- 2. Index Of Sheets
- 3. Description And Location
- 4. Typical Sections And Design Data
- 5. Paving Limits For Drives And Town Roads
- 6. Pavement Marking Locations
- 7. Guidelines For Minimum Interim Pavement Markings In Construction Zones
- 8. Mainline Pavement Marking At Intersecting Side Road
- 9.-10. Project Lengths And Item Quantities

PROJECT Rochester-Hancock

NO. HMA 2828
SHEET 2 OF 10 SHEETS

SHEET 24 OF 38 SHEETS

DESCRIPTION AND LOCATION

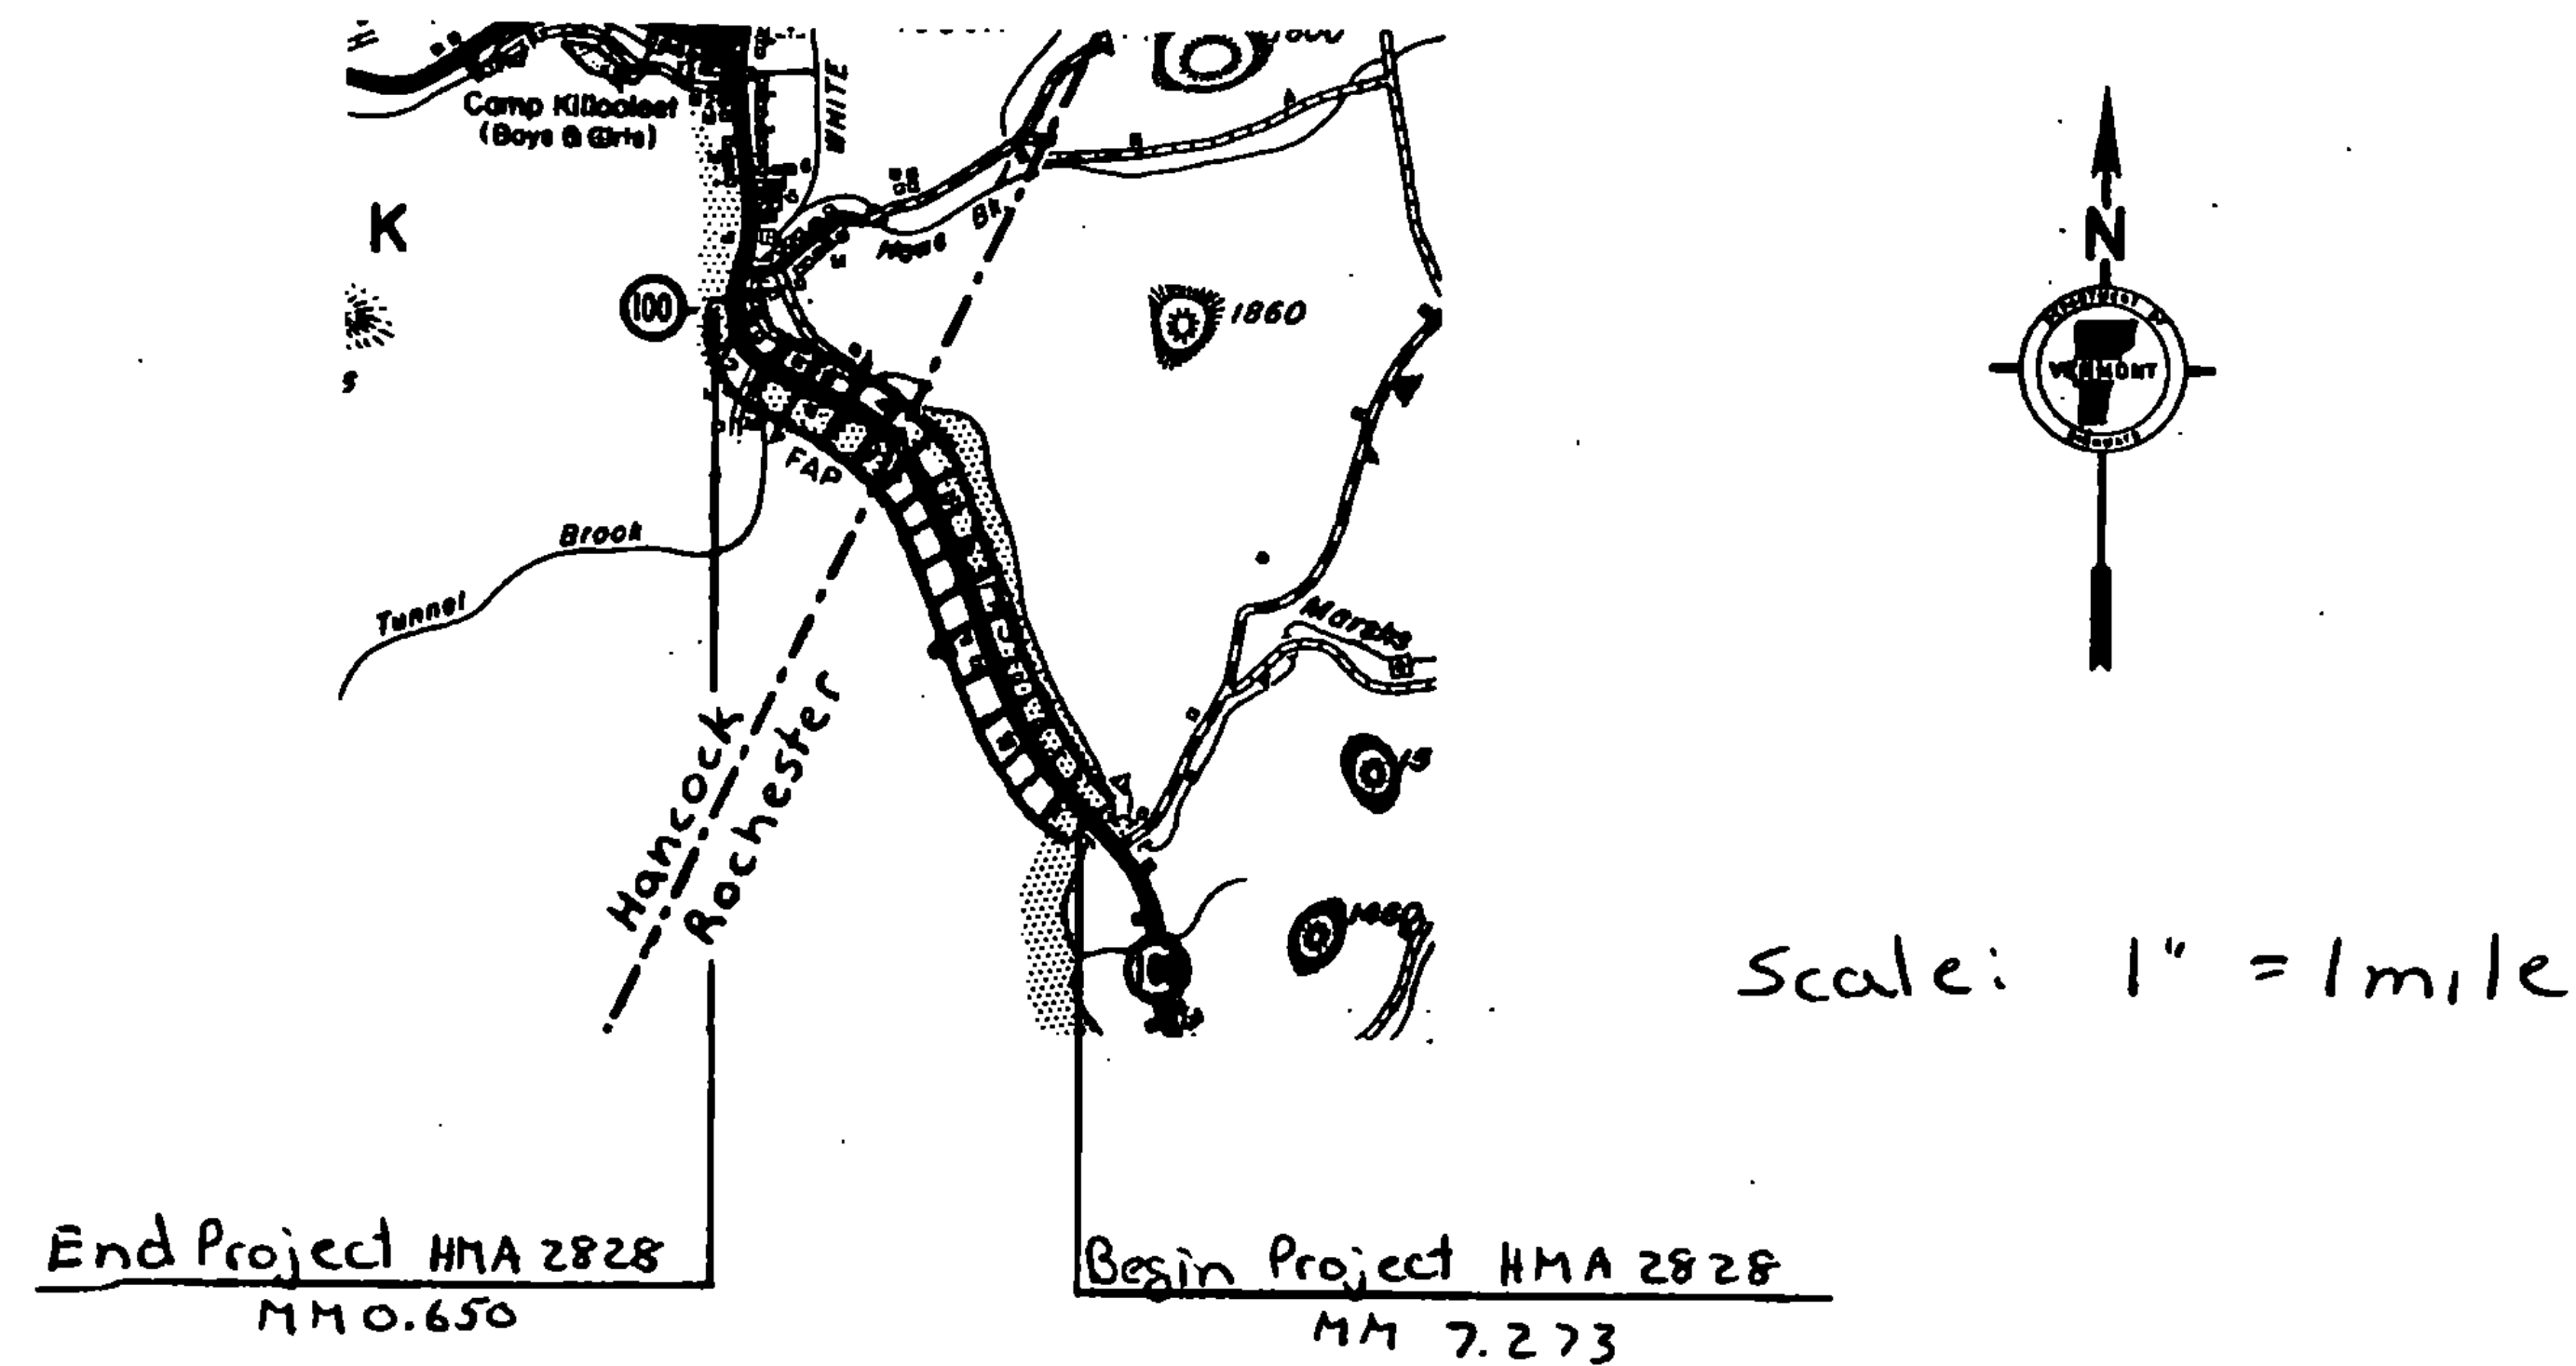

Beginning at a point on UT 100, 1.080 miles southerly of the Rochester-Hancock town line and extending northerly 1.730 miles to MM 0.650 in the town of Hancock

Work consists of resurfacing of the highway, including shoulders, and new pavement markings.

1986 ADT 2410

Length Of Project 1.730 miles
9134 feet

PROJECT Rochester-Hancock


NO. HMA 2828

SHEET 3 OF 10 SHEETS

SHEET 25 OF 38 SHEETS

TYPICAL SECTIONS & DESIGN DATA

BITUMINOUS CONCRETE PAVEMENT
 LEVELING COURSE TYPE IV (295 TONS/MILE)
 AS DIRECTED BY THE ENGINEER.
 1 1/4" WEARING COURSE TYPE III (±1/4" THICKNESS TOLERANCE)

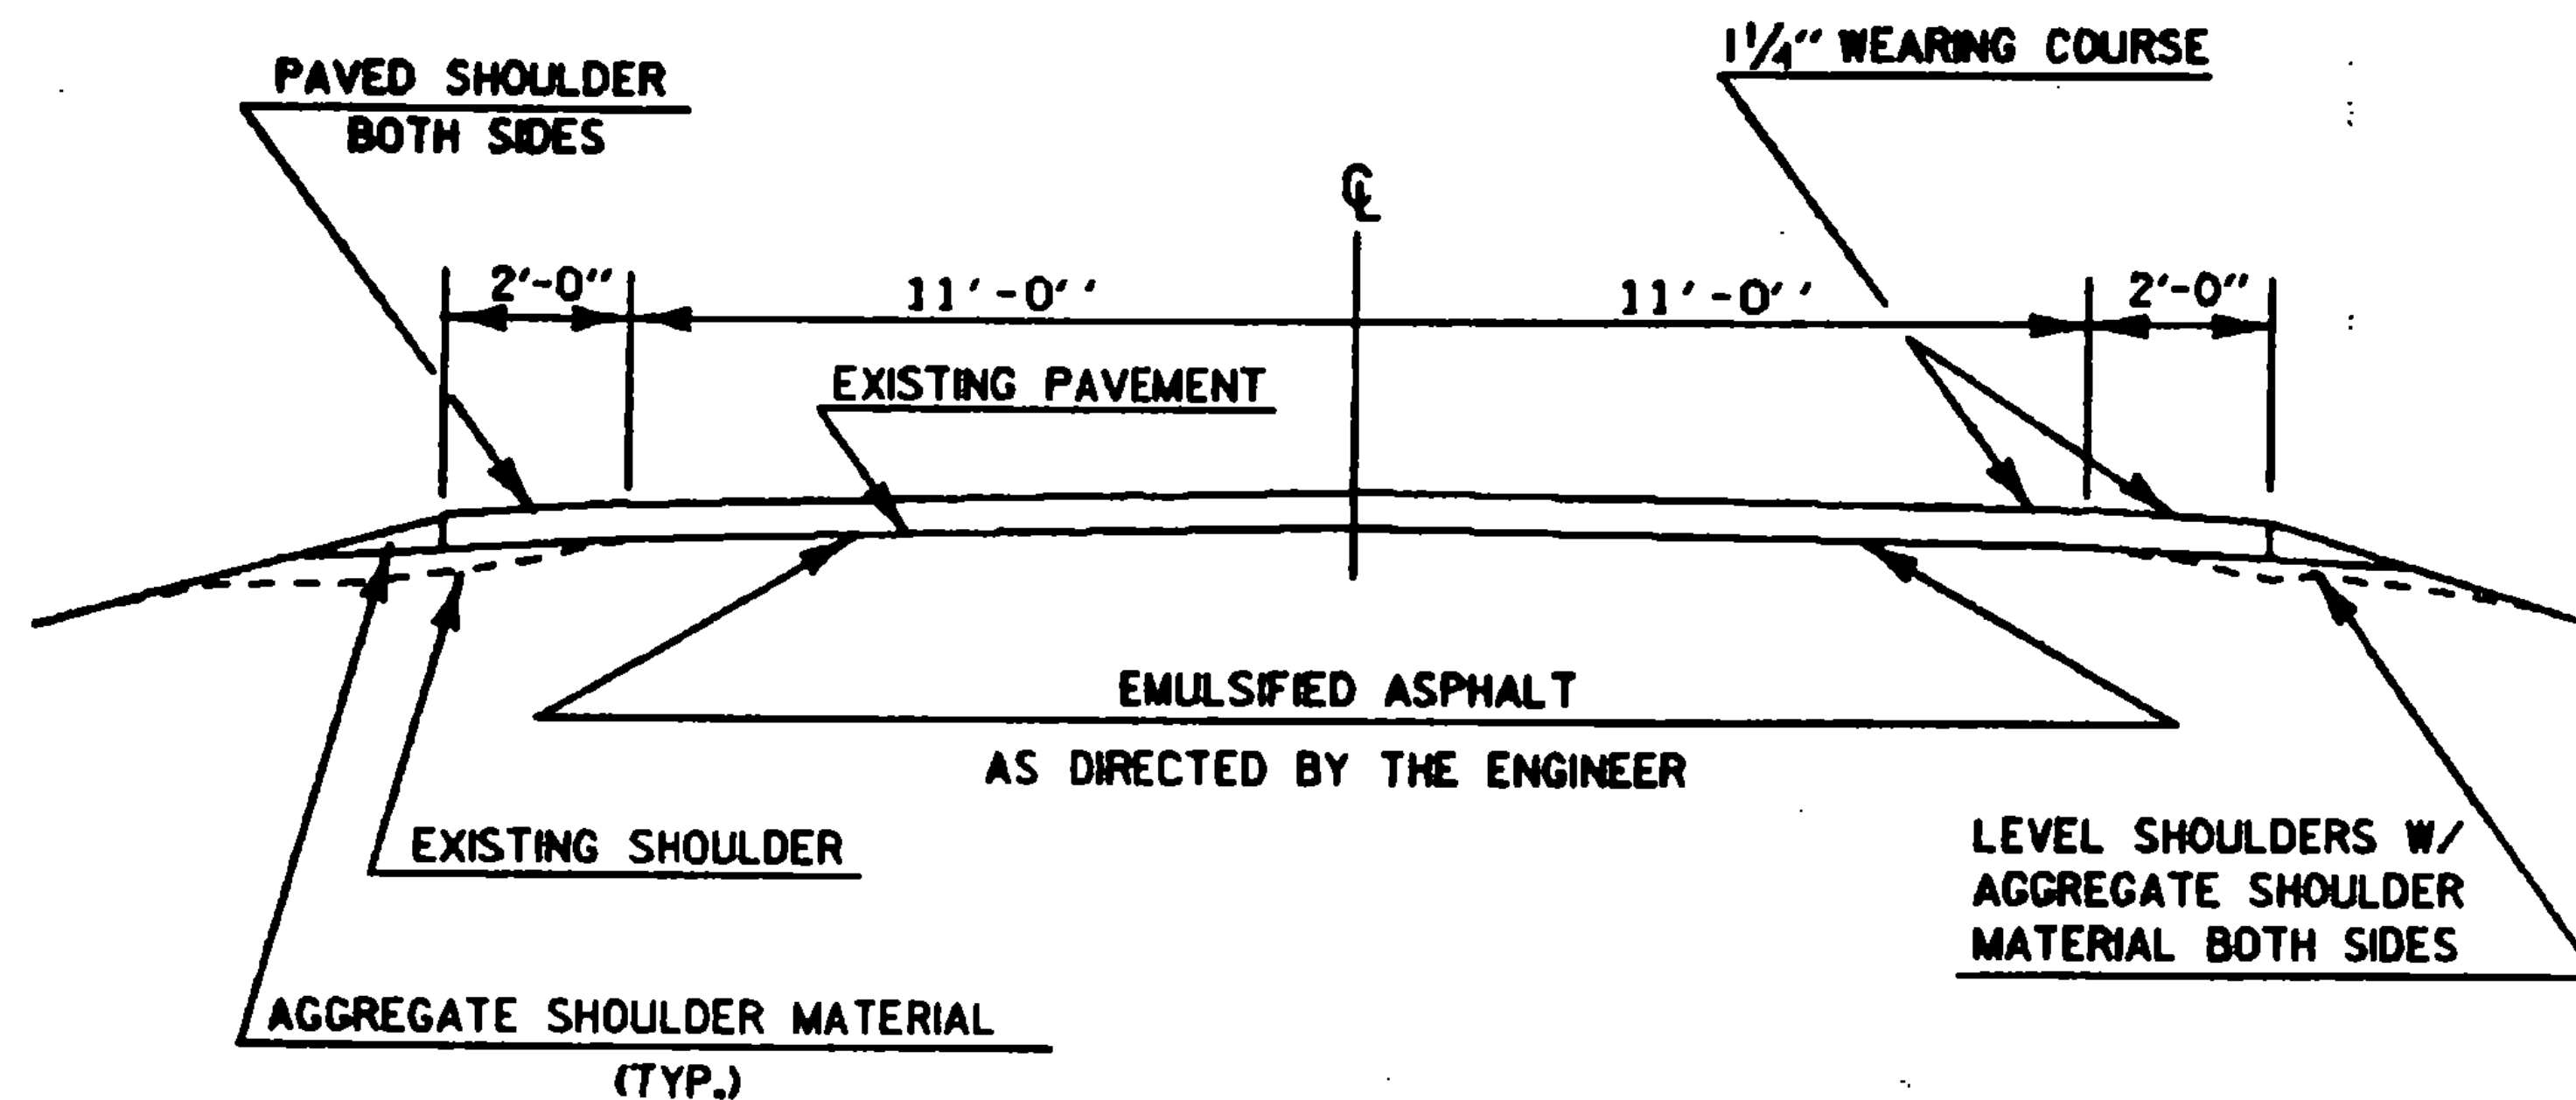

ROCHESTER HANCOCK
 VT. 100 MM 7.273 ~ MM 0.650


NOTE : WHEN ENCOUNTERING VEGETATION OR POOR MATERIAL IN THE SHOULDER AREA,
 REMOVE 2" BELOW EXISTING PAVEMENT LEVEL AND REPLACE WITH AGGREGATE
 SHOULDER MATERIAL. REMOVAL OF THIS MATERIAL WILL BE PAID FOR UNDER
 THE ITEM 'ALL PURPOSE EXCAVATOR RENTAL' OR 'GRADER RENTAL'.

PROJECT ROCHESTER-HANCOCK


NO. HMA 2828
 SHEET 4 OF 10 SHEETS
 SHEET 26 OF 38 SHEETS

PAVING LIMITS FOR DRIVES & TOWN ROADS

PAVING LIMITS FOR TOWN ROADS

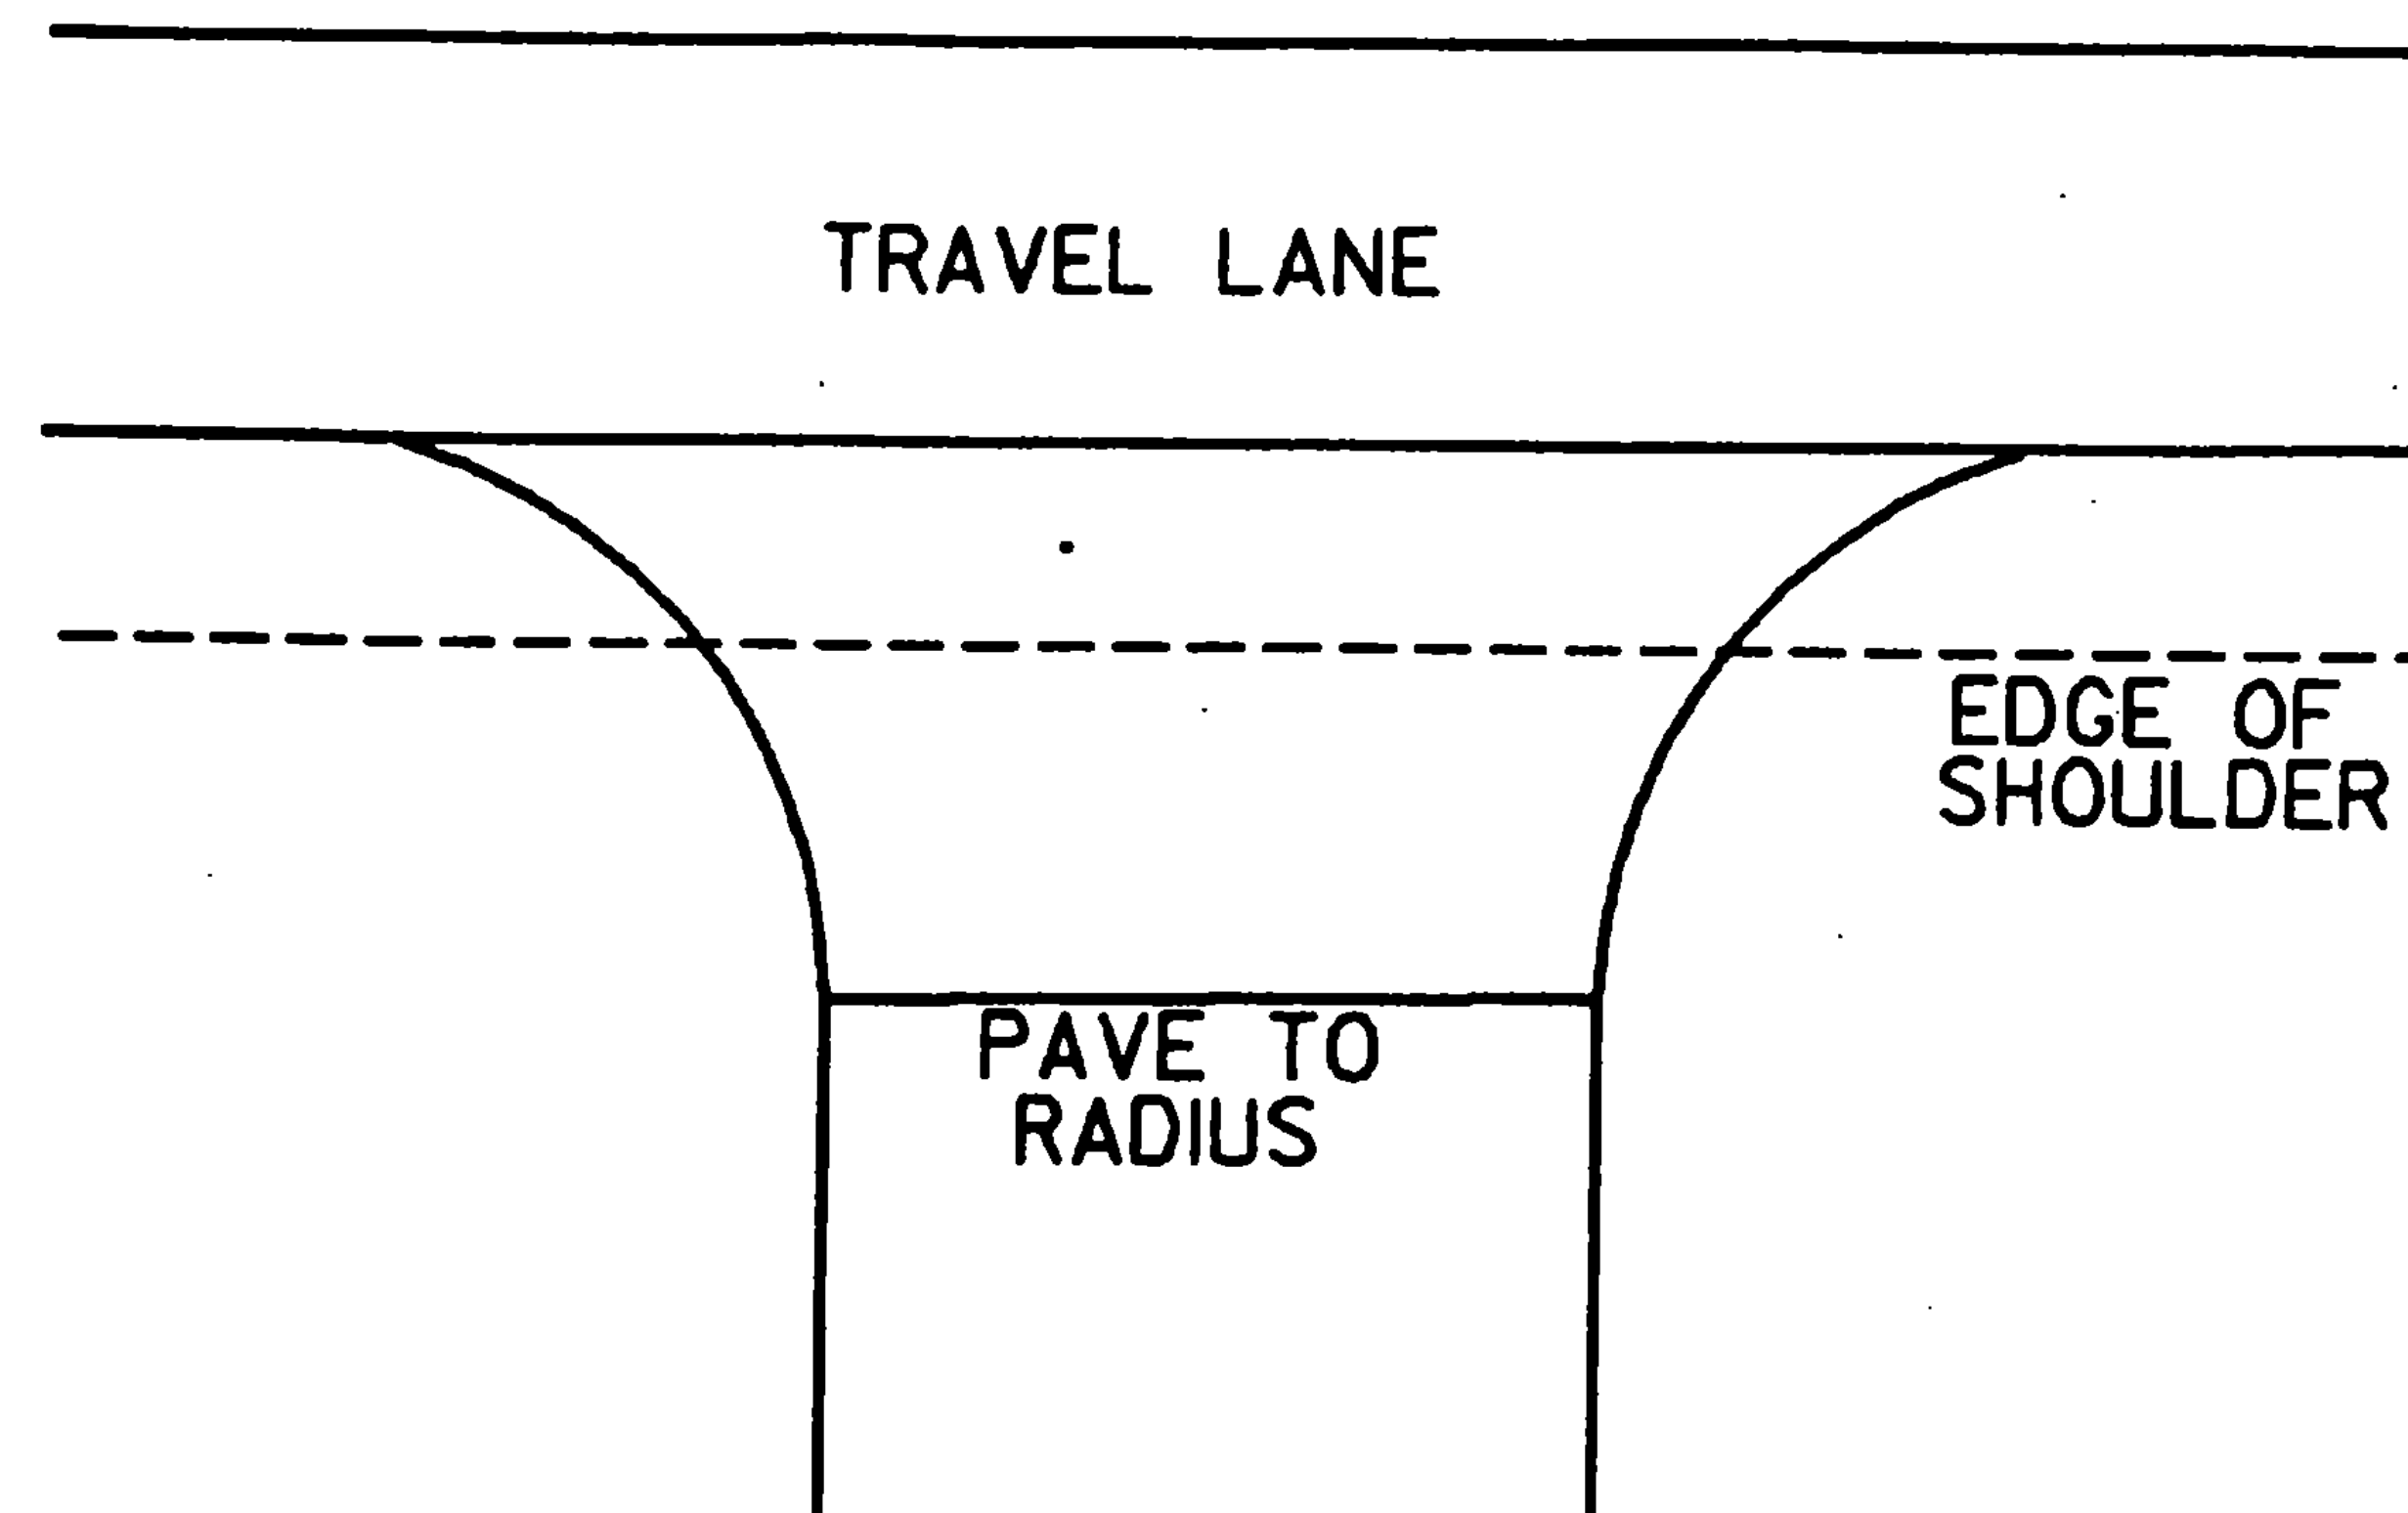

PAVING LIMITS FOR DRIVES

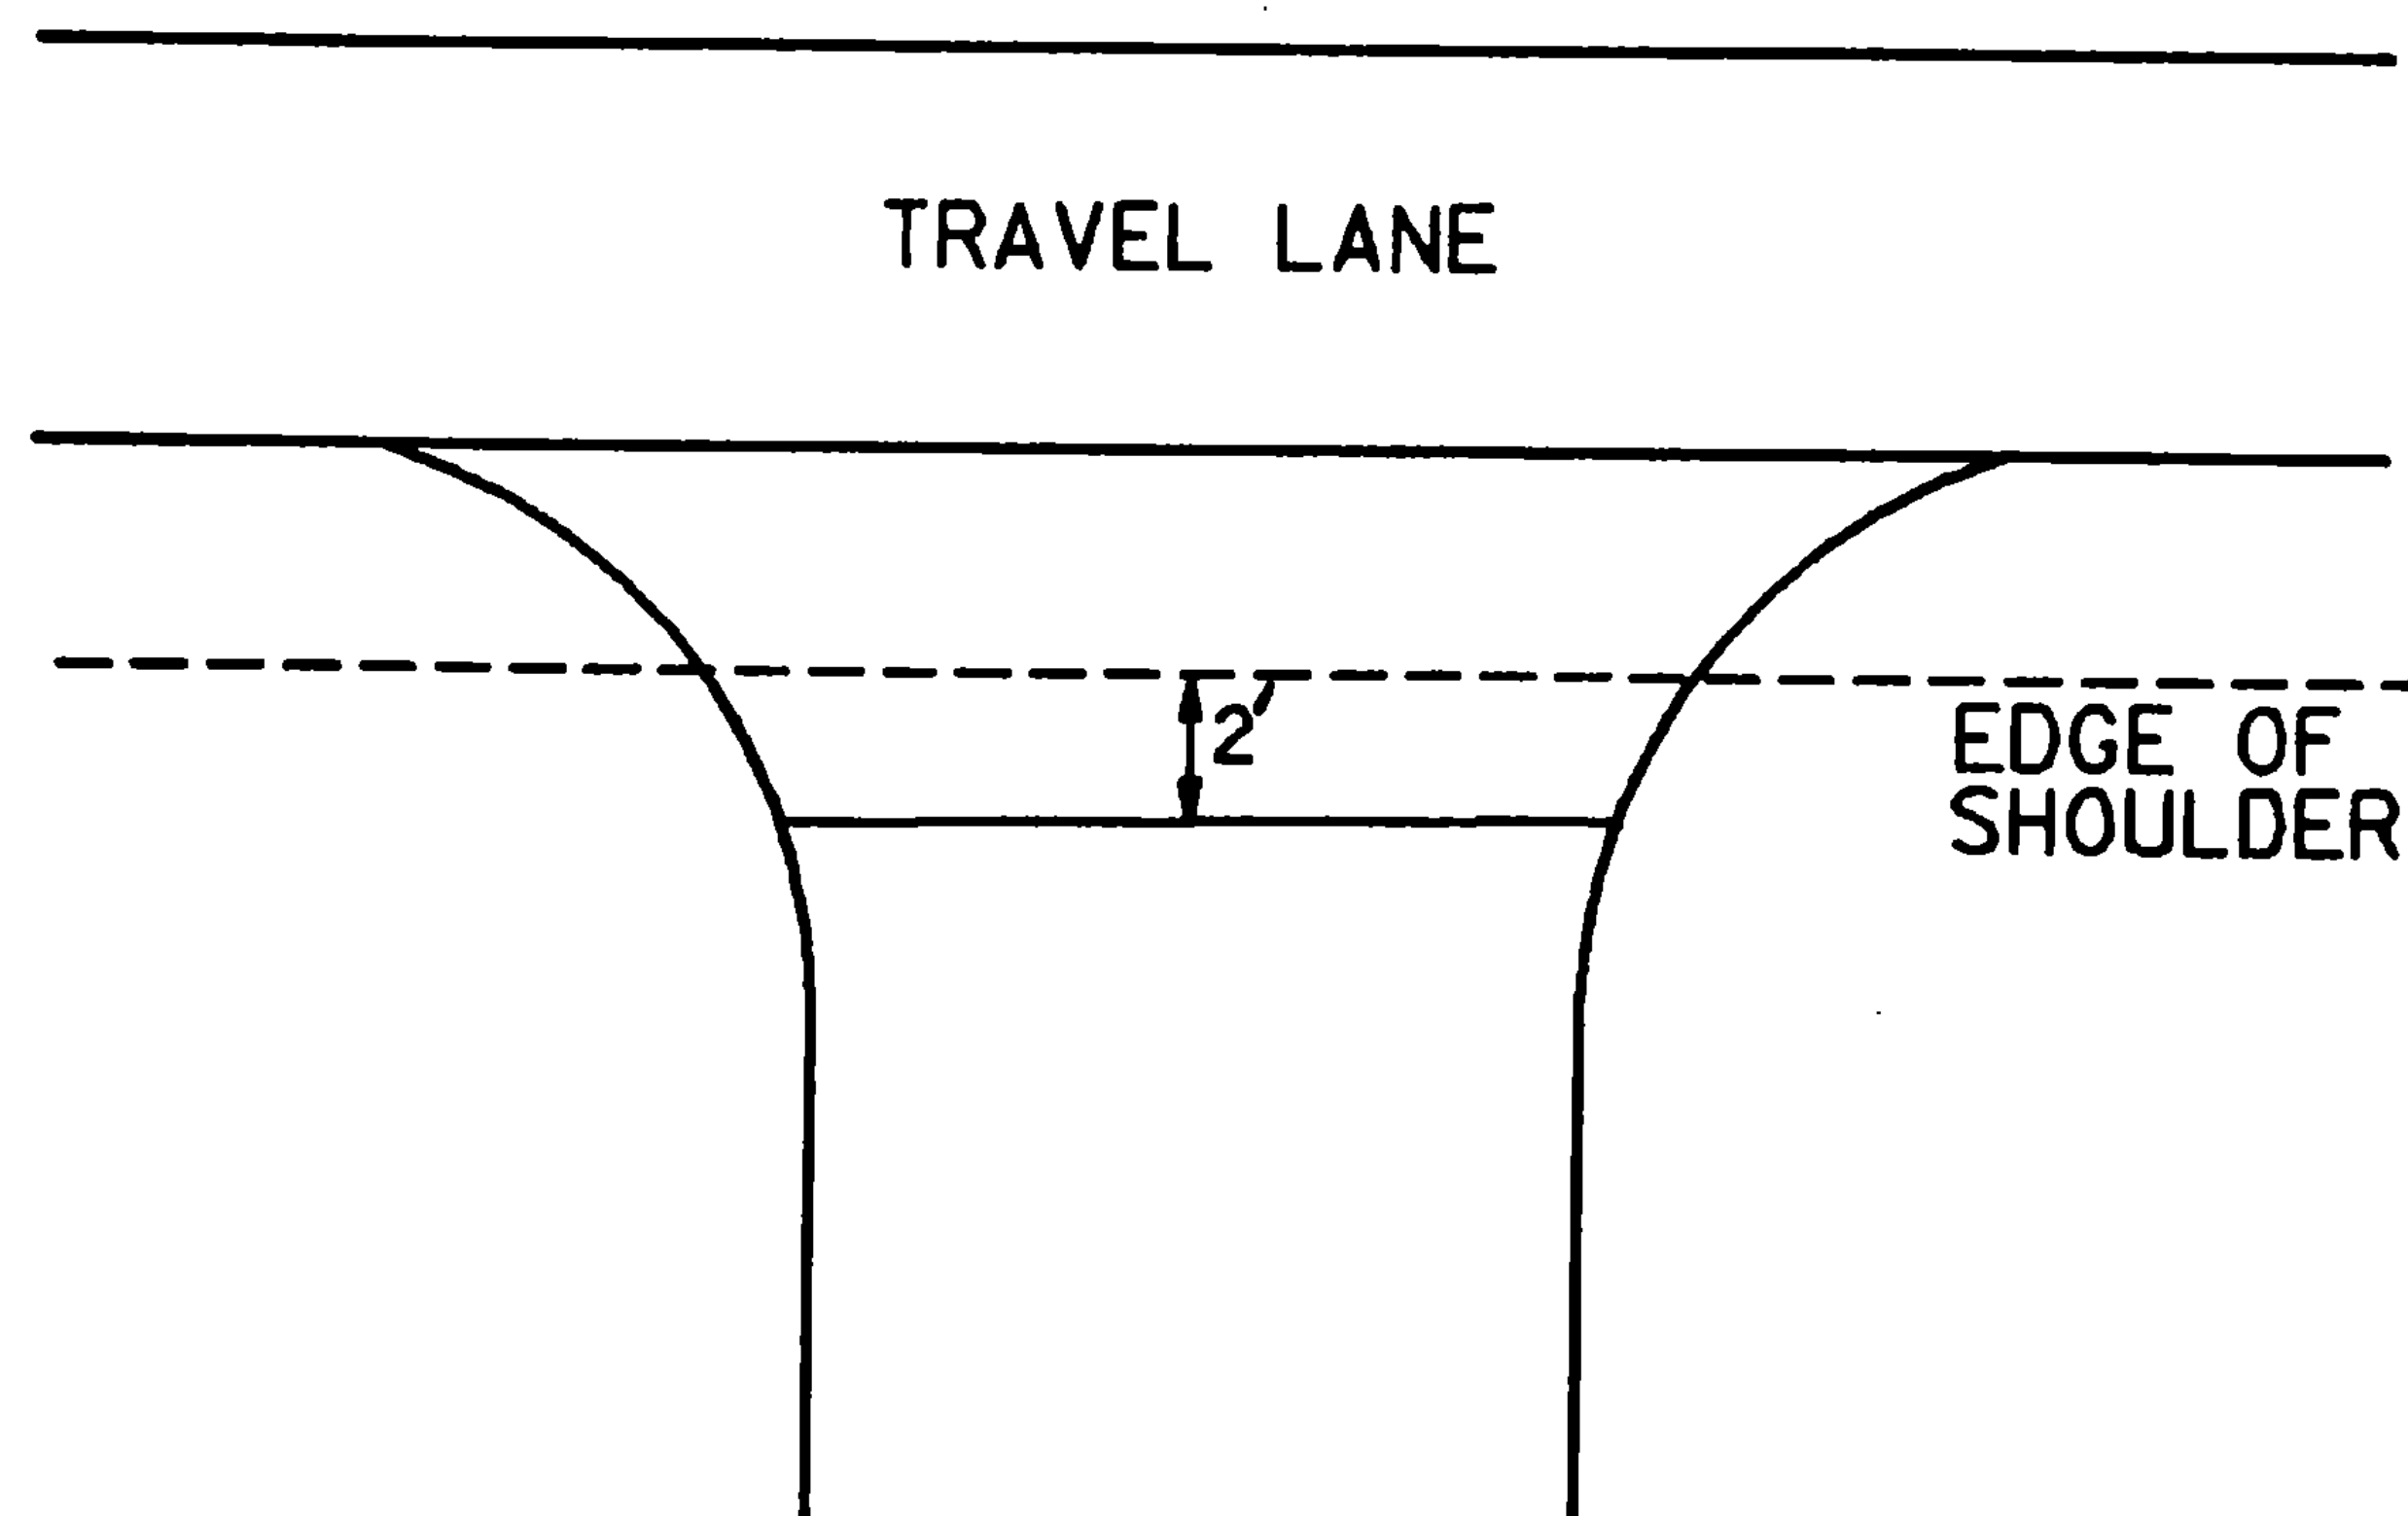

PROJECT Rochester - Hancock

NO. HMA 2828

SHEET 5 OF 10 SHEETS

SHEET 27 OF 38 SHEETS

TEMPORARY 4" YELLOW LINE

[illegible]

TEMPORARY 4" WHITE LINE

[illegible]

PROJECT Rochester - Hancock

NO. HMA 2828
SHEET 6 OF 10 SHEETS
SHEET 28 OF 39 SHEETS

GUIDELINES FOR MINIMUM INTERIM PAVEMENT MARKINGS
IN CONSTRUCTION ZONES

- A. CENTERLINE AND GORE AREA MARKINGS SHALL BE APPLIED AT THE END OF EACH WORKING DAY. THE FOLLOWING LAYOUT REQUIREMENTS SHALL BE MET:

NO PASSING BARRIER
SOLID STRIPES.

DASHED LINE
10-FOOT SOLID LINE WITH 30-FOOT GAP.

GORE AREA
(GORE AREAS TO INCLUDE 8' CHANNELIZING LINE AND DASHED LINE)
PER STANDARD SHEET E-50

- B. EDGE LINES

WHEN SPECIFIED, EDGE LINES ARE NOT REQUIRED UNTIL COMPLETION OF THE PROJECT. ON INTERSTATE PROJECTS, TEMPORARY EDGE LINES SHOULD BE APPLIED WHERE TRAFFIC VOLUMES AND SPEEDS ARE HIGH AND DELAY OF SEVERAL DAYS IS ANTICIPATED.

- C. TEMPORARY MARKINGS MAY CONSIST OF PAINT, TAPE OR RAISED PAVEMENT MARKERS (RPM'S). THE TAPE SHALL BE A RETRO-REFLECTIVE FILM ON A CONFORMABLE METALLIC BACKING THAT CAN BE PAVED OVER. TAPE MAY BE USED ON THE FINAL SURFACE COURSE IF IT WILL NOT INTERFERE WITH THE FINAL MARKING APPLICATION. TEMPORARY TAPE MARKINGS WILL BE OFFSET AND REMOVED WHEN PROJECT IS FINISHED AND FINAL CENTERLINE PAINTED. THE TAPE SHALL BE THE TYPE THAT IS REMOVABLE INTACT AND NOT SEPERATE AT ANY TIME. THE RPM'S SHALL HAVE A SELF-ADHESIVE BACKING EASILY REMOVED BEFORE PAVING AND SHALL CONFORM TO THE FOLLOWING LAYOUT PATTERN:

NO PASSING BARRIER
NO RPM'S ALLOWED.

DASHED LINE
FOUR RETRO-REFLECTIVE RPM'S ON 3 1/2 FOOT CENTERS WITH A 30' GAP.


SOLID LINE - EDGE LINES
INTERSTATE MEDIAN SIDE-RETRO-REFLECTIVE RPM'S ON 4 TO 5 FOOT CENTER.
DRIVERS RIGHT SIDE-RPM'S NOT ALLOWED.

- D. WHEN PAINT IS USED FOR TEMPORARY MARKING, AN ALTERNATE MATERIAL SUCH AS TAPE OR RPM'S SHALL BE ON HAND IN THE EVENT RAIN PREVENTS THE PAINT APPLICATION FROM BEING COMPLETED. ALL PAINT SHALL BE REFLECTORIZED.
- E. PAYMENT FOR PAINT AND TAPE SHALL BE COMPUTED ON A LINEAR FOOT BASIS AS IF PAINT WAS USED. PAYMENT FOR THE RPM'S SHALL BE COMPUTED AS IF AN EQUIVALENT PAINT LINE WAS USED. (FOR EXAMPLE, DASHED LINE PAID AS 10 FEET OF PAINT, SOLID LINE PAID AS THE TOTAL DISTANCE COVERED WITH THE MARKERS).
- F. PRIOR TO ACCEPTANCE, THE PAVEMENT MARKINGS SHALL BE COMPLETED FOR THE ENTIRE PROJECT BY THE CONTRACTOR AS DETAILED ON THE PLANS OR DIRECTED BY THE RESIDENT ENGINEER.


REVISED
02/11/85

HMA 2828
Sheet 7 of 10 Sheets
Sheet 29 of 38 Sheets

Rochester - Hancock

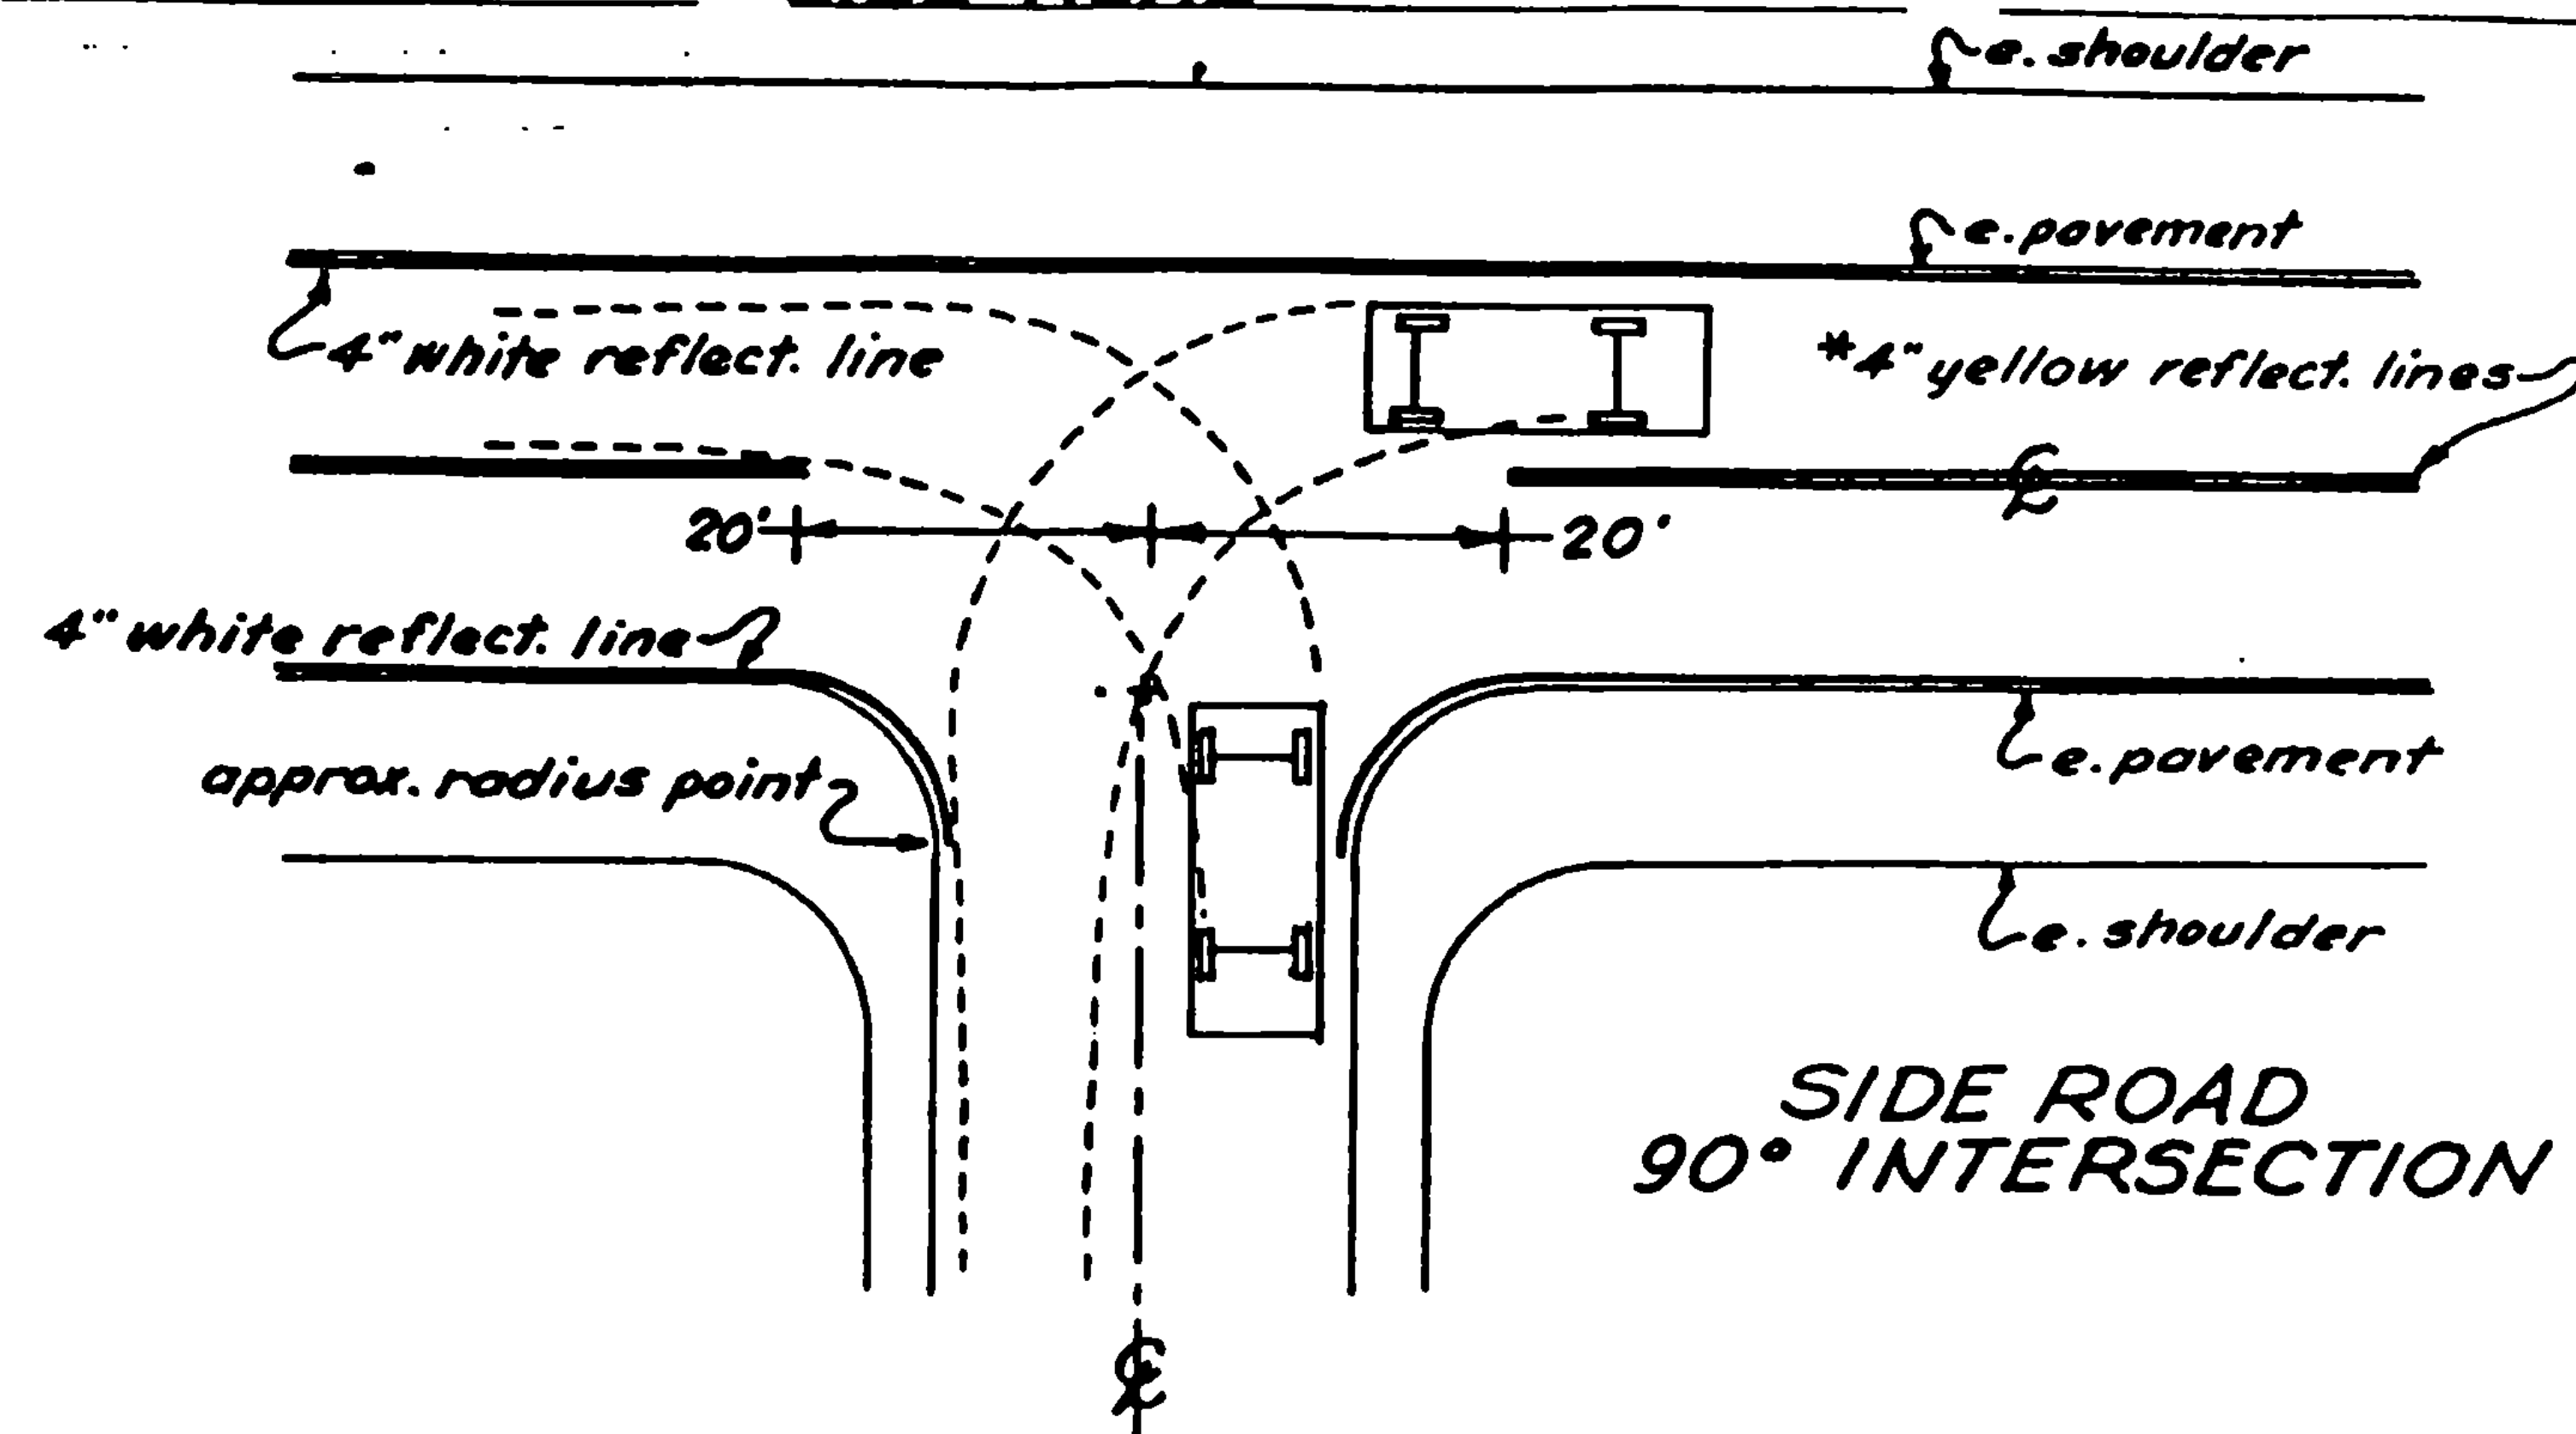

* Centerline treatment shall consist of a minimum of 400 feet of solid line in advance of the intersection and shall be paired with either a solid or dashed line depending on sight distance availability in the opposing lane.

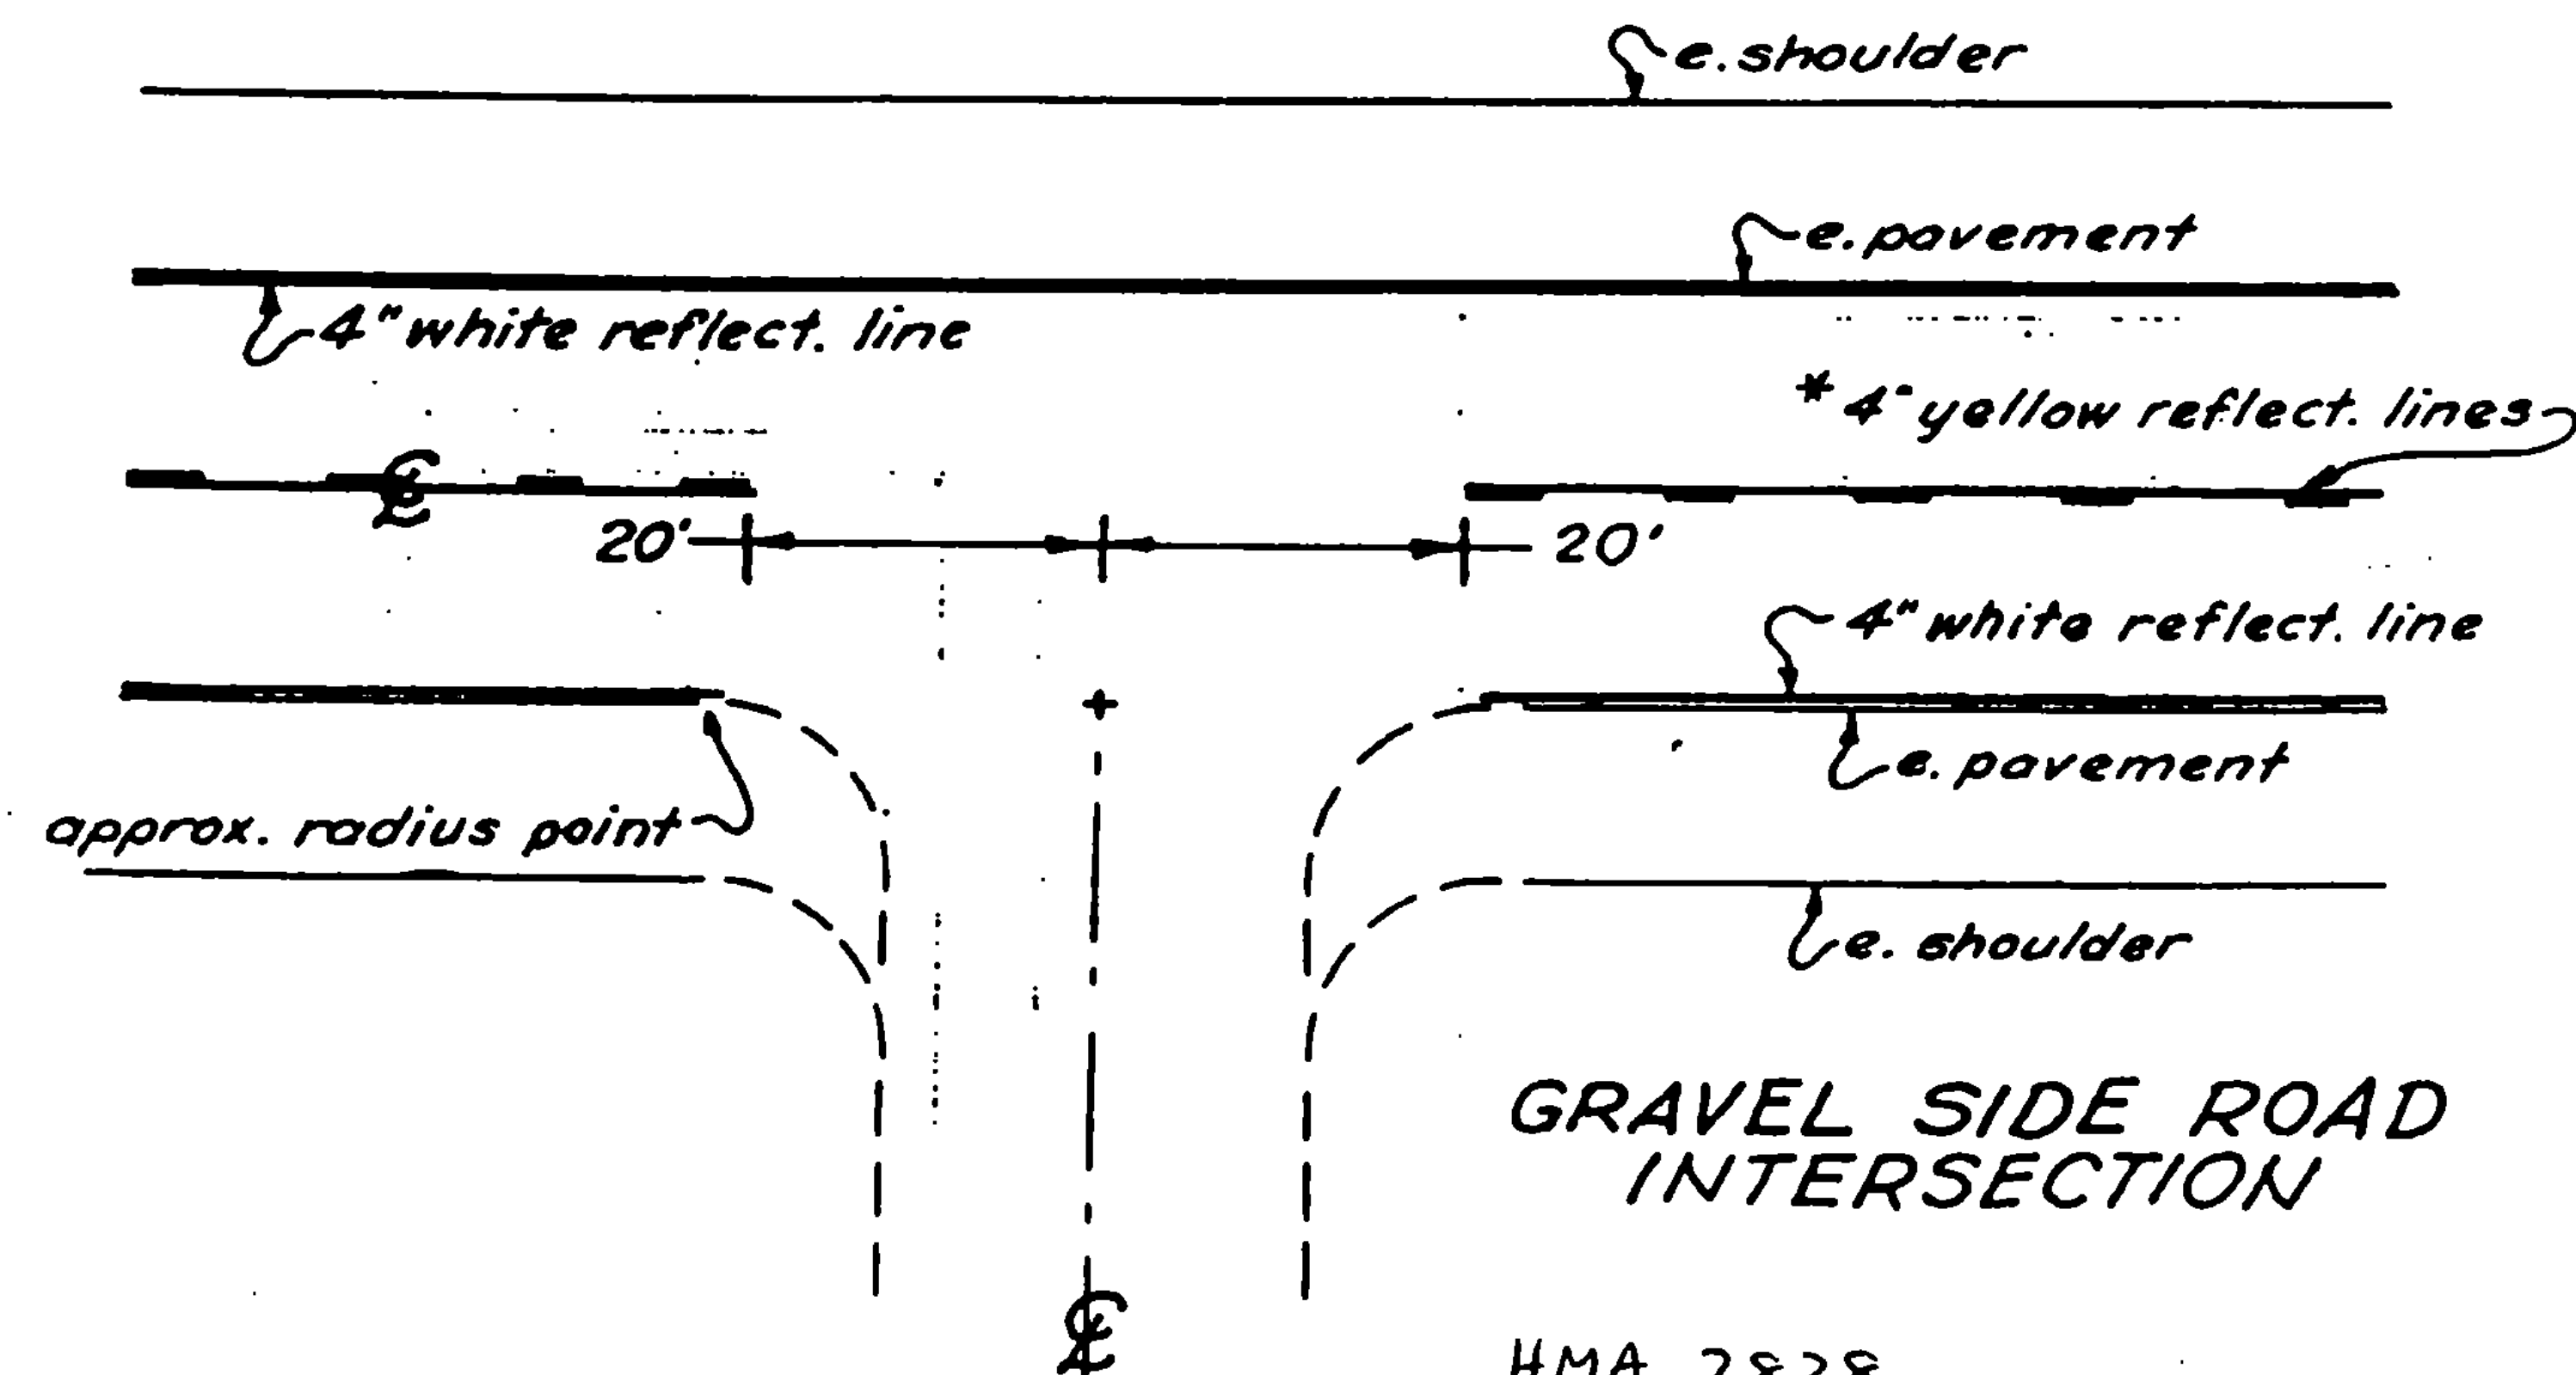

ITEM DESCRIPTION

SHEET 9 OF 10 SHEETS
SHEET 31 OF 38 SHEETS

[illegible]

PROJECT Rochester - Hancock

SHEET 10 OF 10 SHEETS
SHEET 32 OF 38 SHEETS

INDEX OF SHEETS

1. TITLE SHEET	
2. QUANTITY SHEET	
3-12. GRANVILLE	HMA 2860
13-22. HANCOCK-GRANVILLE	HMA 2823
23-32. ROCHESTER-HANCOCK	HMA 2828

STANDARDS

33. E-2	APPROACH SIGNS, ROAD CONSTRUCTION	2-3-86R
34. E-6	CONSTRUCTION SIGNS, ON PROJECT	2-3-86R
35. E-7	DELINEATION, BARRICADES & DETOURS	2-3-86R
36. E-7A	BREAKAWAY BARRICADE DETAILS	2-3-86R
37. E-8	APPROACH SIGNS, MAJOR MAINTENANCE	2-3-86R
38. E-10	APPROACH SIGNS, MINOR MAINTENANCE	2-3-86R



STATE OF VERMONT AGENCY OF TRANSPORTATION



PROPOSED IMPROVEMENT TOWNS OF GRANVILLE, HANCOCK & ROCHESTER

RESURFACING PROJECTS

WORK PERFORMED UNDER THIS PROJECT SHALL CONSIST OF RESURFACING THE HIGHWAY, INCLUDING SHOULDERS AND NEW PAVEMENT MARKINGS.

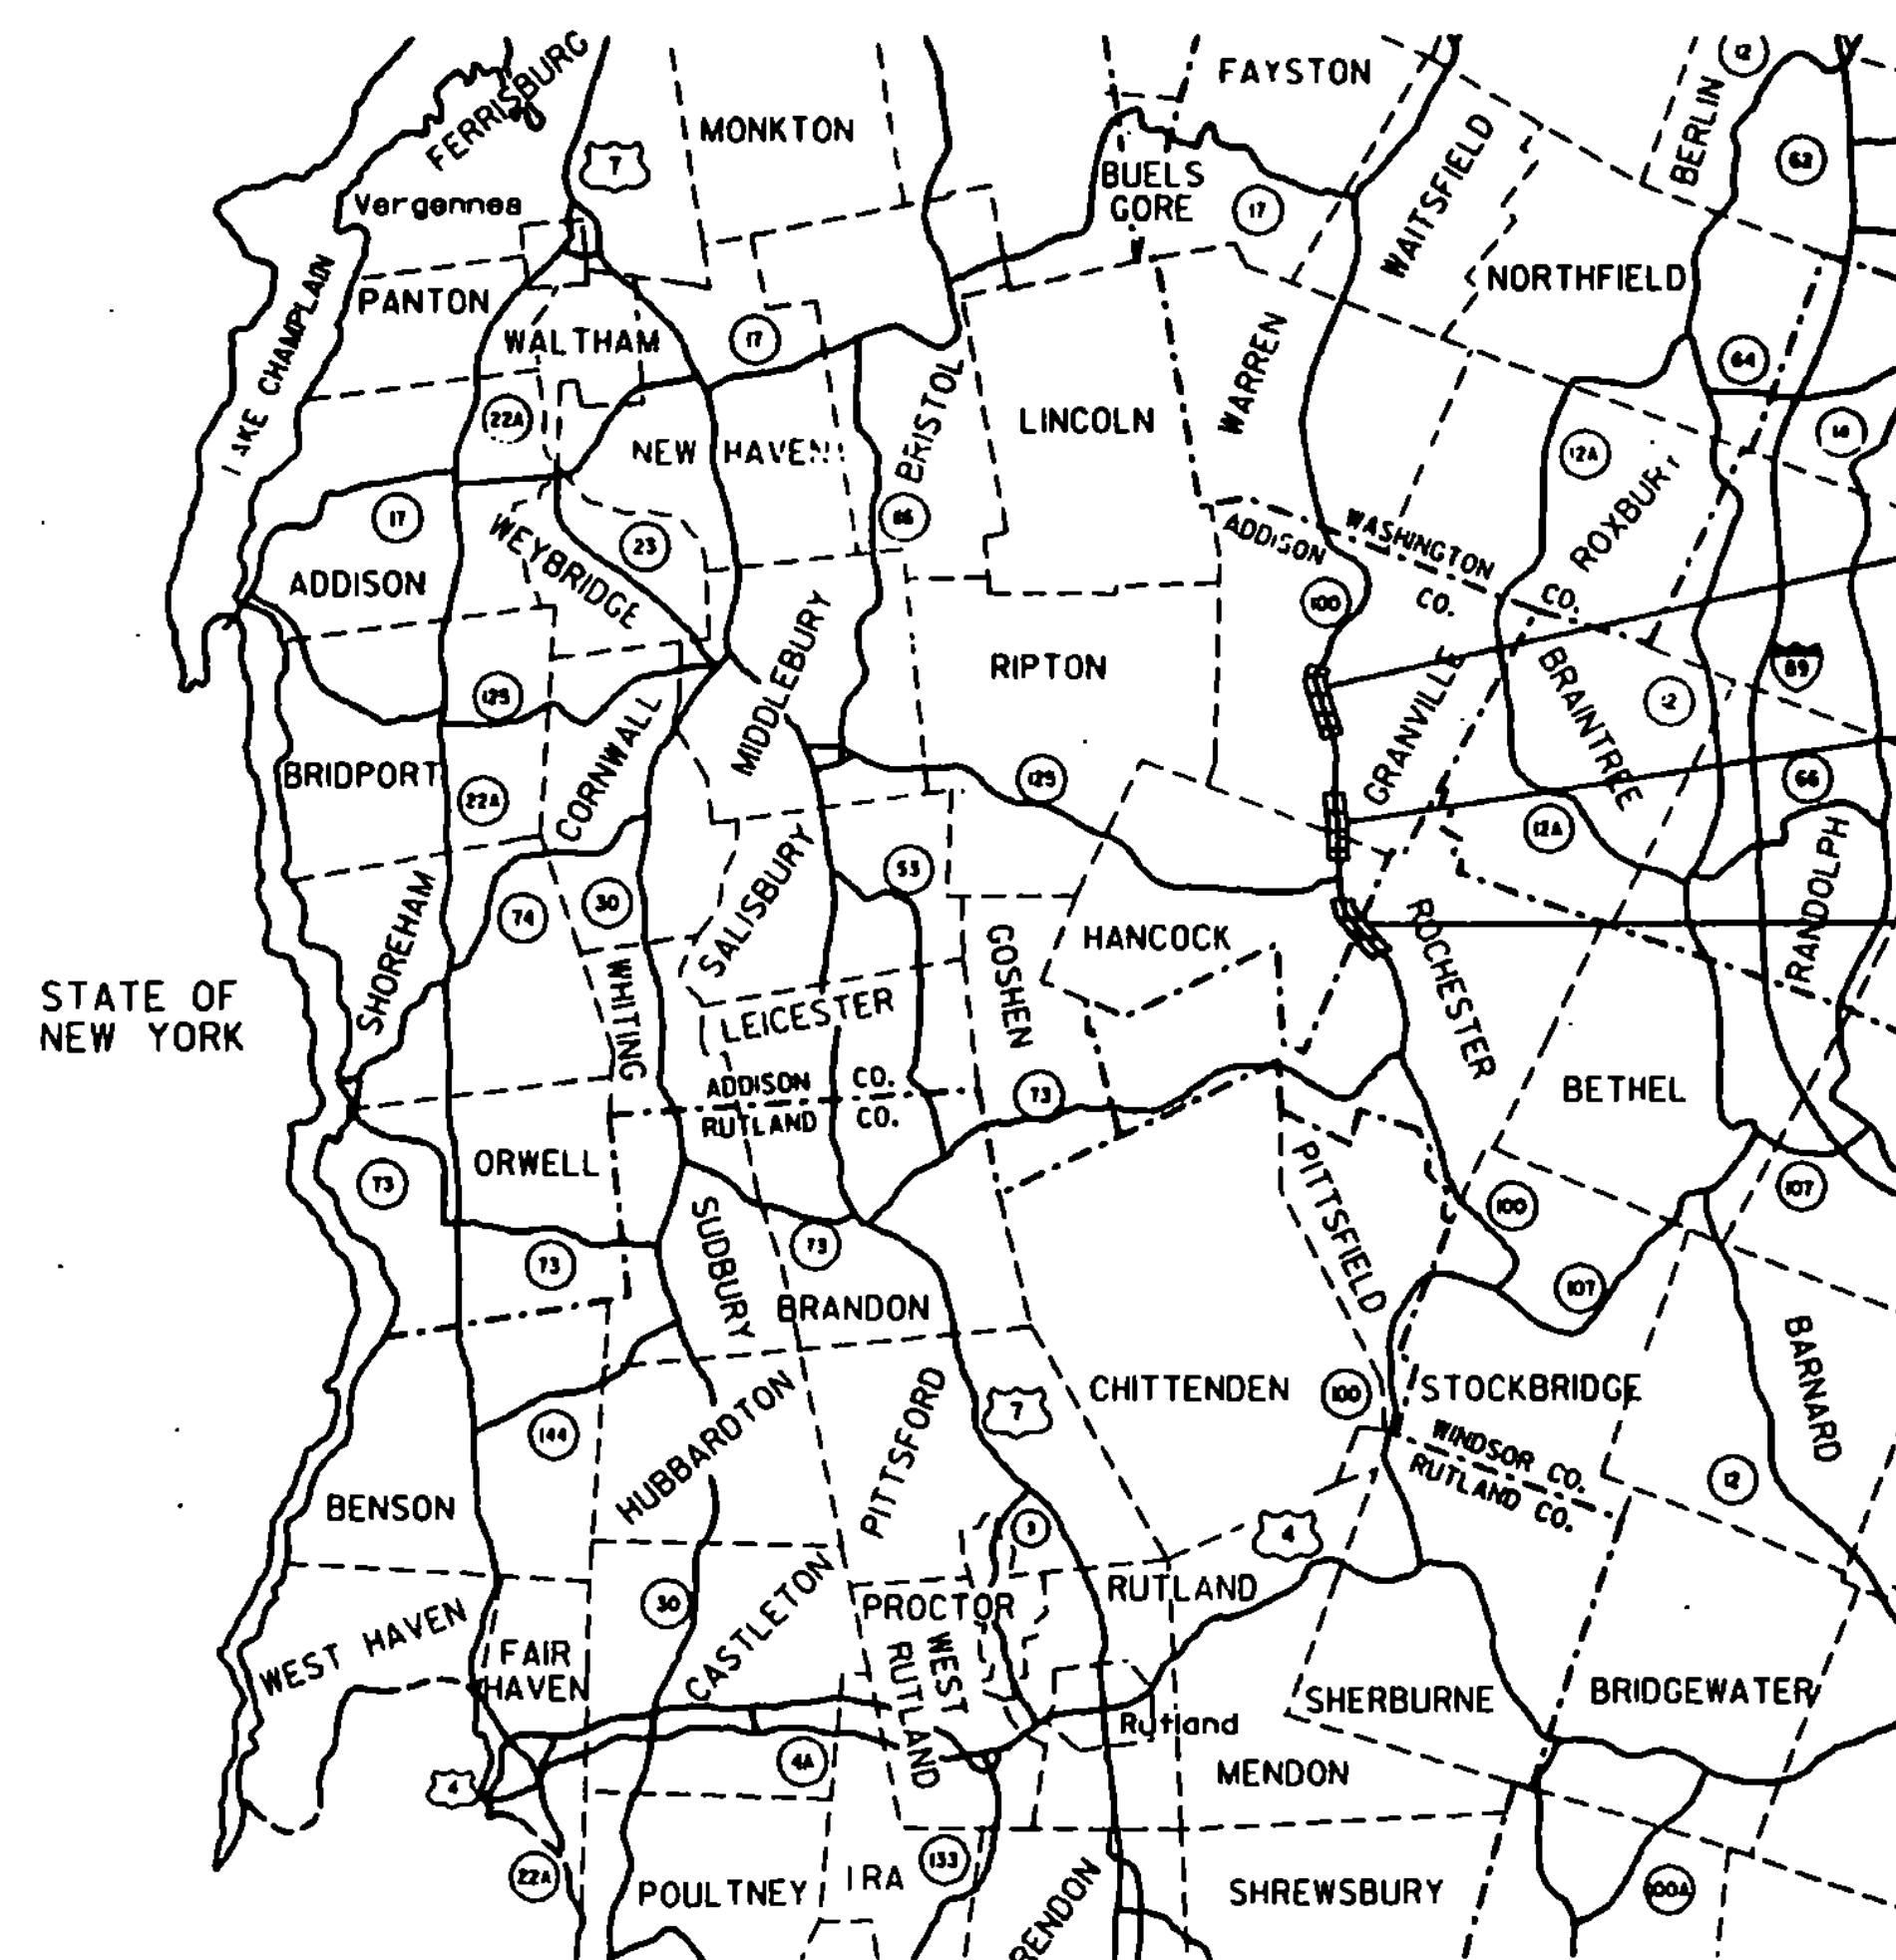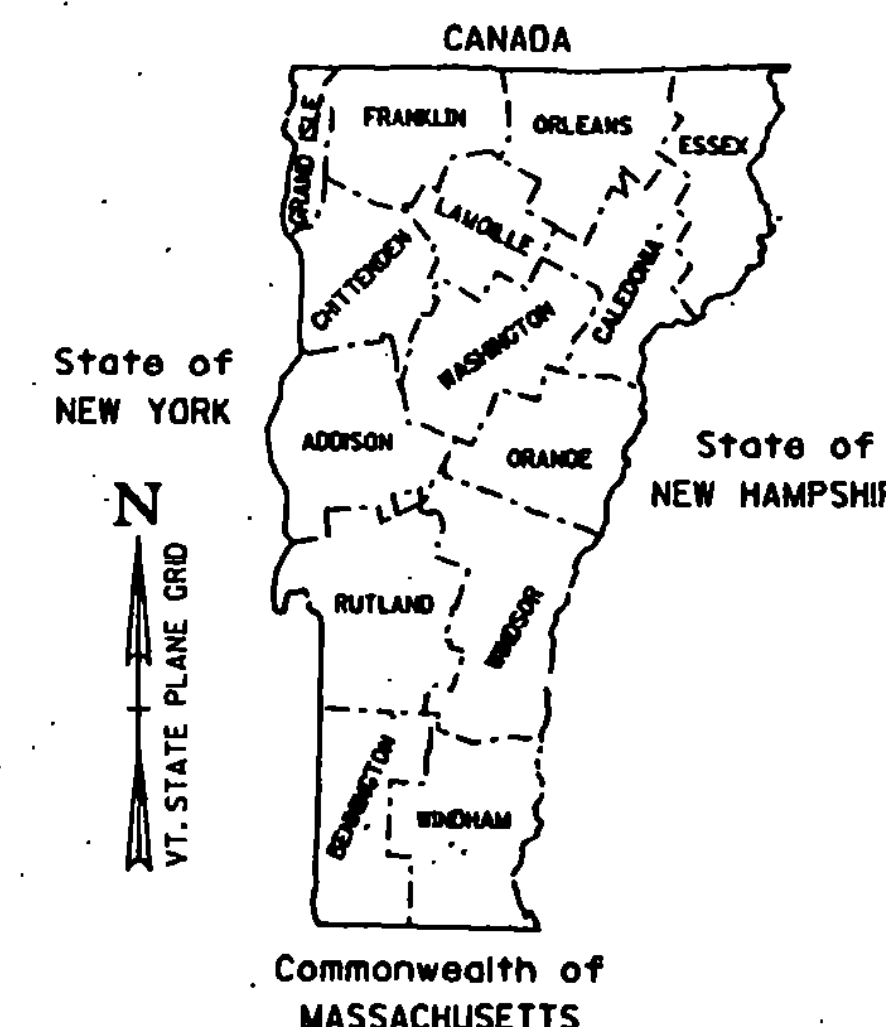


GRANVILLE HMA 2860

HANCOCK - GRANVILLE HMA 2823

ROCHESTER - HANCOCK HMA 2828

PROJECT	NUMBER	ROUTE	LOCATION	LENGTH
GRANVILLE	HMA 2860	VT. 100	MM 0.570 TO MM 2.971	2.401 MILES
HANCOCK-GRANVILLE	HMA 2823	VT. 100	MM 1.320 TO MM 2.511 MM 0.000 TO MM 0.110	1.300 MILES
ROCHESTER-HANCOCK	HMA 2828	VT. 100	MM 7.273 TO MM 8.353 MM 0.000 TO MM 0.650	1.730 MILES
TOTALS				5.431 MILES

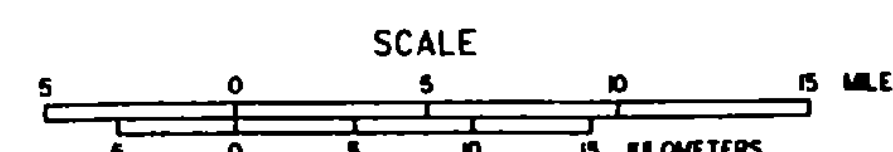

THESE PLANS ARE SUBJECT TO SUCH ENGINEERING CHANGES AS MAY BE REQUIRED BY THE FEDERAL HIGHWAY ADMINISTRATION OR THE CHIEF ENGINEER. CONSTRUCTION IS TO BE CARRIED ON IN ACCORDANCE WITH THESE PLANS AND THE STANDARD SPECIFICATIONS FOR CONSTRUCTION DATED 1986, AS APPROVED BY THE FEDERAL HIGHWAY ADMINISTRATION ON NOVEMBER 21, 1985 FOR USE ON THIS PROJECT, INCLUDING ALL SUBSEQUENT REVISIONS AND SUCH REVISED SPECIFICATIONS AND SPECIAL PROVISIONS AS ARE INCORPORATED IN THESE PLANS.






SUBMITTED BY ORDER OF THE STATE TRANSPORTATION BOARD	
APPROVED <i>David B. Kelly</i>	DATE 7/1/87
CHIEF ENGINEER	
DEPARTMENT OF TRANSPORTATION FEDERAL HIGHWAY ADMINISTRATION	
APPROVED _____	DATE _____
DIVISION ADMINISTRATOR	
PROJECT RESURFACING PROJECTS	
SHEET 1 OF 30 SHEETS	

**STATE OF VERMONT
AGENCY OF TRANSPORTATION**


SHEET 2 OF 38 SHEETS

SIGN H-3 IS TO BE USED WHEN PROJECT LENGTH EXCEEDS 2 MILES, OR AS REQUESTED BY THE RESIDENT ENGINEER. THE TEXT MAY BE AS SHOWN OR MAY READ AS FOLLOWS "CONSTRUCTION AREA NEXT — MILES"

* Show mileage to nearest 1/4 mile

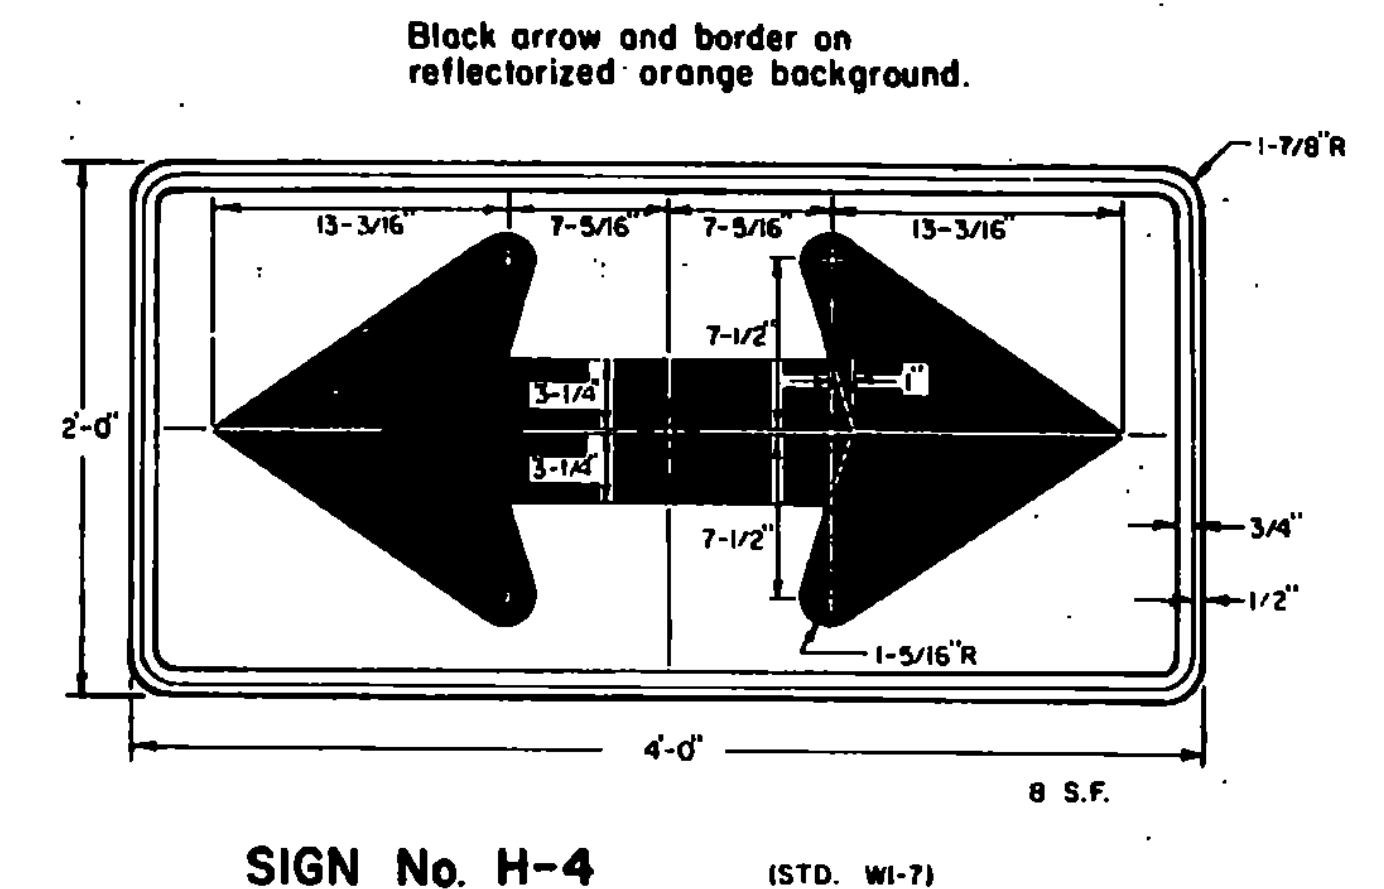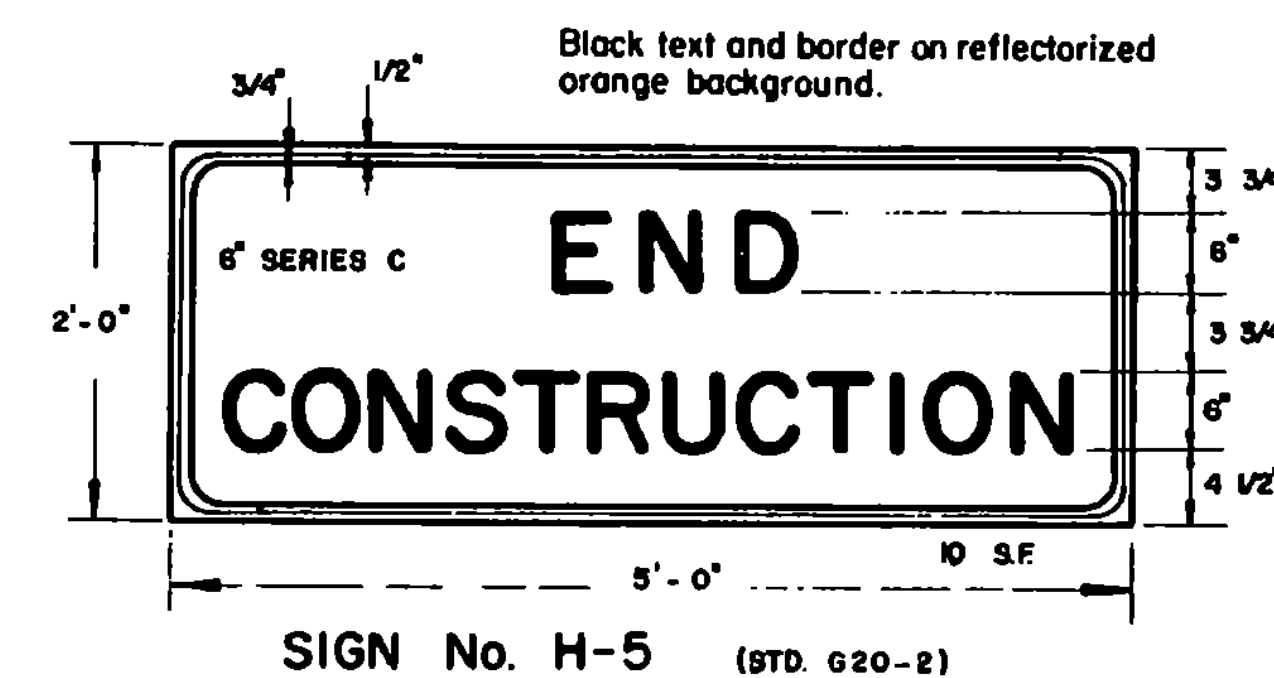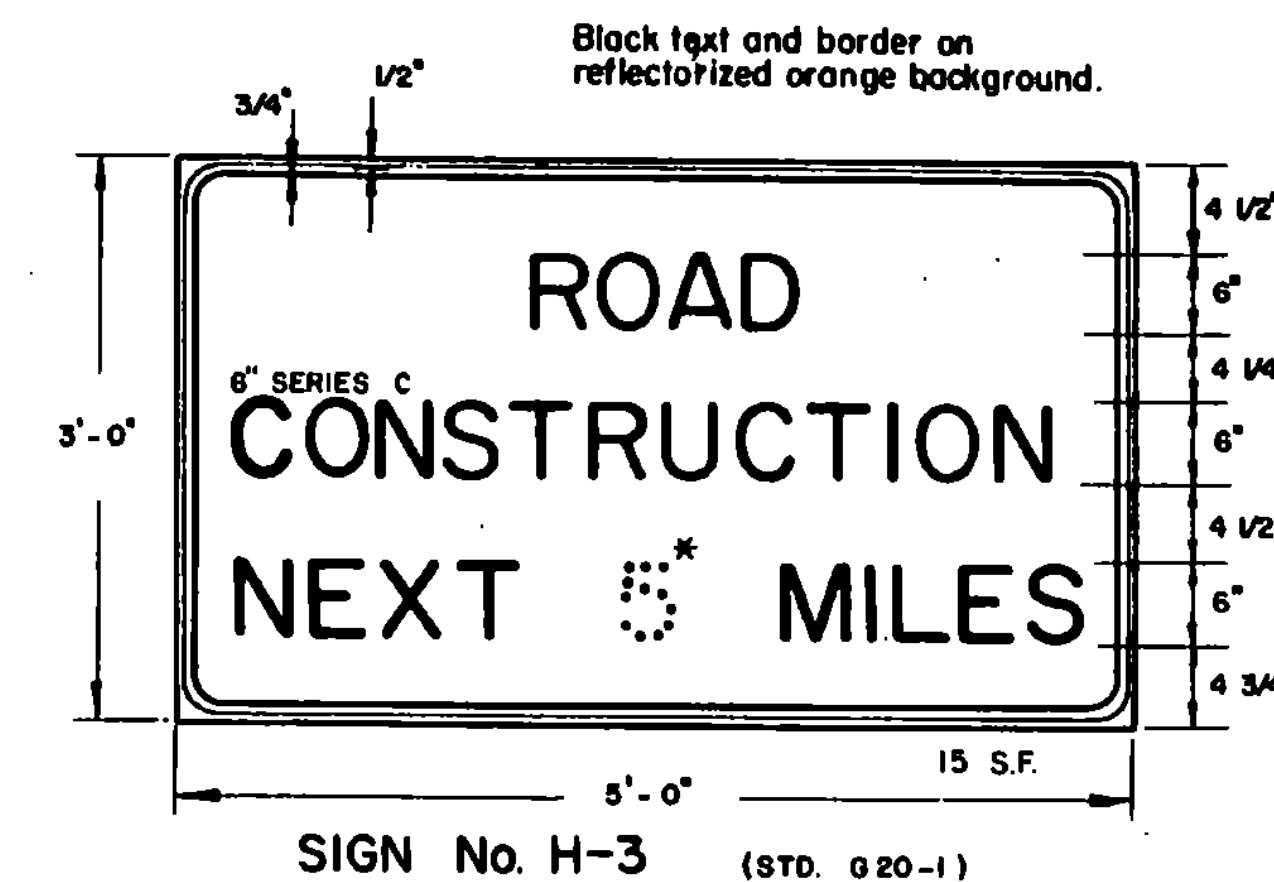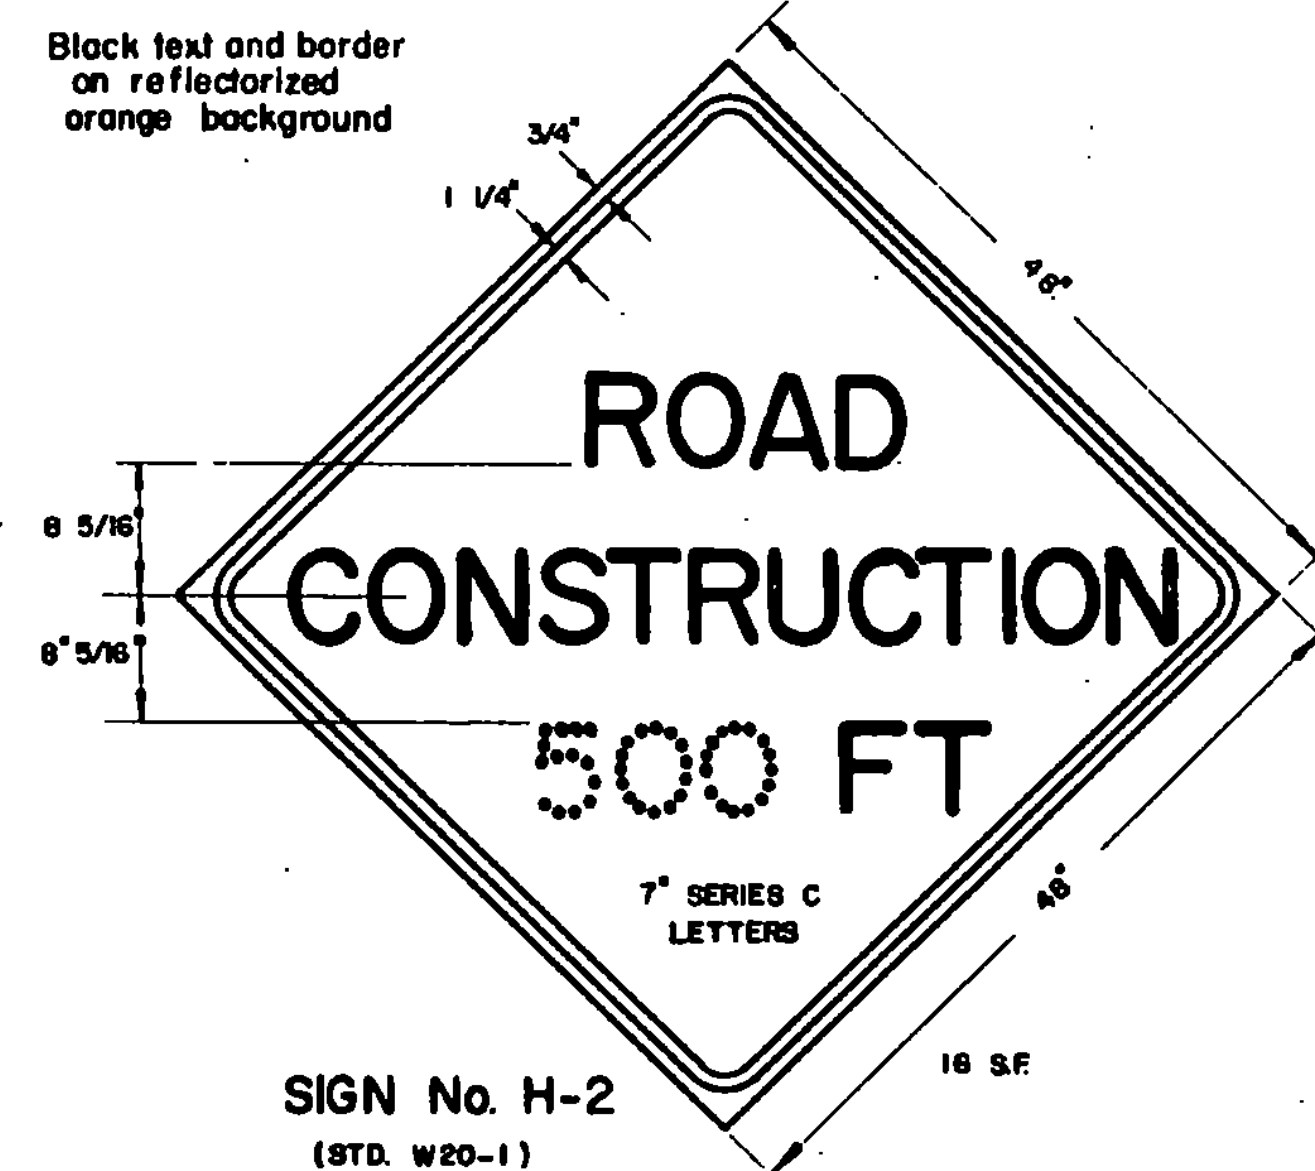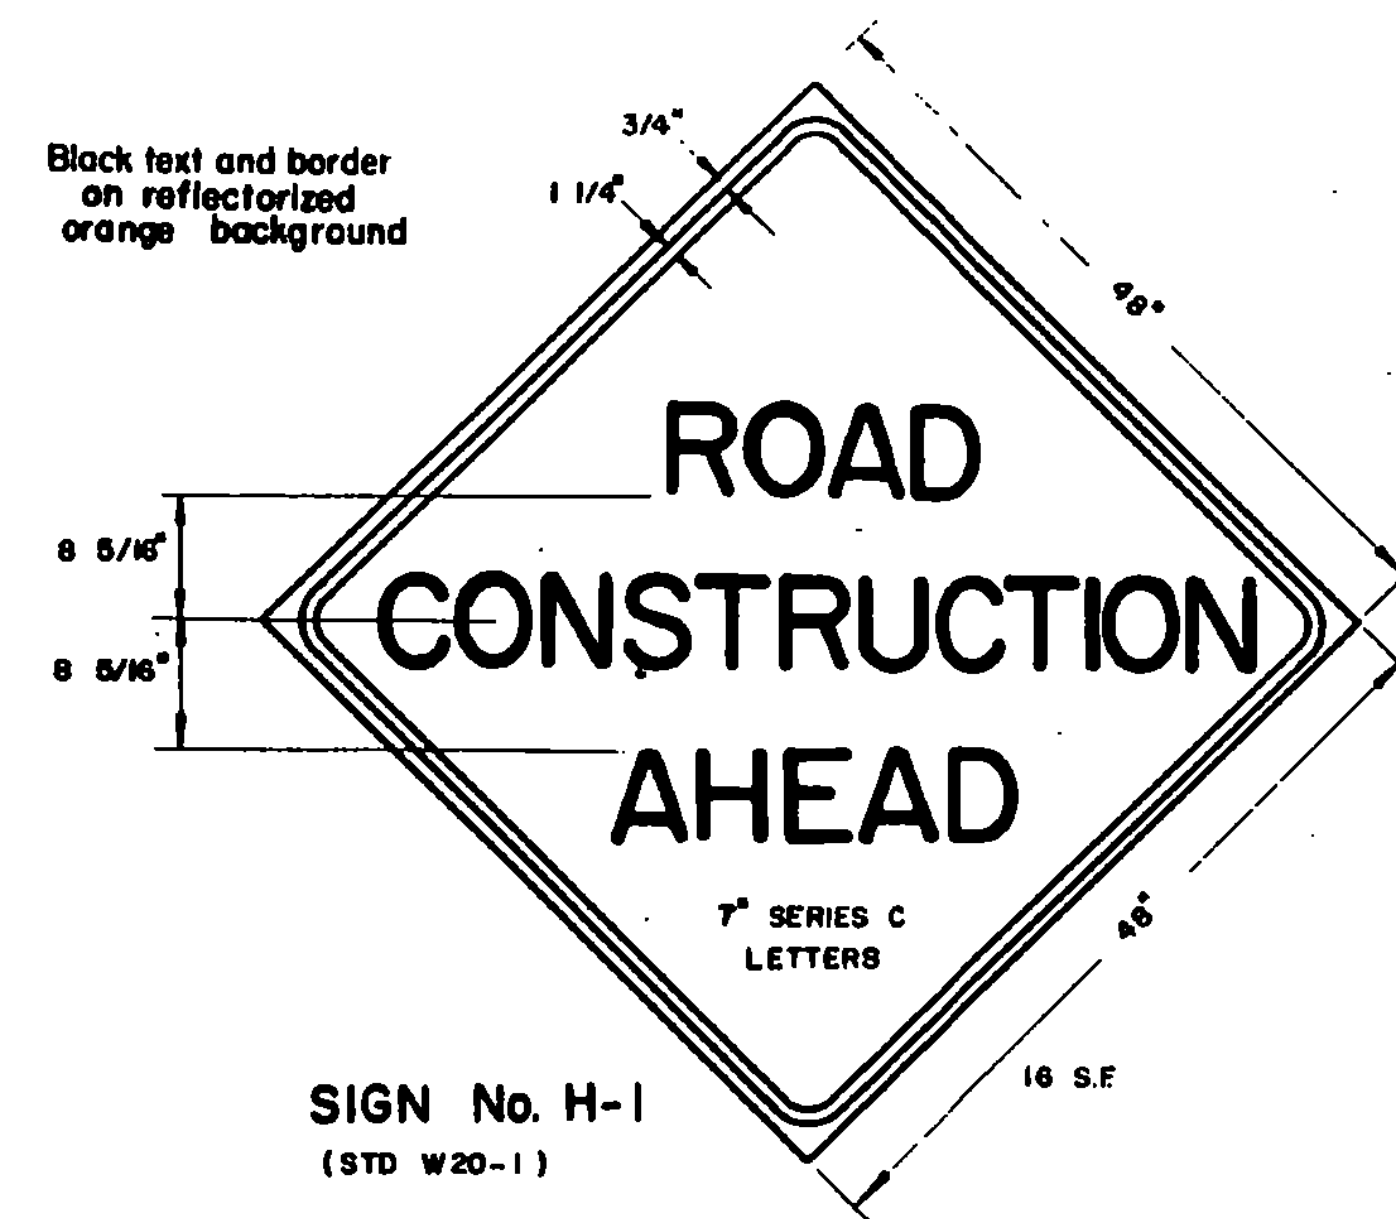

The road construction approach signs shown on this sheet are intended for use in providing advance warning and information on construction projects over which traffic will be maintained. When additional approach signs or other types of advance signing or control are necessary, the Plans and/or the Specifications for that project will give the details of the signs and devices required.

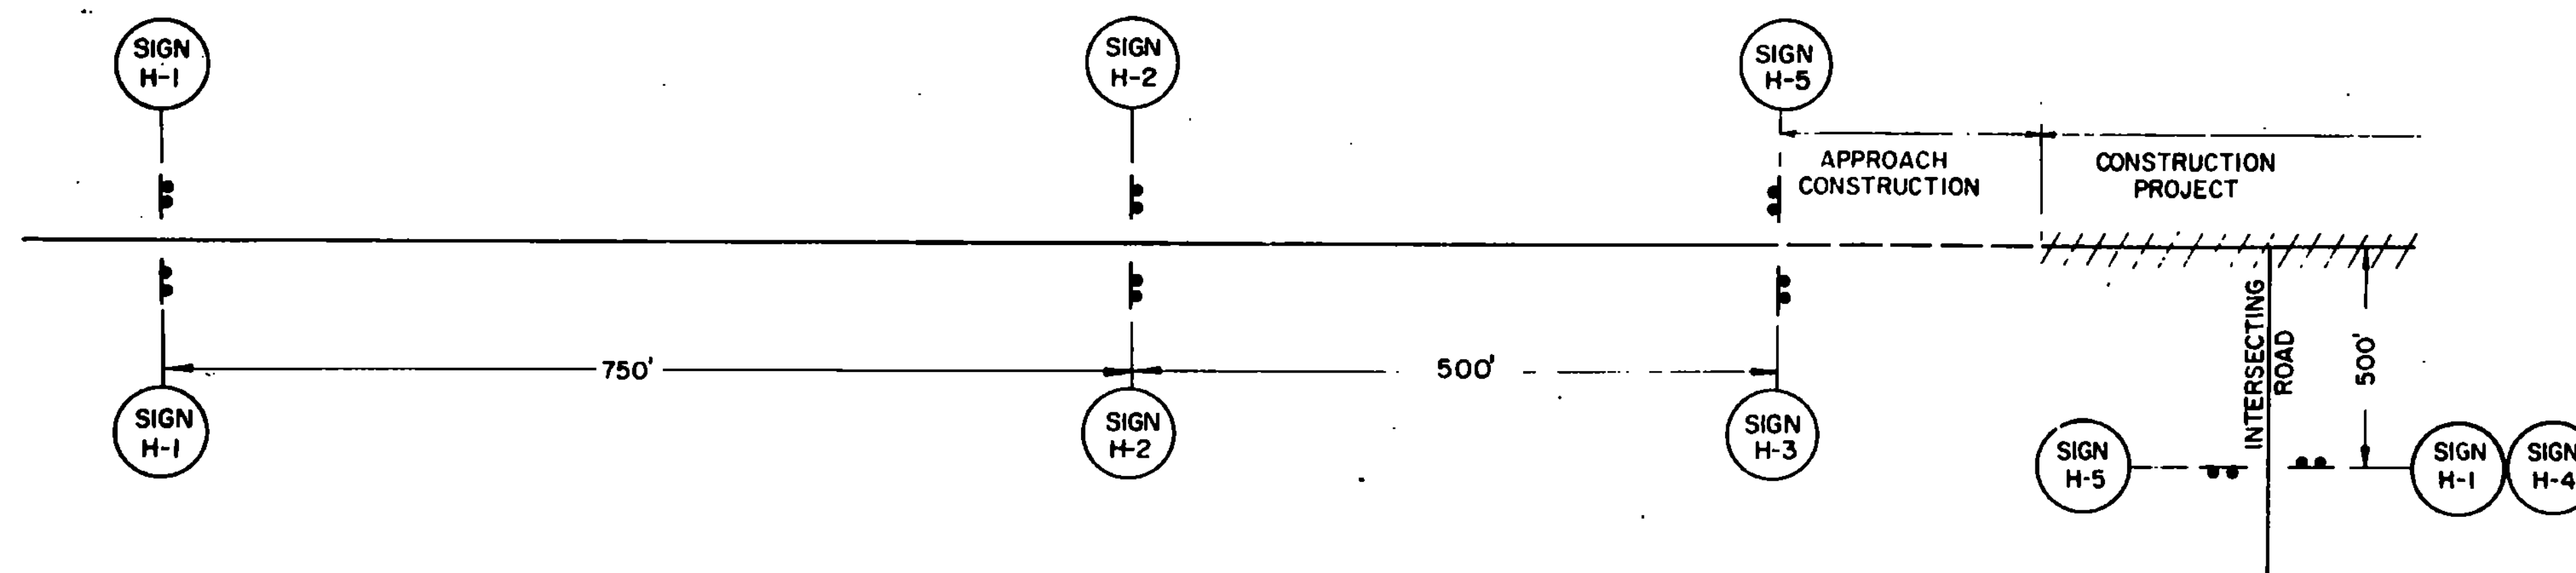

LOCATION

Construction approach signs shall be located as detailed on this sheet or otherwise shown on the Plans. They shall appear at each end of the highway under construction, and on all intersecting public highways. The exact placement of any sign will depend upon the alignment of the highway and the character of the roadsides. The location measurements on this sheet are intended to indicate the sequence to be followed, and the minimum spacing to be observed by the Engineer in determining exact locations.

DESIGN

The designs of the signs shall conform with the details shown on this sheet and with the standards prescribed in the Manual on Uniform Traffic Control Devices prepared by National Joint Committee on Uniform Traffic Control Devices.

MATERIALS

The signs shall be of metal, wood, plywood, hardboard or any other material satisfactory to the Engineer. No material will be approved that will deteriorate by exposure to the weather during the required life of the sign.

REFLECTORIZATION

All reflectorized material shall consist of encapsulated lens reflective sheeting.

INSTALLATION

The signs shall be in place at the time the project officially commences. Each sign shall be erected in a neat and workmanlike manner on wood or metal posts set securely in the ground. The bottom of a sign shall be at least 5 feet above road level, and the nearest edge of a sign shall be at least 6 feet outside the shoulder point or 2 feet outside guard rail, curbing or sidewalk. Posts and signs shall be braced or reinforced in back as necessary. The installation of signs shall be subject to approval of the Engineer. In urban areas, the bottom of the sign shall be at least 7' above the sidewalk.

MAINTENANCE

Signs shall be maintained in a clean and legible condition satisfactory to the Engineer. They shall be completely visible to approaching traffic at all times. They shall be kept plumb and level, and always present a neat appearance. Damaged, defaced or dirty signs shall be repaired, cleaned or replaced as ordered by the Engineer.

GENERAL

The cost of furnishing, erecting, maintaining and removing all construction approach signs will be considered subsidiary work pertaining to the project as a whole and shall be included in the contract unit price bid for various items involved in the contract. In all phases of construction of approach signing, the requirements set forth in the Manual on Uniform Traffic Control Devices shall be met (See Standard Specifications, Section 107, Article 107.08 Traffic Control Devices).

When project is closed down for temporary periods the signs shall be covered in a workmanlike manner.

REVISIONS AND CORRECTIONS

SEPT. 11, 1973 - REVISED PER ORDER OF FHWA, SEPT. 11, 1973
OCT. 19, 1973 - SIGN H-4 REMOVED.
MAY 14, 1974 - REFLECTIVE MATERIAL CHANGE
JUNE 7, 1977 - REFLECTIVE MATERIAL NOTE CHANGED.
DEC. 15, 1979 - ILLUMINATION DELETED.
DEC. 17, 1979 - SIGN H-3 REVISED, SIGN H-4 ADDED.
MAR. 4, 1981 - SIGN H-3 TEXT CHANGED, NOTE ADDED.
FEB. 3, 1988 - UPDATED TO 1986 SPECIFICATIONS

APPROVED

Dec. 14, 1971
DATE

R. H. Arnold
CHIEF ENGINEER

E. H. Dickson
ASST. CHIEF ENGINEER

G. M. Lane
HIGHWAY ENGINEER











TRAFFIC SIGNS

ROAD CONSTRUCTION APPROACH SIGNS



STANDARD

E-2

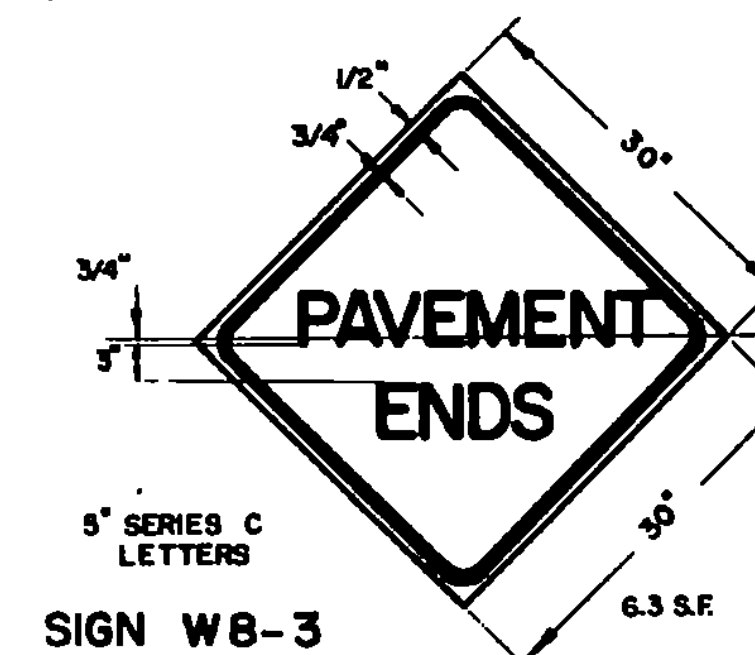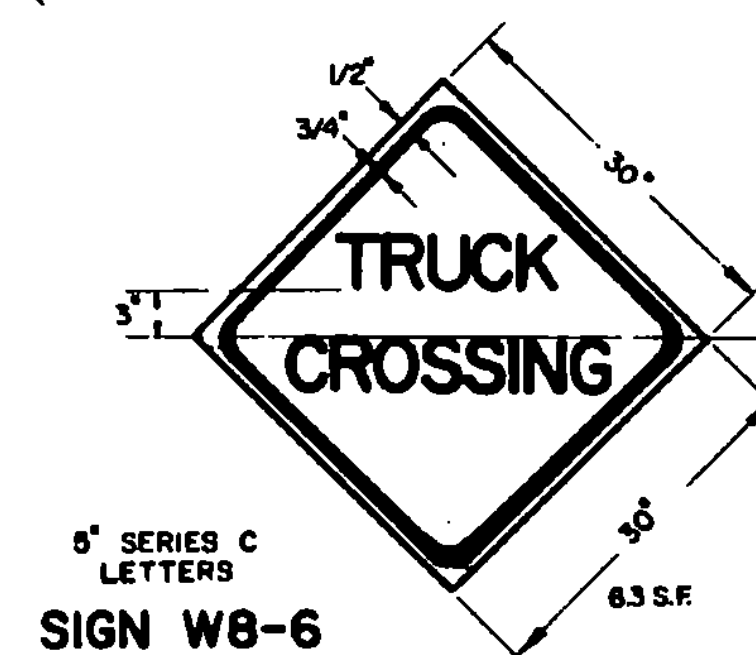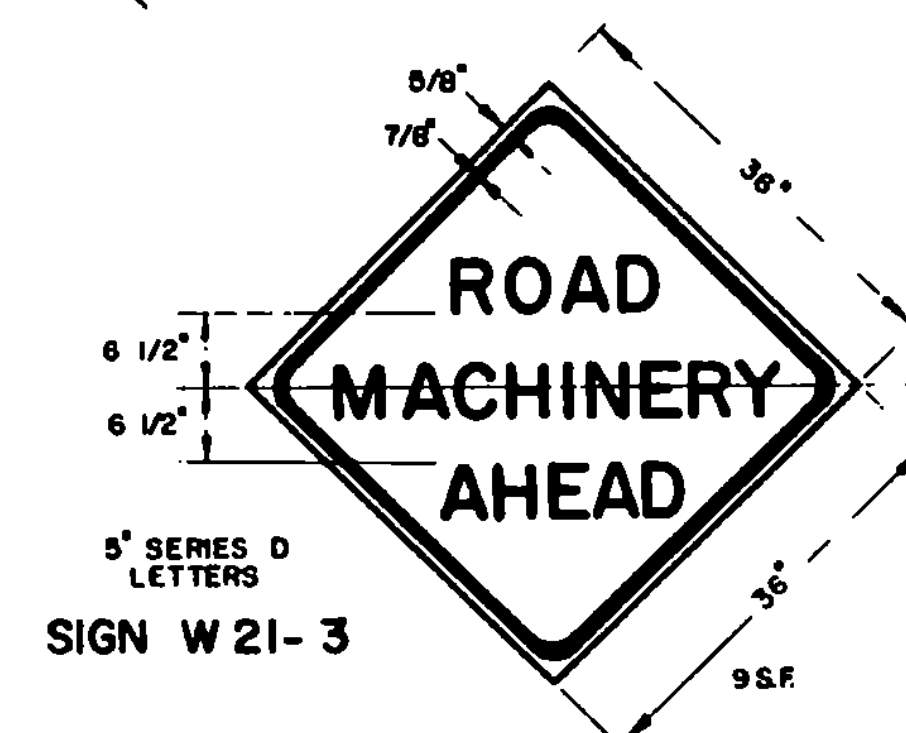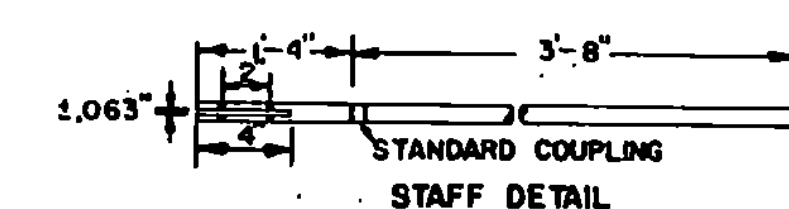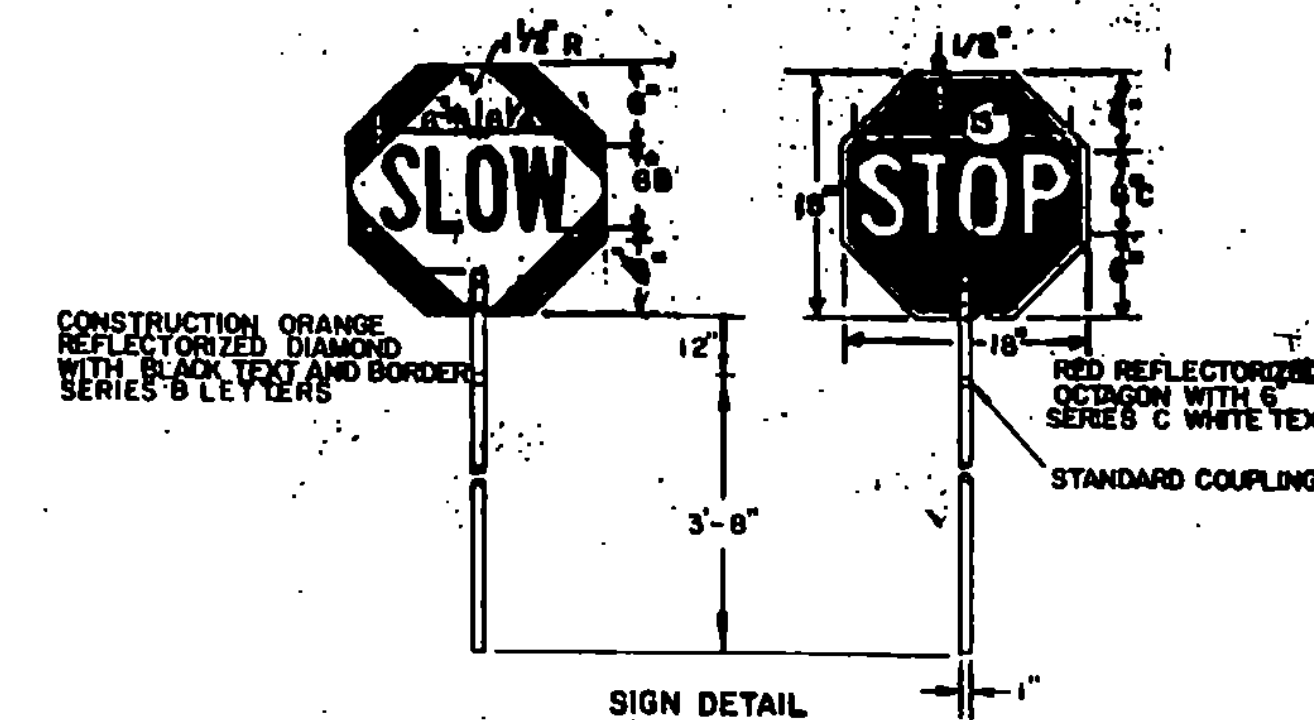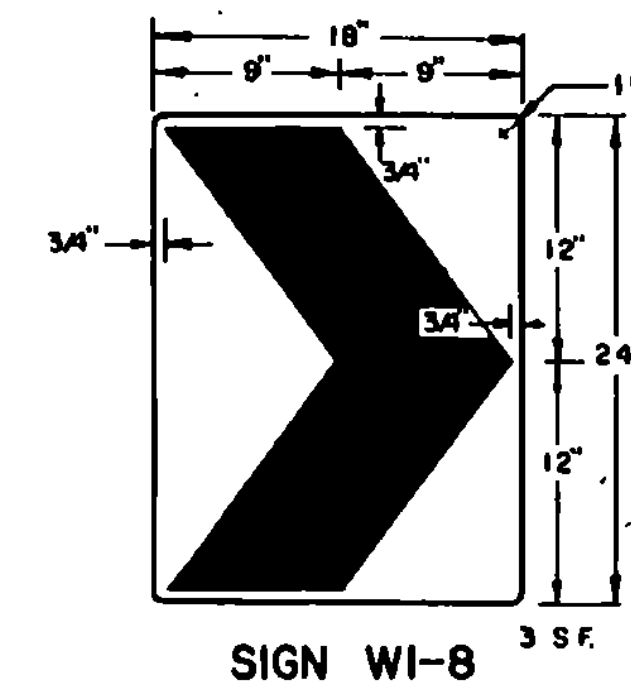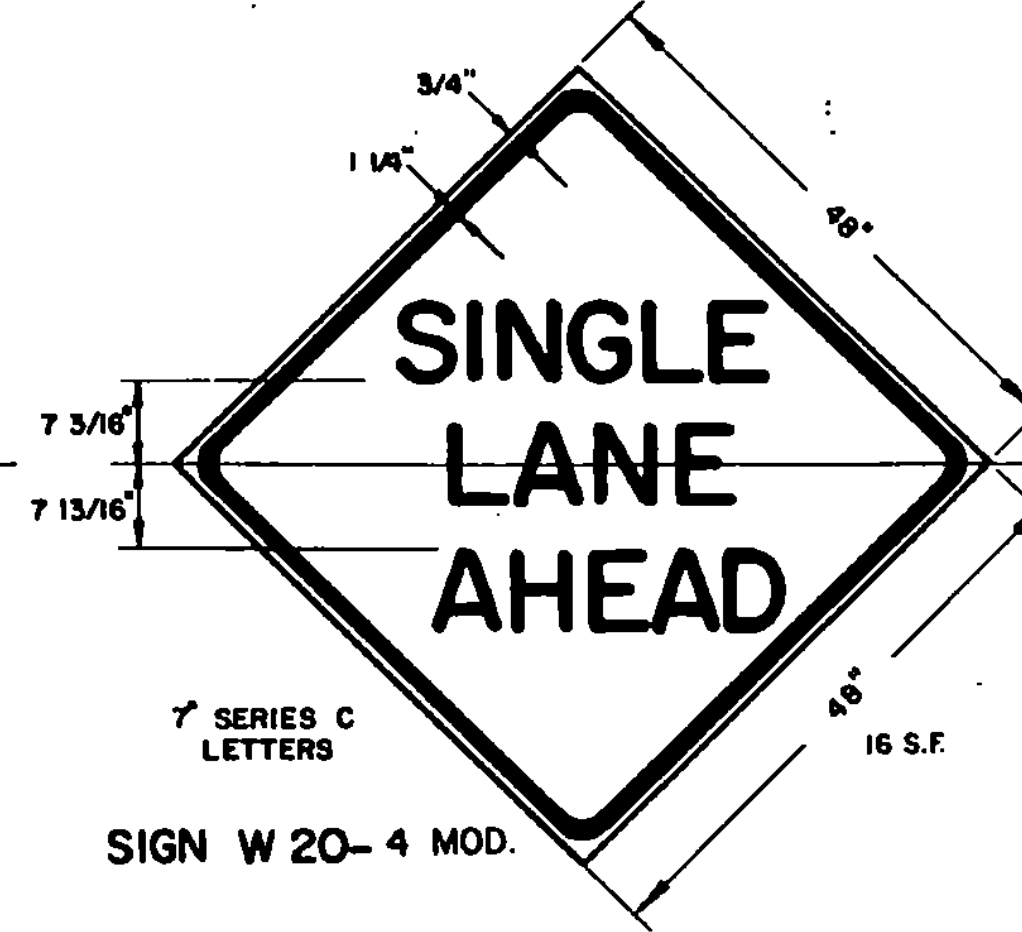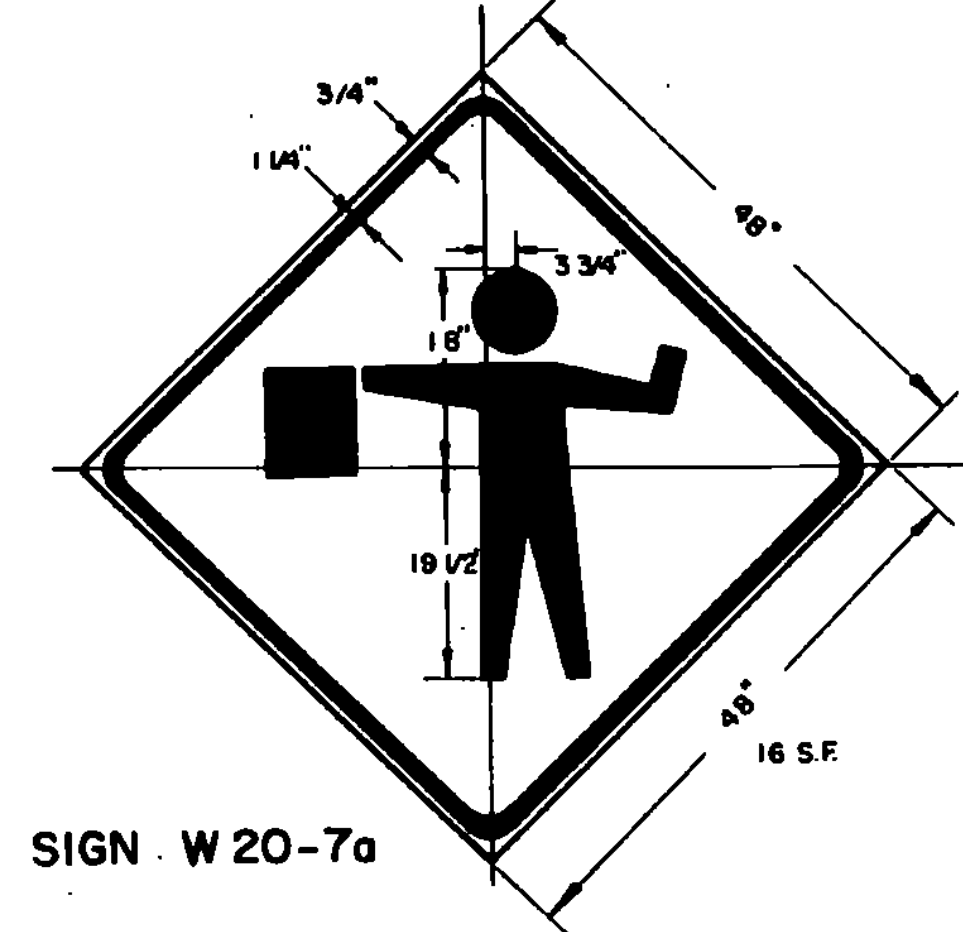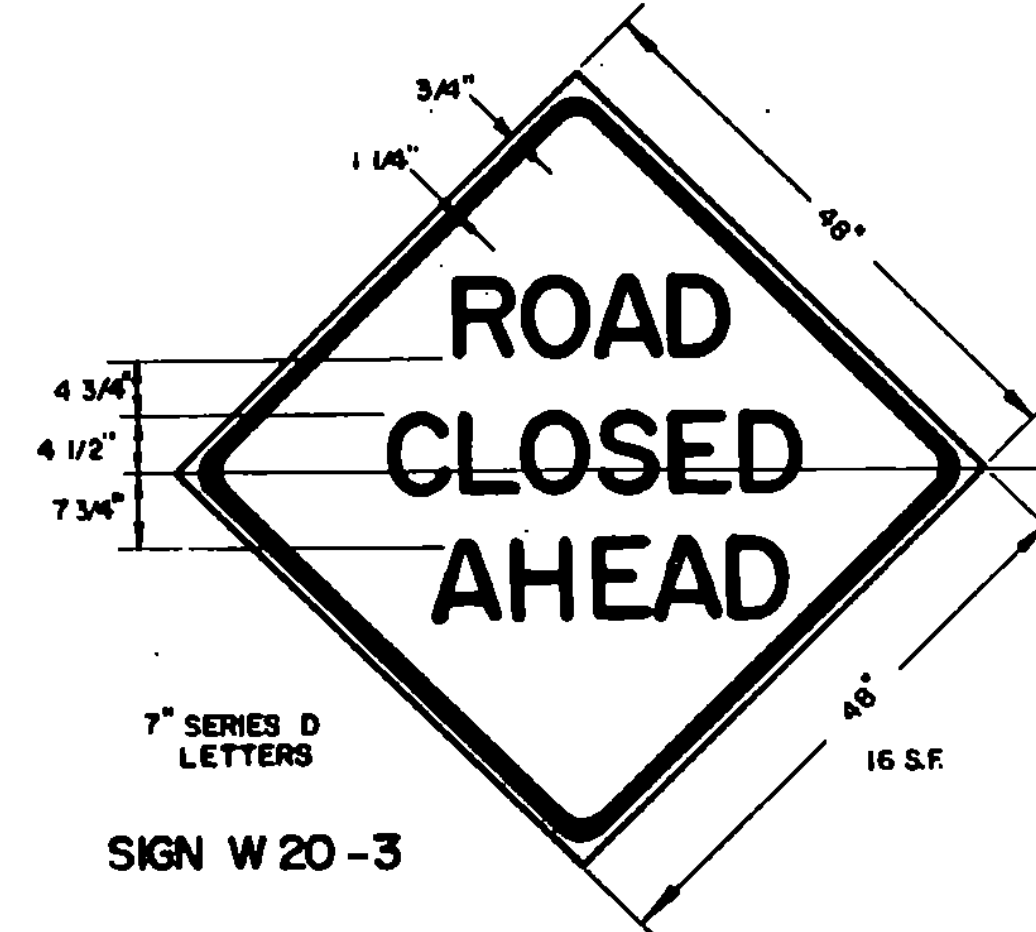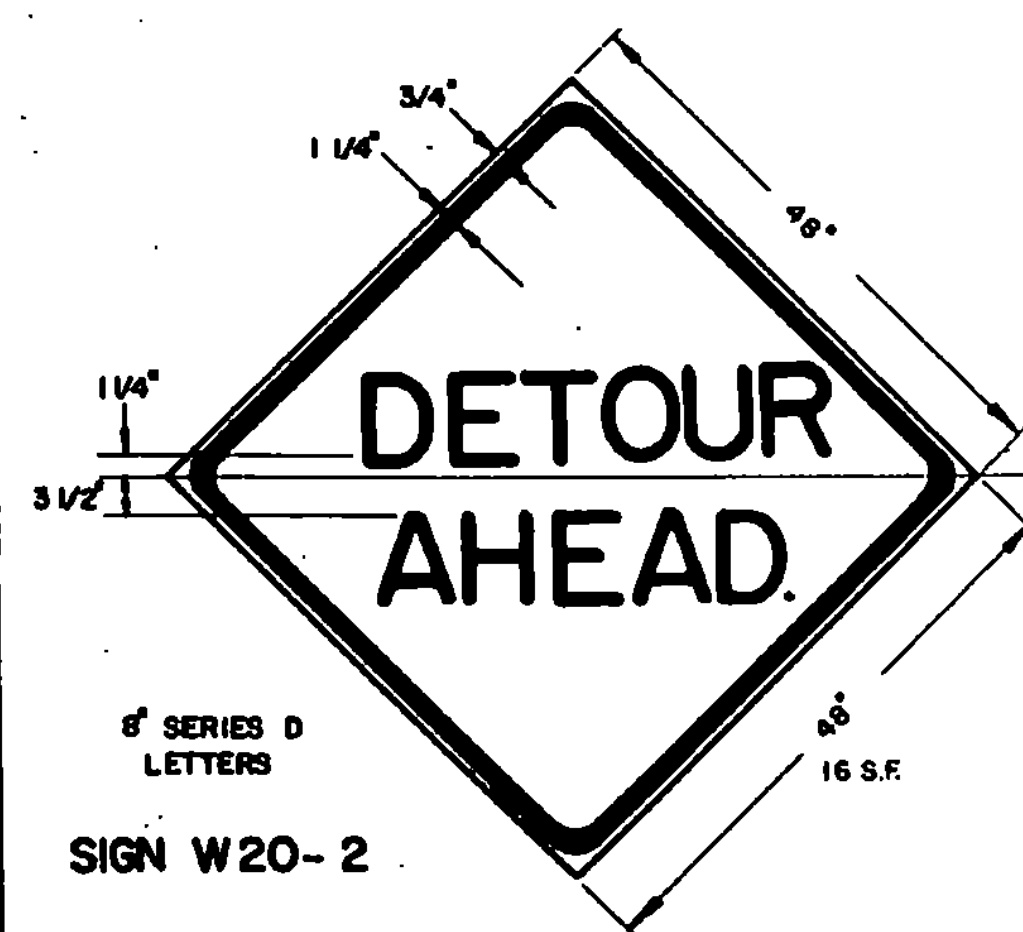

NOTES

APPLICATION OF STANDARDS

Since it is not possible to prescribe detailed standards of application for all of the situations that may conceivably arise on a construction project, reference must be made to the Manual on Uniform Traffic Control Devices for the principles, procedures and standards that will be required in connection with on-project construction signs and barricades. The signs here shown represent a sample of those that probably will be most used.

DESIGN

The designs of the signs and barricades shall conform with the details shown on this sheet and with the standards prescribed in the Manual. Deviations will not be permitted.

MATERIALS

The signs shall be of metal, wood, plywood, hardwood or any other material satisfactory to the Engineer. No material will be approved that will deteriorate by exposure to the weather during the required life of the sign.

REFLECTORIZATION AND COLORS



All signs except sign R11-2 and the sign paddle shall have black texts and borders on an encapsulated lens reflective orange background. Sign R11-2 shall have black text and border on an encapsulated lens reflective white background.

INSTALLATION


Signs and barricades shall be in place prior to the start of the construction operation to which they apply, and shall be removed promptly when the need no longer exists. Each sign shall be erected in a neat and workmanlike manner on wood or metal posts set securely in the ground, or on portable supports for temporary use, or on barricades when appropriate. As a general rule, roadside signs shall be 5 feet above road level with the nearest edge at least 6 feet outside the shoulder point. The installation of all signs and barricades shall be subject to the approval of the Engineer.

MAINTENANCE

Signs shall be kept in a clean and legible condition at all times with the reflective quality completely unimpaired. Signs, sign supports, and barricades shall be repaired, cleaned, repainted or replaced whenever necessary. Weeds, shrubbery, construction materials, equipment, and snow shall not be allowed to obscure any sign or barricade. The maintenance of all traffic control devices shall be subject to the orders of the Engineer.

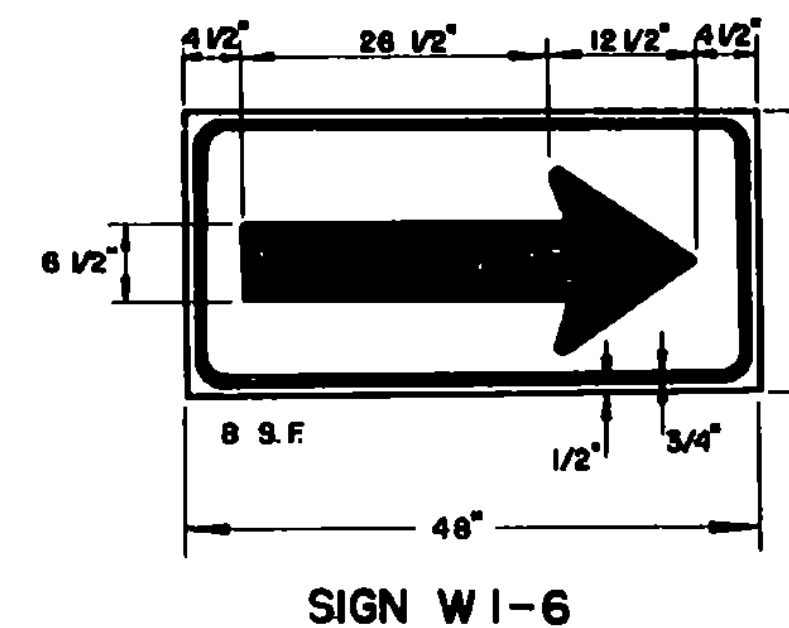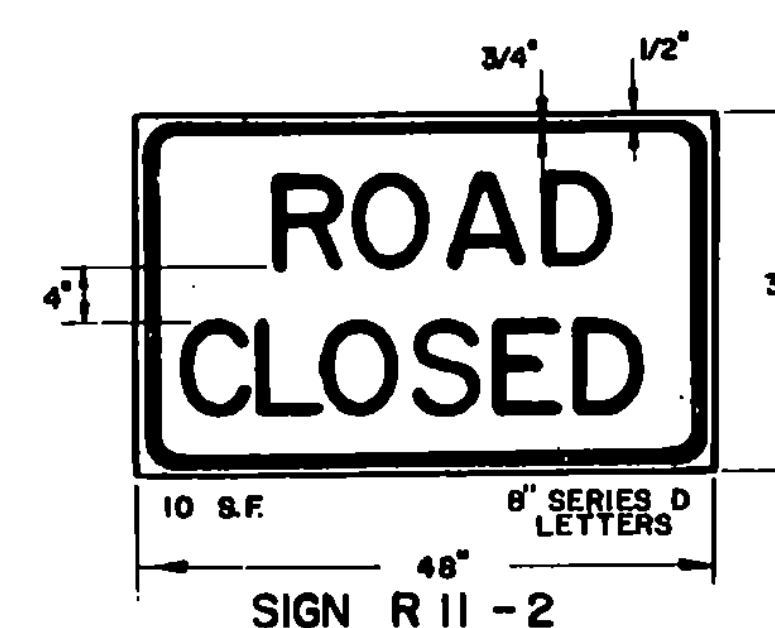

ARROW RIGHT OR LEFT AS REQUIRED

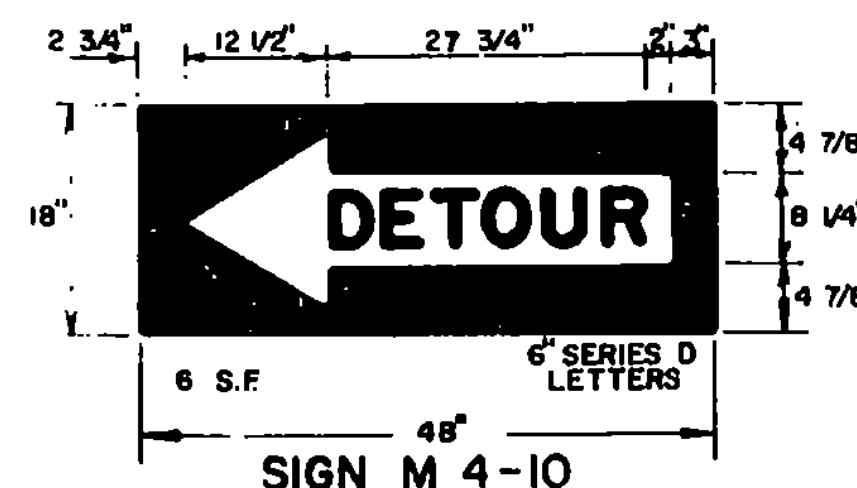

ARROW LEFT OR RIGHT AS REQUIRED

The on-project construction signs covered by this sheet are intended to be used as the situations apply within normal two-lane highway construction areas, for the protection of the public and workmen and for the guidance of traffic through or around construction operations. When messages other than those shown here are needed, the signs and their applications shall conform with the standards set forth in the Manual on Uniform Traffic Control Devices.

The cost of furnishing, erecting, maintaining and removing all construction approach signs shall be considered as subsidiary work pertaining to the project as a whole and shall be included in the contract unit price bid for various items involved in the contract.

REVISIONS AND CORRECTIONS

DEC. 14, 1973 - BEADS ON PAINT FOR BACKGROUND MATERIAL REMOVED.
MAY 14, 1974 - REFLECTIVE MATERIAL CHANGE.
JUNE 7, 1977 - REFLECTIVE MATERIAL NOTE CHANGED.
JUNE 7, 1977 - SIGNS REFERENCED TO NUMBERS IN M.U.T.C.D.
APR. 20, 1978 - FLAGPERSON SIGN CHANGED TO SYMBOL.
DEC. 19, 1978 - ILLUMINATION DELETED.
FEB. 27, 1980 - SIGN W1-8 AND SIGN PADDLE ADDED. SIGN DETAILS REVISED.
APR. 1, 1980 - SIGN PADDLE SIGN REVISED.

FEB. 3, 1986 - UPDATED TO 1986 SPECIFICATIONS

APPROVED
Dec. 14, 1971
DATE

R. H. Arnold
CHIEF ENGINEER

E. H. Stickney
ASST. CHIEF ENGINEER

G. M. Lane
HIGHWAY ENGINEER

TRAFFIC SIGNS


ON-PROJECT CONSTRUCTION SIGNS



STANDARD


E-6

DELINEATOR AND HAZARD MARKER DETAILS FOR CONSTRUCTION AREAS WHERE TRAFFIC IS MAINTAINED

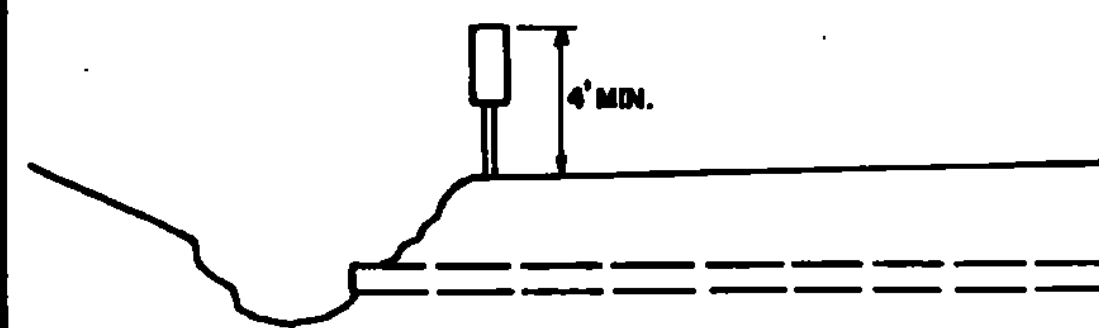


HAZARD MARKER TYPICAL

OBJECTS ADJACENT TO THE ROADWAY SHALL REQUIRE A HAZARD MARKER TO MARK THE OBSTRUCTION. IN SOME CASES THERE MAY NOT BE A PHYSICAL OBJECT INVOLVED BUT OTHER ROADSIDE CONDITIONS SUCH AS NARROW SHOULDER DROP-OFFS, GORES, D.I. EXCAVATIONS OR ABRUPT CHANGE IN THE ROADWAY ALIGNMENT MAY MAKE IT UNDESIRABLE FOR A DRIVER TO LEAVE THE ROADWAY. THE INSIDE EDGE OF THE HAZARD MARKER SHALL BE IN LINE WITH THE INNER EDGE OF THE OBSTRUCTION, WHENEVER POSSIBLE.

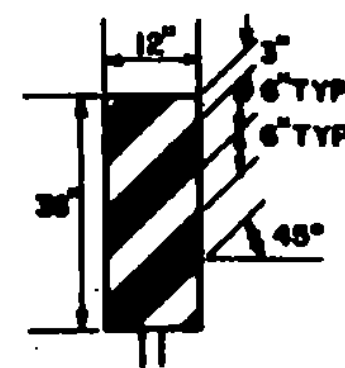

VERTICAL PANEL

VERTICAL PANELS SHALL HAVE ALTERNATING ORANGE AND WHITE REFLECTORIZED STRIPS (SLOPING DOWNWARD IN THE DIRECTION TRAFFIC IS TO PASS). THESE DEVICES MAY BE USED FOR TRAFFIC SEPARATION OR SHOULDER BARRICADES WHERE SPACE IS AT A PREMIUM.

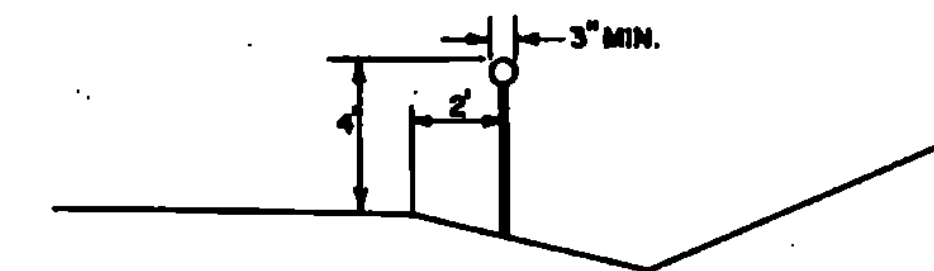


SYMBOL


DELINEATOR TYPICAL

DELINEATORS SHALL BE OF A REFLECTORIZED WHITE COLOR. THEY SHALL HAVE A MINIMUM OF 7 SQUARE INCHES. THEY MAY BE ROUND, SQUARE, OR OBLONG. THEY SHALL BE OF THE FOLLOWING:
1- REFLECTORIZED TAPE WITH METAL BACKING.
2- REFLECTORIZED TAPE APPLIED DIRECTLY TO POSTS.
3- REFLECTORIZED PAINT APPLIED DIRECTLY TO POSTS WHEN PAINT OR TAPE IS APPLIED DIRECTLY TO POST, A SURFACE OF 3' MINIMUM WIDTH FACING TRAFFIC IS REQUIRED.

SEE STANDARD SHEET E-2 FOR SIGN DETAILS FOR "ROAD CONSTRUCTION AHEAD" AND "END CONSTRUCTION" SIGNS.
SEE STANDARD SHEET E-6 FOR SIGN DETAILS FOR THE FOLLOWING SIGNS: "DETOUR AHEAD", "ROAD CLOSED", "DETOUR" ARROW.
SEE STANDARD SHEET E-8 FOR SIGN MATERIAL AND SPECIFICATION NOTES FOR ALL SIGNS DETAILED ON THIS SHEET.

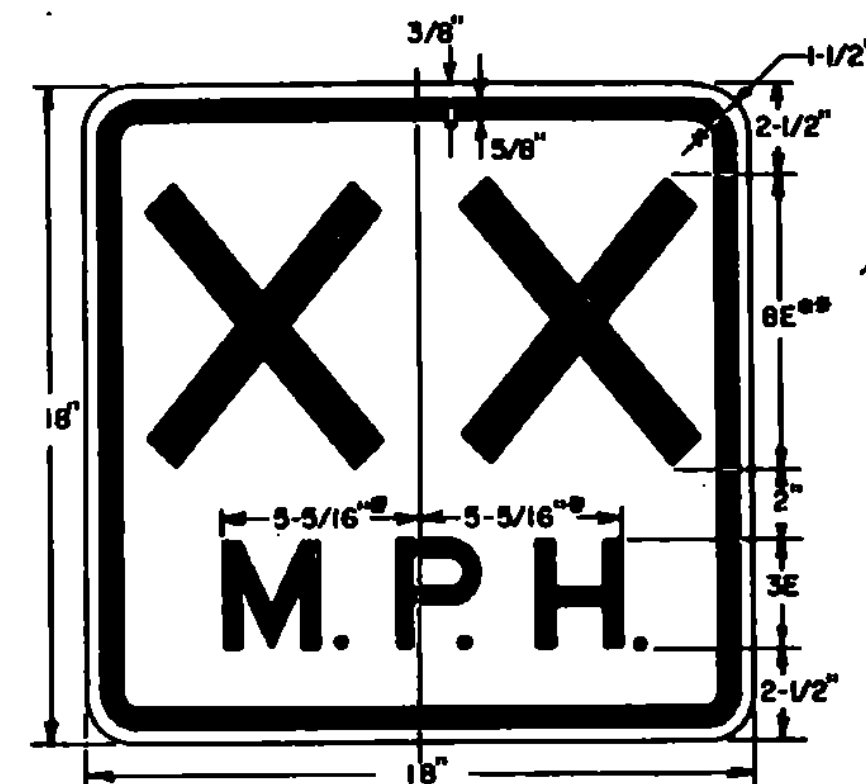


*INCREASE SPACING 100%
**OPTICALLY SPACE NUMERALS ABOUT VERT. CENTERLINE.

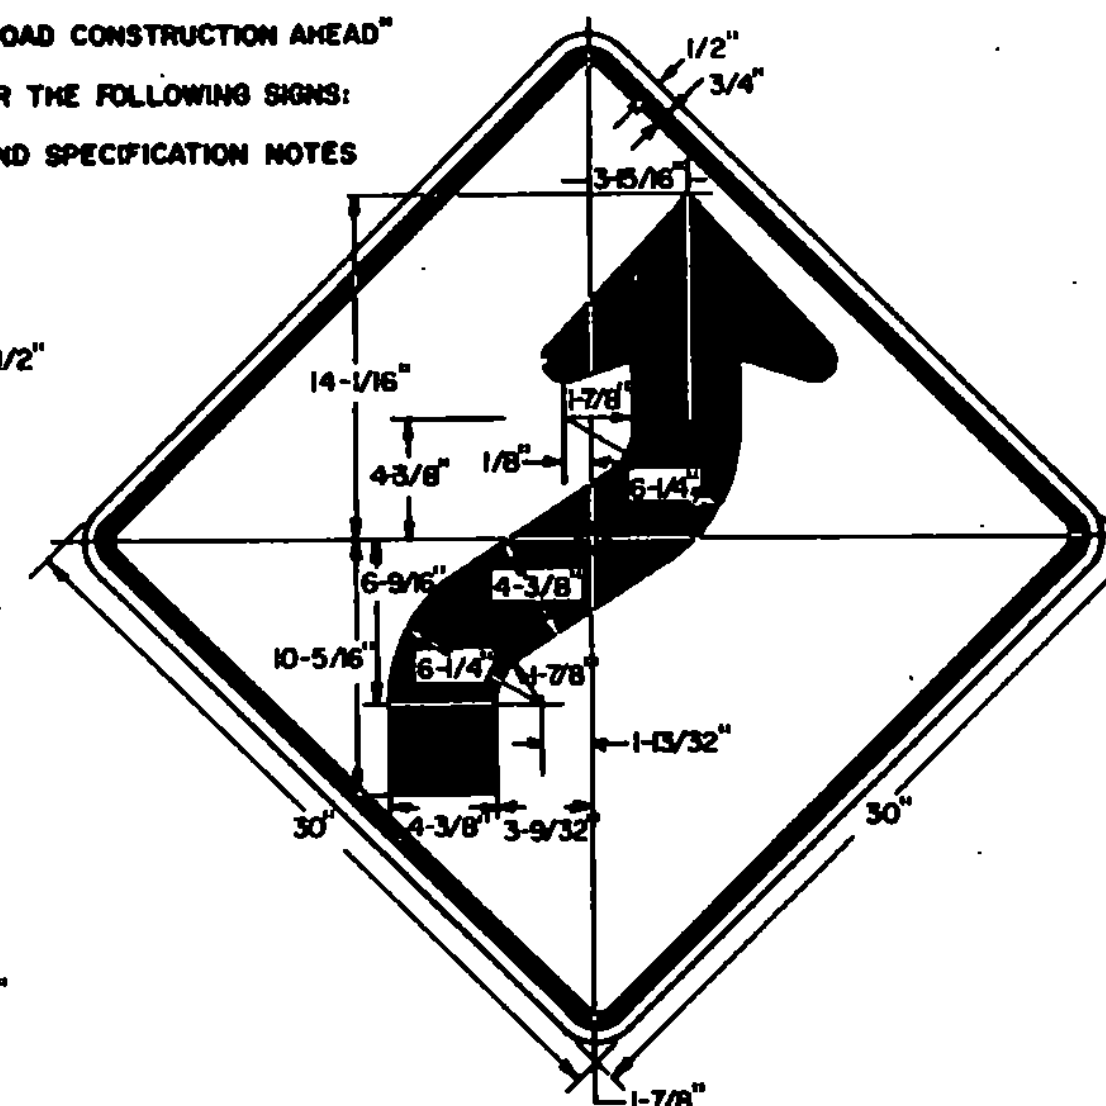

NOTES

1. SIGNS & DELINEATION SHOWN FOR ONE DIRECTION OF TRAVEL ONLY.
2. CHANNELIZING DEVICES SHALL CONSIST OF TYPE II BARRICADES WITH STEADY BURN LIGHTS EXCEPT ON THE FIRST AND LAST BARRICADES WHICH SHALL HAVE A FLASHING LIGHT.
3. FLASHING WARNING LIGHTS MAY BE USED TO CALL ATTENTION TO THE EARLY WARNING SIGNS.
4. CONTRACTOR IS RESPONSIBLE FOR PAVEMENT MARKING AND SHALL REMOVE ANY CONFLICTING OR CONFUSING EXISTING MARKINGS.
5. ADDITIONAL SIGNING MAY BE REQUIRED AT THE DISCRETION OF THE ENGINEER.
6. UNPAVED DETOURS REQUIRE PAVEMENT MARKINGS FOR TRANSITIONS ON EXISTING PAVEMENT.

DESIGN SPEED MPH	REQUIRED RADIUS FT	SPACING - "S" FT
25	150	30
30	250	40
40	450	60
50	750	75

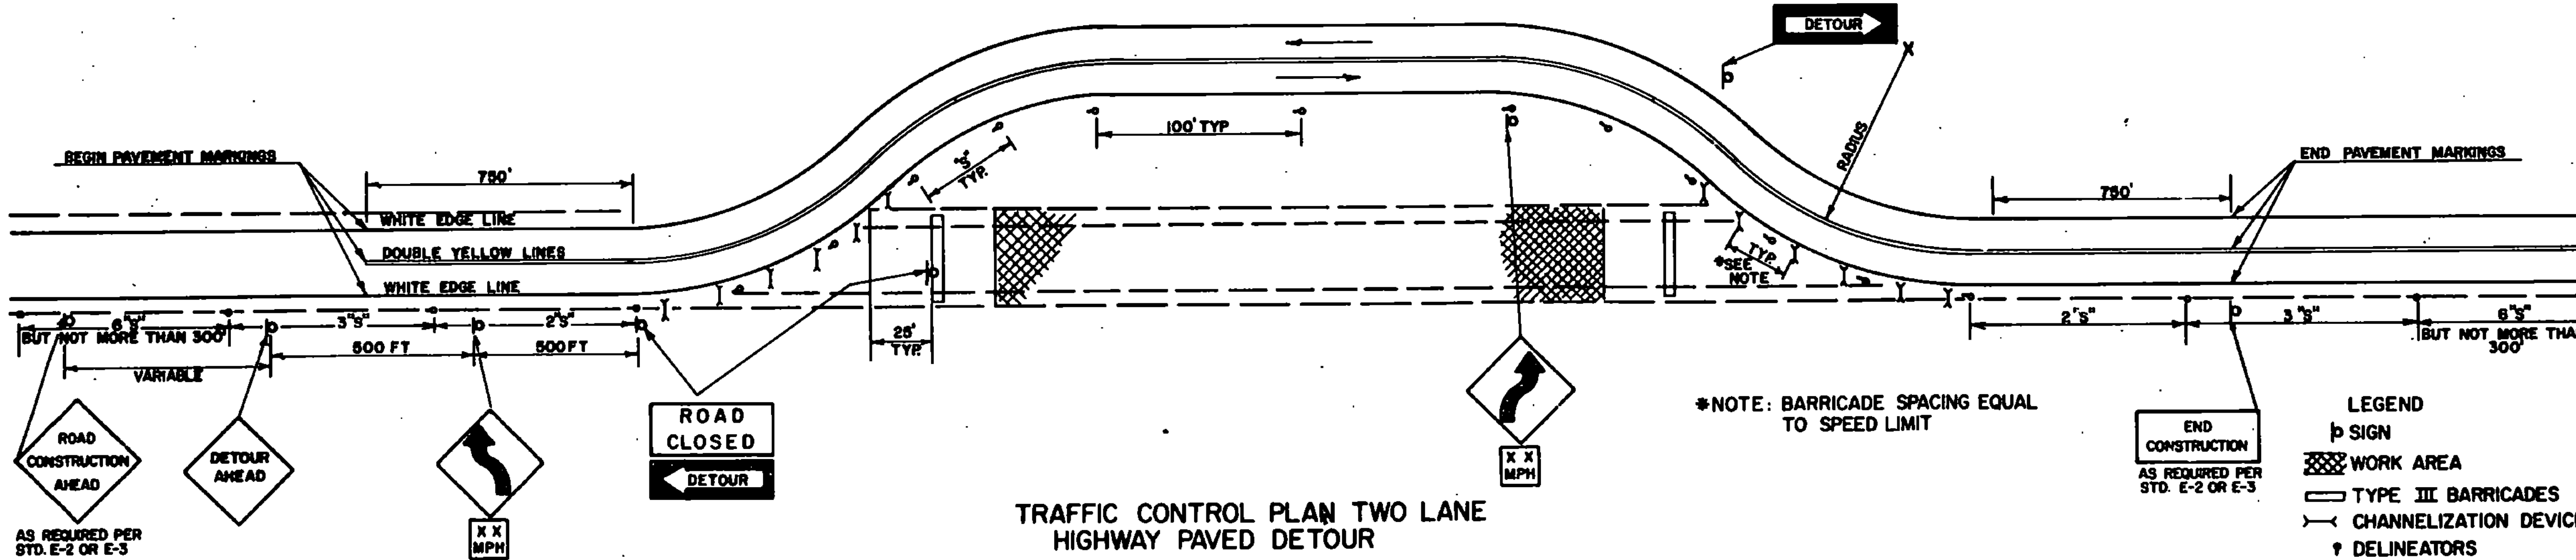

TRAFFIC CONTROL PLAN TWO LANE
HIGHWAY PAVED DETOUR

*NOTE: BARRICADE SPACING EQUAL TO SPEED LIMIT

LEGEND

- SIGN
- ▨ WORK AREA
- ▬ TYPE III BARRICADES
- CHANNELIZATION DEVICES
- DELINEATORS

BARRICADES

APPLICATION NOTES

TYPE I BARRICADES ARE TO BE USED ON CONVENTIONAL ROADS OR URBAN STREET AND ARTERIALS TO MARK A SPECIFIC HAZARD TO CHANNELIZE TRAFFIC.

TYPE II BARRICADES ARE TO BE USED ON EXPRESSWAYS AND FREEWAYS, SERVING THE SAME FUNCTIONS AS THE TYPE I BARRICADES.

TYPE III (SEE STANDARD E-7A) SHALL ONLY BE USED WHEN A ROAD SECTION IS CLOSED TO TRAFFIC TO BE ERECTED AT THE POINT OF CLOSURE.

MATERIALS

THE BARRICADES SHOWN ON THIS SHEET NORMALLY WILL BE OF LIGHTWEIGHT MATERIAL. IF WOOD IS USED THE FOLLOWING CONDITIONS SHALL APPLY.

1. WOODEN BARRICADES (TYPES I AND II)

A. SHALL NOT BE USED TO CHANNELIZE OR DELINEATE WORK AREAS WITHIN THE CLEAR ZONE OF ANY HIGHWAY WHERE OPERATING SPEEDS IN EXCESS OF 20 MILES PER HOUR ARE EXPECTED UNLESS INSTALLED FOR PEDESTRIAN CONTROL BEHIND APPROVED POSITIVE BARRIERS.

B. MAY BE USED IF OPERATING SPEEDS OF 20 M.P.H. OR LESS ARE EXPECTED.

2. TYPE III WOODEN BARRICADES SHALL NOT BE USED WITHIN THE CLEAR ZONE OF ANY HIGHWAY REGARDLESS OF THE TRAFFIC OPERATING SPEED.

DESIGN

THE DESIGN OF THE BARRICADES SHALL CONFORM WITH THE DETAILS SHOWN ON THIS SHEET AND THE MARKINGS ON THE BARRICADES SHALL BE ALTERNATE ORANGE AND WHITE STRIPES (SLOPING DOWNWARD AT AN ANGLE OF 45° IN THE DIRECTION TRAFFIC IS TO PASS).

COLORS


THE BARRICADES PANELS SHOWN ON THIS SHEET SHALL HAVE ALTERNATING REFLECTORIZED WHITE AND ORANGE STRIPES. THE ORANGE SHALL CONFORM WITH THE STANDARD COLORS ADOPTED BY THE AMERICAN ASSOCIATION OF STATE HIGHWAY & TRANSPORTATION OFFICIALS AND APPROVED BY THE U.S. DEPARTMENT OF TRANSPORTATION FEDERAL HIGHWAY ADMINISTRATION. THE BARRICADE COMPONENTS SHALL BE WHITE EXCEPT THAT UNPAINTED METAL OR ALUMINUM MAY BE USED.

REFLECTORIZATION

THE BARRICADES SHALL BE REFLECTORIZED WITH REFLECTIVE SHEETING.

LOCATION


THE BARRICADES SHOWN ON THIS SHEET WILL BE LOCATED BY THE ENGINEER IN THE FIELD OR AS SHOWN ON THE PLANS. THE LOCATION OF THE BARRICADES SHALL FOLLOW THE PROCEDURES SET FORTH IN THE MANUAL ON UNIFORM TRAFFIC CONTROL DEVICES, OR AS OTHERWISE NOTED.

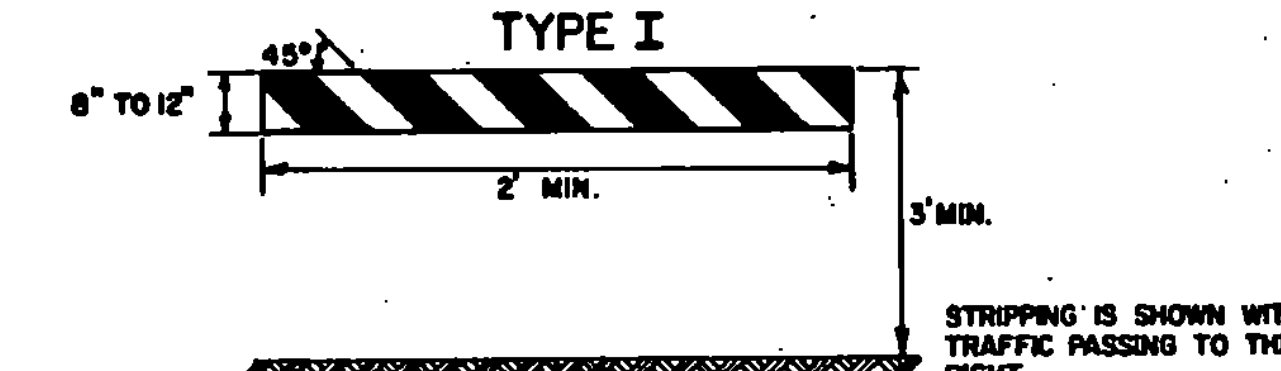

TYPE II



TYPE III

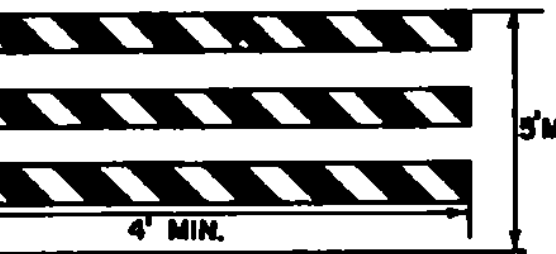

BARRICADE CHARACTERISTICS	I	II
WIDTH OF RAIL	8" MIN. 12" MAX.	8" MIN. 12" MAX.
LENGTH OF RAIL	2' MIN.	2' MIN.
WIDTH OF STRIPS	6"	6"
HEIGHT	3' MIN.	3' MIN.
TYPE OF FRAME	DEMOUNTABLE OR A FRAME	LIGHT A FRAME NO STRY BRACE
FLEXIBILITY	ESSENTIALLY MOVEABLE	PORTABLE
ANGLE OF STRIPE	45°	45°
COLOR OF STRIPS	ORANGE AND WHITE	ORANGE AND WHITE

*FOR RAILS LESS THAN 3 FEET LONG, 4" WIDE STRIPS SHALL BE USED.

MAINTENANCE

BARRICADES SHALL BE MAINTAINED IN A CLEAN AND LEGIBLE CONDITION SATISFACTORY TO THE ENGINEER. THEY SHALL BE COMPLETELY VISIBLE TO APPROACHING TRAFFIC AT ALL TIMES. DAMAGED, DEFACED, OR DIRTY BARRICADES SHALL BE REPAIRED, CLEANED, OR REPLACED AS ORDERED BY THE ENGINEER.


LIGHTING

FOR NIGHTTIME USE ADD FLASHING WARNING LIGHTS WHEN BARRICADES ARE USED SINGLY AND STEADY BURN LIGHTS WHEN BARRICADES ARE USED IN A SERIES FOR CHANNELIZATION. THE LIGHTING DEVICES SHALL CONFORM TO THOSE SPECIFIED IN THE MUTCD.


REVISIONS AND CORRECTIONS
FEB. 12, 1982 MATERIALS NOTE CLARIFIED, SIGN ADDITIONS.
FEB. 2, 1983 NOTE # 6 RE: UNPAVED DETOURS ADDED.
FEB. 8, 1986 - UPDATED TO 1986 SPECIFICATIONS

APPROVED: SEPT. 22, 1981
DATE
DIRECTOR OF ENGINEERING AND CONSTRUCTION
CHIEF OF DESIGN
TRANSPORTATION DESIGN ENGINEER

DELINEATION, BARRICADES AND DETOURS FOR CONSTRUCTION AREAS

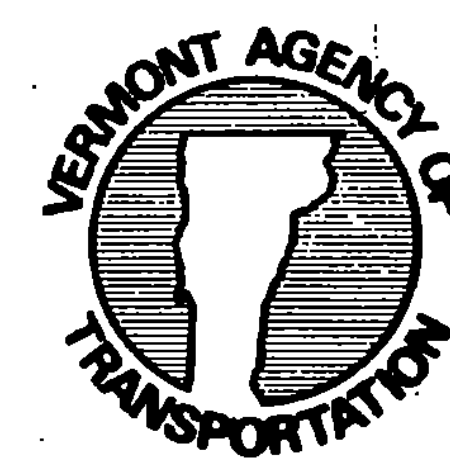


STANDARD E-7

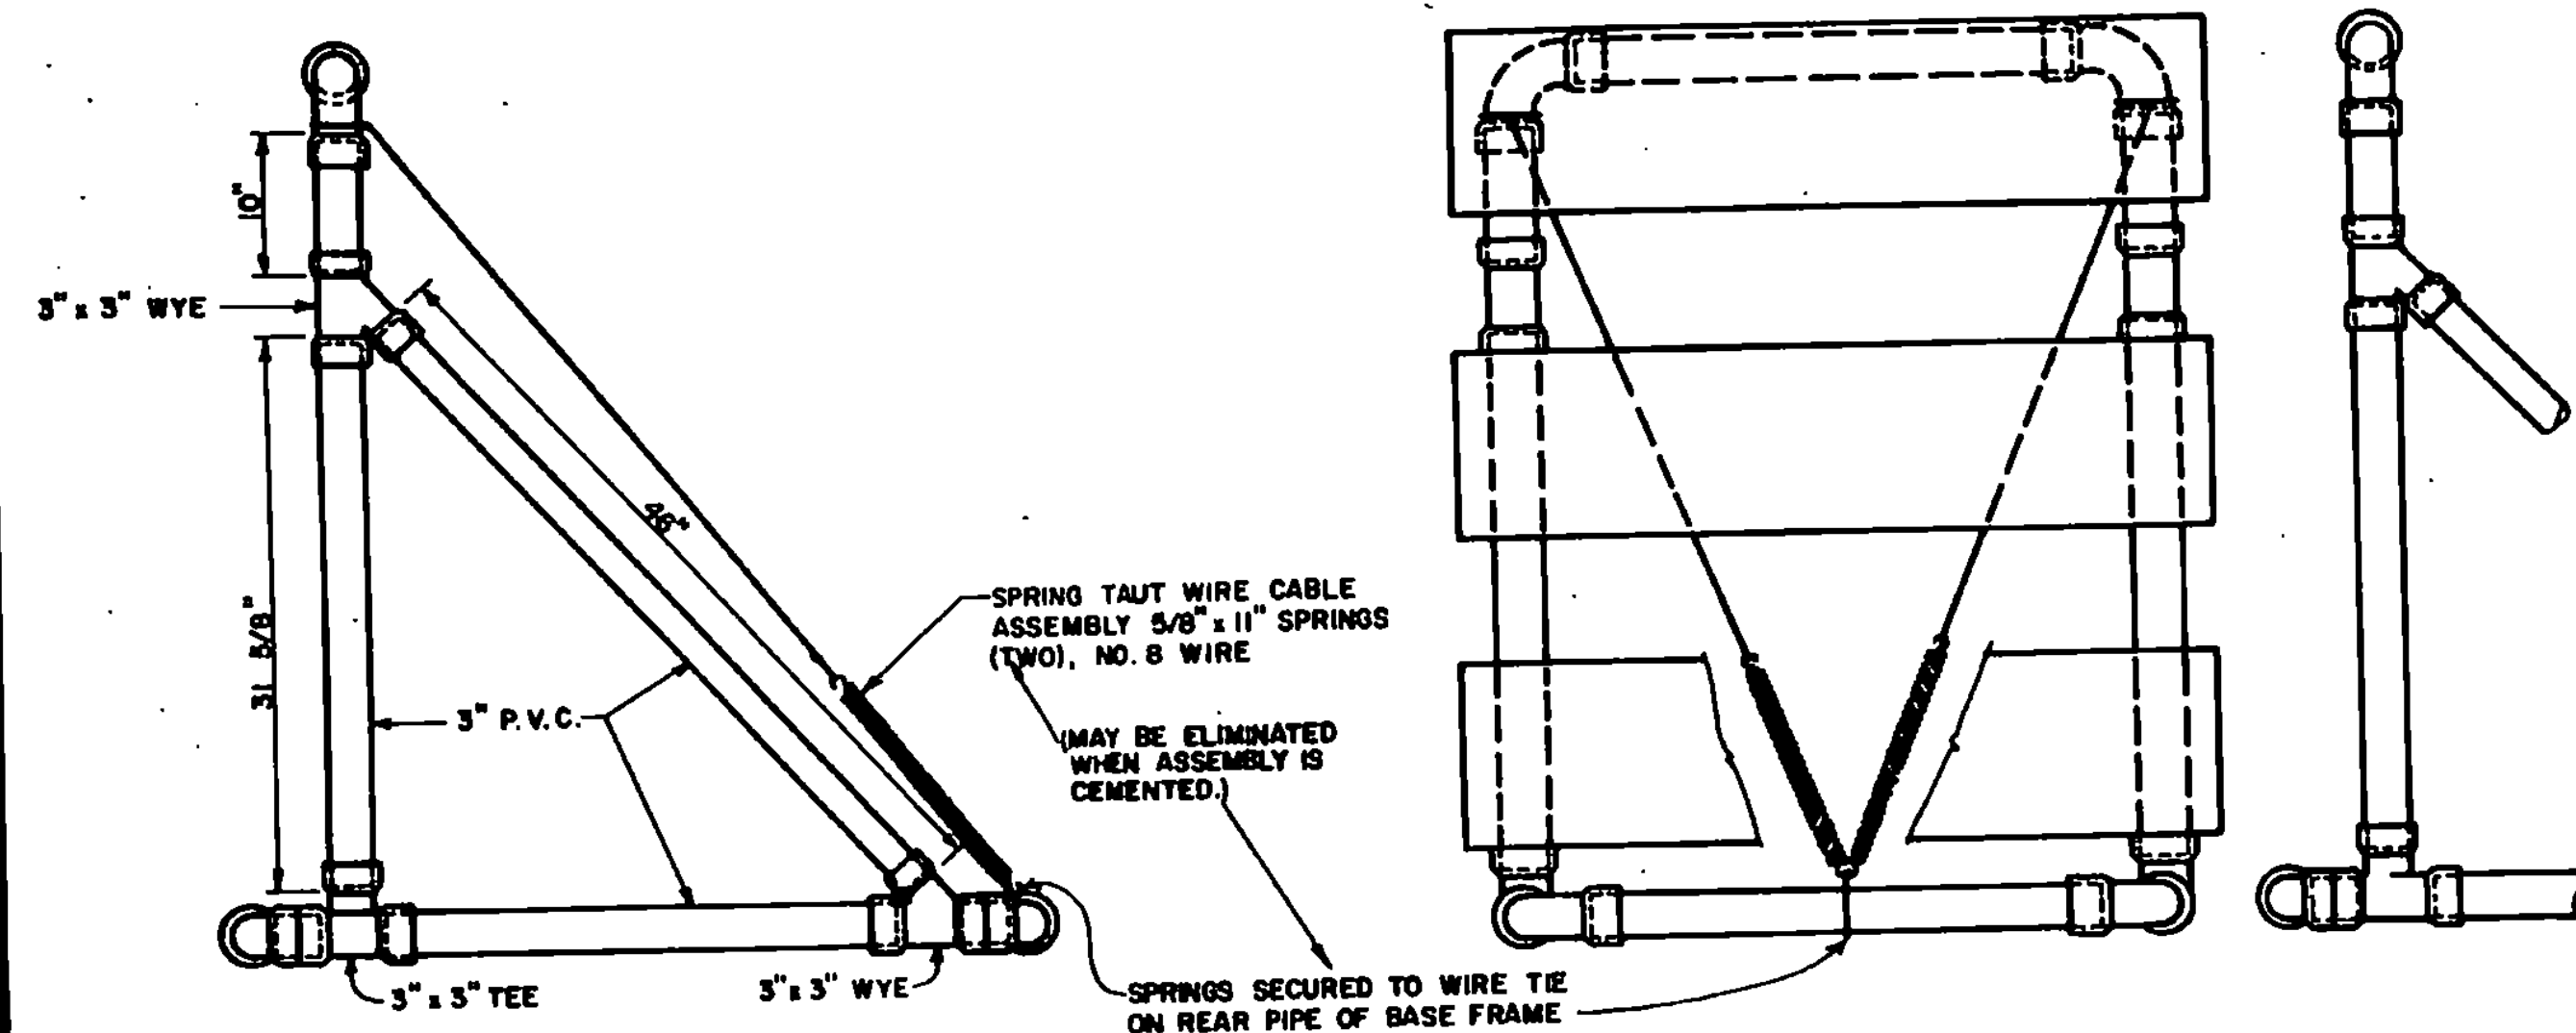


SIDE VIEW

BARRICADES SHALL BE STABILIZED WITH SAND BAGS OF MINIMUM WEIGHT WHICH WILL NOT CONSTITUTE A HAZARD WHEN BARRICADE IS HIT. THEY SHALL BE PLACED ONLY ON THE BASE FRAME OF THE BARRICADE. STABILIZERS SHALL BE SO PLACED AS NOT TO BE A HAZARD TO VEHICLES PASSING ON EITHER SIDE.

IF BARRICADE REPLACEMENT COSTS CAN BE CONSIDERED NEGLIGIBLE, GLUED JOINTS MAY PROVIDE ADDITIONAL STABILITY TO THE INSTALLATION.

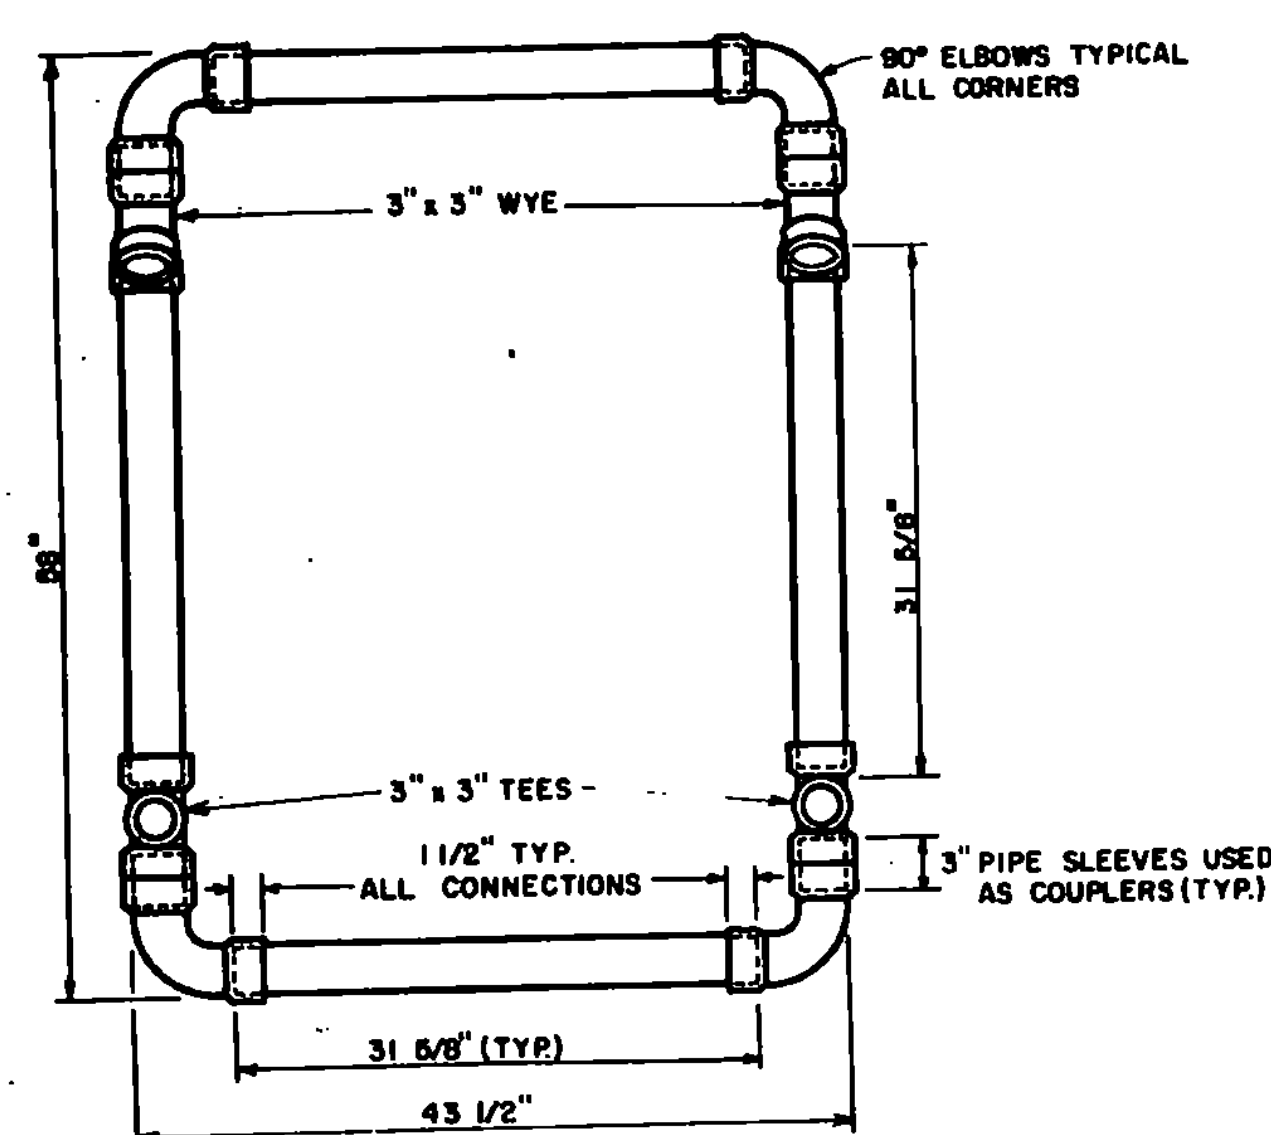


TOP VIEW OF BASE

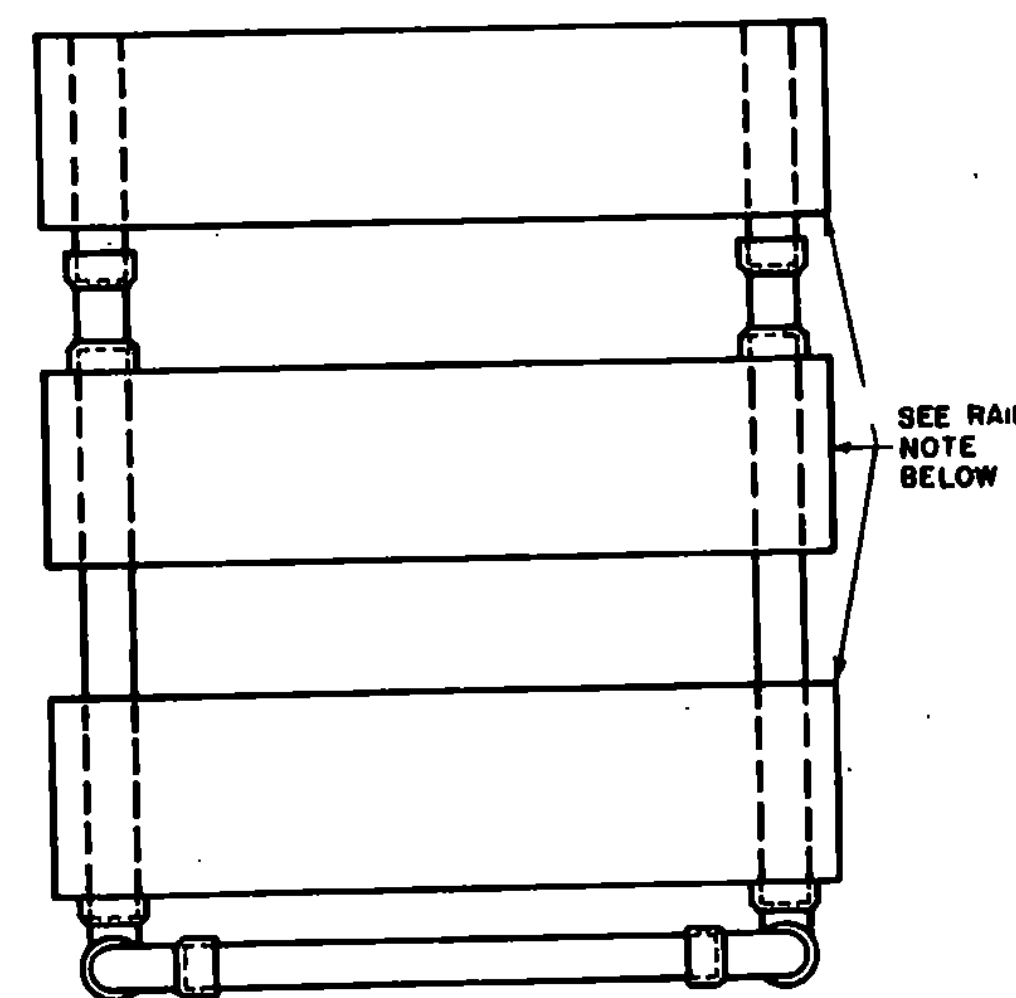

SEE STANDARD E-7 FOR RAIL DETAILS.
RAILS ATTACHED WITH 1" NO. 14 PAN HEAD METAL SCREW.

FRONT VIEW

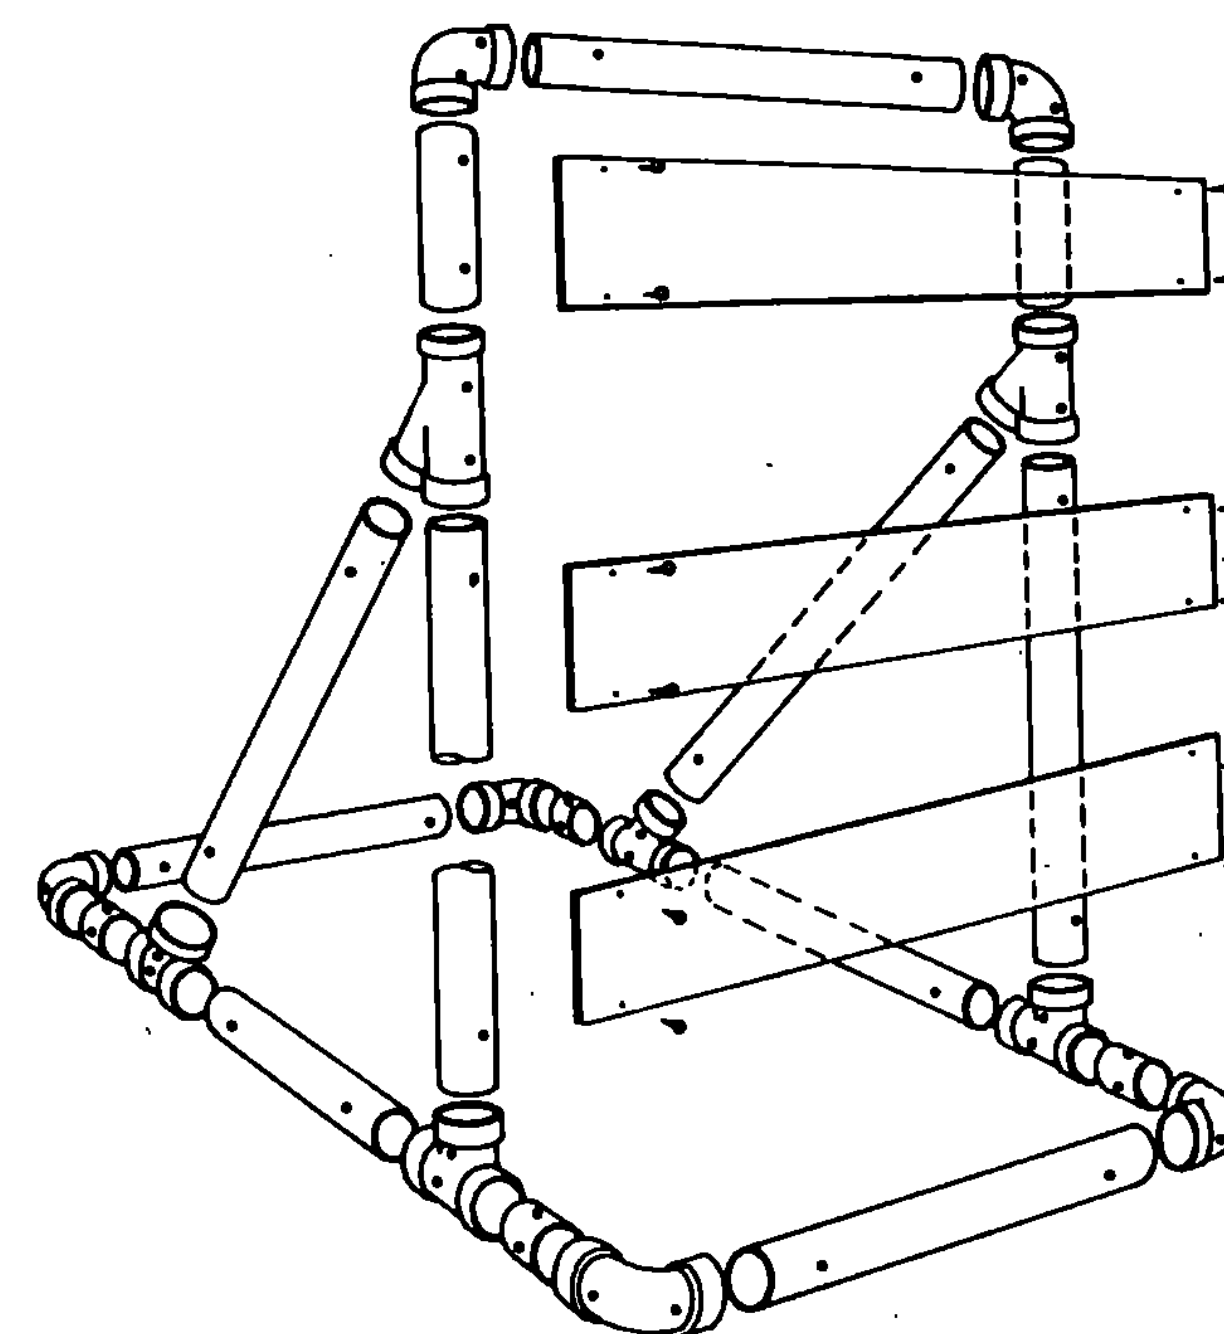



BARRICADE ASSEMBLY

MATERIALS LIST FOR ONE BARRICADE

3" Diameter Pipe	30 LF
3" 1/4 Bend Elbow	6 EA
3" Tees	2 EA
3" Wyes	4 EA
6" x 48" x 0.75 Barricade Panels	2 EA
5/8" x 11" No. 8 Spring	2 EA
1" No. 14 Pan Head Metal Screws	12 EA
No. 14 Black Annealed Tie Wire	15 LF

WARNING LIGHTS

WARNING LIGHTS, IF REQUIRED BY THE LAND OR RESIDENT ENGINEER, SHALL BE AFFIXED TO THE TOP OF THESE BREAKAWAY BARRICADES WITH A MINIMUM MOUNTING HEIGHT OF 36 INCHES TO THE BOTTOM OF THE LENS. A FLASHING WARNING LIGHT SHOULD BE PLACED ON BARRICADES USED SINGLY AND STEADY BURN TRAFFIC LIGHTS SHOULD BE PLACED ON BARRICADES USED IN A SERIES FOR TRAFFIC CHANNELIZATION. THE WARNING LIGHTS SHALL CONFORM TO THE REQUIREMENTS FOUND IN THE M.U.T.C.D. WHEN THE INTEGRAL WARNING LIGHT UNIT IS USED, THE BATTERY PACK SHALL CONTAIN A LIGHT WEIGHT DRY CELL BATTERY AND THE UNIT SHALL BE RESTRAINED WITH A TETHER CABLE OR WIRE (12' LENGTH) SECURELY FASTENED TO THE BARRICADES SO AS TO AVOID HAVING THE UNIT BECOME A DANGEROUS FLYING OBJECT IF THE BARRICADE IS HIT.

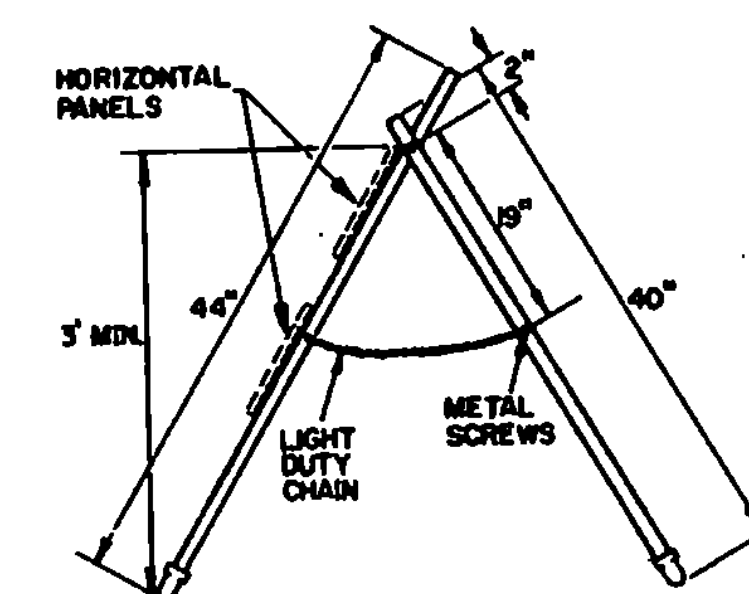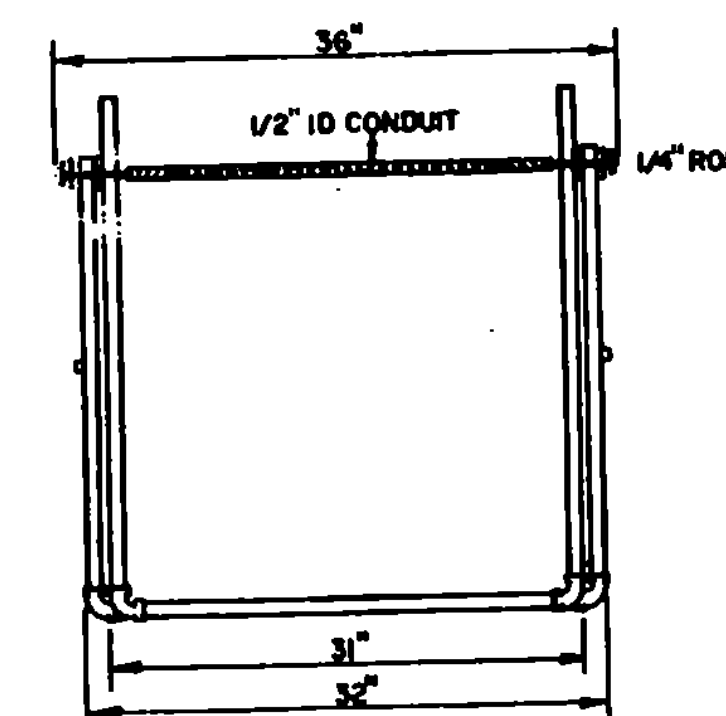

TYPE I & II BARRICADE DETAILS

MATERIALS

The pipe, wyes, tees and elbows used to construct Barricades shall conform to the requirements of ASTM designation D 2241 for P.V.C. 1120 or 1220 SDR-21, pressure rating 200 p.s.i. The Wyes, tees and elbows shall conform to the requirements of ASTM Designation D 2466, Type II, Grade 1. All joints shall be slip-fit and may be lightly cemented.

The 8" x 48" barricade rails shall be fabricated from 0.025" anodized aluminum and shall have reflectorized alternating, orange and white stripes (sloping downward at an angle of 45 degrees in the direction traffic is to pass).

COLORS

The barricades shown on the sheet shall have reflectorized orange and white stripes.

The orange shall conform with the standard color adopted by the American Association of State Highway And Transportation Officials and approved by the U.S. Department of Transportation, Federal Highway Administration.

LOCATION

The barricades shown on this sheet will be located by the Engineer in the field or as shown on the plans. The locations of the barricades shall follow the procedures set forth in the Manual on Uniform Traffic Control Devices.

MAINTENANCE

Barricades shall be maintained in clean and legible conditions satisfactory to the Engineer.

They shall be completely visible to approaching traffic at all times. Damages, defaced, or dirty barricades shall be repaired cleaned or replaced as ordered by the Engineer.

The P.V.C. Pipe and fittings shall be white in color. If the fittings are not available, other colors may be substituted.

At least two (2) holes shall be drilled (3/16" to 1/4") in each section of pipe and fittings if the assembly is not cemented.

MATERIALS FOR TYPE I & II BARRICADES

- 20'-J" PVC
- 4'-J" PVC 90° ELBOWS
- 30'-1/2" ID THINWALL CONDUIT
- 36"-1/4" STEEL ROD
- 4'-J" WASHERS
- 24'-LIGHT DUTY CHAIN
- 4'-METAL SCREWS
- 2-3/4" CUTTER PINS

TYPE I BARRICADES SHALL CONSIST OF ONE HORIZONTAL PANEL.
TYPE II BARRICADES SHALL CONSIST OF AN ADDITIONAL HORIZONTAL PANEL MOUNTED BELOW THE OTHER.
SEE STD E-7 FOR USE REQUIREMENTS.

REVISIONS & CORRECTIONS

JAN. 11, 1977 - REVISED ACCORDING TO FHWA REQUIREMENTS.
JUNE 8, 1977 - MATERIALS LIST ADDED.
APR. 8, 1982 - CEMENTING NOTE AND BARRICADES TYPE I & II ADDED.
JUNE 13, 1984 - RAILS CHANGED FROM 9" TO 8".
JUNE 3, 1985 - SAND AND WARNING LIGHT NOTE ADDED.
FEB. 3, 1986 - UPDATED TO 1986 SPECIFICATIONS

APPROVED

Dec 30, 1976
DATE


E. H. Stackney
CHIEF ENGINEER

R. O. Munn
ASST. CHIEF ENGINEER

Lois E. Jones
HIGHWAY ENGINEER











TRAFFIC SIGNS

BREAKAWAY BARRICADE DETAILS

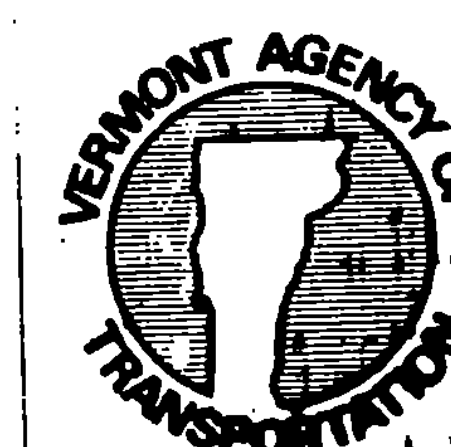

STANDARD

E-7a

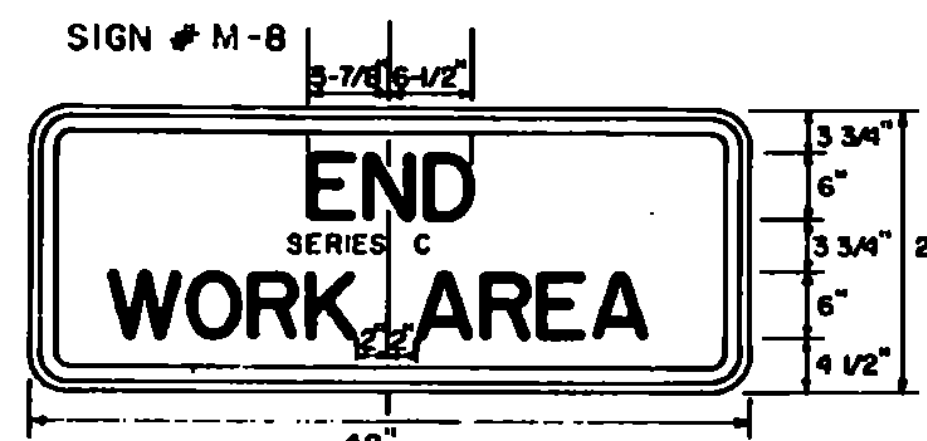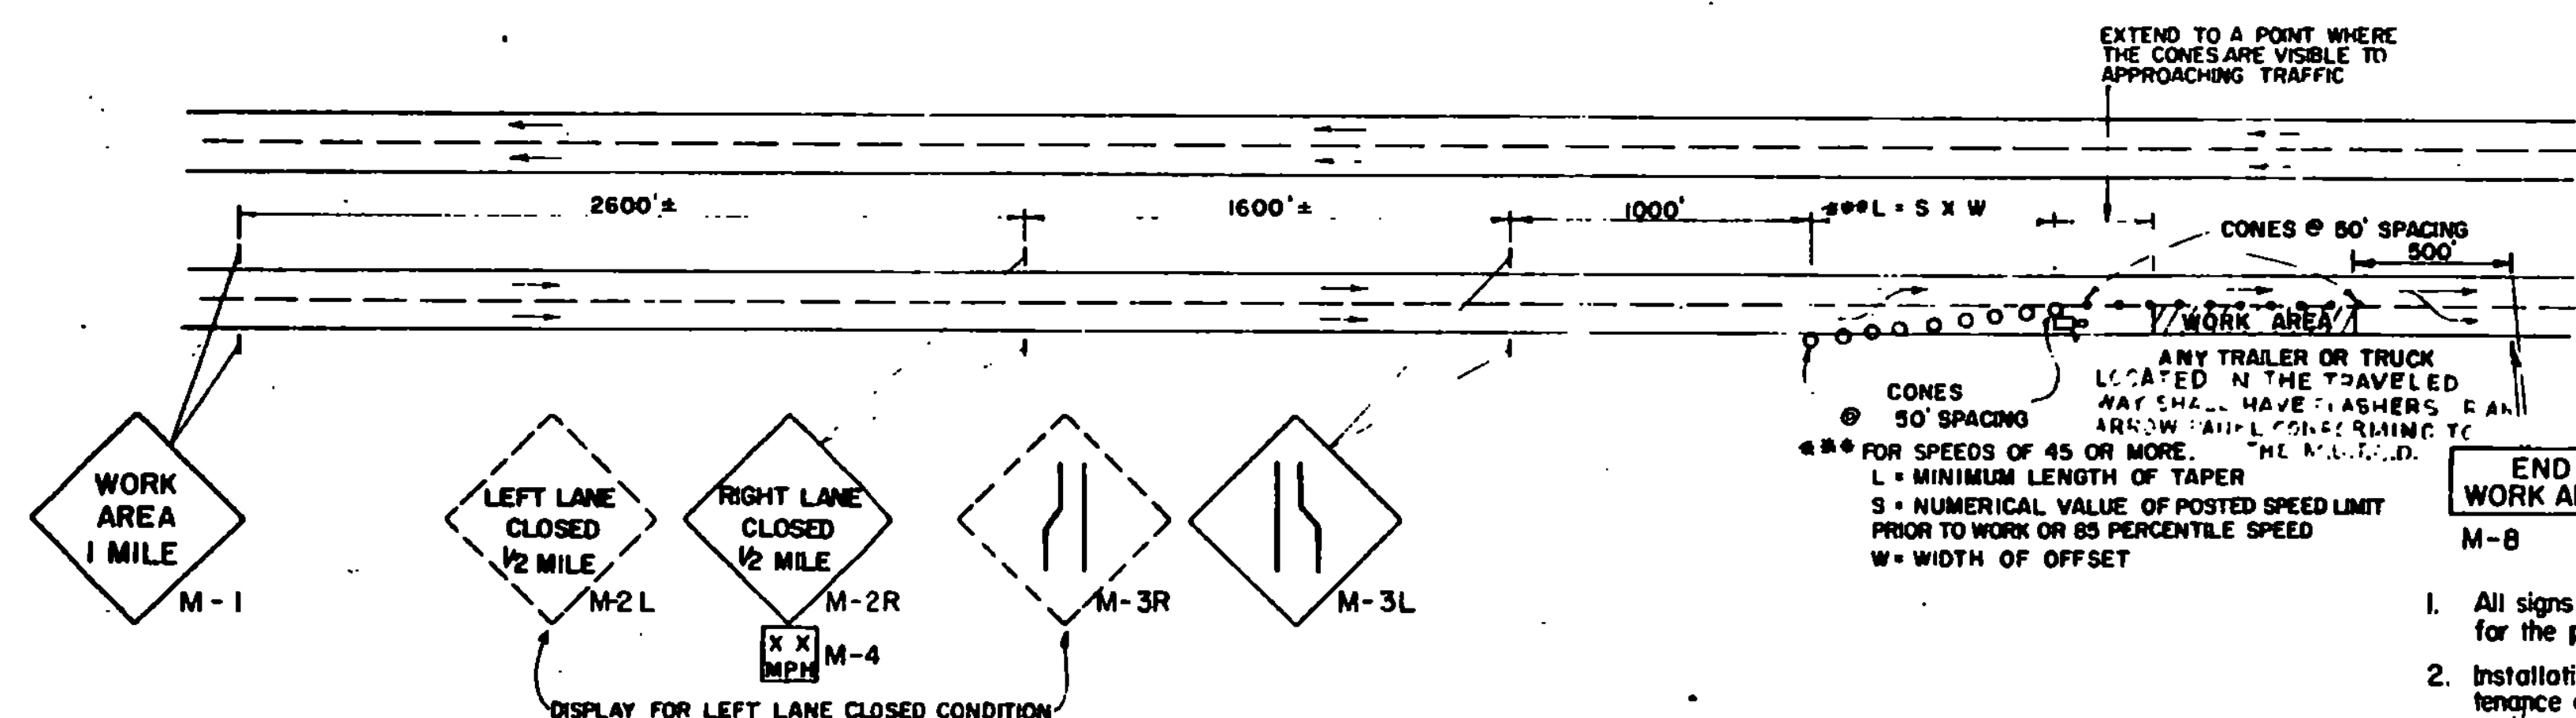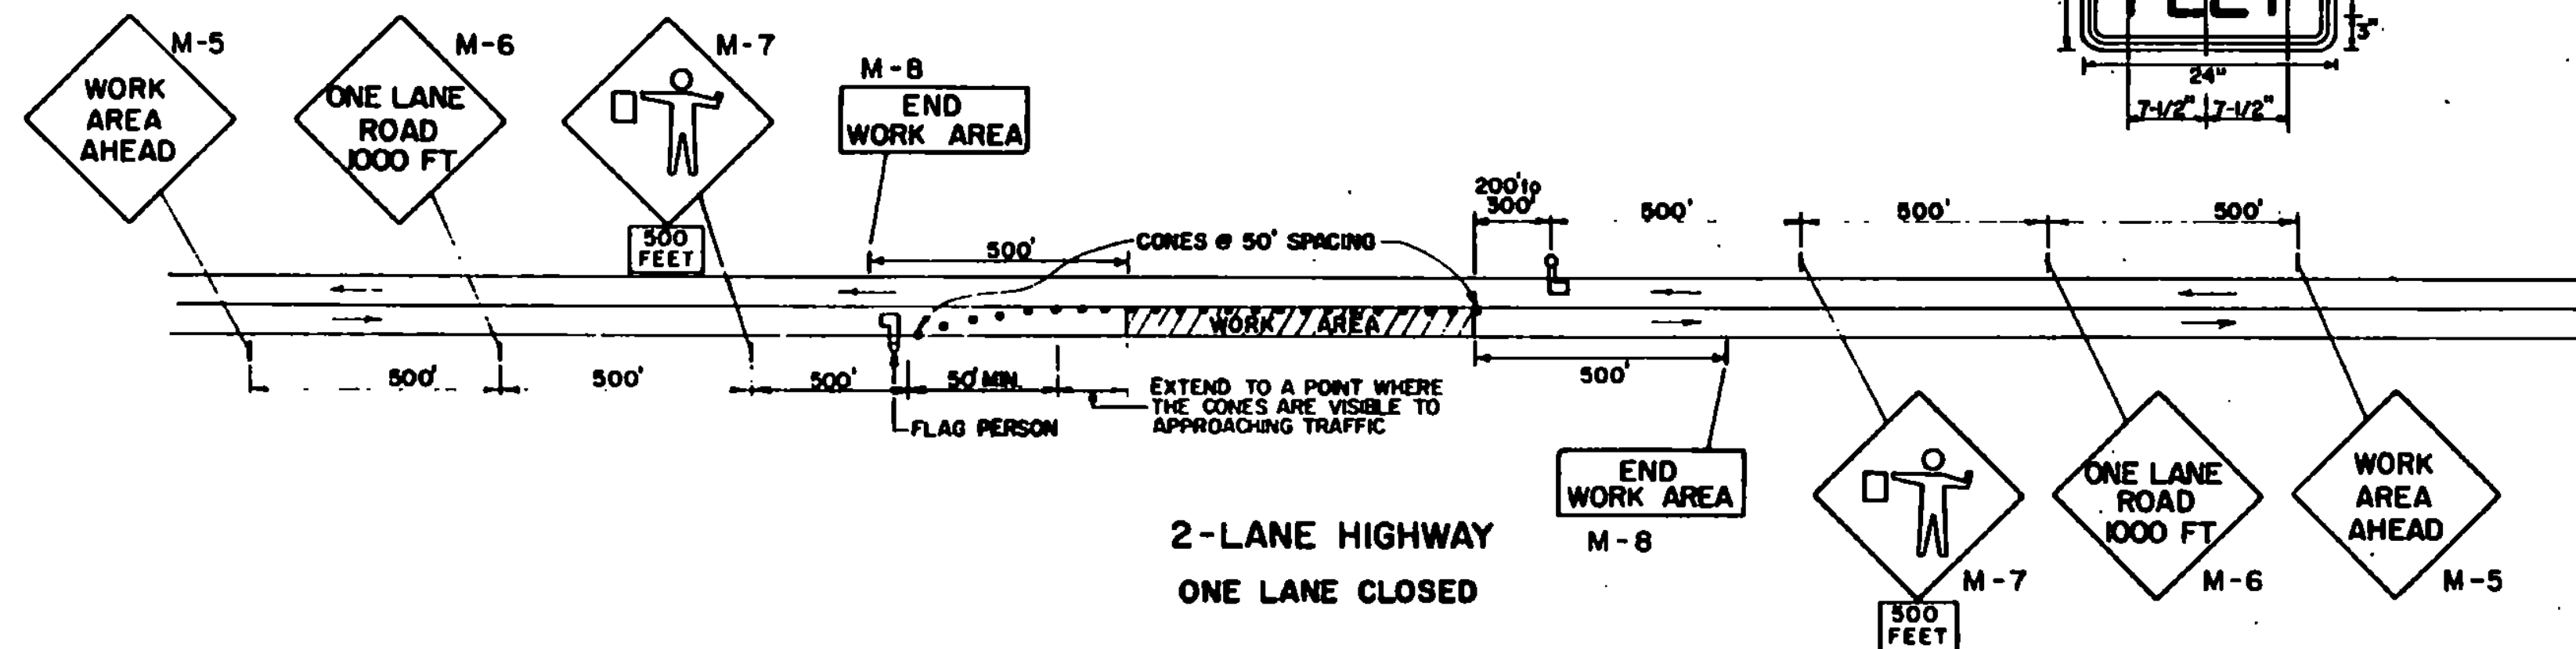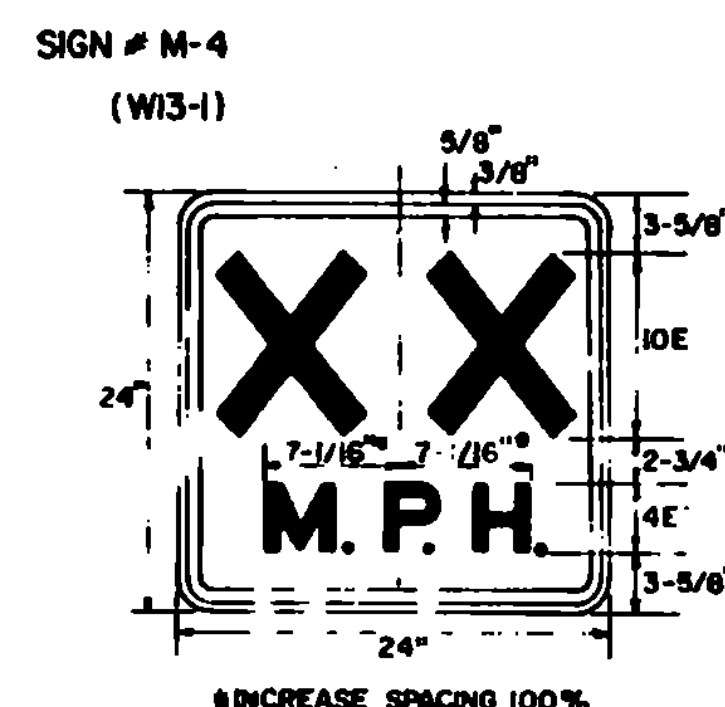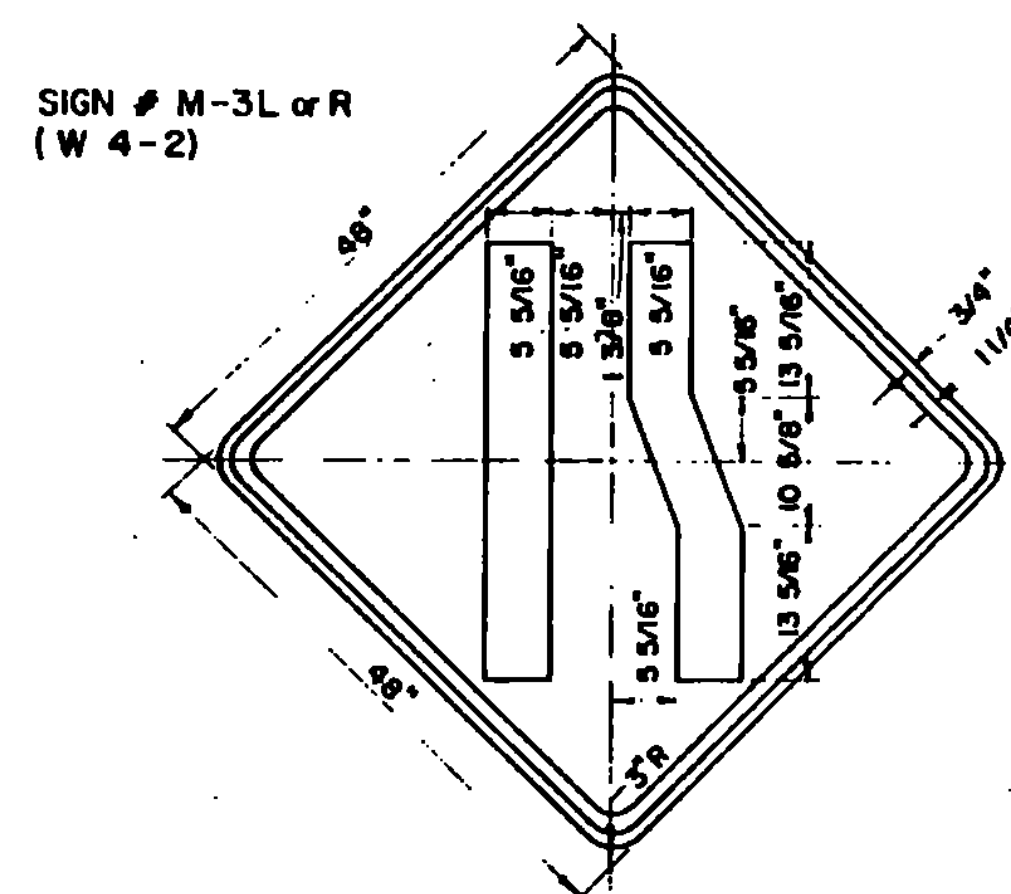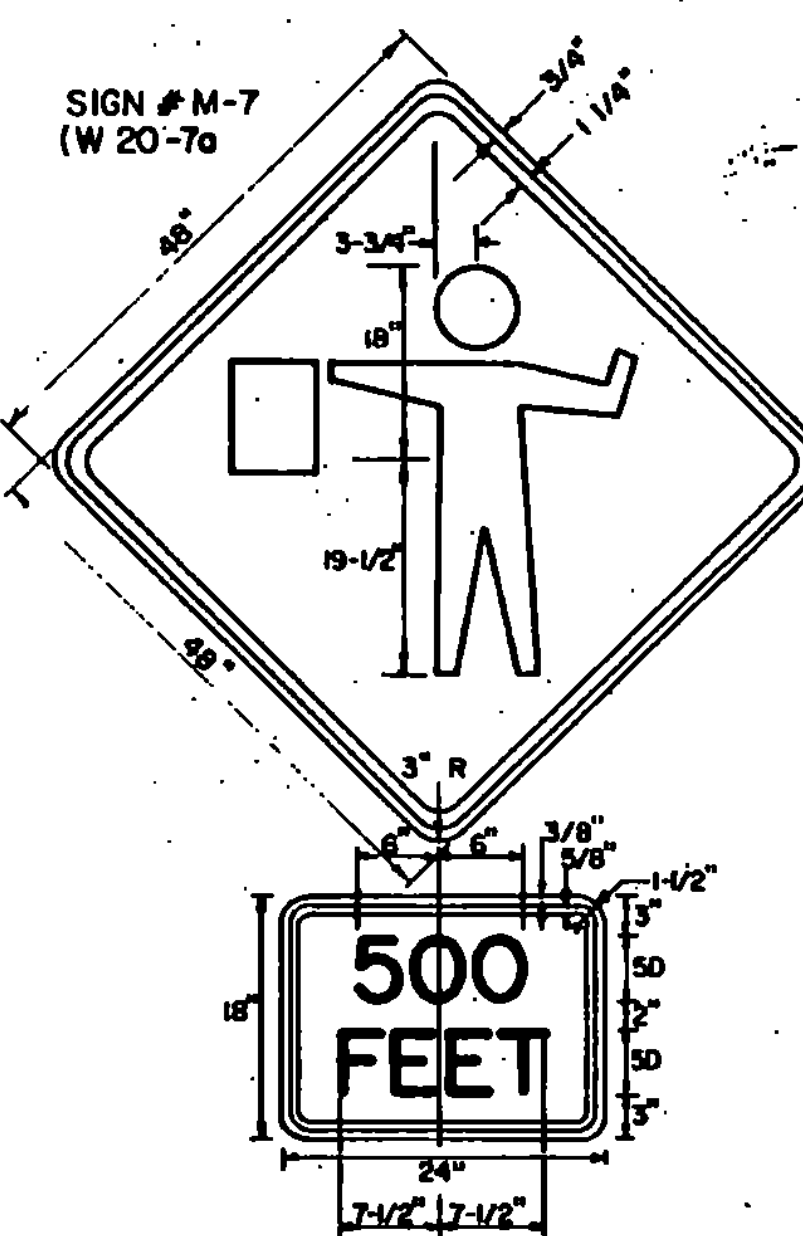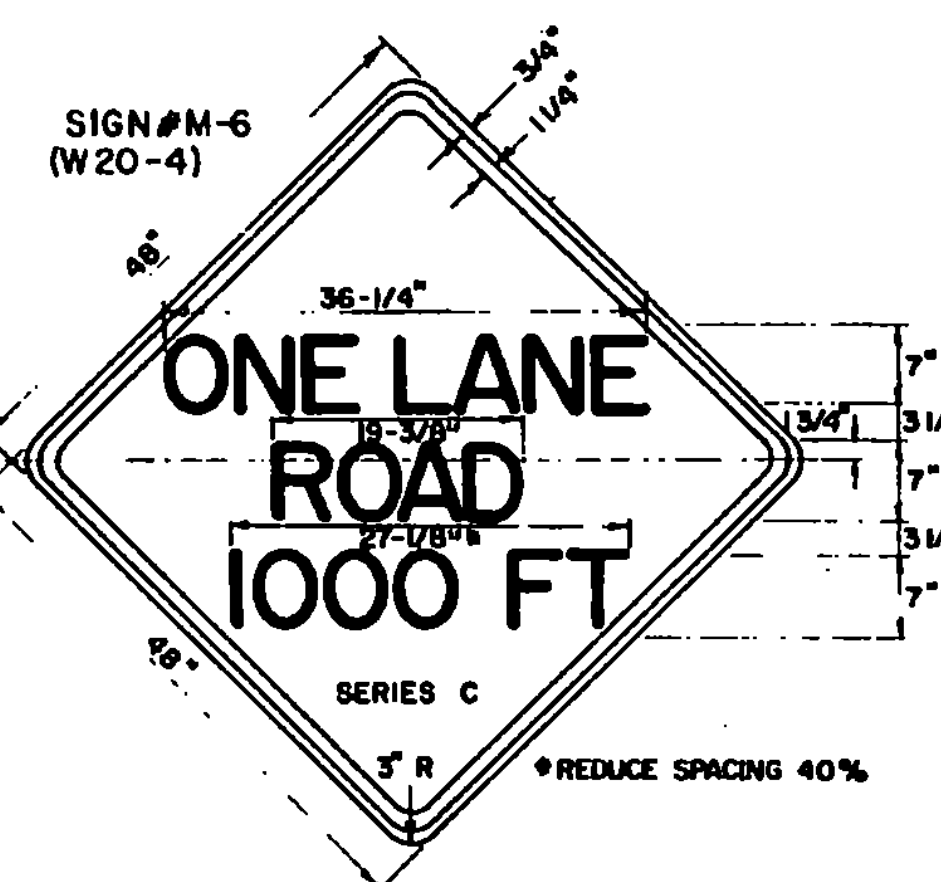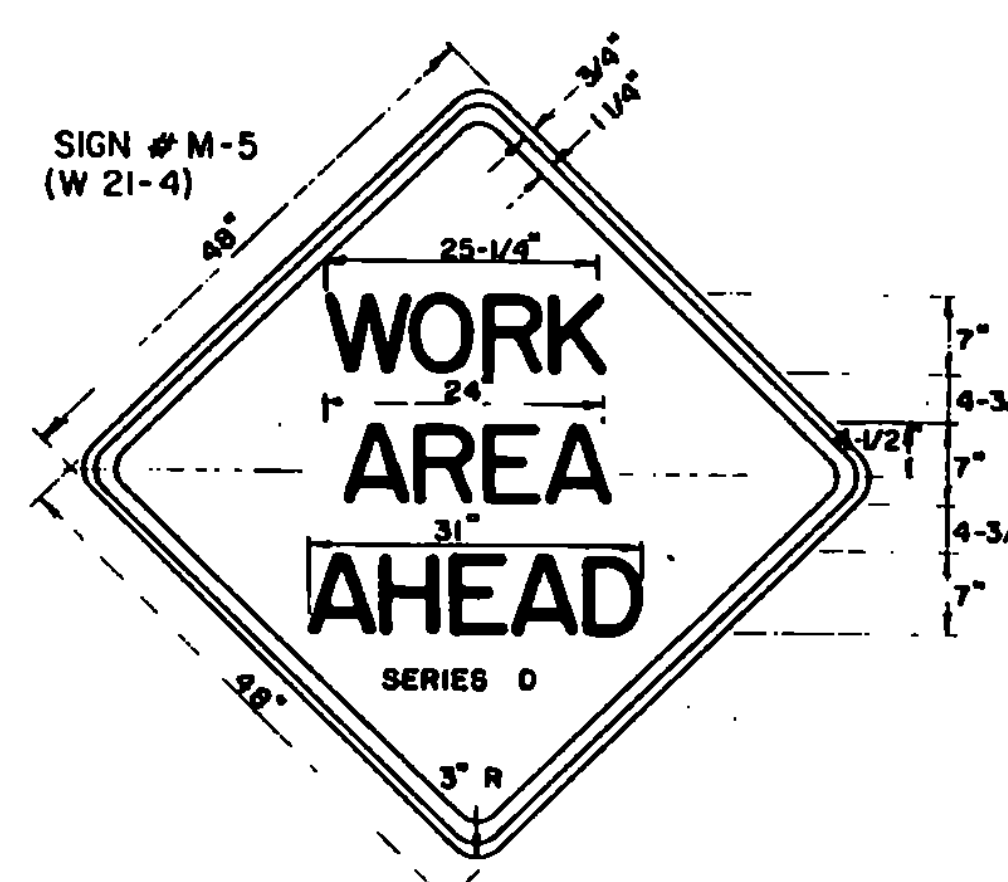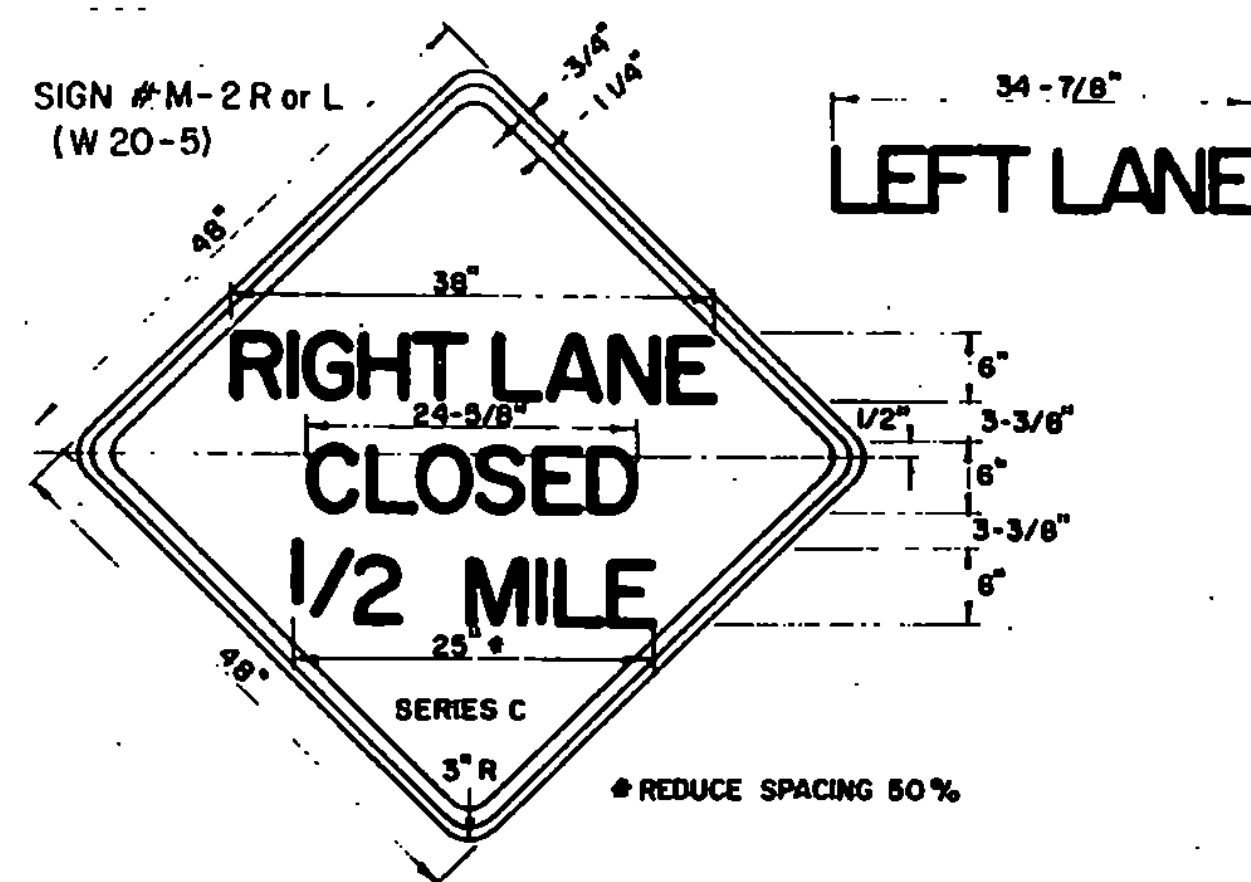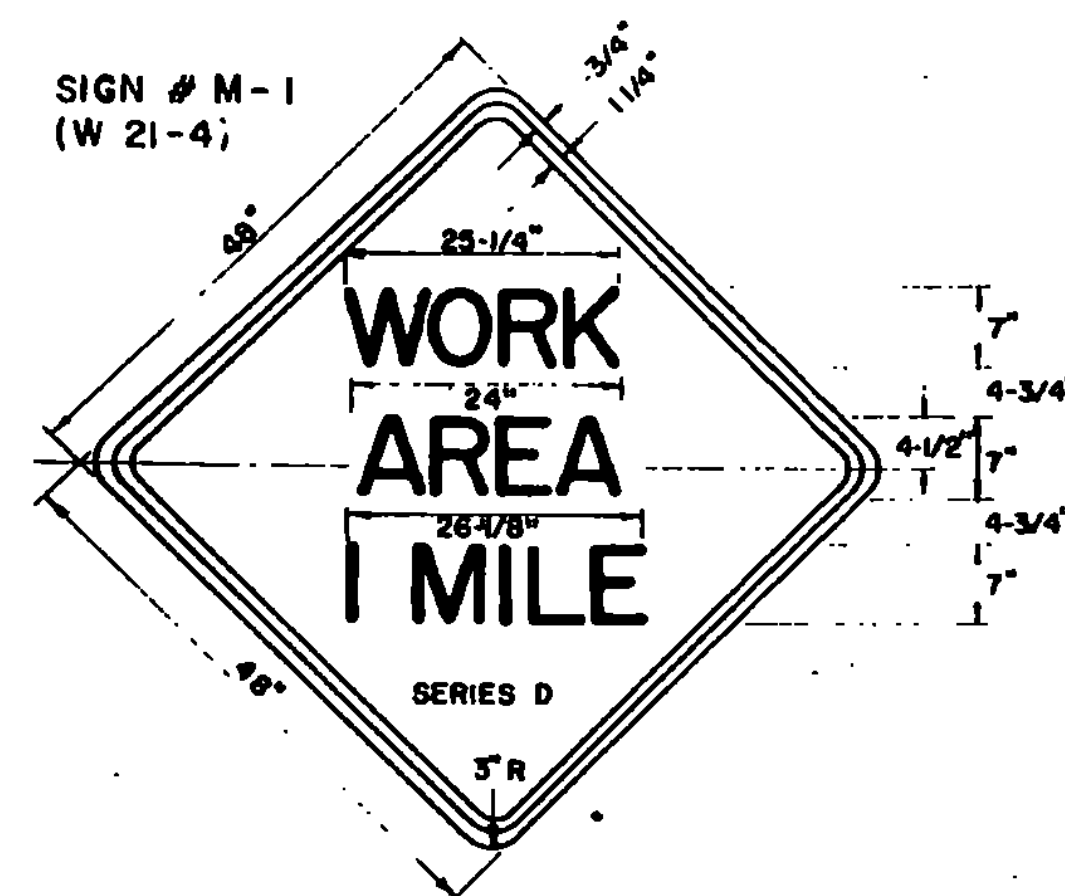

NOTES

1. All signs shall be covered or removed at the end of the working day unless required for the protection and safety of the traveling public.
2. Installation: Signs and barricades shall be in place prior to the start of the maintenance operation to which they apply and shall be removed promptly when the need no longer exists. Each sign shall be erected in a neat and workmanlike manner on wood or metal posts set securely in the ground, or on portable supports for temporary use, or on barricades when appropriate. As a general rule, roadside signs shall be 5 feet above road level with the nearest edge at least 6 feet outside the shoulder point. The installation of all signs and barricades shall be subject to the approval of the Engineer.
3. Numbers in parenthesis indicate M.U.T.C.D. sign designations.
4. "ROAD WORK" or "BRIDGE WORK" may be substituted as the appropriate legend for signs # M-1 or M-5.

Reflectorization

All reflectorized material shall consist of encapsulated lens reflective sheeting. The text and borders may be screened, lettering film, or hand painted. Cones used for traffic control at night shall have a minimum 6" wide reflectorized material. Colors: The warning signs shown on this sheet shall have black text, border, and symbols on a reflectorized orange background. The orange shall conform with the standard colors adopted by the American Association of State Highway and Transportation Officials and approved by the U.S. Department of Transportation, Federal Highway Administration.

Text Design

Letters, digits, spacing, and text dimensions shall conform with the standard alphabets and design prescribed in the manual on Uniform Traffic Control Devices.

Specifications

Warning signs shall meet the standard state specifications for traffic signs.

Sign Base Material

The sign base material used for the warning signs on this sheet may be of any of the following, with minimum thickness as noted:

Flat sheet aluminum	0.125 Inches
High density overlaid plywood	3/4 Inches
Galvanized sheet steel	12 Gage

5. ON TOWN, CITY AND INCORPORATED VILLAGE HIGHWAY SYSTEMS THE MINIMUM NUMBER OF SIGNS IS AS FOLLOWS:

MINIMUM NUMBER OF SIGNS REQUIRED ARE M-6 AND M-7.

MINIMUM SIZE OF THE SIGNS SHALL BE 36" x 36".

THIS SIGN SIZE REDUCTION IS FOR DAYTIME MAINTENANCE OPERATIONS OF SHORT DURATION.

REVISIONS & CORRECTIONS


FEB. 28, 1972: SIGN ADDED UNDER DIRECTION OF FEDERAL HIGHWAY ADMINISTRATION
MAY 14, 1974: REFLECTIVE MATERIAL CHANGE.
JUNE 8, 1977: REFLECTIVE MATERIAL NOTE CHANGED. SIGNS REFERENCED TO NUMBERS IN M.U.T.C.D. SIGNS NUMBERED.
AUG. 4, 1977: FLAGPERSON SIGN CHANGED TO SYMBOL.
SEPT. 12, 1977: NOTE ADDED FOR REDUCED NUMBER AND SIZE OF SIGNS.
JUNE 9, 1978: REVISED REDUCED SPEED SIGN PER FHWA
NOV. 23, 1981: "WORK AREA" LEGEND AND NOTES ADDED, GENERAL SIGN REVISIONS.
JUNE 18, 1983: TRUCK/TRAILER W/ FLASHER WITH CLARIFIED

FEB. 1, 1986 - UPDATED TO 1986


APPROVED:

DATE Jan. 26, 1972
R. H. Arnold
CHIEF ENGINEER
E. H. O'Harey
ASST. CHIEF ENGINEER
L. M. Lane
HIGHWAY ENGINEER


TYPICAL MAJOR MAINTENANCE OPERATION (BRIDGE AND ROADWAY) APPROACH SIGNS

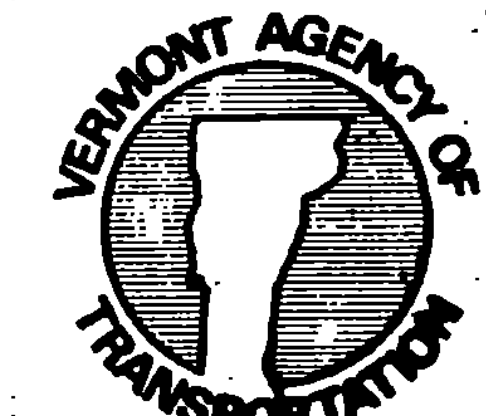


STANDARD
E-8

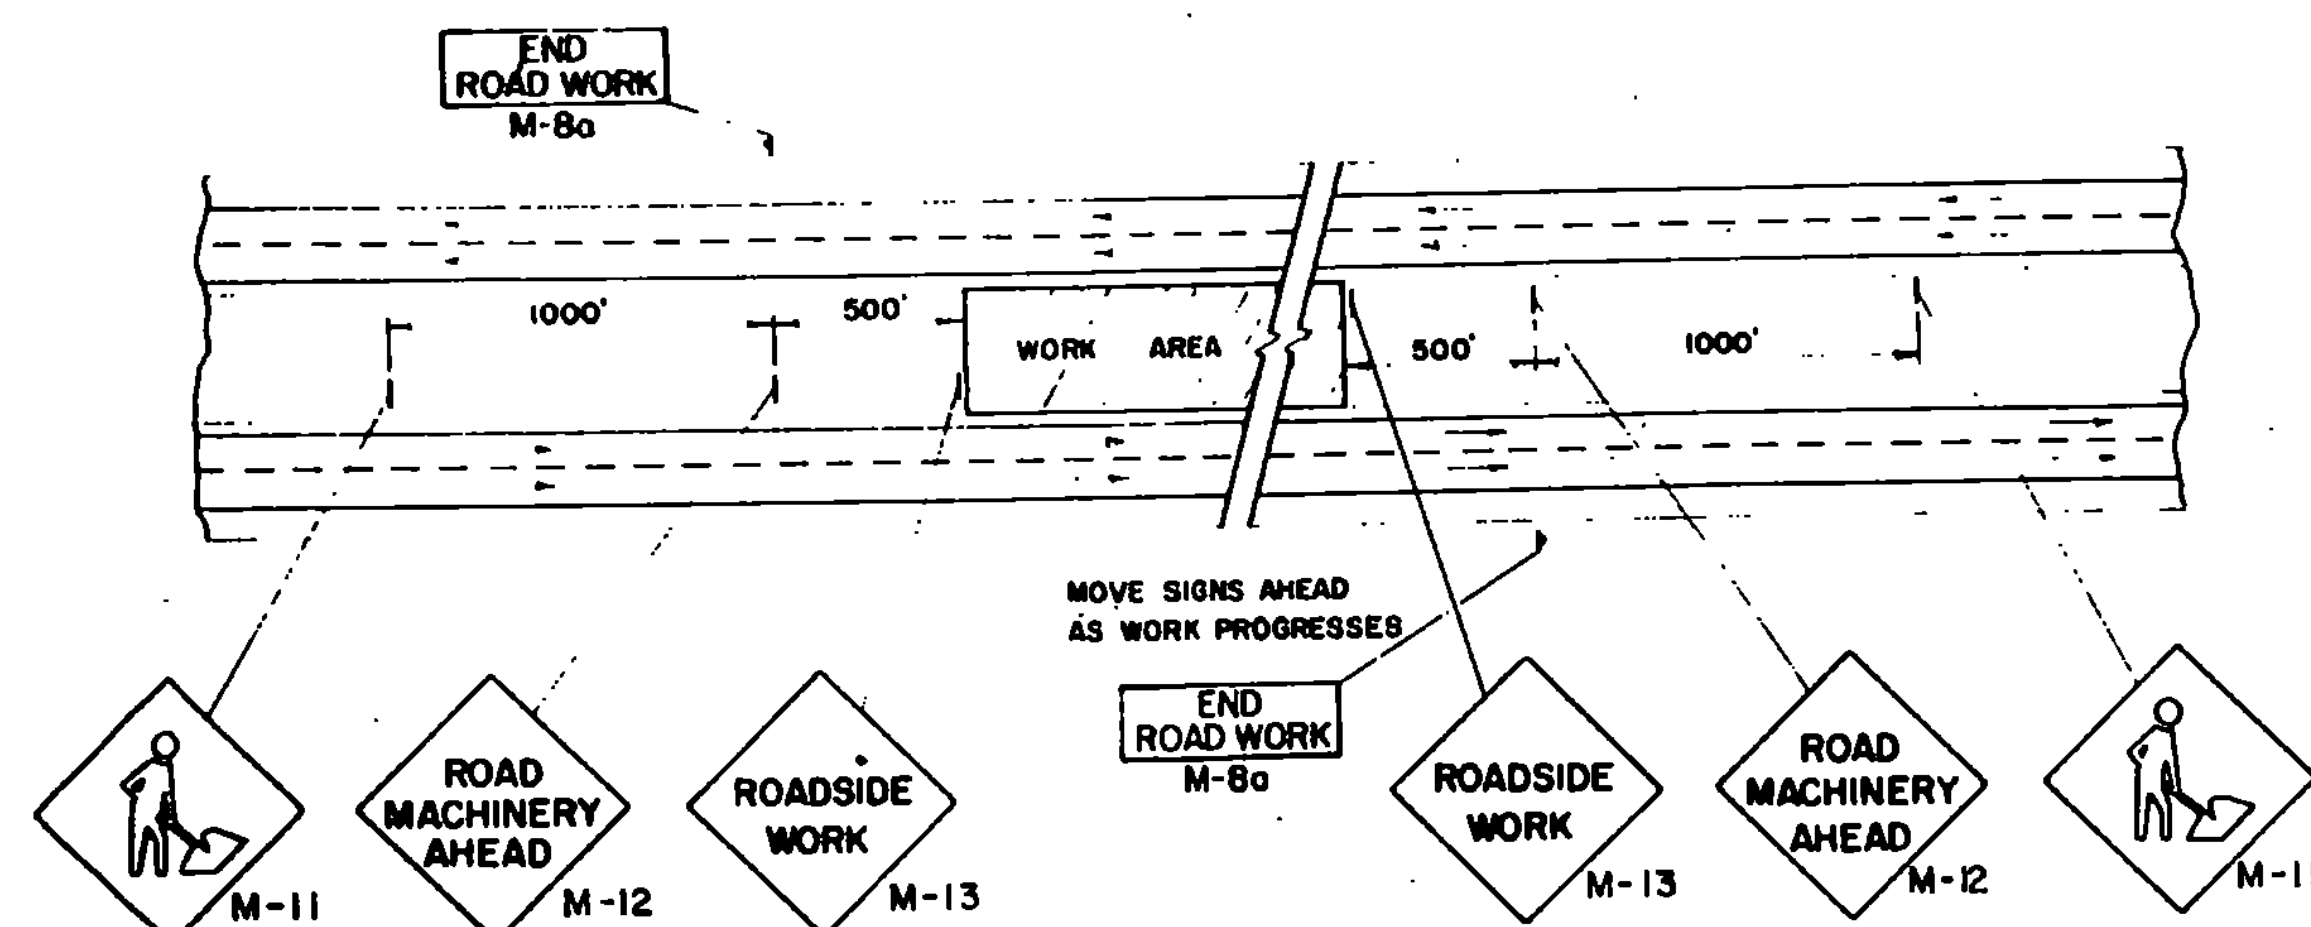


4-LANE DIVIDED HIGHWAY
MEDIAN MAINTENANCE

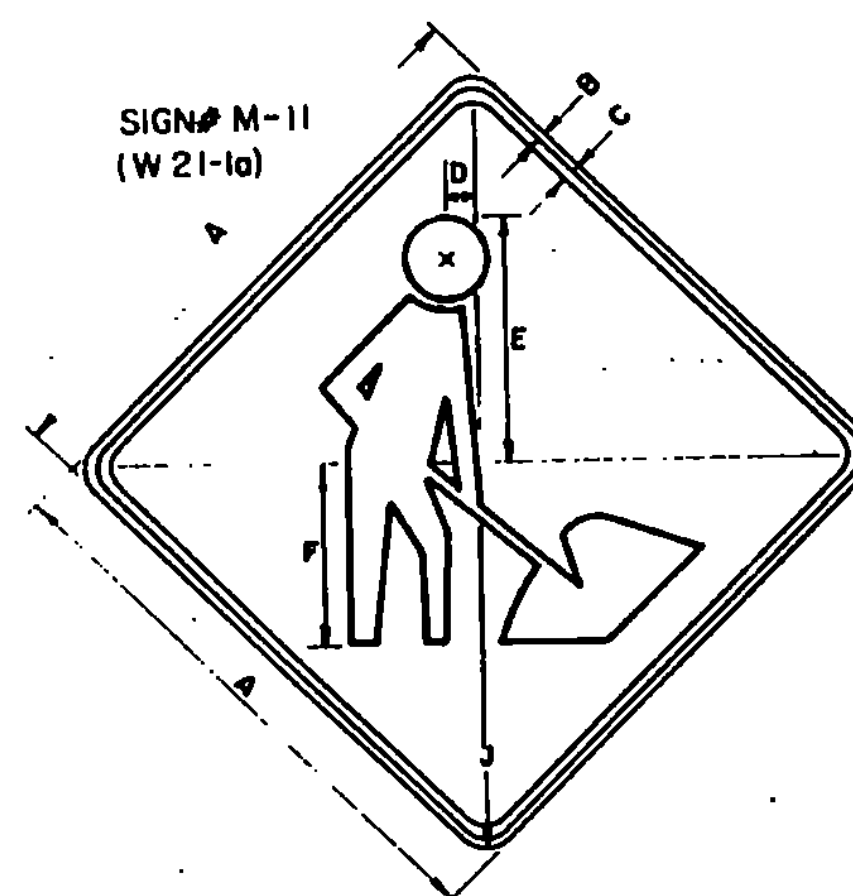


SIGN	DIMENSIONS (INCHES)									
	A	B	C	D	E	F	G	H	J	K
2 LANE	36	5/8	7/8	2-1/4	5-7/8	12			2 1/4	
4 LANE	48	3/4	1 1/4	3	22 3/4	16			3	

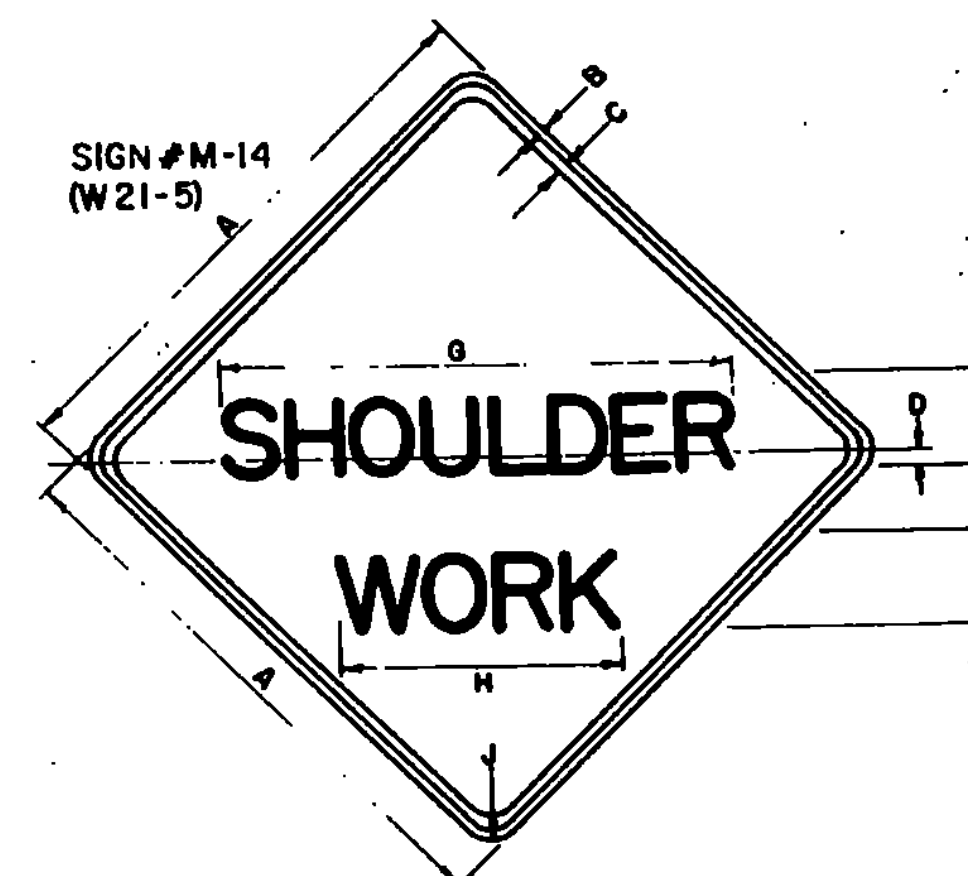


SIGN	DIMENSIONS (INCHES)									
	A	B	C	D	E	F	G	H	J	K
2 LANE	36	5/8	7/8	1	5-D	3 1/2	3 1/2	17	2 1/4	
4 LANE	48	3/4	1 1/4	1	7-C	4	3 1/2	20	3	

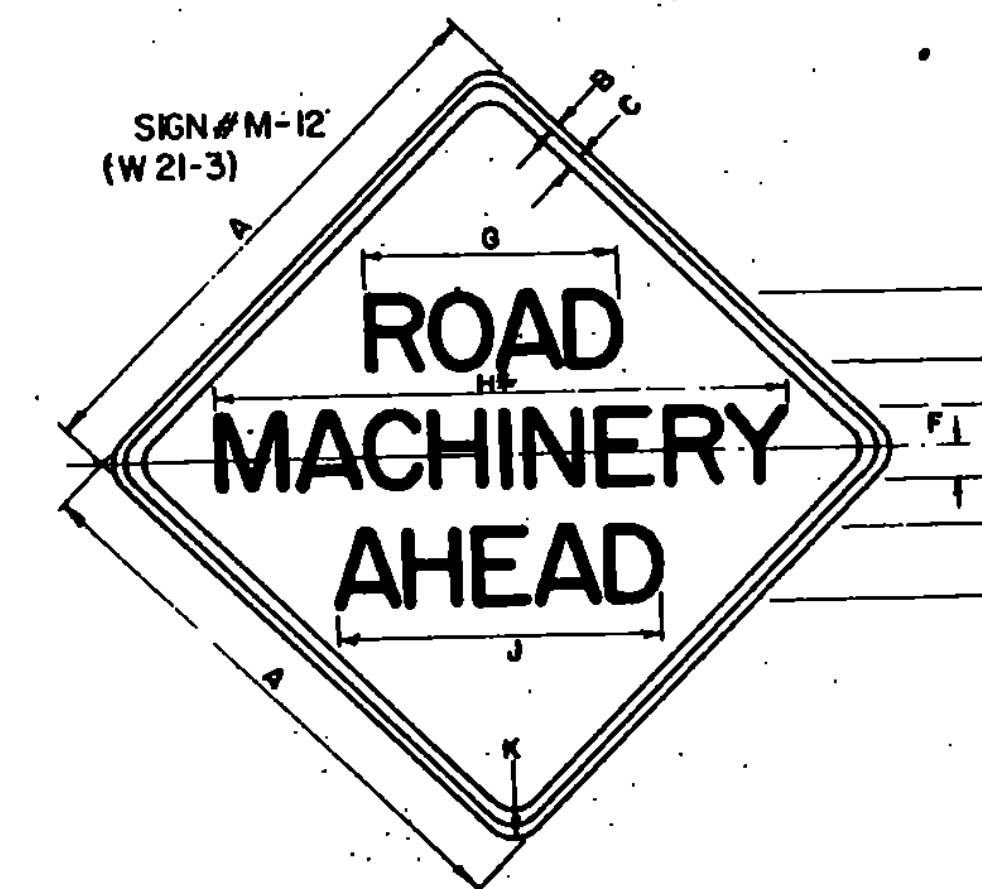


SIGN	DIMENSIONS (INCHES)									
	A	B	C	D	E	F	G	H	J	
2 LANE	36	5/8	7/8	5-D	4	2-1/2	7 1/4	34 1/2	2 1/2	
4 LANE	48	3/4	1 1/4	7-D	5	3-1/2	24 1/8	48 1/2	31	

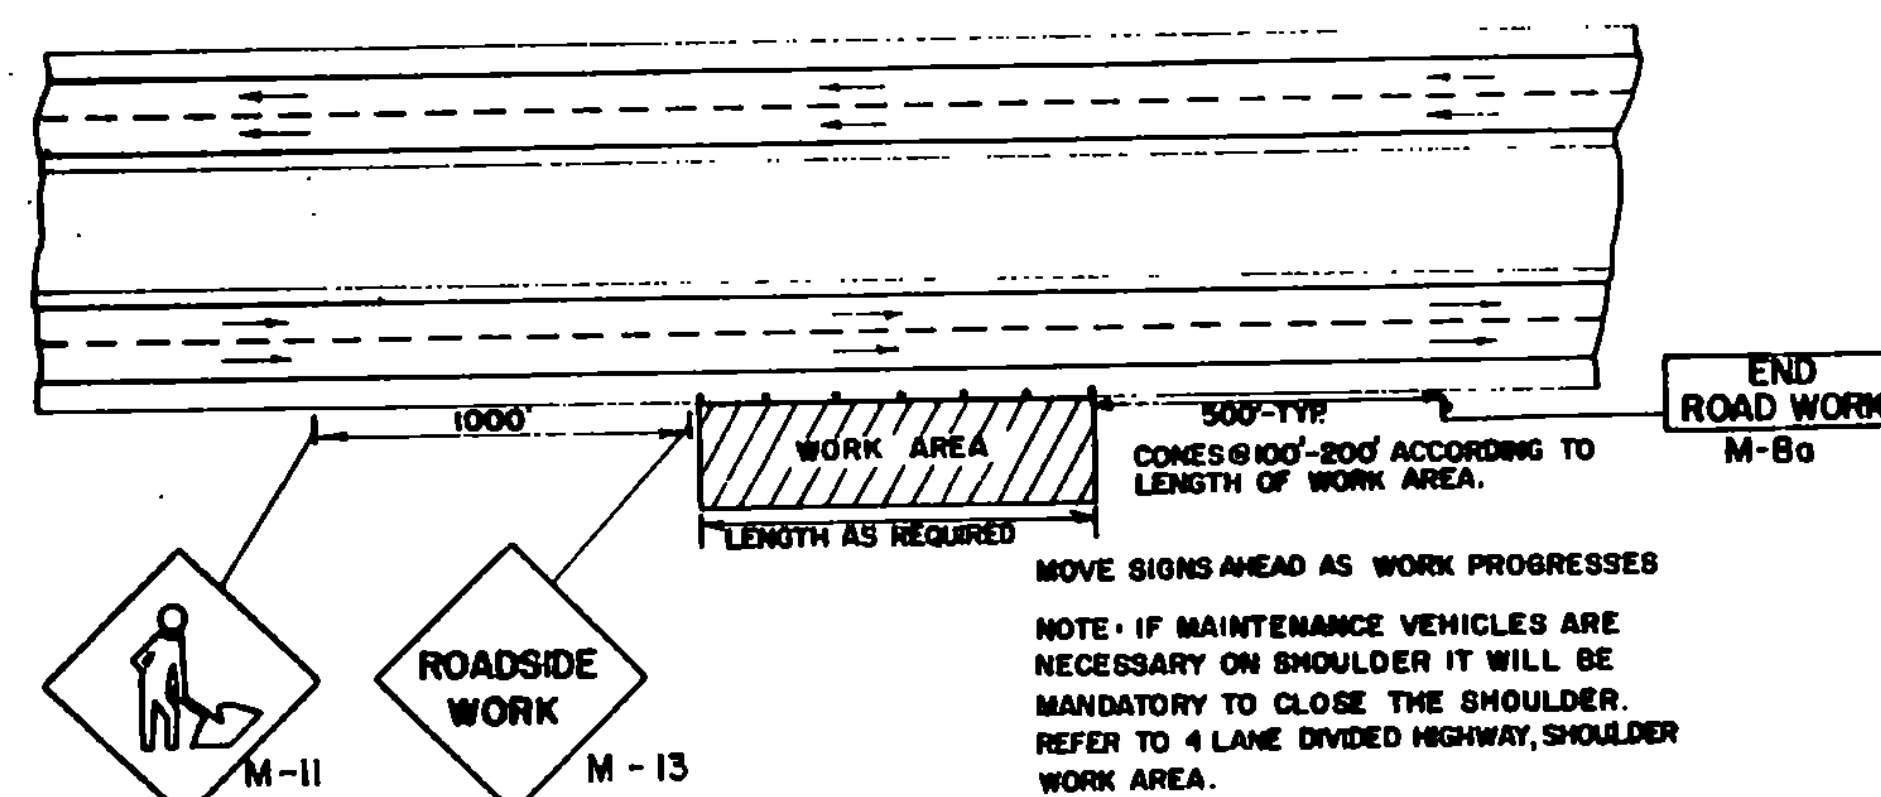


4-LANE DIVIDED HIGHWAY
MAINTENANCE OUTSIDE RIGHT SHOULDER

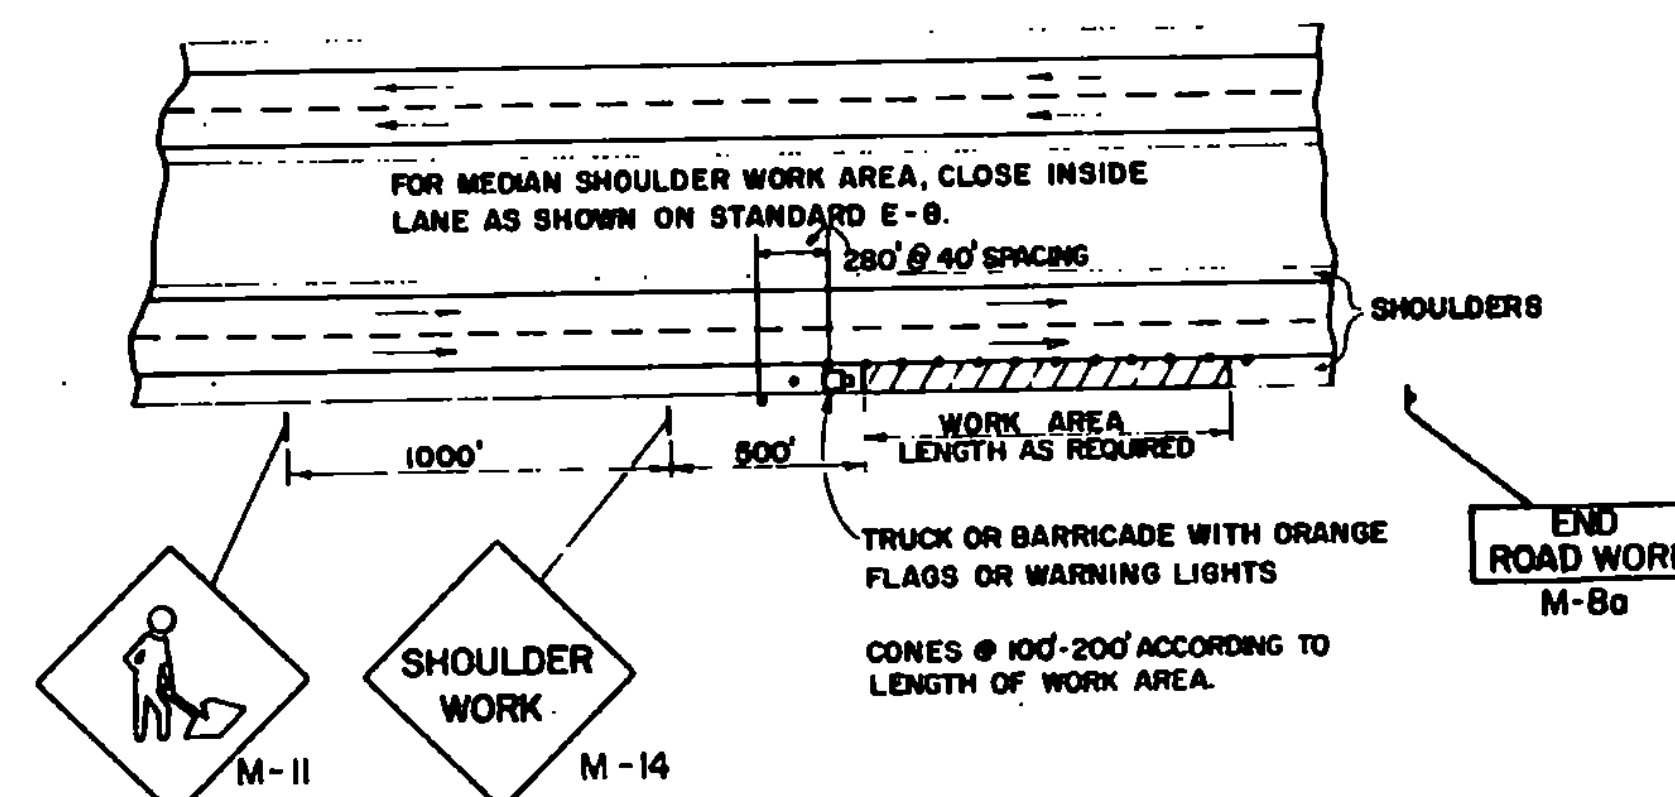


4-LANE DIVIDED HIGHWAY
SHOULDER WORK AREA

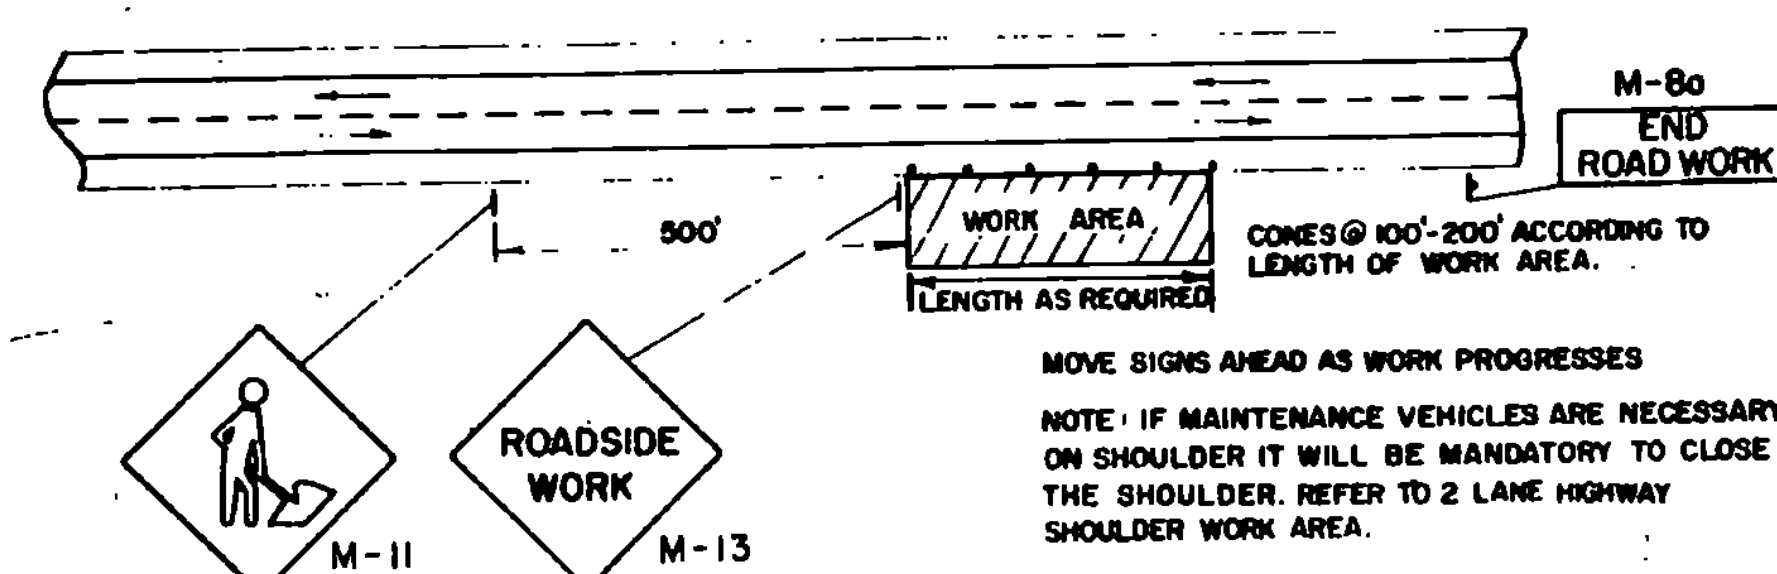

2-LANE HIGHWAY
MAINTENANCE OUTSIDE SHOULDER

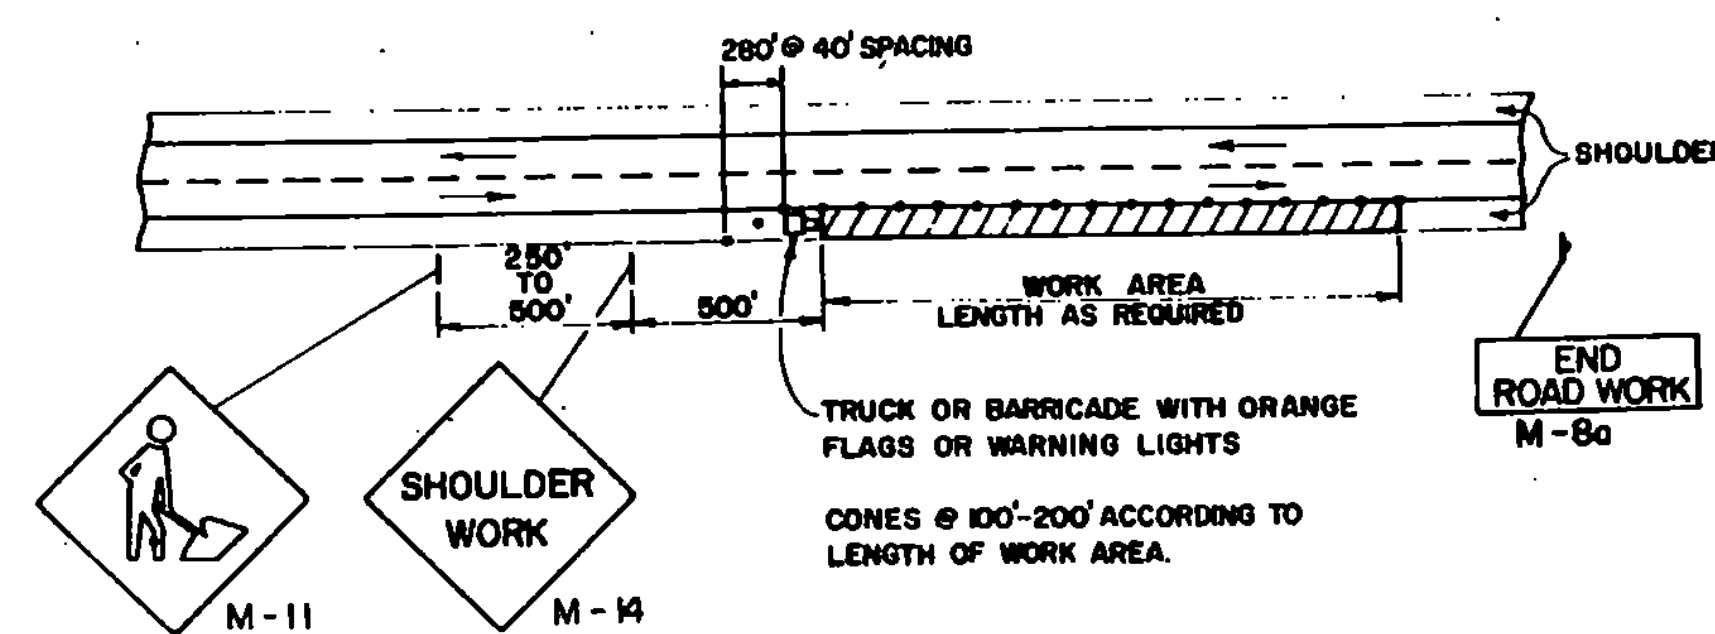


2-LANE HIGHWAY
SHOULDER WORK AREA

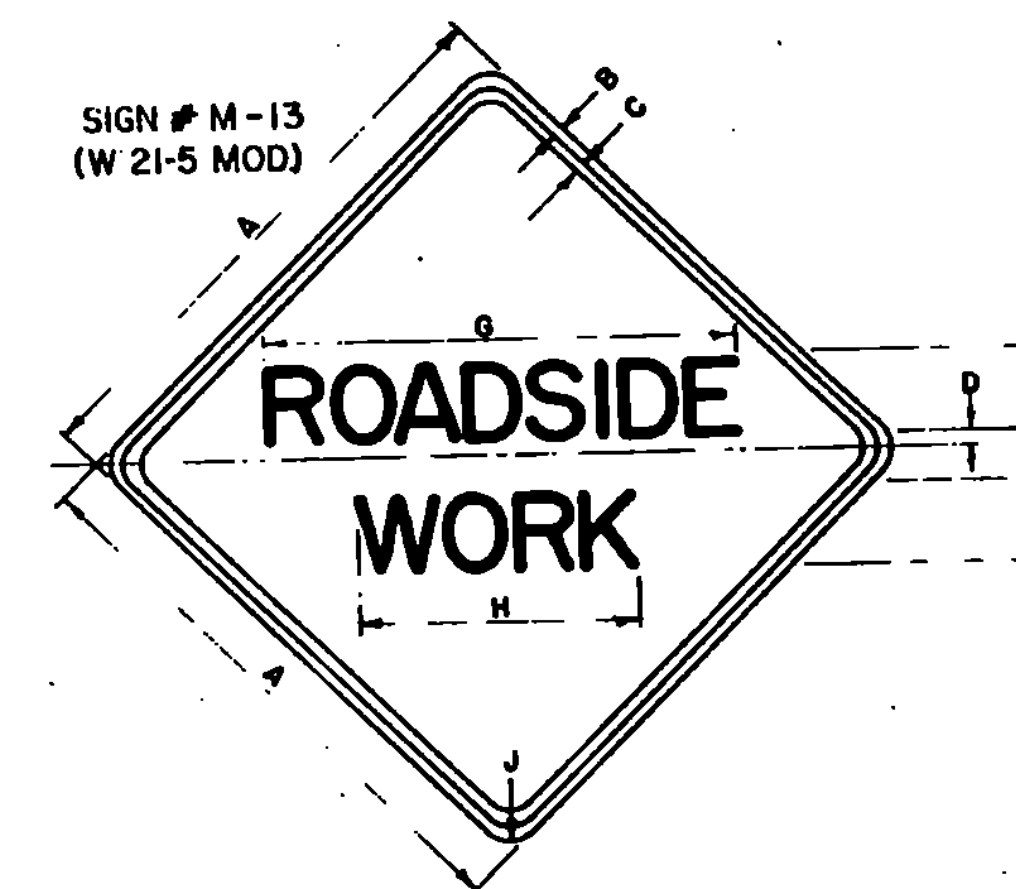

SIGN	DIMENSIONS (INCHES)									
	A	B	C	D	E	F	G	H	J	K
2 LANE	36	5/8	7/8	1/2	5-D	3 1/2	3 1/2	17	2 1/4	
4 LANE	48	3/4	1 1/4	1	7-C	4	3 1/2	20	3	

SIGN # M-8a
(G20-2 MOD.)

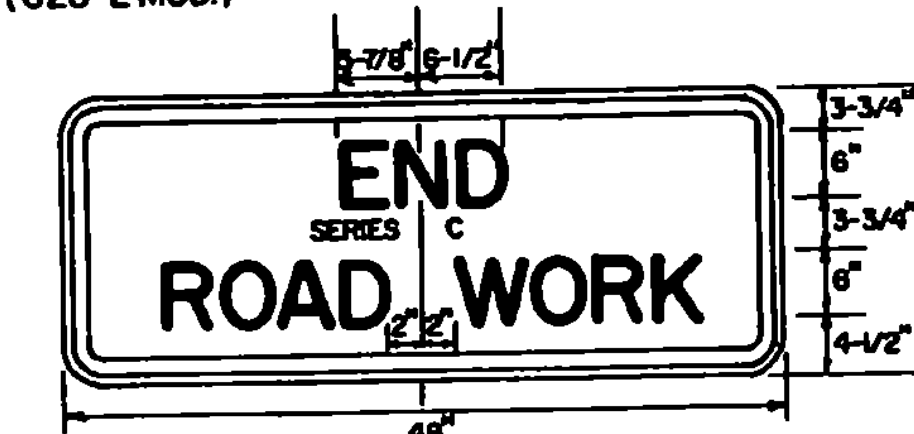

Reflectionization
All reflective material shall consist of encapsulated lens reflective sheeting. The text and borders may be screened, lettering film, or hand painted.

Colors
The warning signs shown on this sheet shall have a black text and border on a reflectorized orange background. The orange shall conform with the standard colors adopted by the American Association of State Highway and Transportation Officials and approved by the U.S. Dept. of Transportation, Federal Highway Administration.

Text Design
Letters, spacing, and text dimensions shall conform with the standard alphabets and design prescribed in the Manual on Uniform Traffic Control Devices.

Specifications
Warning signs shall meet the standard state specifications for traffic signs.

Sign Base Material
The sign base material used for the warning signs shown on this sheet may be of any of the following, with minimum thickness as noted:

(1) Flat Sheet Aluminum	0.100	0.125	inches
(2) High Density Overlay Plywood	5/8	3/4	inches
(3) Galvanized Sheet Steel	14	12	gauge

REVISIONS & CORRECTIONS
FEB. 29, 1972: REVISED PER DIRECTION OF THE FEDERAL HIGHWAY ADMINISTRATION.
MAY 14, 1974: REFLECTIVE MATERIAL CHANGE.
JUNE 6, 1977: REFLECTIVE MATERIAL NOTE CHANGED.
AUG. 10, 1977: SIGNS REFERENCED TO NUMBERS IN M.U.T.C.D.
DEC. 9, 1981: MINOR SIGN DIMENSION CHANGES.
FEB. 5, 1986: UPDATED TO 1986 SPECIFICATIONS

APPROVED

DATE Jan. 26, 1972
R. L. Arnold
CHIEF ENGINEER
E. J. O'Brien
ASST. CHIEF ENGINEER
G. M. Lane
HIGHWAY ENGINEER

TRAFFIC SIGNS TYPICAL MINOR MAINTENANCE OPERATION APPROACH SIGNS



STANDARD
E-10