


TYPICAL SECTIONS & DESIGN DATA

BITUMINOUS CONCRETE PAVEMENT
 LEVELING COURSE TYPE IV (355 TONS/MILE)
 AS DIRECTED BY THE ENGINEER.
 1 1/4" WEARING COURSE TYPE III (±1/4" THICKNESS TOLERANCE)

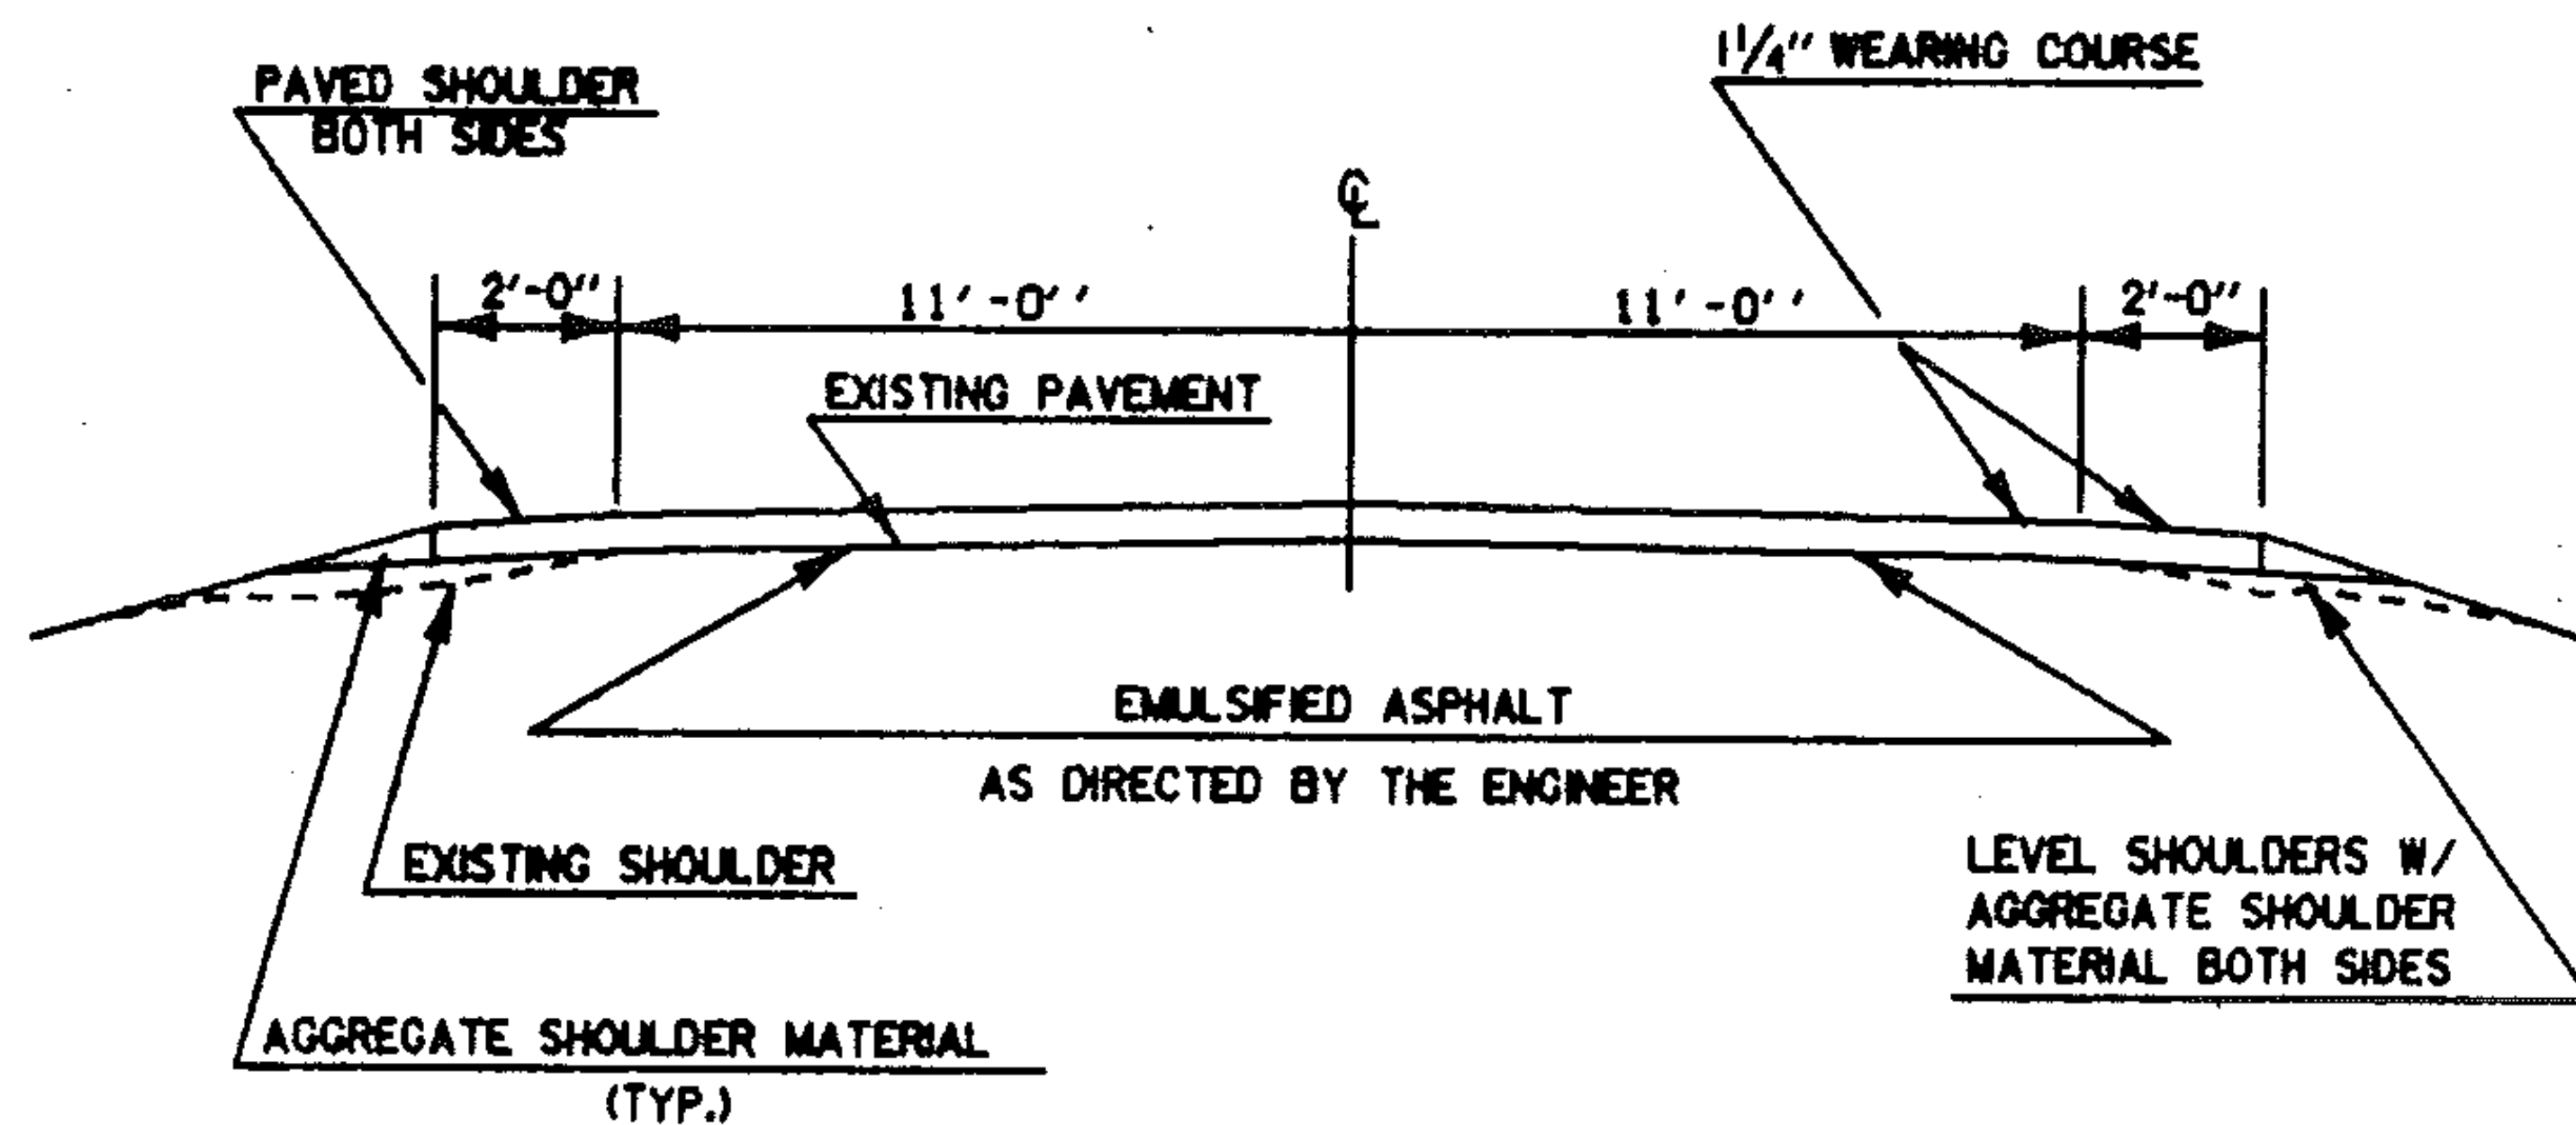

CORNWALL MIDDLEBURY
 VT. 125 MM 2.596 ~ MM 0.400

NOTE : WHEN ENCOUNTERING VEGETATION OR POOR MATERIAL IN THE SHOULDER AREA,
 REMOVE 2" BELOW EXISTING PAVEMENT LEVEL AND REPLACE WITH AGGREGATE
 SHOULDER MATERIAL. REMOVAL OF THIS MATERIAL WILL BE PAID FOR UNDER
 THE ITEM 'ALL PURPOSE EXCAVATOR RENTAL' OR 'GRADER RENTAL'.

PROJECT CORNWALL-MIDDLEBURY

NO. HMA 2825
 SHEET 4 OF 7 SHEETS
 SHEET 38 OF 75 SHEETS